




RIVER-UPSTREAM PHOTOS



RIVER-DOWNSTREAM PHOTOS

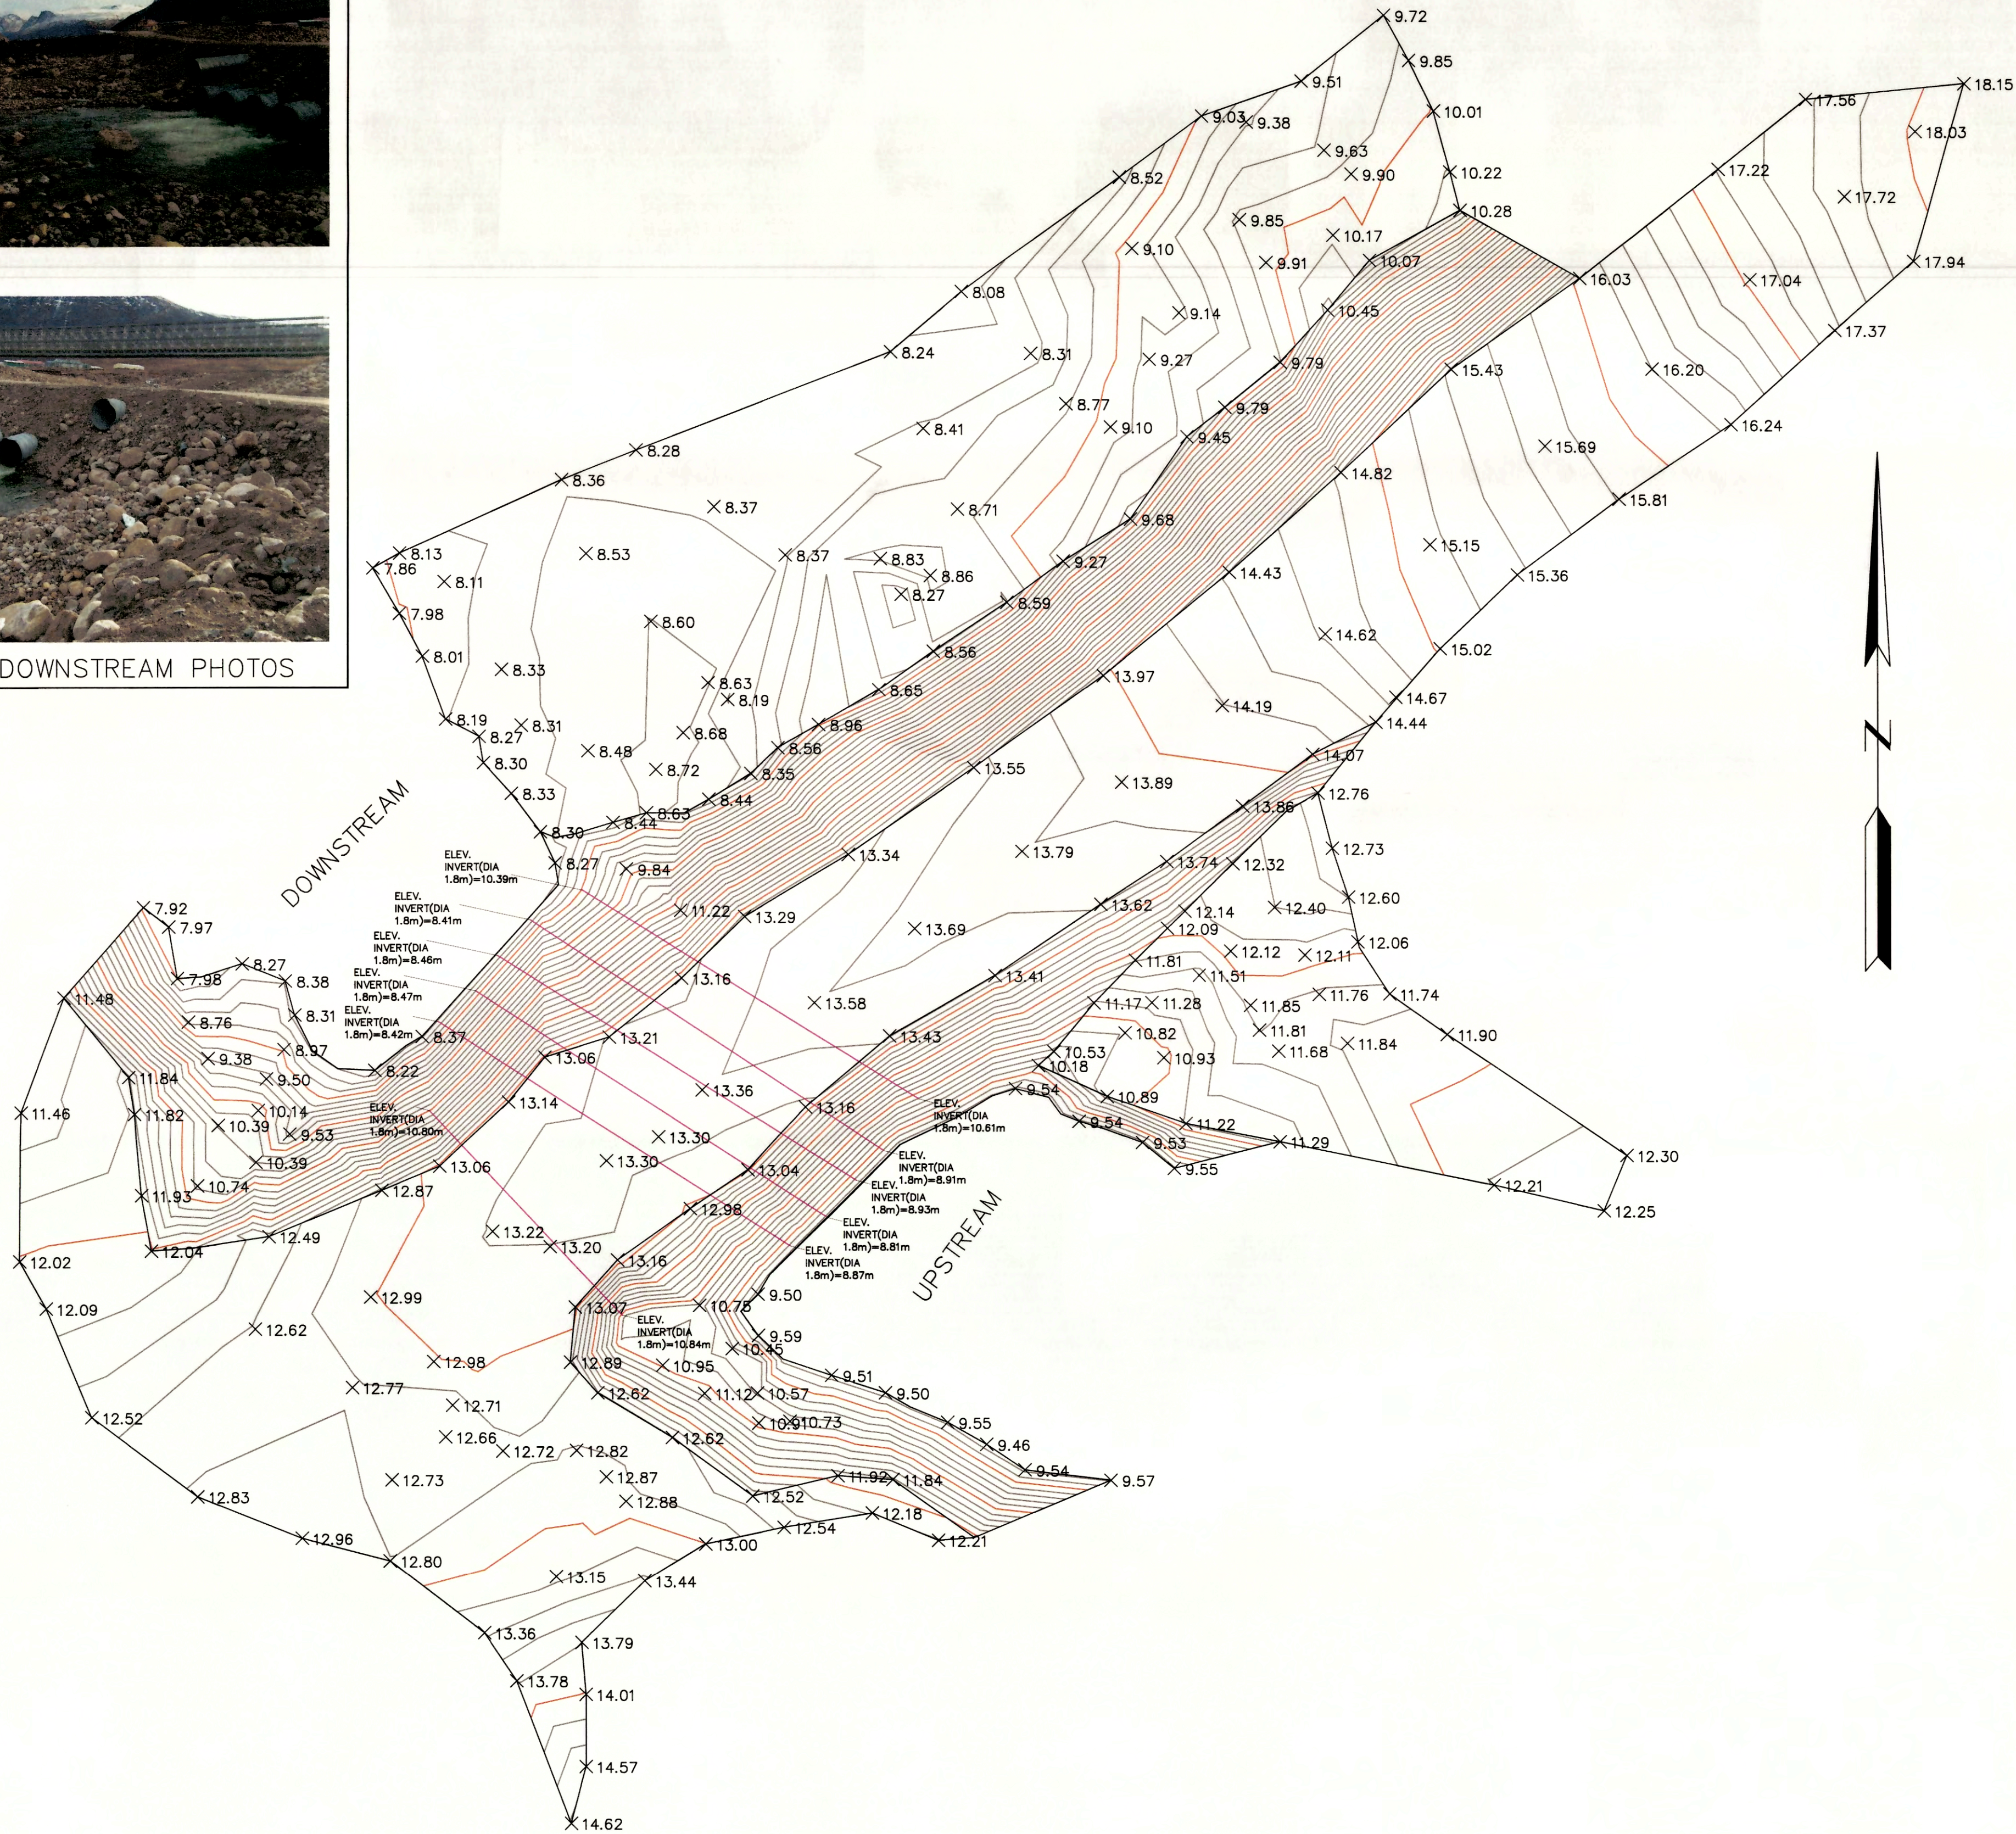

OLLERHEAD & ASSOCIATES LTD
CANADA LANDS SURVEYORS
AND ENGINEERS
TEL: 867- 8739690
FAX: 867- 6696334
EMAIL: info@ollerhead.ca PROJECT NO.: 12-38-FO

PROJECT NAME:
**PANGNIRTUNG
TOPOGRAPHIC SURVEY**

CLIENT:
FISHERIES AND OCEANS CANADA

DRAWING TITLE:
DUVAL CULVERT SITE

REV	DATE	COMMENTS
1	OCT 15, 2012	X 0.00 SPOT ELEVATION (NOT ALL POINTS ARE SHOWN)

DRAWN:	CHECKED:	INITIAL	APPROVED	INITIAL
V.F.	C.T.		V.O.	

SCALE	1:250	DATE:	OCT 15, 2012
-------	-------	-------	--------------

PERMIT TO PRACTICE
OLLERHEAD AND ASSOCIATES LTD.
Signature: *V. Ollerhead*
Date: *Oct 19, 2012*
PERMIT NUMBER: P 372
The Association of Professional Engineers
Geologist and Geophysicists of the Northwest Territories



Signature: *V. Ollerhead*
Date: *Oct 19, 2012*

DRAWING NUMBER:
SHEET 1