



I:\AN-SVR0\Projects\01_SITES\Hope Bay\1CT022.009_2016_Compliance\1040_AutoCAD\IMXD\2_2016_Sampling\1CT022.009_AnnualSeepMaps_2016_Fig_01_keymap.mxd

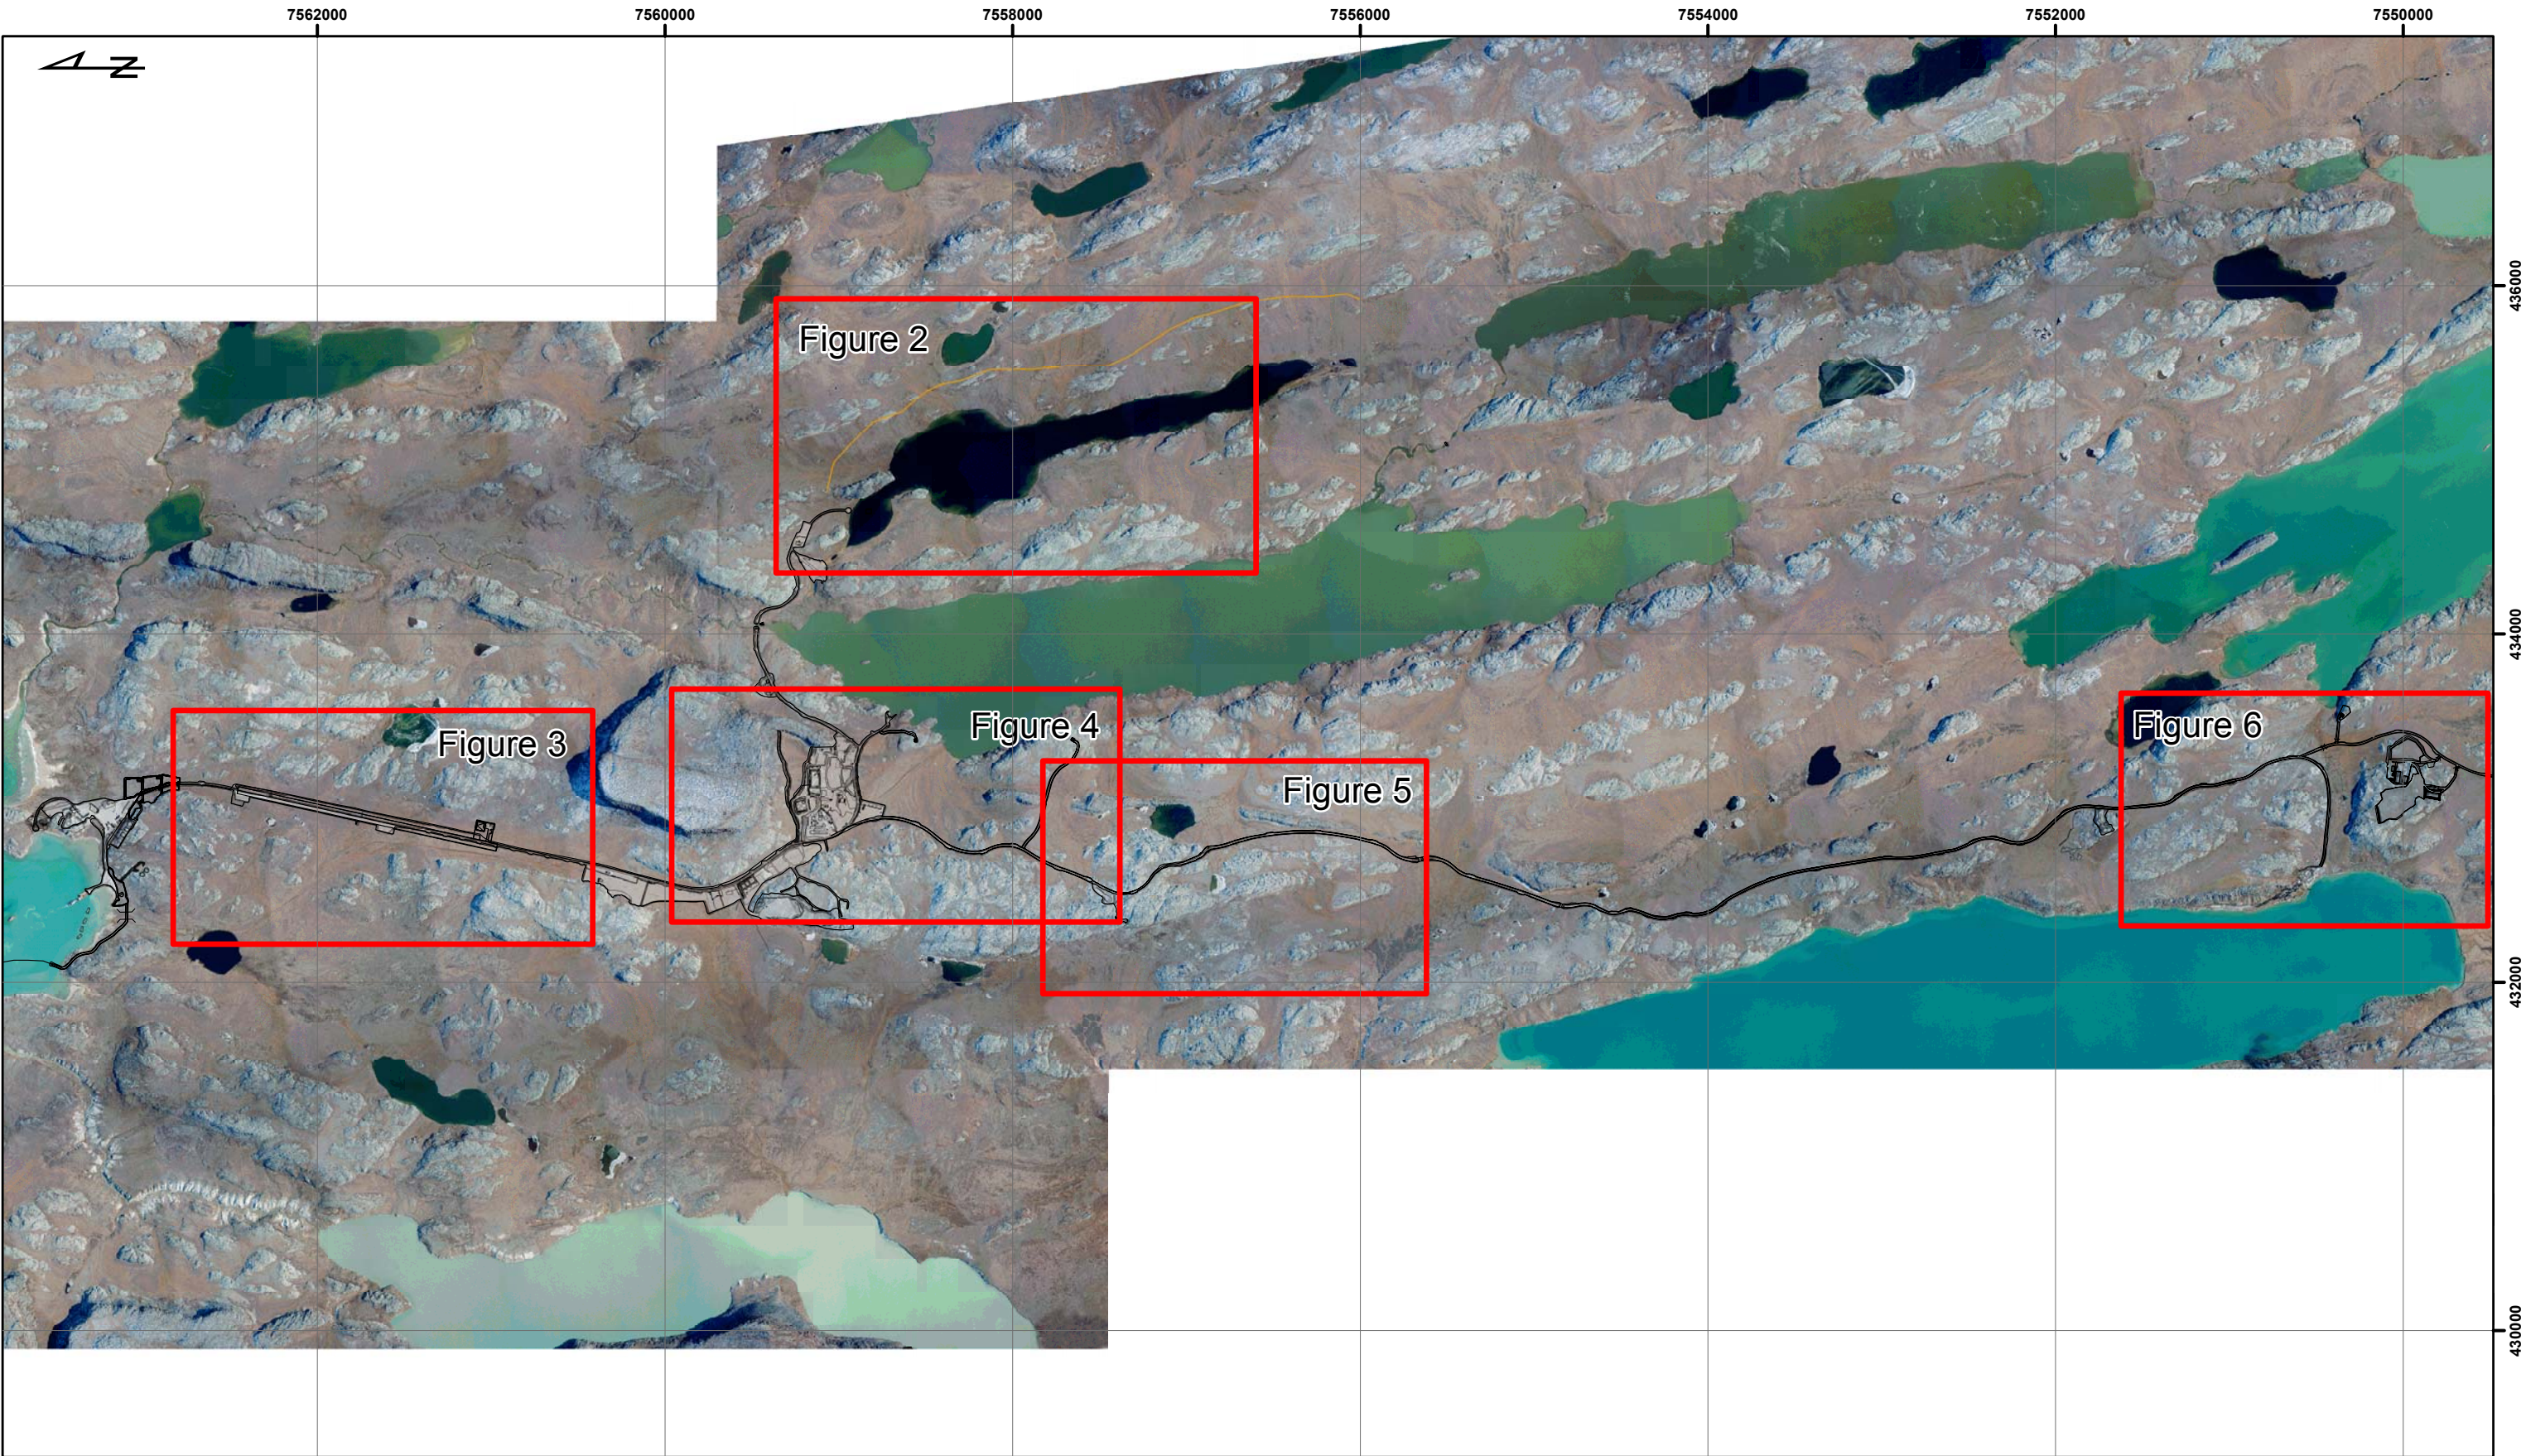

Legend

- As-Built Infrastructure
- Proposed Alignment

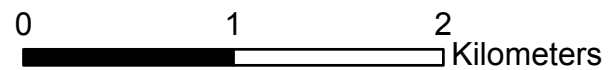

Job No: 1CT022.009.700
Filename: 1CT022.009_AnnualSeepMaps_2016_Fig_01_keymap




2016 Seepage Monitoring

Hope Bay Gold Project

Seepage Survey Locations
Key Map

Date: Jan. 2017	Approved: LB	Figure: 1
--------------------	-----------------	---------------------

I:\VAN-SVR01\Projects\01_SITES\Hope Bay\1CT022.009_2016_Compliance\1040_AutoCAD\IMXD\2_2016_Sampling\1CT022.009_AnnualSeepMaps_2016_Fig_02_TIA.mxd

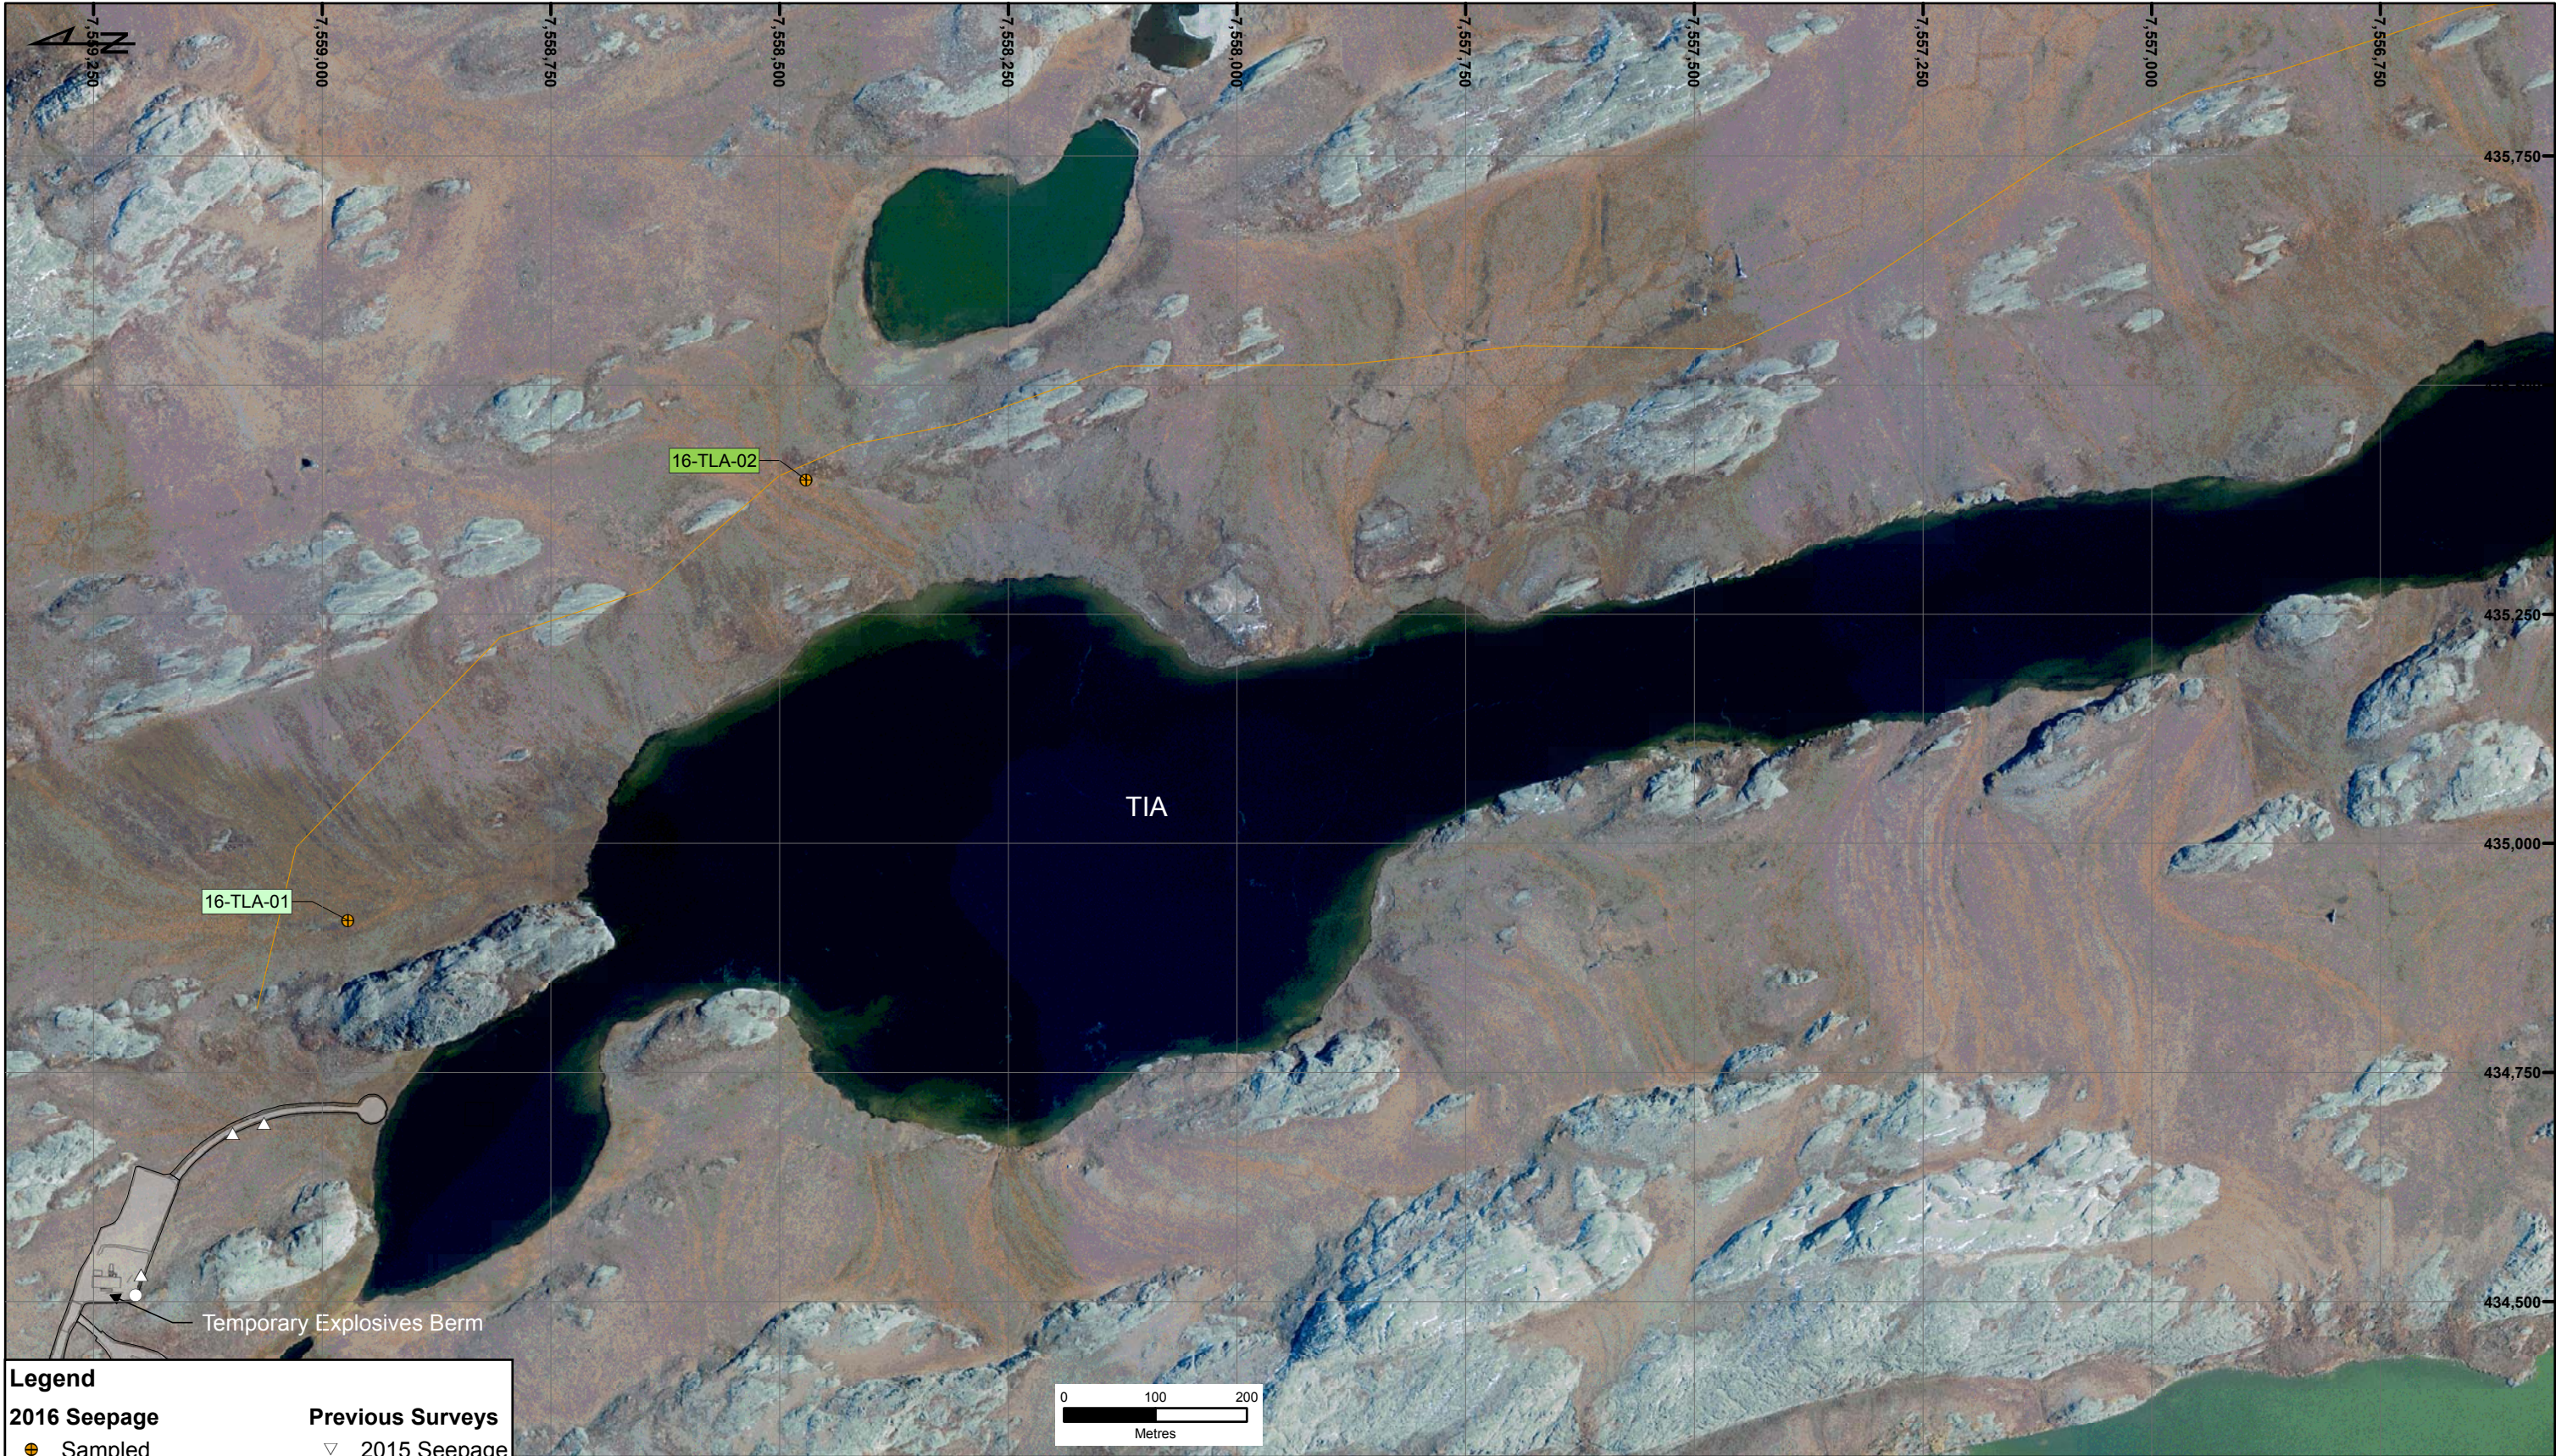

Legend

2016 Seepage

- ⊕ Sampled
- ⊕ Not Sampled
- As-Built Infrastructure
- Proposed Alignment

Previous Surveys

- ▽ 2015 Seepage
- ◇ 2014 Seepage
- ◇ 2013 Seepage
- 2012 Seepage
- △ 2011 Seepage
- 2010 Seepage

	pH 6.0 to 6.9	pH 7 to 7.9	pH 8 to 8.9
EC ≤ 500 µS/cm			
500µS/cm<EC<2000µS/cm			
EC>2000µS/cm			

Note: As-built alignment for Tail Lake road not shown.



Job No: 1CT022.009.700
Filename: 1CT022.009_AnnualSeepMaps_2016_Fig_02_TIA



2016 Seepage Monitoring

Hope Bay Gold Project

Seep Survey Location
TIA Area

Date:
Jan. 2017

Approved:
LB

Figure:
2