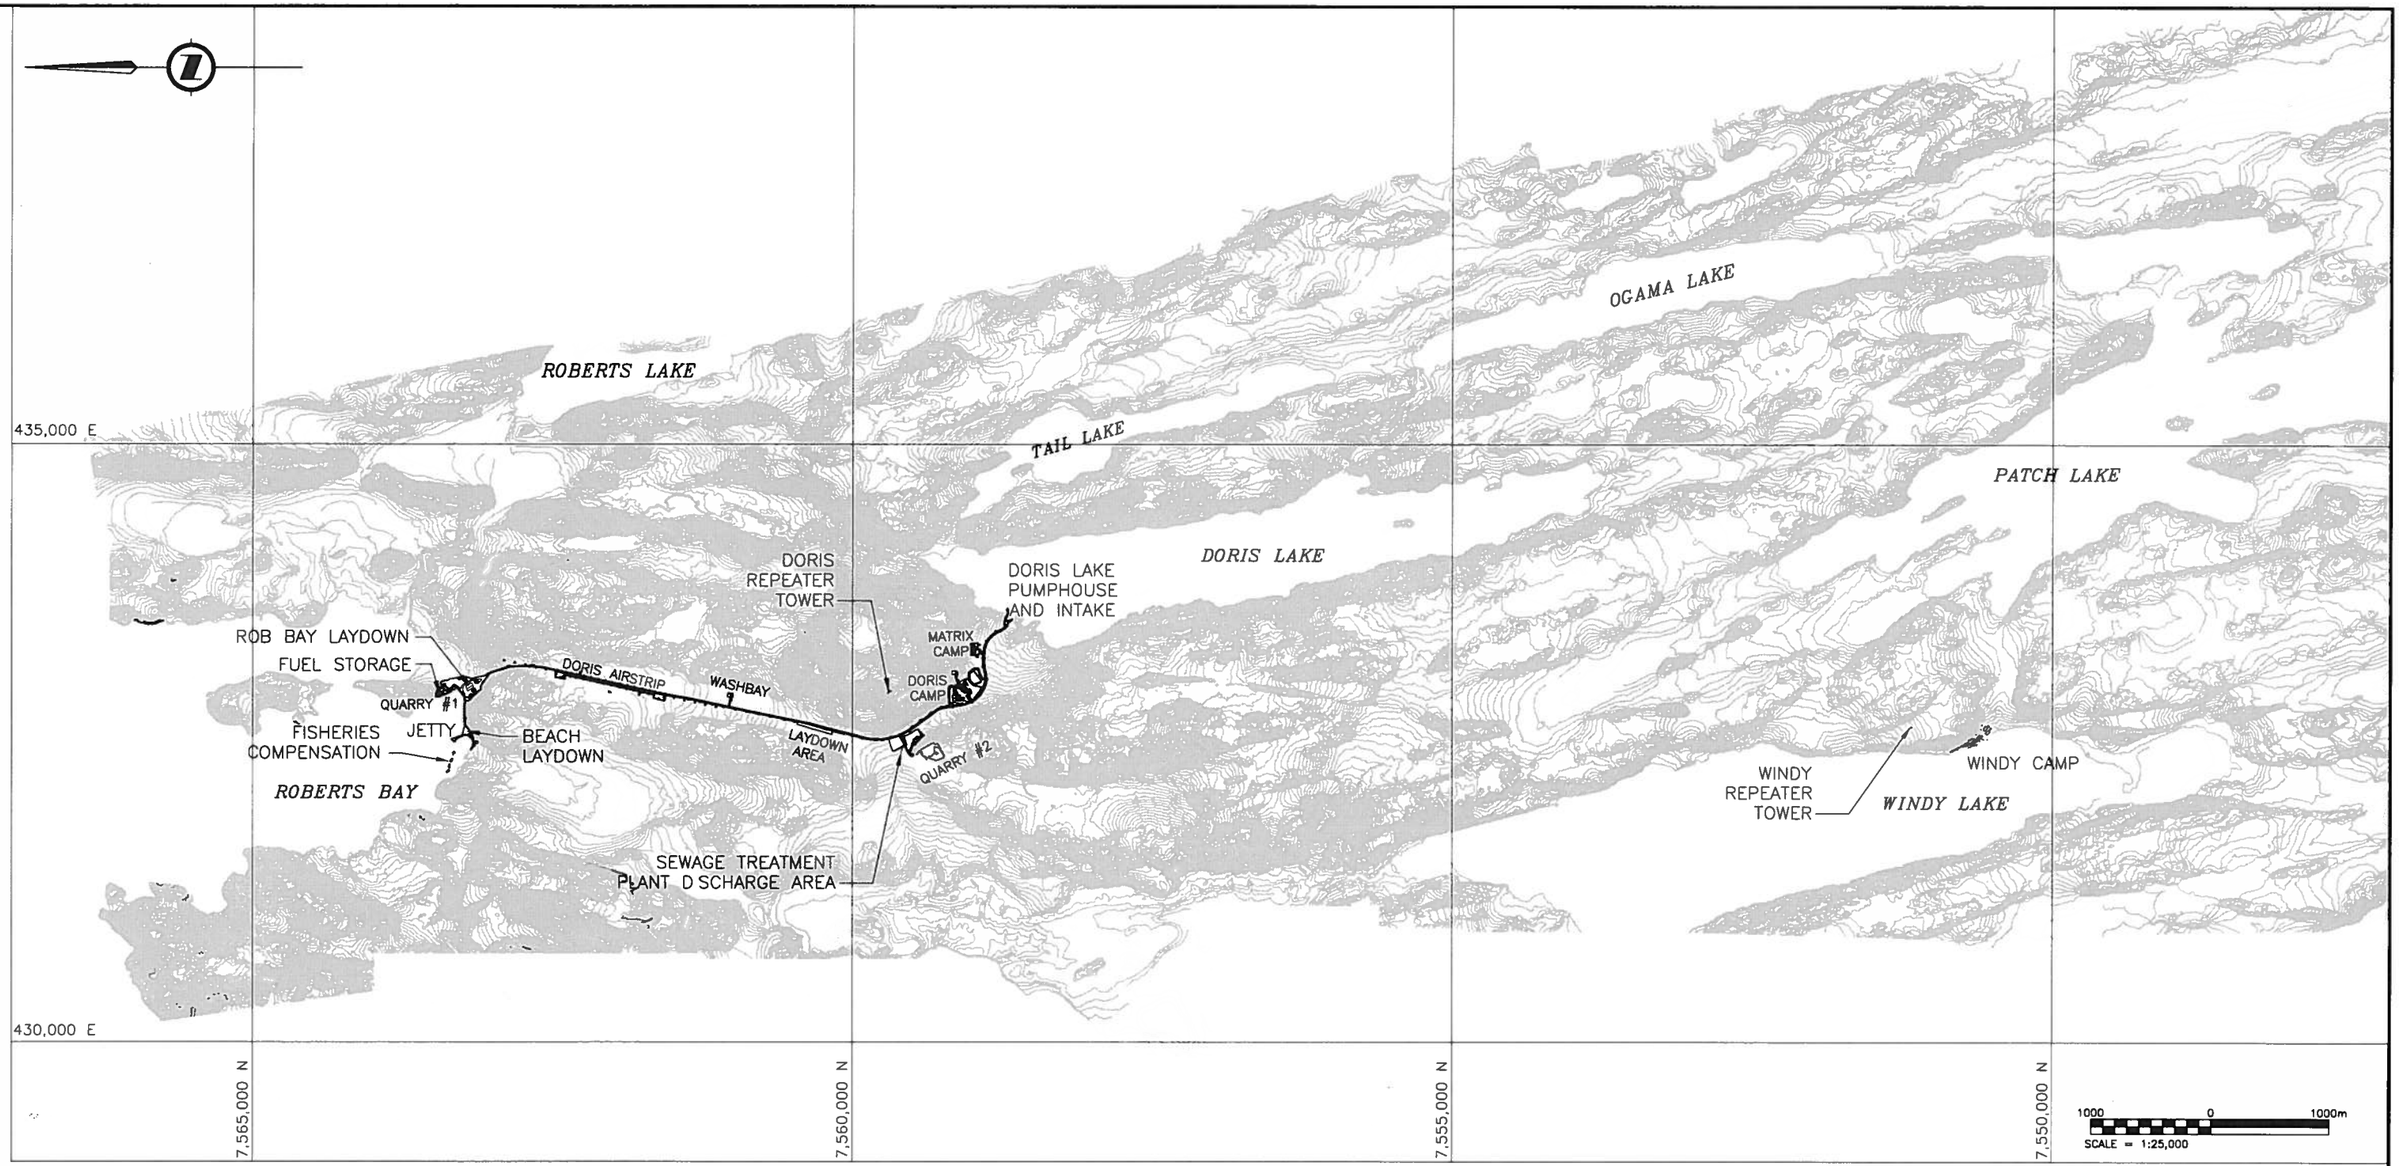

NOTES:

1. HORIZONTAL CONTROL IS UTM NAD 83 AND VERTICAL IS GEODETIC.
2. ALL DIMENSIONS AND ELEVATIONS ARE IN METRES UNLESS NOTED OTHERWISE.
3. AS BUILT INFORMATION PROVIDED BY SUB-ARCTIC SURVEYS LTD. – 2008.

AS-BUILT

NO.	DATE	REVISIONS	BY	CHK	LEAD DISCP.	CHG. MAN.	AREA MAN.	CLIENT CHG.	CLIENT AREA
1	09/02/04	AS-BUILT UPDATED WITH OWNER'S COMMENTS	ESL	JMG	RU	RU	GA	TL	
0	09/01/12	AS-BUILT	ESL	JMG	RU	RU	GA		
PD	08/07/11	REVISED WITH CLIENT COMMENTS	NKP						
PC	08/06/09	CHANGE DRAWING NAME	LJG	CT					
PB	08/01/29	ISSUED FOR COMMENTS	ESL	JC					
PA	07/11/07	ISSUED FOR COMMENTS	LJG						

SNC-LAVALIN INC.			
DESIGNED	JOS CAVE	JC	07/09/29
DRAWN	LEE GOUDZWAARD	LJG	07/09/29
CHECKED			
APPROVED LEAD CHG.			
APPROVED CHG. MAN.			
APPROVED AREA MAN.			
CLIENT APPROVED CHG. COORD.			
CLIENT APPROVED AREA MAN.			
AS SHOWN	NAME (PRINT)	INIT.	DATE

ENGINEER'S STAMP

REGISTERED PROFESSIONAL ENGINEER — ORIGINAL SIGNED BY — 27/11/2008 — #L1158 — NWT

NEWMONT The Gold Company

CLIENT: HOPE BAY MINING LTD.

CLIENT DWG. NO.

SNC·LAVALIN

THIS DRAWING IS THE PROPERTY OF SNC-LAVALIN INC., AND THE USE AND COPYING THEREOF IS SUBJECT TO THE TERMS OF THE AGREEMENT UNDER WHICH IT WAS PREPARED. THIS DRAWING MAY NOT BE COPIED EXCEPT AS EXPRESSLY PROVIDED THEREIN.

PROFESSIONAL ENGINEER | NAME | NO.

TITLE

HOPE BAY MINING LIMITED
DORIS NORTH INFRASTRUCTURE PROJECT

GENERAL SITE PLAN
PLAN VIEW

PROJECT NO.	AREA	DISCPL.	DOC.	DRAWING NUMBER	LOC.	REVISION NUMBER
334499	0000	41	D1	0003		1

Format: Metric D (TRUE SCALE)

DATE: 2009/02/10 – 3:08pm
PATH: J:\334499 – HBML Doris 2008\00 – As-Builts 2009\334499-0000-4101-0003.dwg