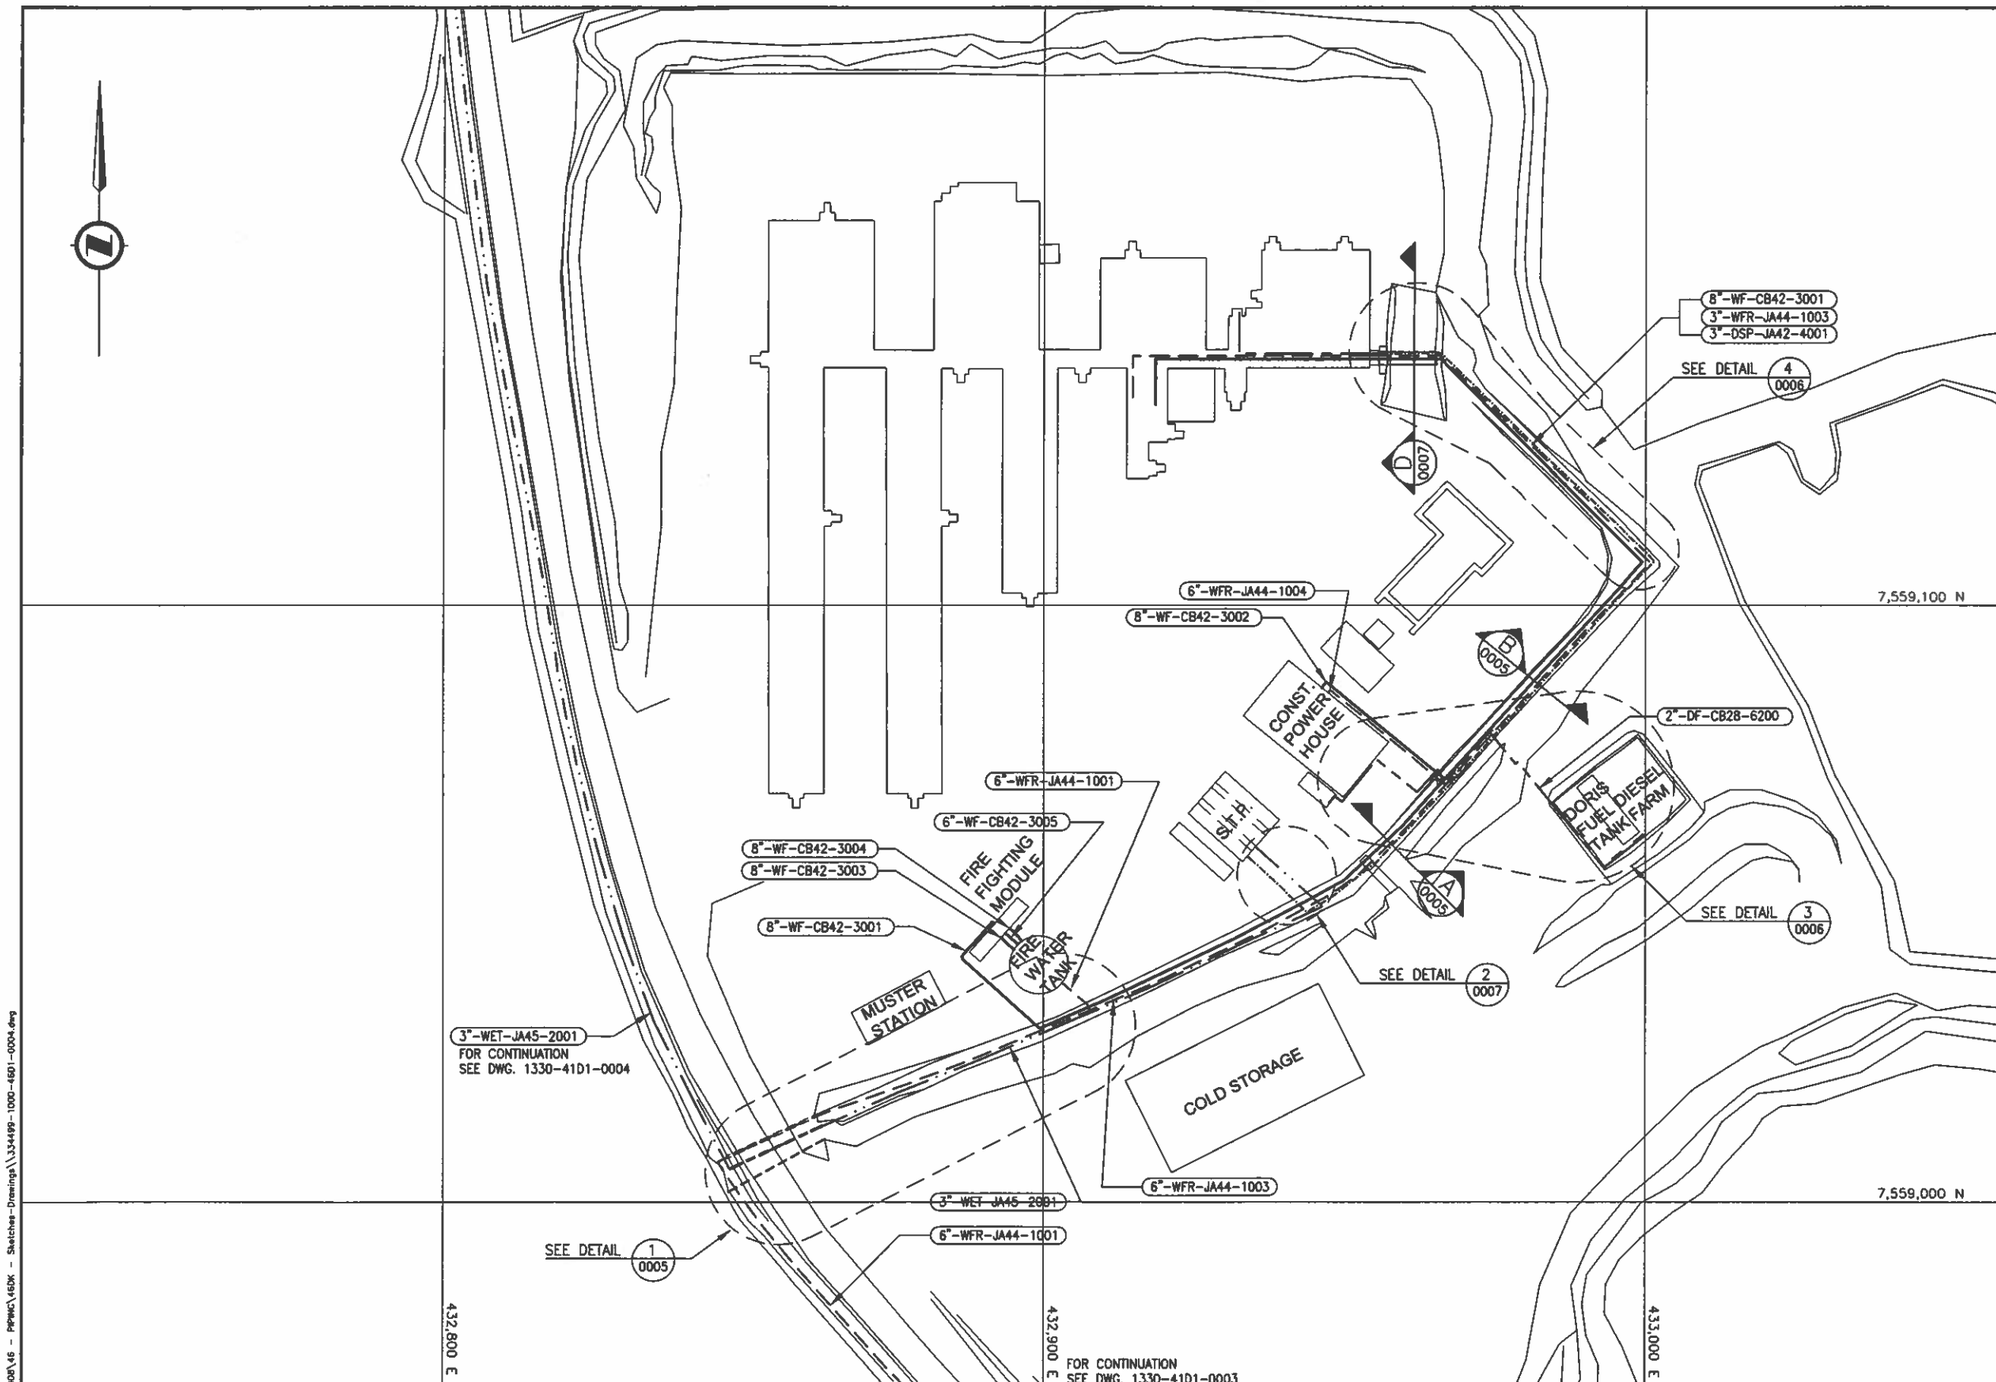

NOTES:

1. HORIZONTAL CONTROL IS UTM NAD 83 AND VERTICAL IS GEODETIC.
2. ALL DIMENSIONS AND ELEVATIONS ARE IN METRES UNLESS NOTED OTHERWISE.
3. AS-BUILT INFORMATION BASED ON DATA RECEIVED FROM SUB ARCTIC SURVEYS LTD. – NOVEMBER 17 2008.
4. FOR 8"-WF-CB42-3002 AND 2"-DF-CB28-6200 (CARBON STEEL PIPING) ISOMETRIC DRAWINGS AVAILABLE IN TURNOVER PACKAGE #10-PIPING OF RYFAN QA/QC.

AS-BUILT

LEGEND:

- FRESHWATER (WFR)
- SANITARY SEWER (SAN)
- SANITARY FORCED MAIN (DSP)
- TREATED EFFLUENT WATER (WET)
- FIRE WATER (WF)
- PIV VALVE
- FIRE HYDRANT 16"Ø FH)
- DIESEL FUEL (DF)
- 600V CONST. 5kV O/H POWER

8"-WF-CB42-3001
- LINE NUMBER
- PIPE MATERIAL CLASS
- SERVICE COMMODITY
- LINE SIZE

0 1:500 25

ENGINEER'S STAMP

NEWMONT. The Gold Company

CLIENT: HOPE BAY MINING LTD.

CLIENT DWG. NO.

SNC·LAVALIN

THIS DRAWING IS THE PROPERTY OF SNC-LAVALIN INC., AND THE USE AND COPYING THEREOF IS SUBJECT TO THE TERMS OF THE AGREEMENT UNDER WHICH IT WAS PROVIDED. THIS DRAWING MAY NOT BE COPIED EXCEPT AS EXPRESSLY PROVIDED THEREIN.

PROFESSIONAL ENGINEER | NAME | NO.

TITLE

HOPE BAY MINING LIMITED
DORIS NORTH INFRASTRUCTURE PROJECT

DORIS CAMP SITE SERVICES PLAN

	NAME (PRINT)	INIT.	DATE
DESIGNED	Jos A. CAVE	JC	08/07/10
DRAWN	C.H. LEONOR	CHL	08/07/11
CHECKED	R. UMENO	RU	08/07/14
APPROVED LEAD DWG.	R. UMENO	RU	08/07/23
APPROVED CHG. MAN.	R. UMENO	RU	08/07/25
APPROVED AREA MAN.	G. AKEHURST	GA	08/07/25
APPROVED CHG. DOCRS			
APPROVED AREA MAN.			
AS SHOWN			

PROJECT NO.	AREA	DISCPL.	DOC.	DRAWING NUMBER	LOC.	REVISION NUMBER
334499	1000	46	D1	0004		2

Format: Metric D (TRUE SCALE)

DWG. NO.	REFERENCES
1330-41D1-0004	TREATED SEWAGE EFFLUENT PIPELINE PLAN, PROFILE & SECTION
1330-41D1-0003	FRESHWATER SUPPLY & TREATED EFFLUENT – PLAN & SECTIONS

NO.	DATE	REVISIONS	BY	CHK	LEAD DISCPL.	CHIEF MAN.	AREA MAN.	CLIENT CHG.	CLIENT AREA
2	09/02/06	REVISED AS PER AS-BUILT INFORMATION	CHL	JMC	RU	RU	GA		
1	08/08/29	BENCH FILL LIMIT 25 AUG. 2008 ADDED	CHL	RU	RU	RU			
D	08/07/25	REVISED PIPE BENCH AND PIPELINES ISSUED FOR CONSTRUCTION	CHL	RU	RU	RU	GA		
PA	08/07/15	ISSUED FOR CLIENT'S APPROVAL	CHL	RU					

DATE: 2009/02/11 - 10:42am
PATH: Z:\334499 - HBML Doris 2008\46 - PRWMC\450K - Sketches-Drawings\1\334499-1000-46D1-0004.dwg