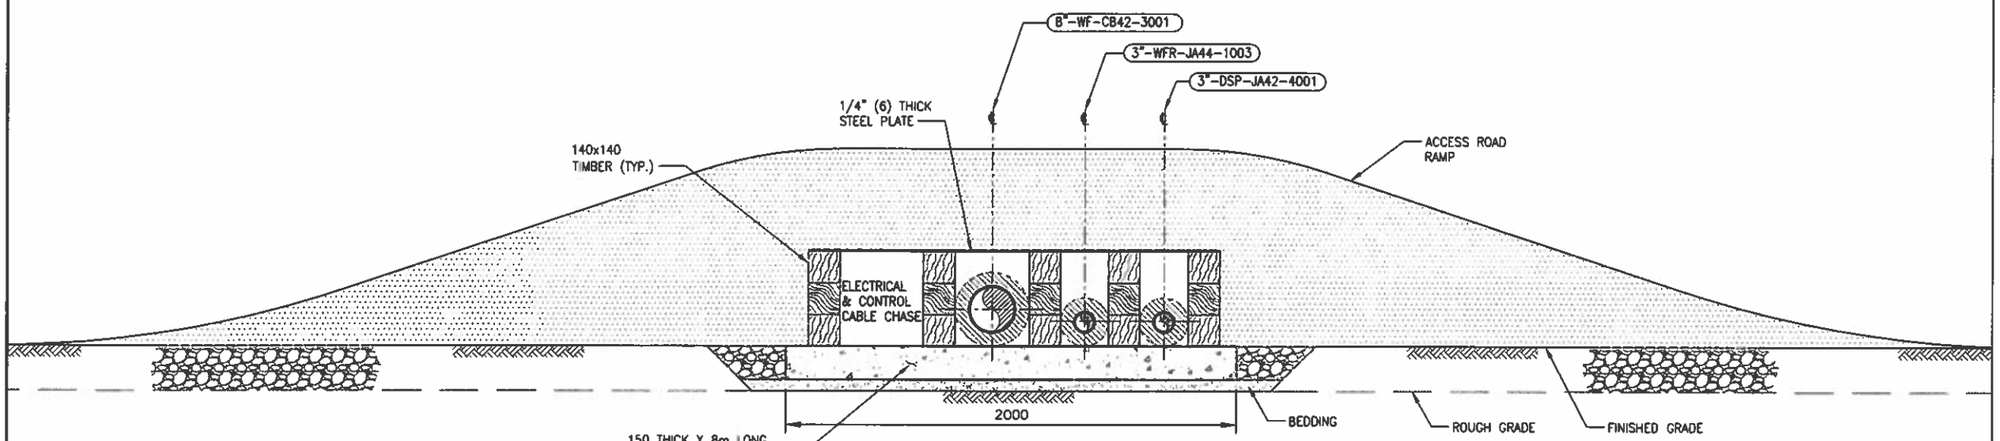

SECTION D 0004
SCALE: N.T.S.

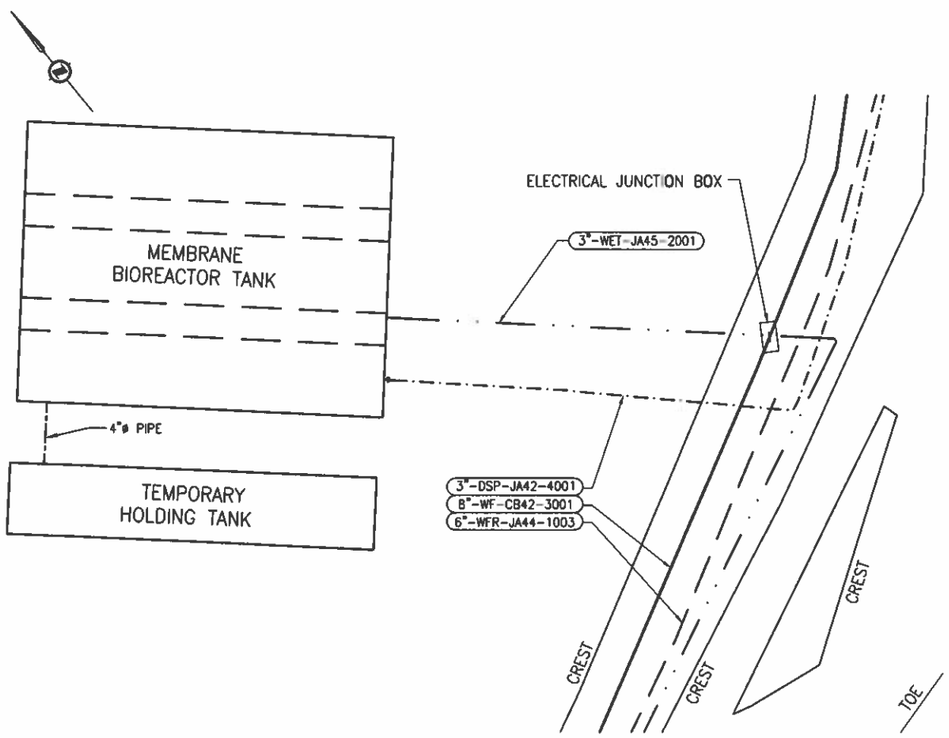

DETAIL 2 0004
SCALE: 1:100

NOTES:

1. ALL DIMENSIONS ARE IN MILLIMETRES AND ELEVATIONS ARE IN METRES UNLESS NOTED OTHERWISE.
2. FOR LEGEND, SPECIFICATIONS AND OTHER NOTES SEE DWG. 1000-4601-004.
3. FOR CONCRETE GENERAL NOTES AND STANDARD DETAILS SEE DWG. 0000-42D2-2001.

AS-BUILT

0 1:100 5

ENGINEER'S STAMP

NEWMONT. The Gold Company

CLIENT HOPE BAY MINING LTD.

CLIENT DWG. NO.

SNC·LAVALIN

THIS DRAWING IS THE PROPERTY OF SNC-LAVALIN INC., AND THE USE AND COPYING THEREOF IS SUBJECT TO THE TERMS OF THE AGREEMENT UNDER WHICH IT WAS PREPARED. THIS DRAWING MAY NOT BE COPIED EXCEPT AS EXPRESSLY PROVIDED THEREIN.

PROFESSIONAL ENGINEER | NAME | NO.

TITLE
HOPE BAY MINING LIMITED
DORIS NORTH INFRASTRUCTURE PROJECT

DORIS CAMP SITE SERVICES
SECTIONS & DETAILS – SHEET 3

DESIGNED	YUEN CHAN	YC	08/08/21
DRAWN	C.H. LEONOR	CHL	08/08/22
CHECKED	R. UMENO	RU	08/08/22
APPROVED LEAD ENG.	R. UMENO	RU	08/08/22
APPROVED ENG MAN.	G. AKEHURST	GA	08/08/22
APPROVED AREA MAN.			
APPROVED ENG. COORD.			
APPROVED AREA MAN.			
AS SHOWN	NAME (PRINT)	INIT.	DATE

PROJECT NO.	AREA	DISCPL.	DOC.	DRAWING NUMBER	LOC.	REVISION NUMBER
334499	1000	46	D1	0007		1

Format: Metric D (TRUE SCALE)

DWG. NO.	REFERENCES
1000-46D1-0008	DORIS CAMP SITE SERVICES SECTIONS & DETAILS – SHEET 2
1000-46D1-0005	DORIS CAMP SITE SERVICES SECTIONS & DETAILS – SHEET 1
1000-46D1-0004	DORIS CAMP SITE SERVICES PLAN

NO.	DATE	REVISIONS	BY	CHK	LEAD DISCPL.	ENG. MAN.	AREA MAN.	CLIENT ENG.	CLIENT AREA
1	09/02/06	REVISED AS PER AS-BUILT INFORMATION	CHL	JMC	RU	RU	GA		
PA	08/08/29	ISSUED FOR CONSTRUCTION	CHL	RU	RU	RU			

DATE: 2009/02/10 - 8:32am
PATH: J:\334499 - HBML Doris 2006\46 - PIPING\46DK - Sketches Drawings\334499-1000-46D1-0007.dwg