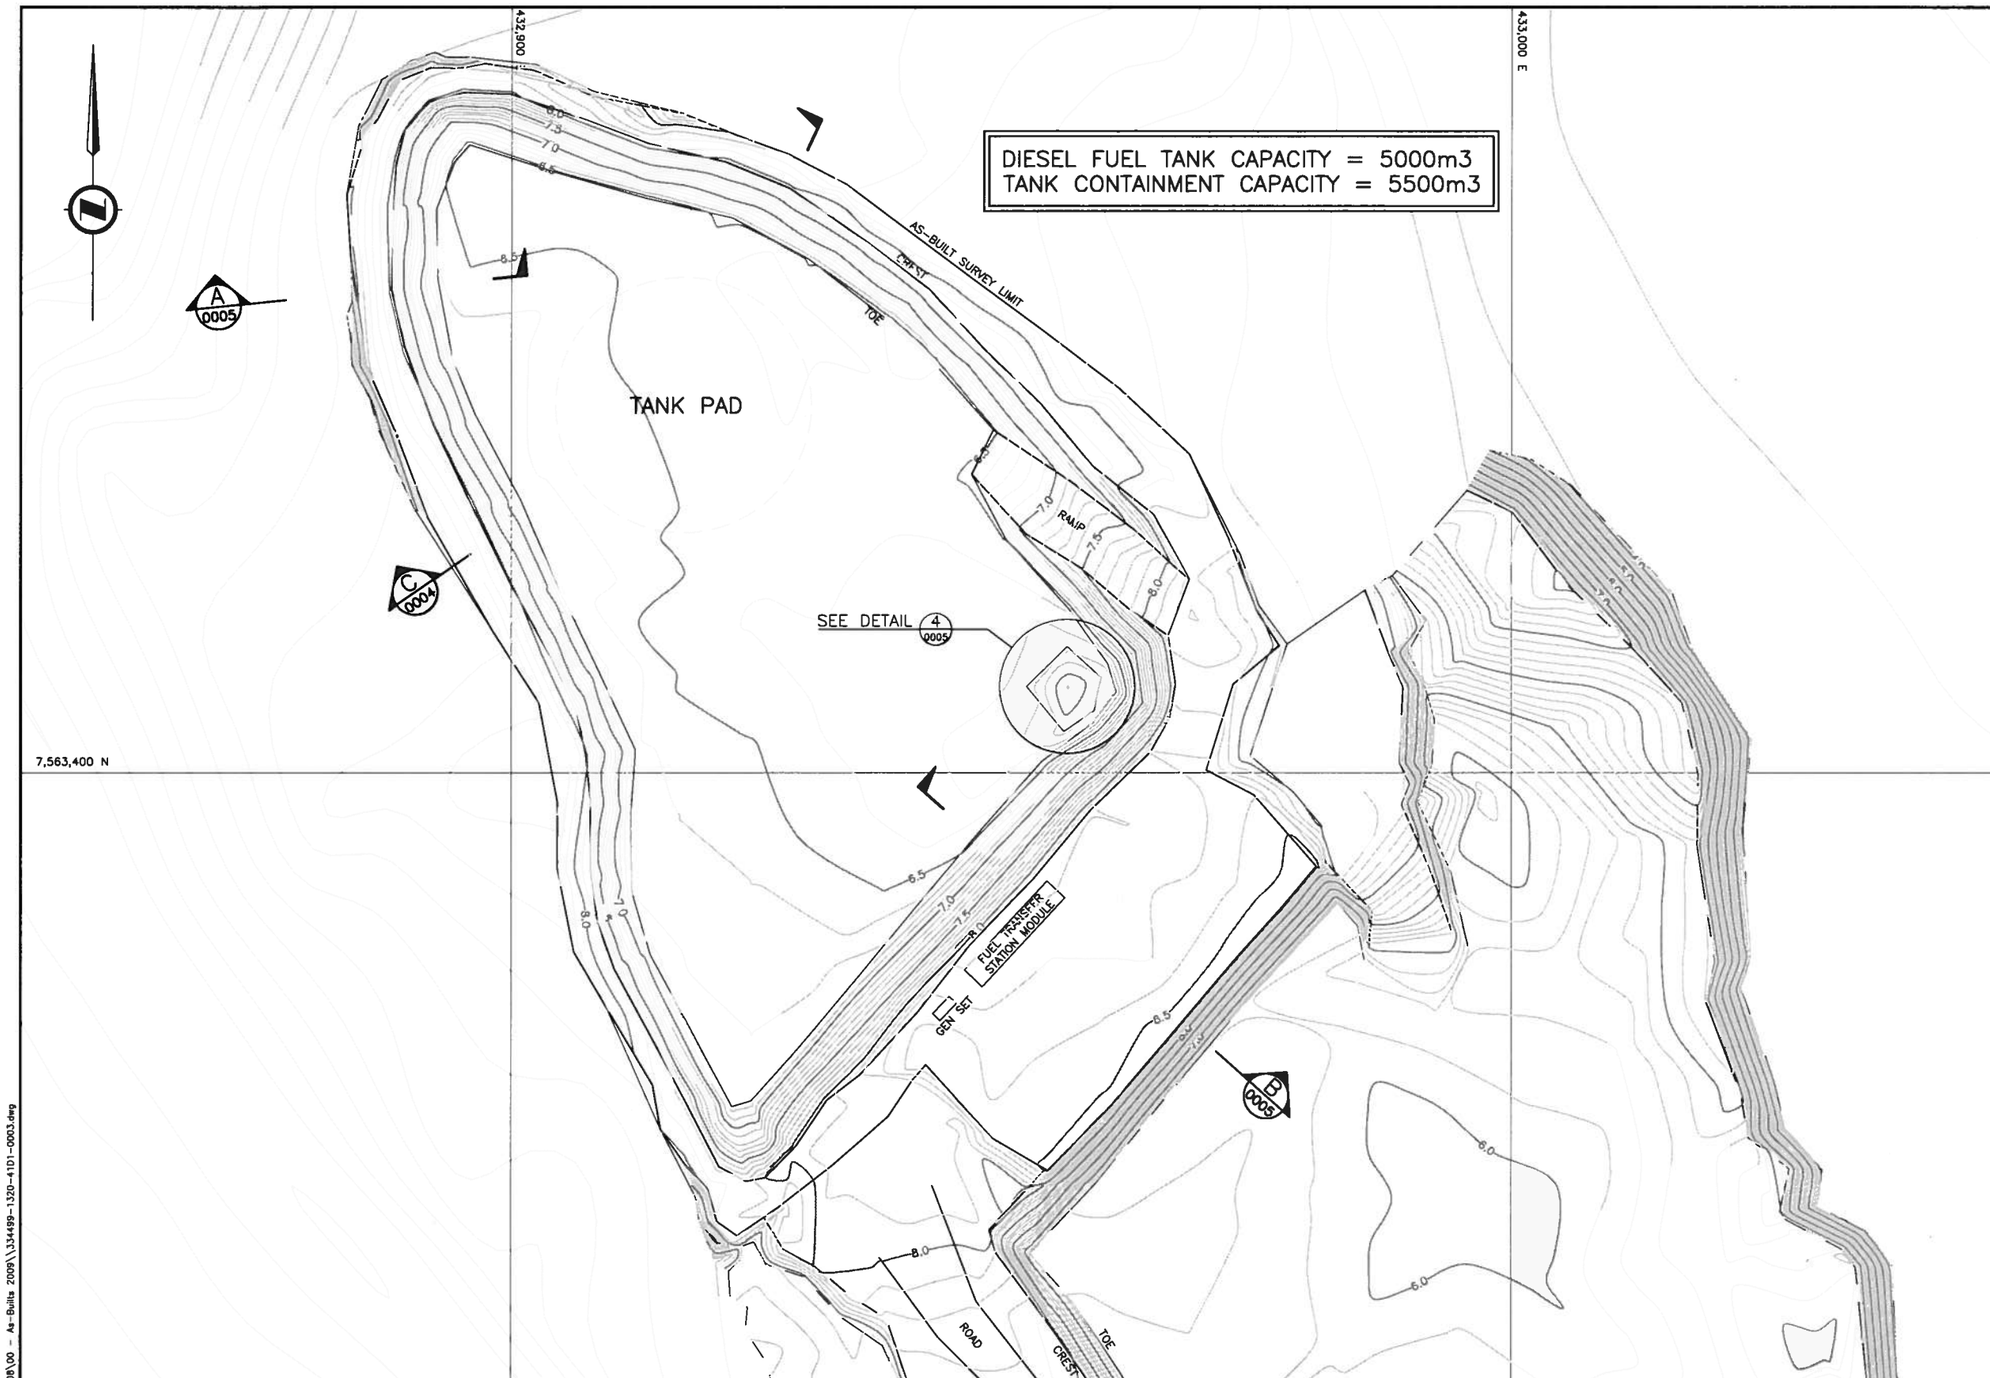

NOTES:

1. HORIZONTAL CONTROL IS UTM NAD 83 AND VERTICAL IS GEODETIC.
2. ALL DIMENSIONS AND ELEVATIONS ARE IN METRES UNLESS NOTED OTHERWISE.
3. AS-BUILT OF TANK FARM BASED ON SURVEY INFORMATION FROM SUB ARCTIC SURVEYS LTD. RECEIVED NOVEMBER 16, 2008.
4. AS-BUILT CONTOUR INTERVAL 0.1m.

AS-BUILT

0 1:300 15

ENGINEER'S STAMP

NEWMONT The Gold Company

CLIENT HOPE BAY MINING LTD.

CLIENT DWG. NO.

SNC·LAVALIN

THIS DRAWING IS THE PROPERTY OF SNC-LAVALIN INC., AND THE USE AND COPYING THEREOF IS SUBJECT TO THE TERMS OF THE AGREEMENT UNDER WHICH IT WAS PREPARED. THIS DRAWING MAY NOT BE COPIED EXCEPT AS EXPRESSLY PROVIDED THEREIN.

PROFESSIONAL ENGINEER | NAME | NO.

TITLE

HOPE BAY MINING LIMITED
DORIS 2008 PROJECT
ROBERTS BAY TANK FARM
FINAL GRADING
PLAN

PROJECT NO.	AREA	DISCPL.	DOC.	DRAWING NUMBER	LOC.	REVISION NUMBER
334499	1320	41	D1	0003		6

Format: Metric D (TRUE SCALE)

DWG. NO.	REFERENCES
1320-41D1-0006	ROBERTS BAY TANK FARM QUARRY AS-BUILT INFORMATION
1320-41D1-0005	ROBERTS BAY TANK FARM FINAL GRADING SECTIONS & DETAILS
1320-41D1-0004	ROBERTS BAY TANK FARM FINAL GRADING SECTION

NO.	DATE	REVISIONS	BY	CHK	LEAD DISCPL.	ENG. MAN.	AREA MAN.	CLIENT ENG.	CLIENT AREA
6	09/01/21	AS-BUILT UPDATED	ESL	JMG	RU	RU	GA		

NO.	DATE	REVISIONS	BY	CHK	LEAD DISCPL.	ENG. MAN.	AREA MAN.	CLIENT ENG.	CLIENT AREA
5	08/12/15	AS-BUILT AND DESIGN INCORPORATED	ESL	ARW	RU	RU	GA	DT	
4	08/08/12	REVISED CONTAINMENT TOE ELEVATION	CHL	RU	RU	RU	GA		
3	08/07/12	REVISED CONTAINMENT CREST	CHL	RU	RU	RU	GA	TL	
2	08/07/05	LAYOUT REVISED AS PER QUARRY SURVEY INFORMATION OF 27&30 JUN 2008 & 1 JUL 2008	CHL	RU	RU	RU	GA	TL	
1	08/06/23	LAYOUT REVISED FOR QUARRY AS-BUILT	CHL	RU	RU	RU			
0	08/06/11	ISSUED FOR CONSTRUCTION	CHL	RU					

ESL JG

SNC-LAVALIN INC.	NAME (PRINT)	INIT.	DATE
DESIGNED	C.H. LEONOR	CHL	08/06/05
DRAWN	C.H. LEONOR	CHL	08/06/06
CHECKED	R. UMENO	RU	08/06/11
APPROVED LEAD ENG.	R. UMENO	RU	08/06/23
APPROVED ENG. MAN.	R. UMENO	RU	08/06/23
APPROVED AREA MAN.	G. AKEHURST	GA	08/06/23
APPROVED ENG. COORD.			
APPROVED AREA MAN.			
CLIENT			
AS SHOWN			

DATE: 2009/02/12 - 9:57am
PATH: J:\334499 - HBML Doris 2008\00 - As-Builts 2009\334499-1320-41D1-0003.dwg