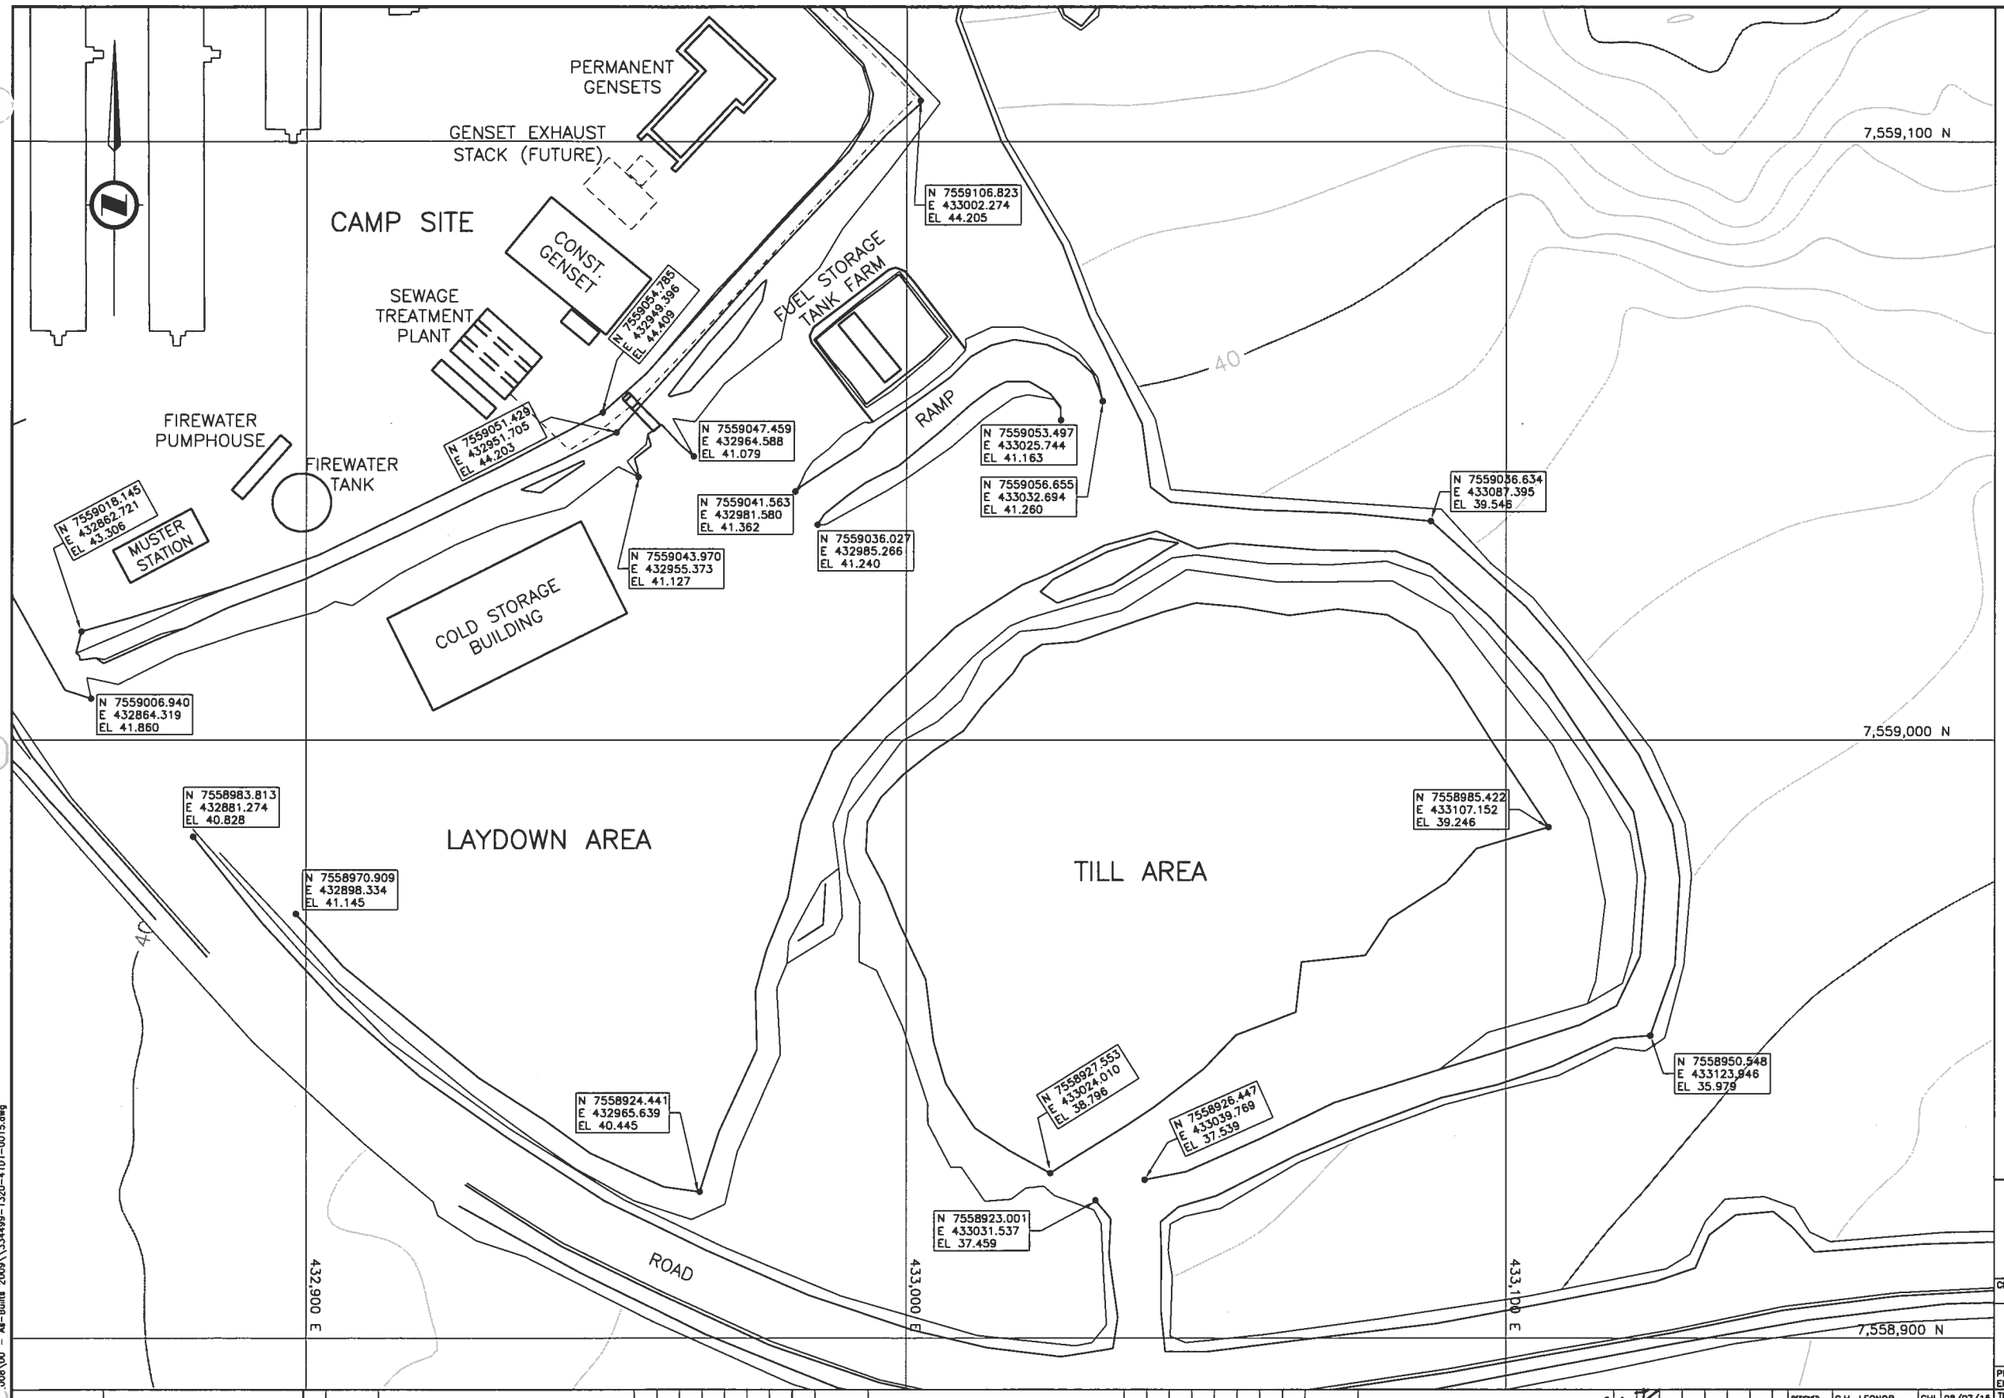

NOTES:

1. HORIZONTAL CONTROL IS UTM NAD 83 AND VERTICAL IS GEODETIC.
2. ALL DIMENSIONS AND ELEVATIONS ARE IN METRES UNLESS NOTED OTHERWISE.
3. AS BUILT INFORMATION PROVIDED BY SUB-ARCTIC SURVEYS LTD. - OCTOBER 27, 2008.

AS-BUILT

0 1:500 25

ENGINEER'S STAMP

ORIGINAL SIGNED BY R.W. LEONOR LICENSED 19/08/2008 NWT #L1158

NEWMONT. The Gold Company

CLIENT HOPE BAY MINING LTD.

CLIENT DWG. NO.

SNC·LAVALIN

THIS DRAWING IS THE PROPERTY OF SNC-LAVALIN INC., AND THE USE AND COPYING THEREOF IS SUBJECT TO THE TERMS OF THE AGREEMENT UNDER WHICH IT WAS PREPARED. THIS DRAWING MAY NOT BE COPIED EXCEPT AS EXPRESSLY PROVIDED THEREIN.

PROFESSIONAL ENGINEER | NAME | NO.

TITLE

HOPE BAY MINING LIMITED
DORIS NORTH INFRASTRUCTURE PROJECT

DORIS CAMP FINAL GRADING
PLAN – SHEET 2

SNC-LAVALIN INC.			
DESIGNED	C.H. LEONOR	CHL	08/07/15
DRAWN	C.H. LEONOR	CHL	08/07/15
CHECKED	J. CAVE	JC	08/07/17
APPROVED LEAD ENG.	R. UMENO	RU	08/07/18
APPROVED ENG. MAN.	R. UMENO	RU	08/07/18
APPROVED AREA MAN.	G. AKEHURST	GA	08/07/18
CLIENT			
APPROVED ENG. COORD.			
APPROVED AREA MAN.			
UNIT	AS SHOWN	NAME (PRINT)	INIT.	DATE

PROJECT NO.	AREA	DISCPL.	DOC.	DRAWING NUMBER	LOC.	REVISION NUMBER
334499	1320	41	D1	0015		3

Format: Metric D (TRUE SCALE)

DWG. NO.	REFERENCES
1320-4101-0017	DORIS CAMP FINAL GRADING SECTIONS & DETAILS – SHEET 2
1320-4101-0016	DORIS CAMP FINAL GRADING SECTIONS & DETAILS – SHEET 1
1320-4101-0014	DORIS CAMP FINAL GRADING PLAN – SHEET 1

NO.	DATE	REVISIONS	BY	CHK	LEAD DISCPL.	ENG. MAN.	AREA MAN.	CLIENT ENG.	CLIENT AREA
3	09/01/21	AS-BUILT	ESL	JMG	RU	RU	GA		
2	08/09/17	REVISED FUEL CONTAINMENT TYPE AND COLD STORAGE BUILDING LOCATION	CHL	RU	RU	RU			
1	08/08/07	LOWER BENCH SAFETY BERM ADDED, REVISED SERVICE ROAD,DELETED DRAINAGE CHANNEL BERM & DITCH	CHL	RU	RU	RU	GA		
0	08/07/24	ISSUED FOR CONSTRUCTION	CHL	JC	RU	RU	GA		
PA	08/07/19	ISSUED FOR CLIENT'S APPROVAL	CHL	RU	RU	RU	GA		

DATE: 2009/02/12 – 9:14
PATH: J:\334499 – HBML D\008\00 – As-Builts 2009\1\334499-1320-4101-0015.dwg