



C:\GT_SITES\Hope Bay\North Dam\2015 Annual Inspection\1CT022.001__GT-2015.dwg

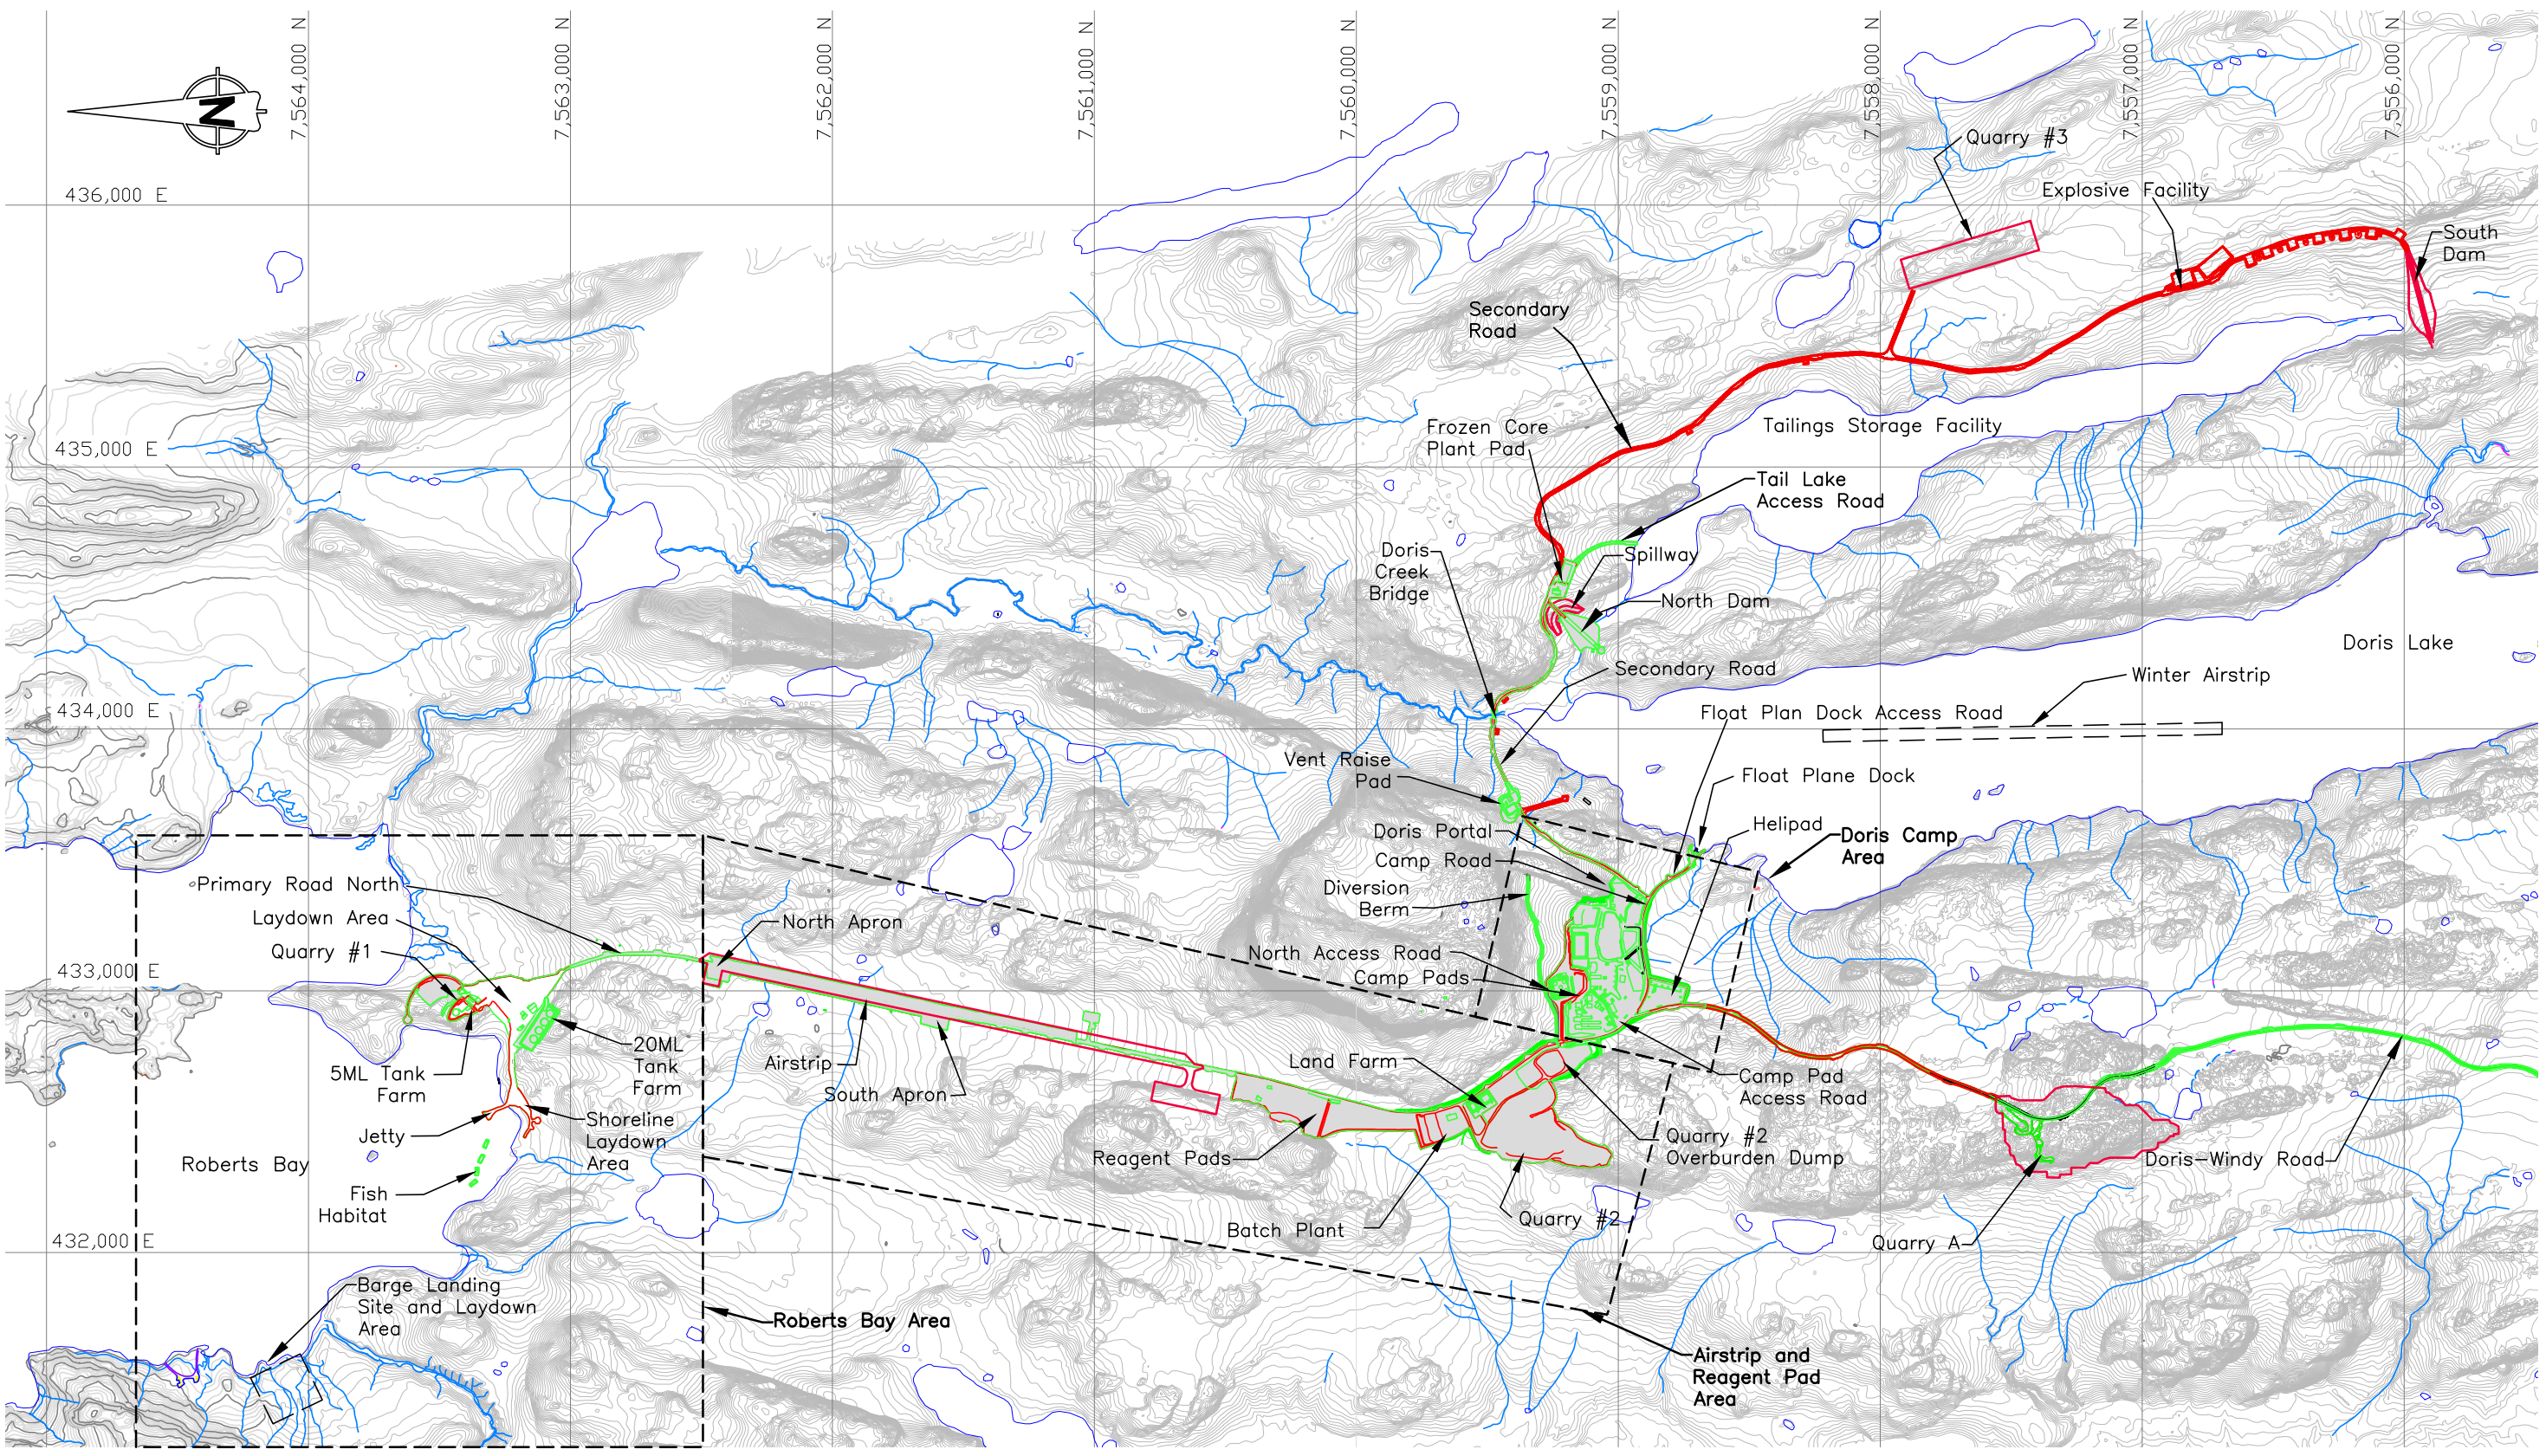

LEGEND

Asbuilt

Licenced but not yet constructed

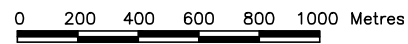

| | | | | |
|---|--------------------------|-------------------------------|-----------------|--------------|
| SRK JOB NO.: 1CT022.002 FILE NAME: 1CT022.001__GT-2015.dwg | HOPE BAY MINING LTD. | 2015 Geotechnical Inspection | | |
| | | Overall Site Layout (Sheet 1) | | |
| | | DATE: Aug. 2015 | APPROVED: LW | FIGURE: 2 |