NO. DESSIN DRAWING NO. 65-417-230-223_R1 (AS BUILT)

FORMAT ARCHD

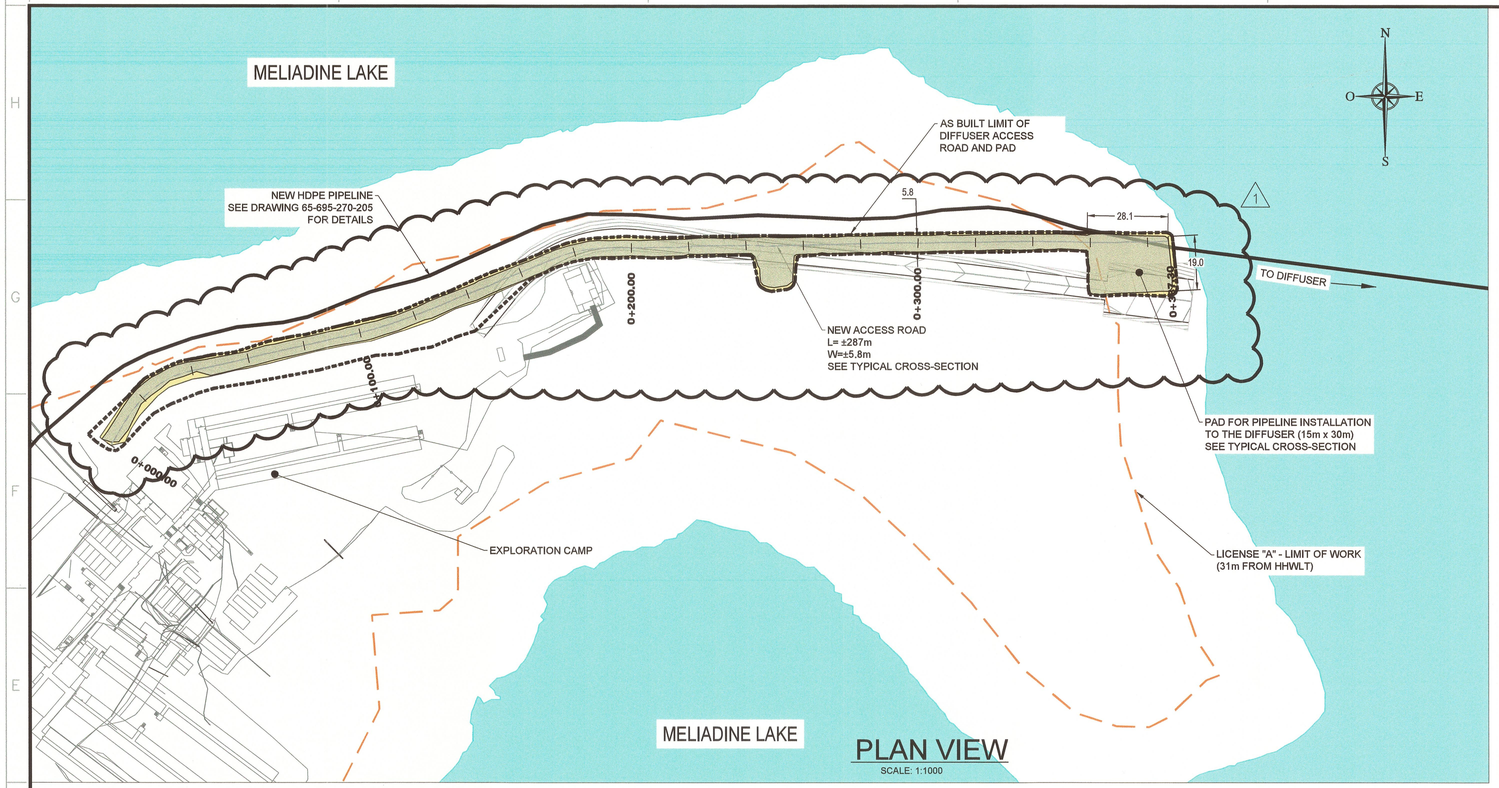

PLAN VIEW

SCALE: 1:1000

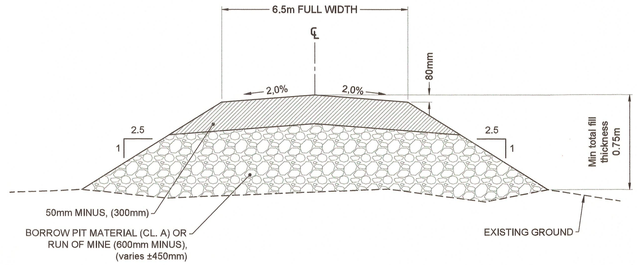

TYPICAL CROSS SECTION
TEMPORARY SERVICE ROAD AND PAD

SCALE: NTS

Quantity construction chart* Temporary Diffuser Access Road and Pad *Theoretical measure in place quantities		
	Thickness (mm)	Required (m^3)
50mm MINUS	300	587
Run of Mine or Borrow Pit Material (CL. A)	±450	3011
Total	-	3598

TEL QUE CONSTRUIT
AS BUILT
AGNICO EAGLE
DATE : 2018-09-14

TETRA TECH

FINAL ISSUE
AFTER CONSTRUCTION

SOME ANNOTATIONS HAVE BEEN ADDED TO THE DRAWING ISSUED FOR CONSTRUCTION IN ORDER TO INCORPORATE THE INFORMATIONS RECIEVED. IN THIS PROJECT, TETRATECH HADN'T DONE ANY FIELD SUPERVISION AT THE CONSTRUCTION SITE.

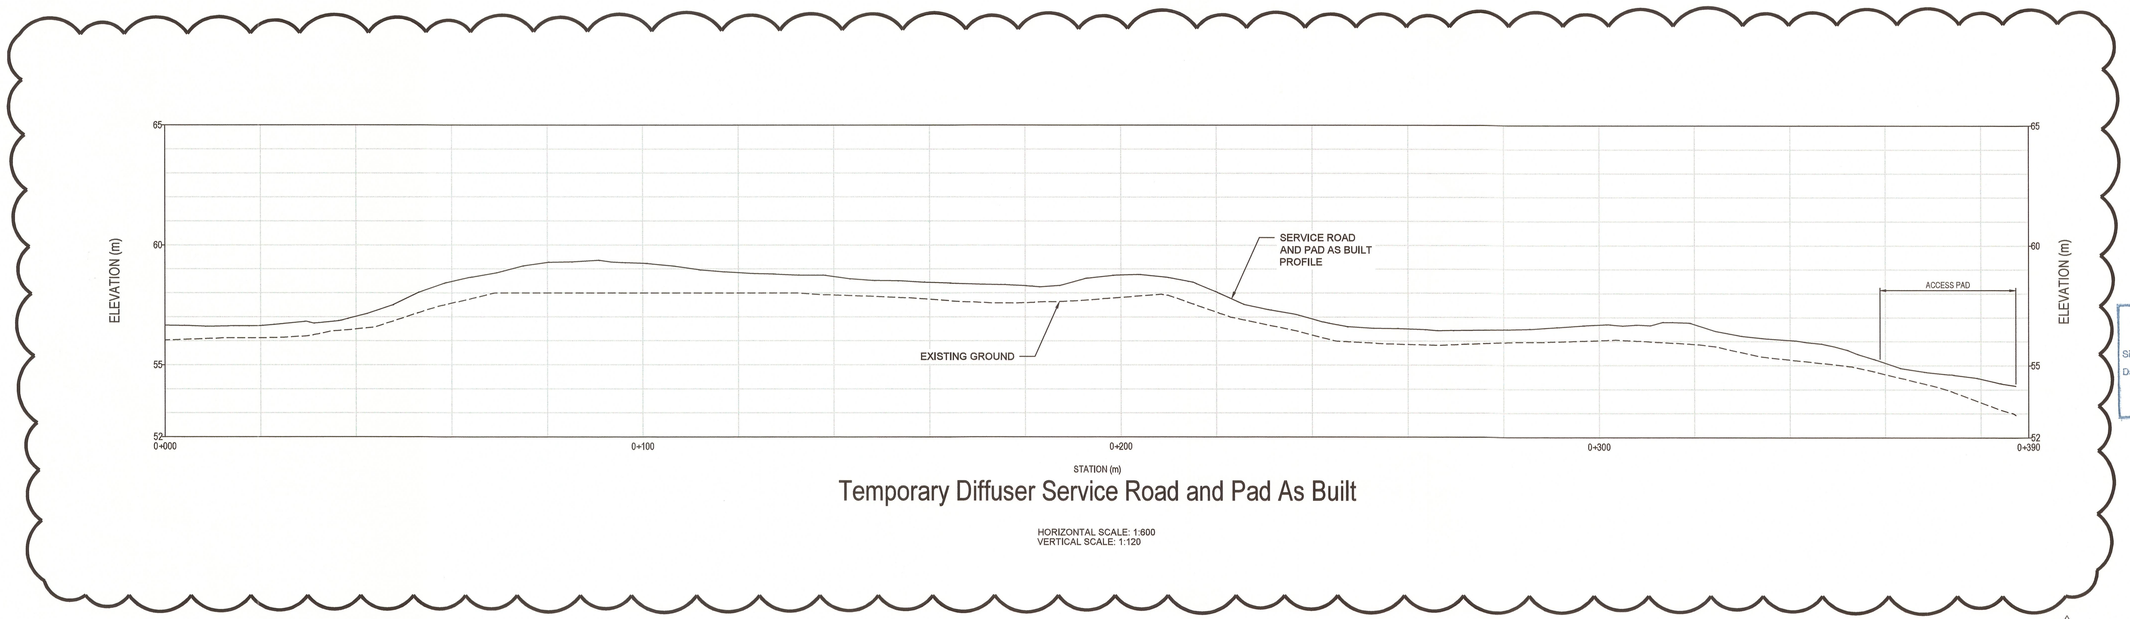

Temporary Diffuser Service Road and Pad As Built

HORIZONTAL SCALE: 1:600
VERTICAL SCALE: 1:120

1

PLAN DE LOCALISATION
KEY PLAN

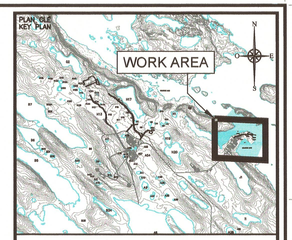

TETRA TECH

NOTES GÉNÉRALES / GENERAL NOTES

GENERAL NOTE:
1. EXISTING GROUND DTM PROVIDED BY AEM.
2. ALL UNITS ARE IN METERS.
3. ELEVATIONS IN DRAWING PROVIDE FINISHED GRADE ELEVATIONS AT THE TOP OF THE SURFACE GRAVEL LAYER.
4. THE CONTRACTOR SHALL BE RESPONSIBLE FOR THE SAFETY, SECURITY AND SLOPES OF ALL EXCAVATIONS/ BACKFILL AND SHALL ABIDE BY ALL RELEVANT STANDARDS AND REGULATIONS. THE STABILITY, DEWATERING AND MAINTENANCE OF ALL EXCAVATIONS SHALL BE THE CONTRACTOR'S RESPONSIBILITY.
5. GRANULAR MATERIAL SHALL BE PLACED IN LIFTS NOT EXCEEDING 300mm AND COMPACTED TO A MINIMUM OF 95% OF MAXIMUM DRY DENSITY. BORROW PIT OR RUN OF MINE MATERIAL 600mm MINUS SHALL BE PLACED IN LIFTS NOT EXCEEDING 600mm AND COMPACTED TO A MINIMUM OF 90% OF MAXIMUM DRY DENSITY. MOISTURE CONDITIONING MAY BE REQUIRED PRIOR TO COMPACTION.

L'INFORMATION CI-CONTENUE EST LA PROPRIÉTÉ DE AGNICO EAGLE LTÉE ET DOIT ÊTRE RETOURNÉE SUR DEMANDE. SANS AUTORISATION ÉCRITE PRÉALABLE, TOUTE TRANSMISSION DE COPIES À AUTRUI ET TOUTE UTILISATION AUTRE QUE CELLE POUR LAQUELLE L'INFORMATION EST PRÊTÉE SONT INTERDITES. © AGNICO EAGLE LTÉE

THE INFORMATION HERE ON IS THE PROPERTY OF AGNICO EAGLE LTD. AND MUST BE RETURNED UPON REQUEST. WITHOUT WRITTEN PERMISSION, ANY COPYING TRANSMITTAL TO OTHERS AND ANY USE EXCEPT THAT FOR WHICH IT IS LOANED ARE PROHIBITED. © AGNICO EAGLE LTD.

DESSINS EN RÉFÉRENCE / REFERENCE DRAWINGS

TITRE / TITLE	# DWG
RELEVÉ TQC 2016	65-000-210-200
--	--
--	--
--	--
--	--
--	--

AGNICO EAGLE

REV.	DATE	DESCRIPTION	PAR/BY	APP.	CLIENT
1	2018-09-14	ISSUE FOR AS BUILT	M.S.	J.A.	
0	2017-06-14	ISSUED FOR CONSTRUCTION	C.M.	J.A.	

REVISIONS

PERMIT TO PRACTICE
TETRA TECH INDUSTRIES, INC.
O/A TETRA TECH
Signature
Date 2018-09-18
PERMIT NUMBER: P 1029
NT/NU Association of Professional Engineers and Geoscientists

REGISTERED PROFESSIONAL ENGINEER
J.M.I.F. ALARIE
LICENSEE
2018-09-18

TITRE / TITLE
AGNICO EAGLE – MELIADINE DIVISION
417 – ROADS, YARDS, FENCES, AND OTHER
230 – GENERAL EARTH WORKS
MELIADINE LAKE DIFFUSER TEMPORARY SERVICE ROAD
PLAN AND PROFILE VIEW

DESSINÉ PAR / DRAWN BY	CHRISTOPHER MORIN	DATE 2017-04-26
VERIFIÉ PAR / CHECKED BY	SOLÈNE MOREAU	2017-04-26
APPROUVÉ PAR / APPROVED BY	JOSÉE ALARIE	2017-04-26
ÉCHELLE / SCALE	AS SHOWN	DATE 2016-04-26
NO. DESSIN / DRAWING NO.	65-417-230-223	
NO. PROJET / PROJECT NO.	6515/28920	REVISION 1
		FEUILLE / SHT 1 / 1

AE-CART-ARCH D

P:\28920\DESSIN\CIV-INFRA\DESSINS DE TRAVAIL\AUTOCAD\65-417-230-223_R1 (AS BUILT).dwg-2013-02-19 14:03:29

FILE NO. 65-417-230-223_R1 (AS BUILT).dwg