DWG. NO. H349000-4000-00-014-0018

E 559 200 E 559 400 E 559 600 E 559 800

N 7 914 200
N 7 914 000
N 7 913 800

AERODROME APRON
EXISTING TOTE ROAD
7432-BLD-007 AERODROME WAITING ROOM WASHCAR
RAMP TO AERODROME NOT CONSTRUCTED. SEE NOTE 5.
4431-BLD-001 AERODROME OFFICE
7432-BLD-005/006 AERODROME WAITING ROOMS
4435-BLD-001 AERODROME FIELD ELECTRIC CENTER (FEC)
4750-BLD-006 E-HOUSE #6 AERODROME AREA
AERODROME RUNWAY
4521-BLD-002 WAREHOUSE BUILDING
TOTE ROAD
TOTE ROAD NOT CONSTRUCTED. SEE NOTE 5
LAYDOWN AREA NOT CONSTRUCTED. SEE NOTE 5.
UTILITY CORRIDOR
EXISTING TOTE ROAD
PAPI LIGHTS
WIND SOCK
5kV JUNCTION BOX

0 15 30 45 60 75
SCALE IN METRES

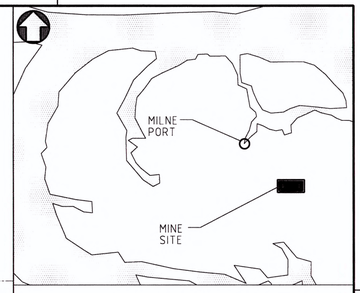

KEY-PLAN

LEGEND:

- PIPE LINE & ELECTRICAL
- PIPE LINE
- ELECTRICAL ABOVE GRADE
- ROAD CROSSING
- ELECTRICAL BELOW GRADE

NOTES:

1. TOPOGRAPHY PROVIDED BY TERRAPOINT CANADA INC.
2. COORDINATE GRID IS SHOWN IN UTM (NAD83) ZONE 17 AND IS IN METRES.
3. CONTOURS ARE IN METRES. CONTOUR INTERVAL IS 1.5 METRES.
4. FOR FOLD-AWAY BUILDINGS SETOUT COORDINATES REFER TO APPLICABLE FOUNDATION DRAWINGS.
5. NOT CONSTRUCTED (FUTURE WORK) AS INDICATED.

DRAWING NO.	DRAWING TITLE
REFERENCE DRAWINGS	

THIS AS-BUILT DOCUMENT HAS BEEN PREPARED BASED ON INFORMATION PROVIDED BY THIRD PARTIES. HATCH HAS NOT VERIFIED THE ACCURACY OR COMPLETENESS OF THIS INFORMATION AND SHALL NOT BE RESPOSIBLE FOR, AND DISCLAIMS ANY LIABILITY IN CONJUNCTION WITH, ANY ERRORS OR OMISSIONS THAT MAY BE INCORPORATED HEREIN AS A RESULT.

THIS DRAWING WAS PREPARED FOR THE EXCLUSIVE USE OF BAFFINLAND IRON CORPORATION ("CLIENT") AND IS ISSUED PURSUANT TO CONTRACT AGREEMENT BETWEEN CLIENT AND HATCH. HATCH'S DUTY OR USE OF THIS DRAWING (AS DEFINED IN THE CONTRACT) AND ANY AND ALL LIABILITY OR RESPONSIBILITY ARISING FROM ANY USE OF OR RELIANCE ON THIS DRAWING BY ANY THIRD PARTY OR ANY MODIFICATION OR CHANGE TO THIS DRAWING BY CLIENT AND (II) THIS DRAWING OR ANY PART THEREOF, AS WELL AS ALL RIGHTS EMBODIED OR REFERENCED IN THIS DRAWING REMAIN THE PROPERTY OF HATCH.

NO.	DESCRIPTION	BY	CHK'D	APP'D	DATE
REVISIONS					

AS BUILT

REVISED AS MARKED. ALL OTHER DETAILS CONSTRUCTED WITHIN ACCEPTABLE TOLERANCES.

REV.	ISSUE FOR	AUTH. BY	DATE
0	AS BUILT	S.H / J.C	2015-02-09
ISSUE AUTHORIZATION			

HATCH™

DESIGNED BY T. THERTELL DATE 2015-02-09	DRAWN BY J. BAJACIC DATE 2015-02-09
CHECKED BY S. HESS DATE 2015-02-09	DISCIP. ENGR. S. HESS DATE 2015-02-09
PROJ. DES. COORD. T. THERTELL DATE 2015-02-09	PROJ. ENGR. J. CLELAND DATE 2015-02-09
PROJ. MGR. J. CLELAND DATE 2015-02-09	

Baffinland

MARY RIVER PROJECT

MINE SITE
INFRASTRUCTURE & UTILITIES
SITE LAYOUT

SCALE	DWG. NO.	REV.
1:1500 OR AS NOTED	H349000-4000-00-014-0018	0

ORIGINAL SHEET SIZE: ISO A1 (841 x 594)

DWG. NO. H349000-4000-00-014-0019

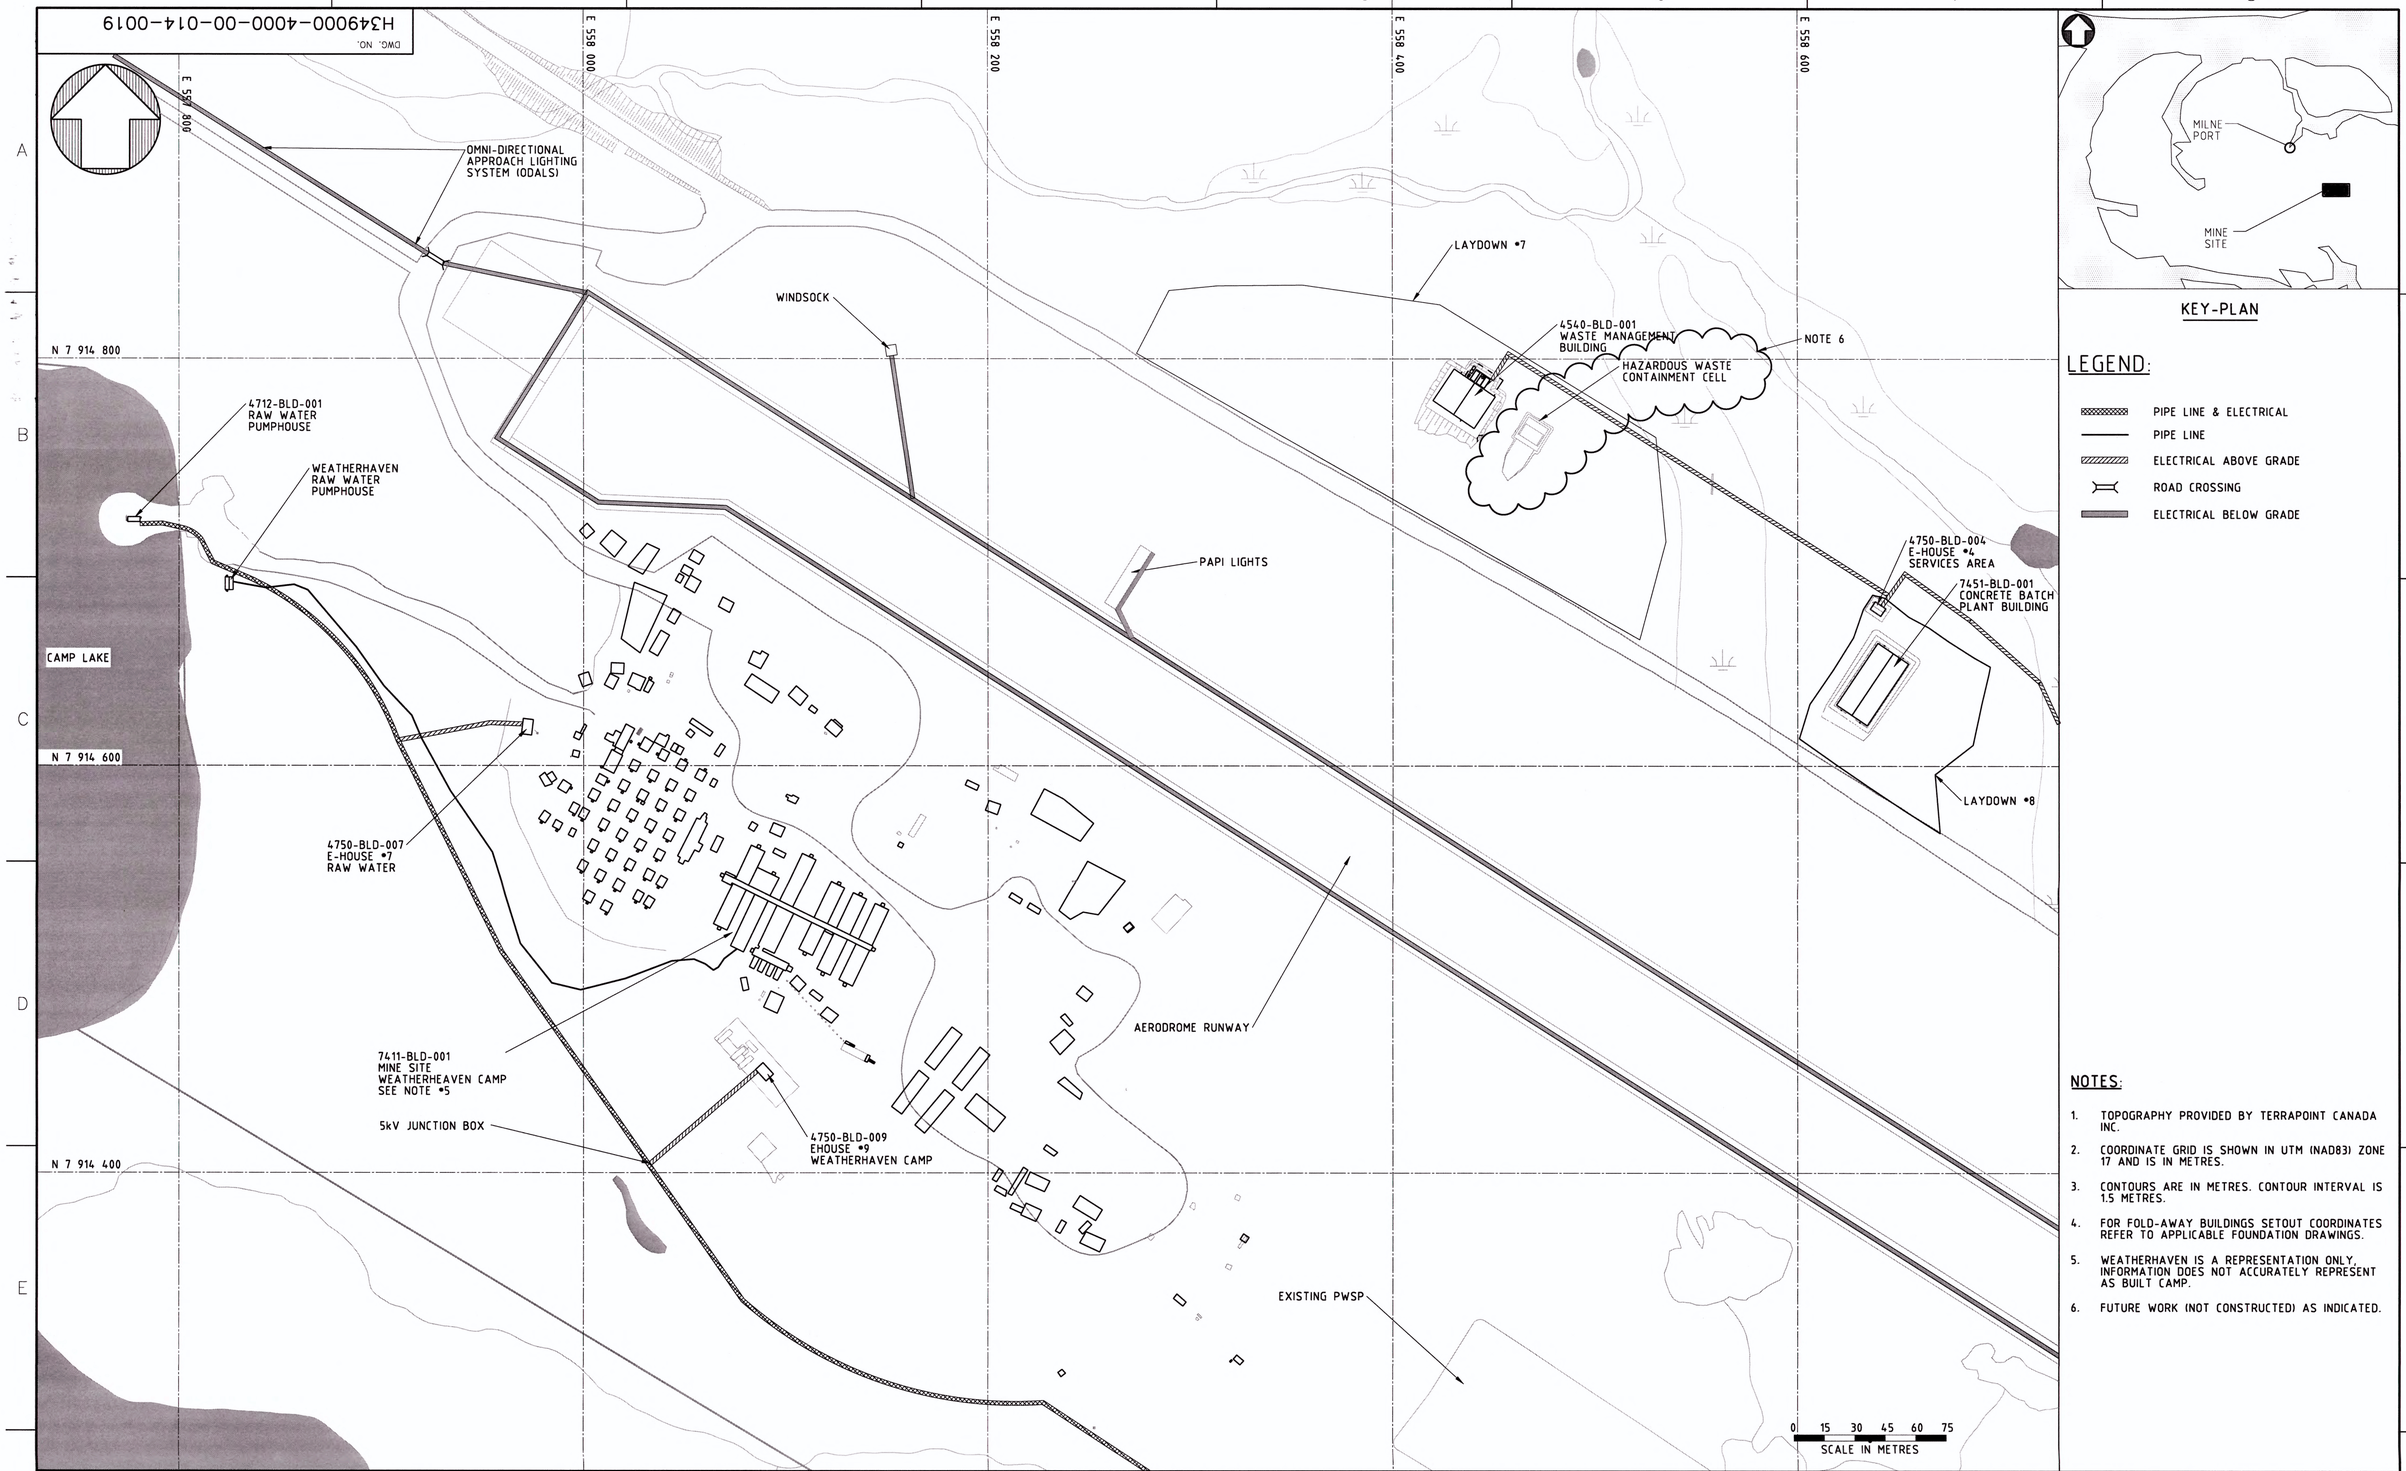

KEY-PLAN

LEGEND:

- PIPE LINE & ELECTRICAL
- PIPE LINE
- ELECTRICAL ABOVE GRADE
- ROAD CROSSING
- ELECTRICAL BELOW GRADE

NOTES:

1. TOPOGRAPHY PROVIDED BY TERRAPOINT CANADA INC.
2. COORDINATE GRID IS SHOWN IN UTM (NAD83) ZONE 17 AND IS IN METRES.
3. CONTOURS ARE IN METRES. CONTOUR INTERVAL IS 1.5 METRES.
4. FOR FOLD-AWAY BUILDINGS SETOUT COORDINATES REFER TO APPLICABLE FOUNDATION DRAWINGS.
5. WEATHERHAVEN IS A REPRESENTATION ONLY. INFORMATION DOES NOT ACCURATELY REPRESENT AS BUILT CAMP.
6. FUTURE WORK (NOT CONSTRUCTED) AS INDICATED.

REFERENCE DRAWINGS	
DRAWING NO.	DRAWING TITLE
H349000-4613-10-014-0001	MINE SITE – EARLY REVENUE PHASE – SITE G.A.

THIS AS-BUILT DOCUMENT HAS BEEN PREPARED BASED ON INFORMATION PROVIDED BY THIRD PARTIES. HATCH HAS NOT VERIFIED THE ACCURACY OR COMPLETENESS OF THIS INFORMATION AND SHALL NOT BE RESPOSIBLE FOR, AND DISCLAIMS ANY LIABILITY IN CONJUNCTION WITH, ANY ERRORS OR OMISSIONS THAT MAY BE INCORPORATED HEREIN AS A RESULT.

THIS DRAWING WAS PREPARED FOR THE EXCLUSIVE USE OF BAFFINLAND IRON ORE MINES CORPORATION AND IS NOT TO BE USED FOR ANY OTHER PURPOSE OR PROJECT WITHOUT THE EXPRESS WRITTEN CONSENT OF HATCH. UNLESS OTHERWISE AGREED IN WRITING WITH CLIENT OR SPECIFIED IN USER DRAWING, (A) HATCH DOES NOT ACCEPT AND DISCLAIMS ANY AND ALL LIABILITY OR RESPONSIBILITY ARISING FROM ANY USE OF OR RELIANCE ON THIS DRAWING BY ANY THIRD PARTY OR ON ANY MODIFICATION OR MISUSE OF THIS DRAWING BY CLIENT, AND (B) THIS DRAWING IS CONFIDENTIAL AND ALL INTELLECTUAL PROPERTY RIGHTS EMBODIED OR REFERENCED IN THIS DRAWING REMAIN THE PROPERTY OF HATCH.

REVISIONS					
NO.	DESCRIPTION	BY	CHK'D	APP'D	DATE

AS BUILT

REVISED AS MARKED. ALL OTHER DETAILS CONSTRUCTED WITHIN ACCEPTABLE TOLERANCES.

ISSUE AUTHORIZATION				
REV.	ISSUE FOR	AUTH. BY		DATE
0	AS BUILT	S.H	J.C	2015-02-06

HATCH

DESIGNED BY	T. THERTELL	DRAWN BY	J. BAJAGIC
DATE	2015-02-06	DATE	2015-02-06
CHECKED BY	S. HESS	DISCIP. ENGR.	S. HESS
DATE	2015-02-06	DATE	2015-02-06
PROJ. DES. COORD.	T. THERTELL	PROJ. ENGR.	J. CLELAND
DATE	2015-02-06	DATE	2015-02-06
PROJ. MGR.	J. CLELAND		
DATE	2015-02-06		

Baffinland

MARY RIVER PROJECT

MINE SITE
INFRASTRUCTURE & UTILITIES
SITE LAYOUT

SCALE	DWG. NO.	REV.
1:1500 OR AS NOTED	H349000-4000-00-014-0019	0

ORIGINAL SHEET SIZE: ISO A1 (841 x 594)