

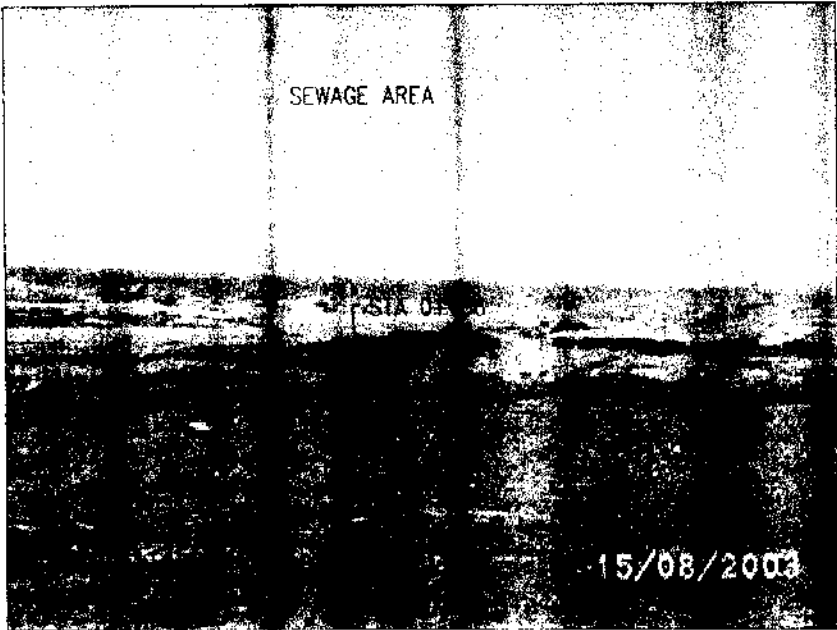
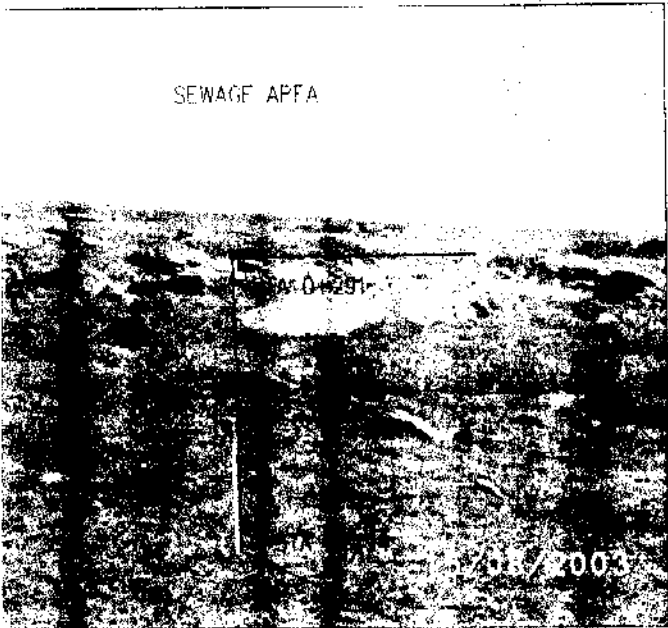
 
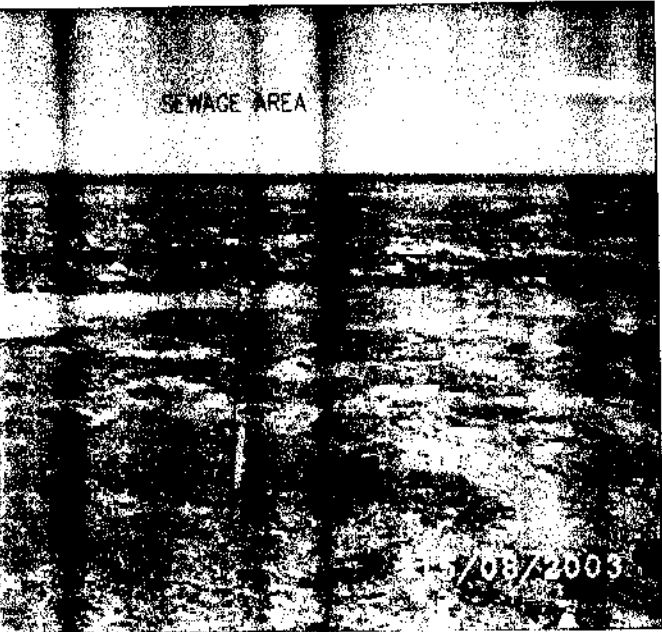


Part 1




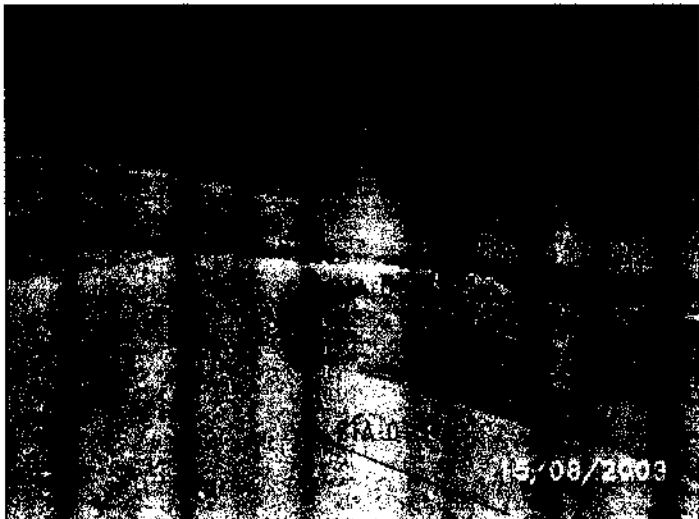


PROPOSED EXTENSION 100 M

100 M X 10 M CULVERT, THAT WAS TO BE
 OR DUMP SITE. INVERT ELEVATION 32.3
 AND TO KEEP SEWAGE DEPTH AS DEEP AS
 POSSIBLE AS TO ENCOURAGE BACTERIAL DECOMPOSITION
 AND AS CREATING HEAT, THIS WOULD COVER THE WHOLE
 AREA, CUTTING BACK ON SMELL, BREAKING DOWN OF
 WATER LOSS BY EVAPORATION AND IF ENOUGH VOLUME
 BE KEPT IN LAGOON, THERE MAY BE ENOUGH HEAT GENERATED
 TO PART OF THE LAGOON FROM FREEZING THIS WOULD STOP THE
 AREA FROM BUILDING UP WITH ICE IN WINTER.

 


Part 2

 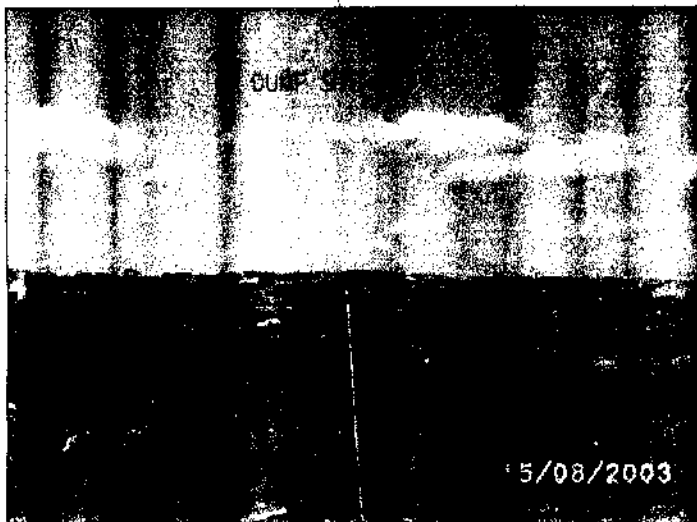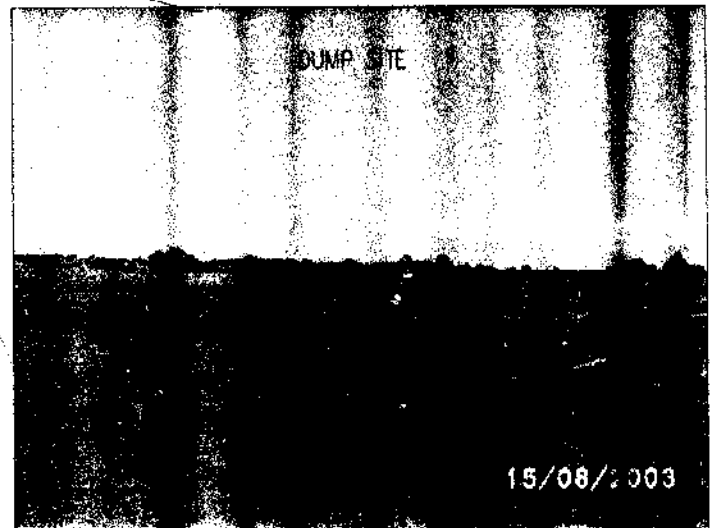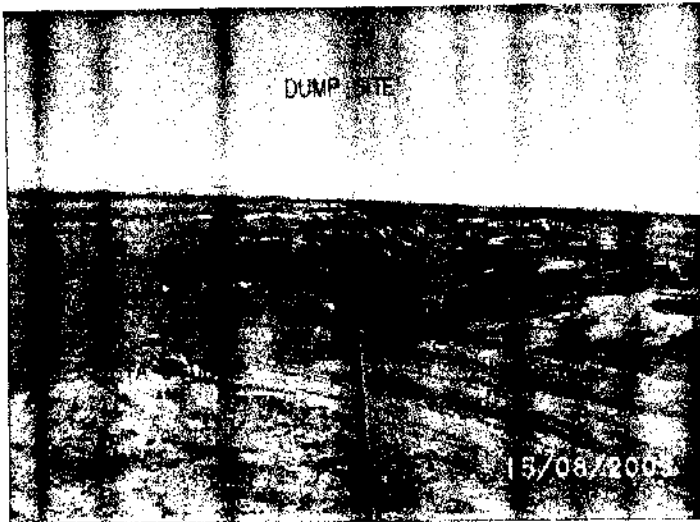

GOVERNMENT OF NUNAVUT
DEPARTMENT OF COMMUNITY GOVERNMENT
AND TRANSPORTATION — KIVALLIO REGION

CORAL HARBOUR, NUNAVUT

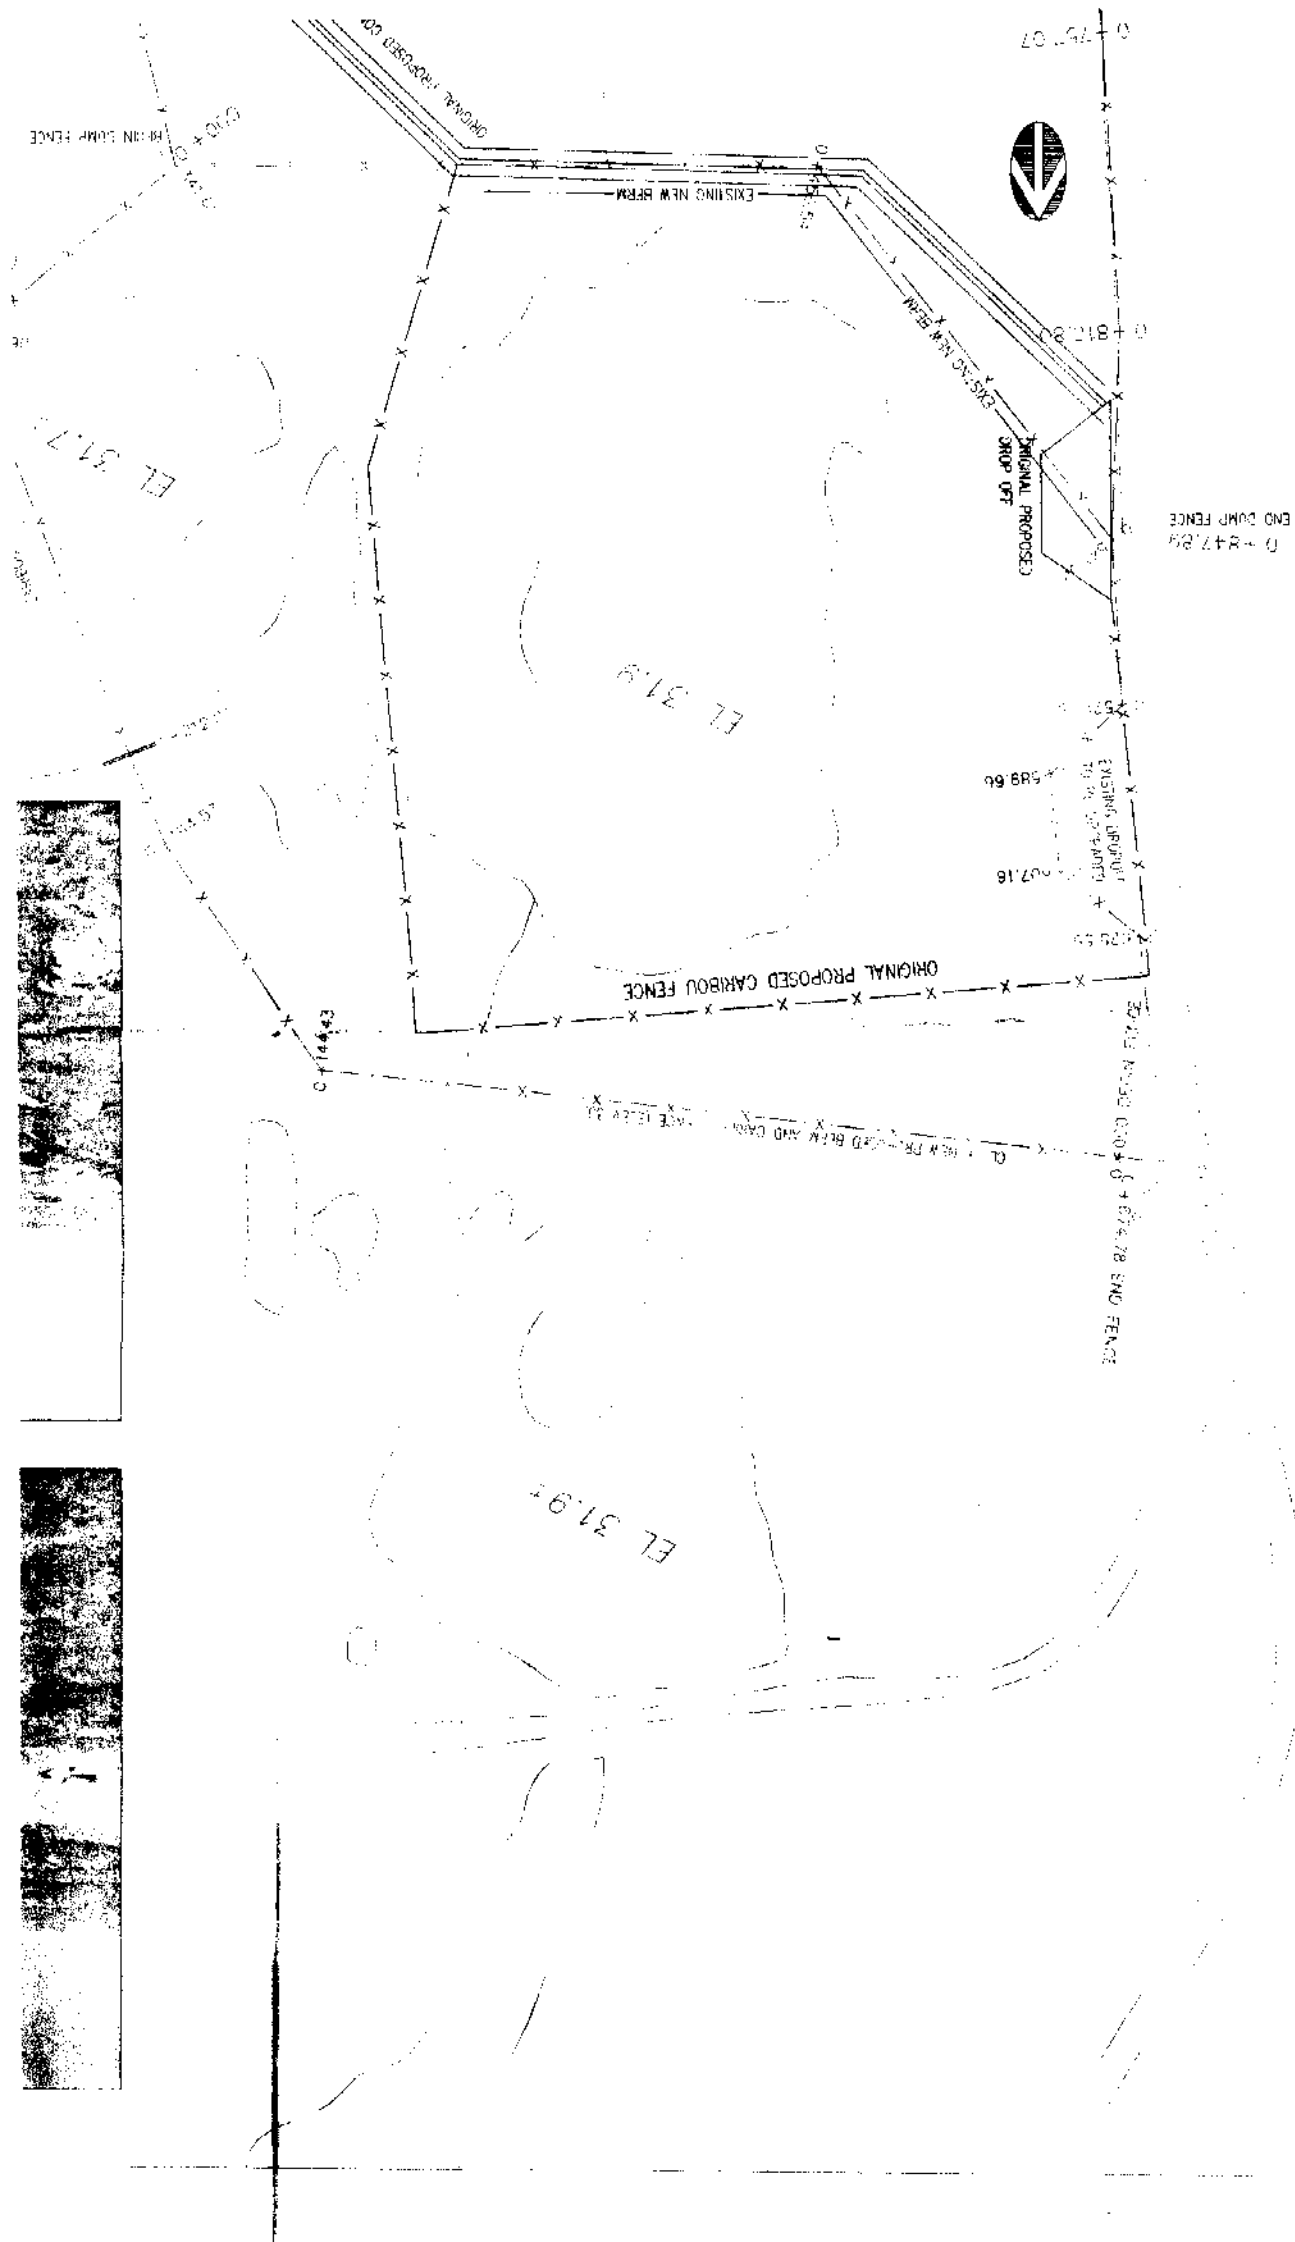

Part 4

