



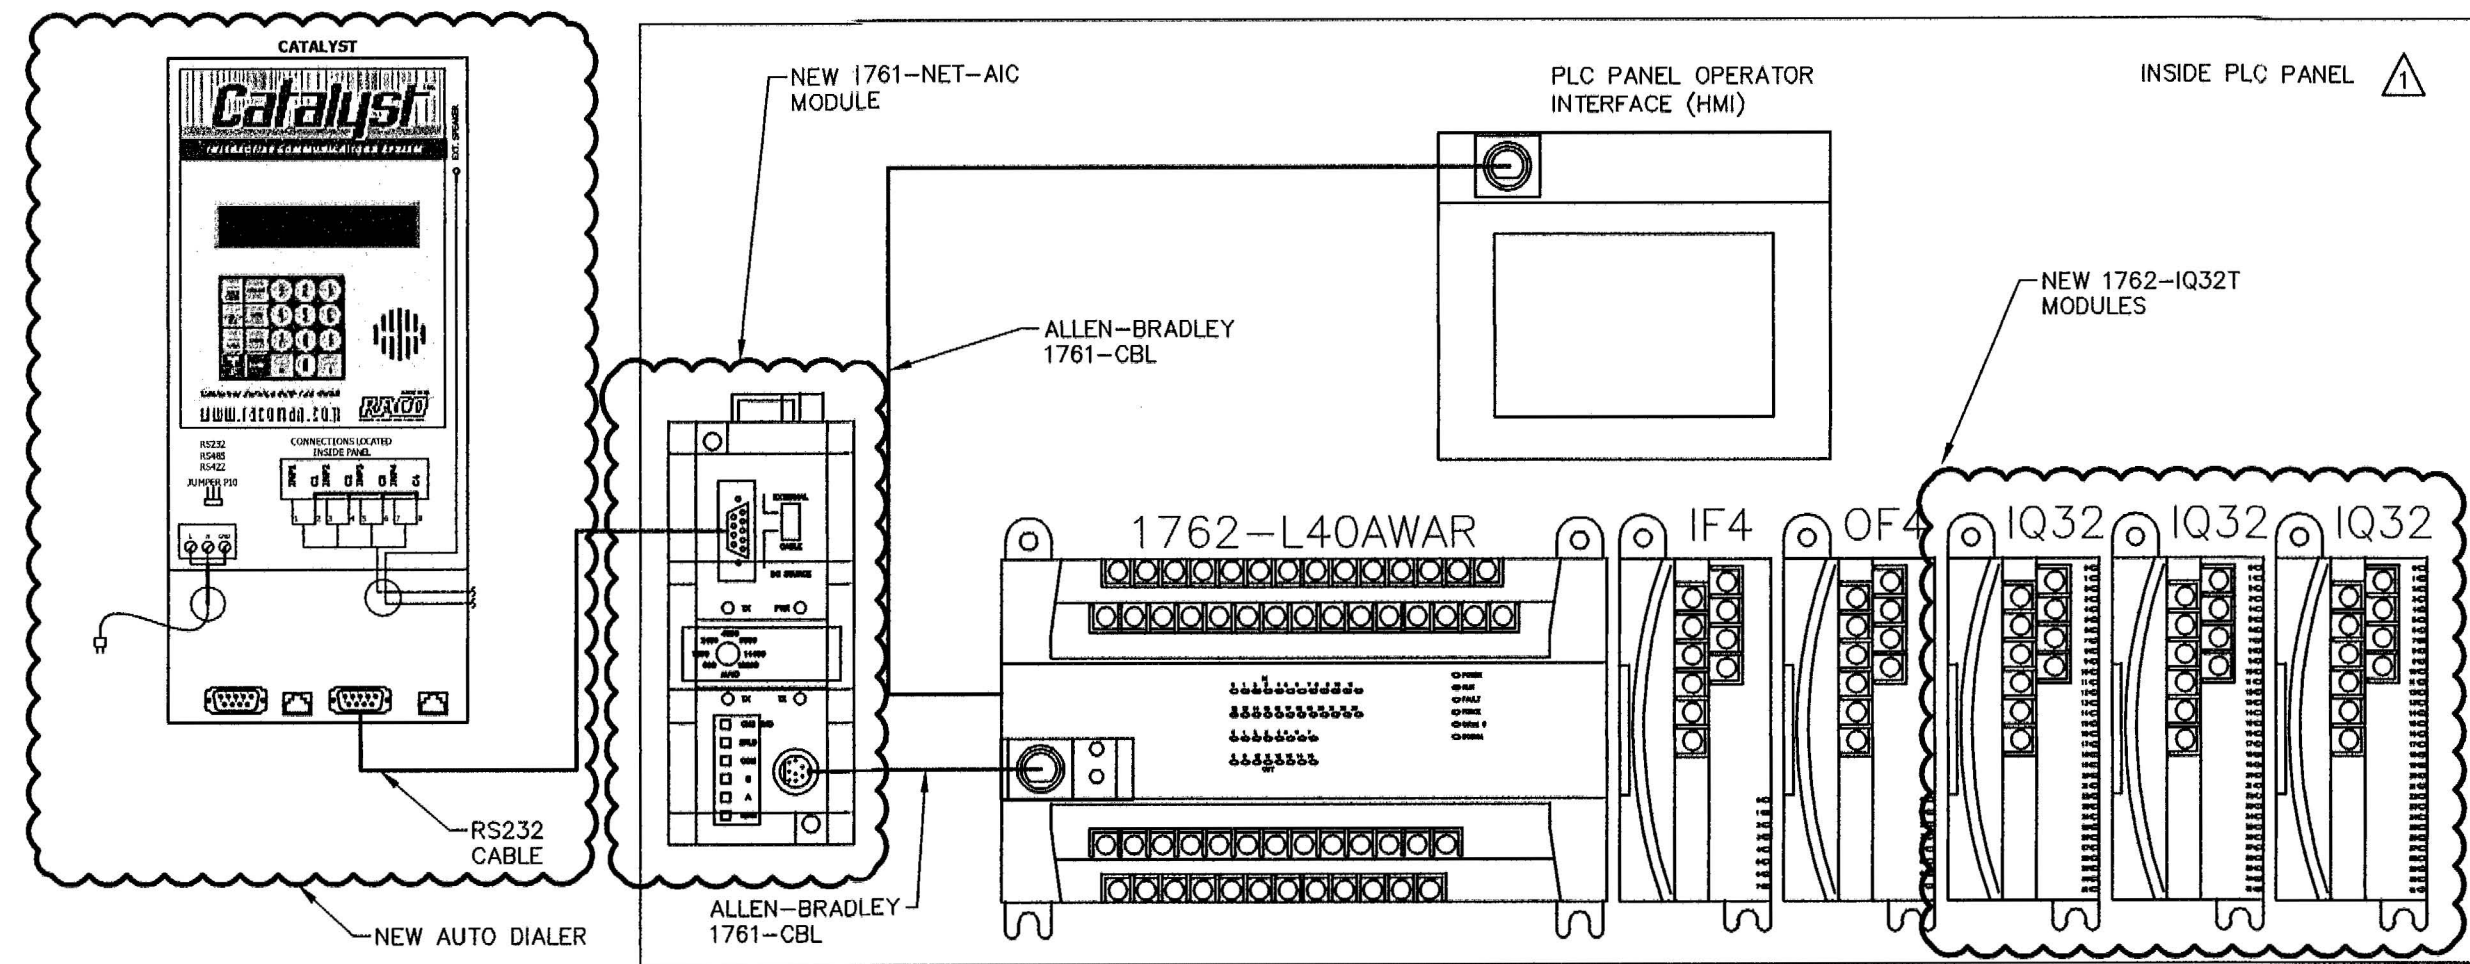


1 PLC COMPONENT LAYOUT

E7 -NTS

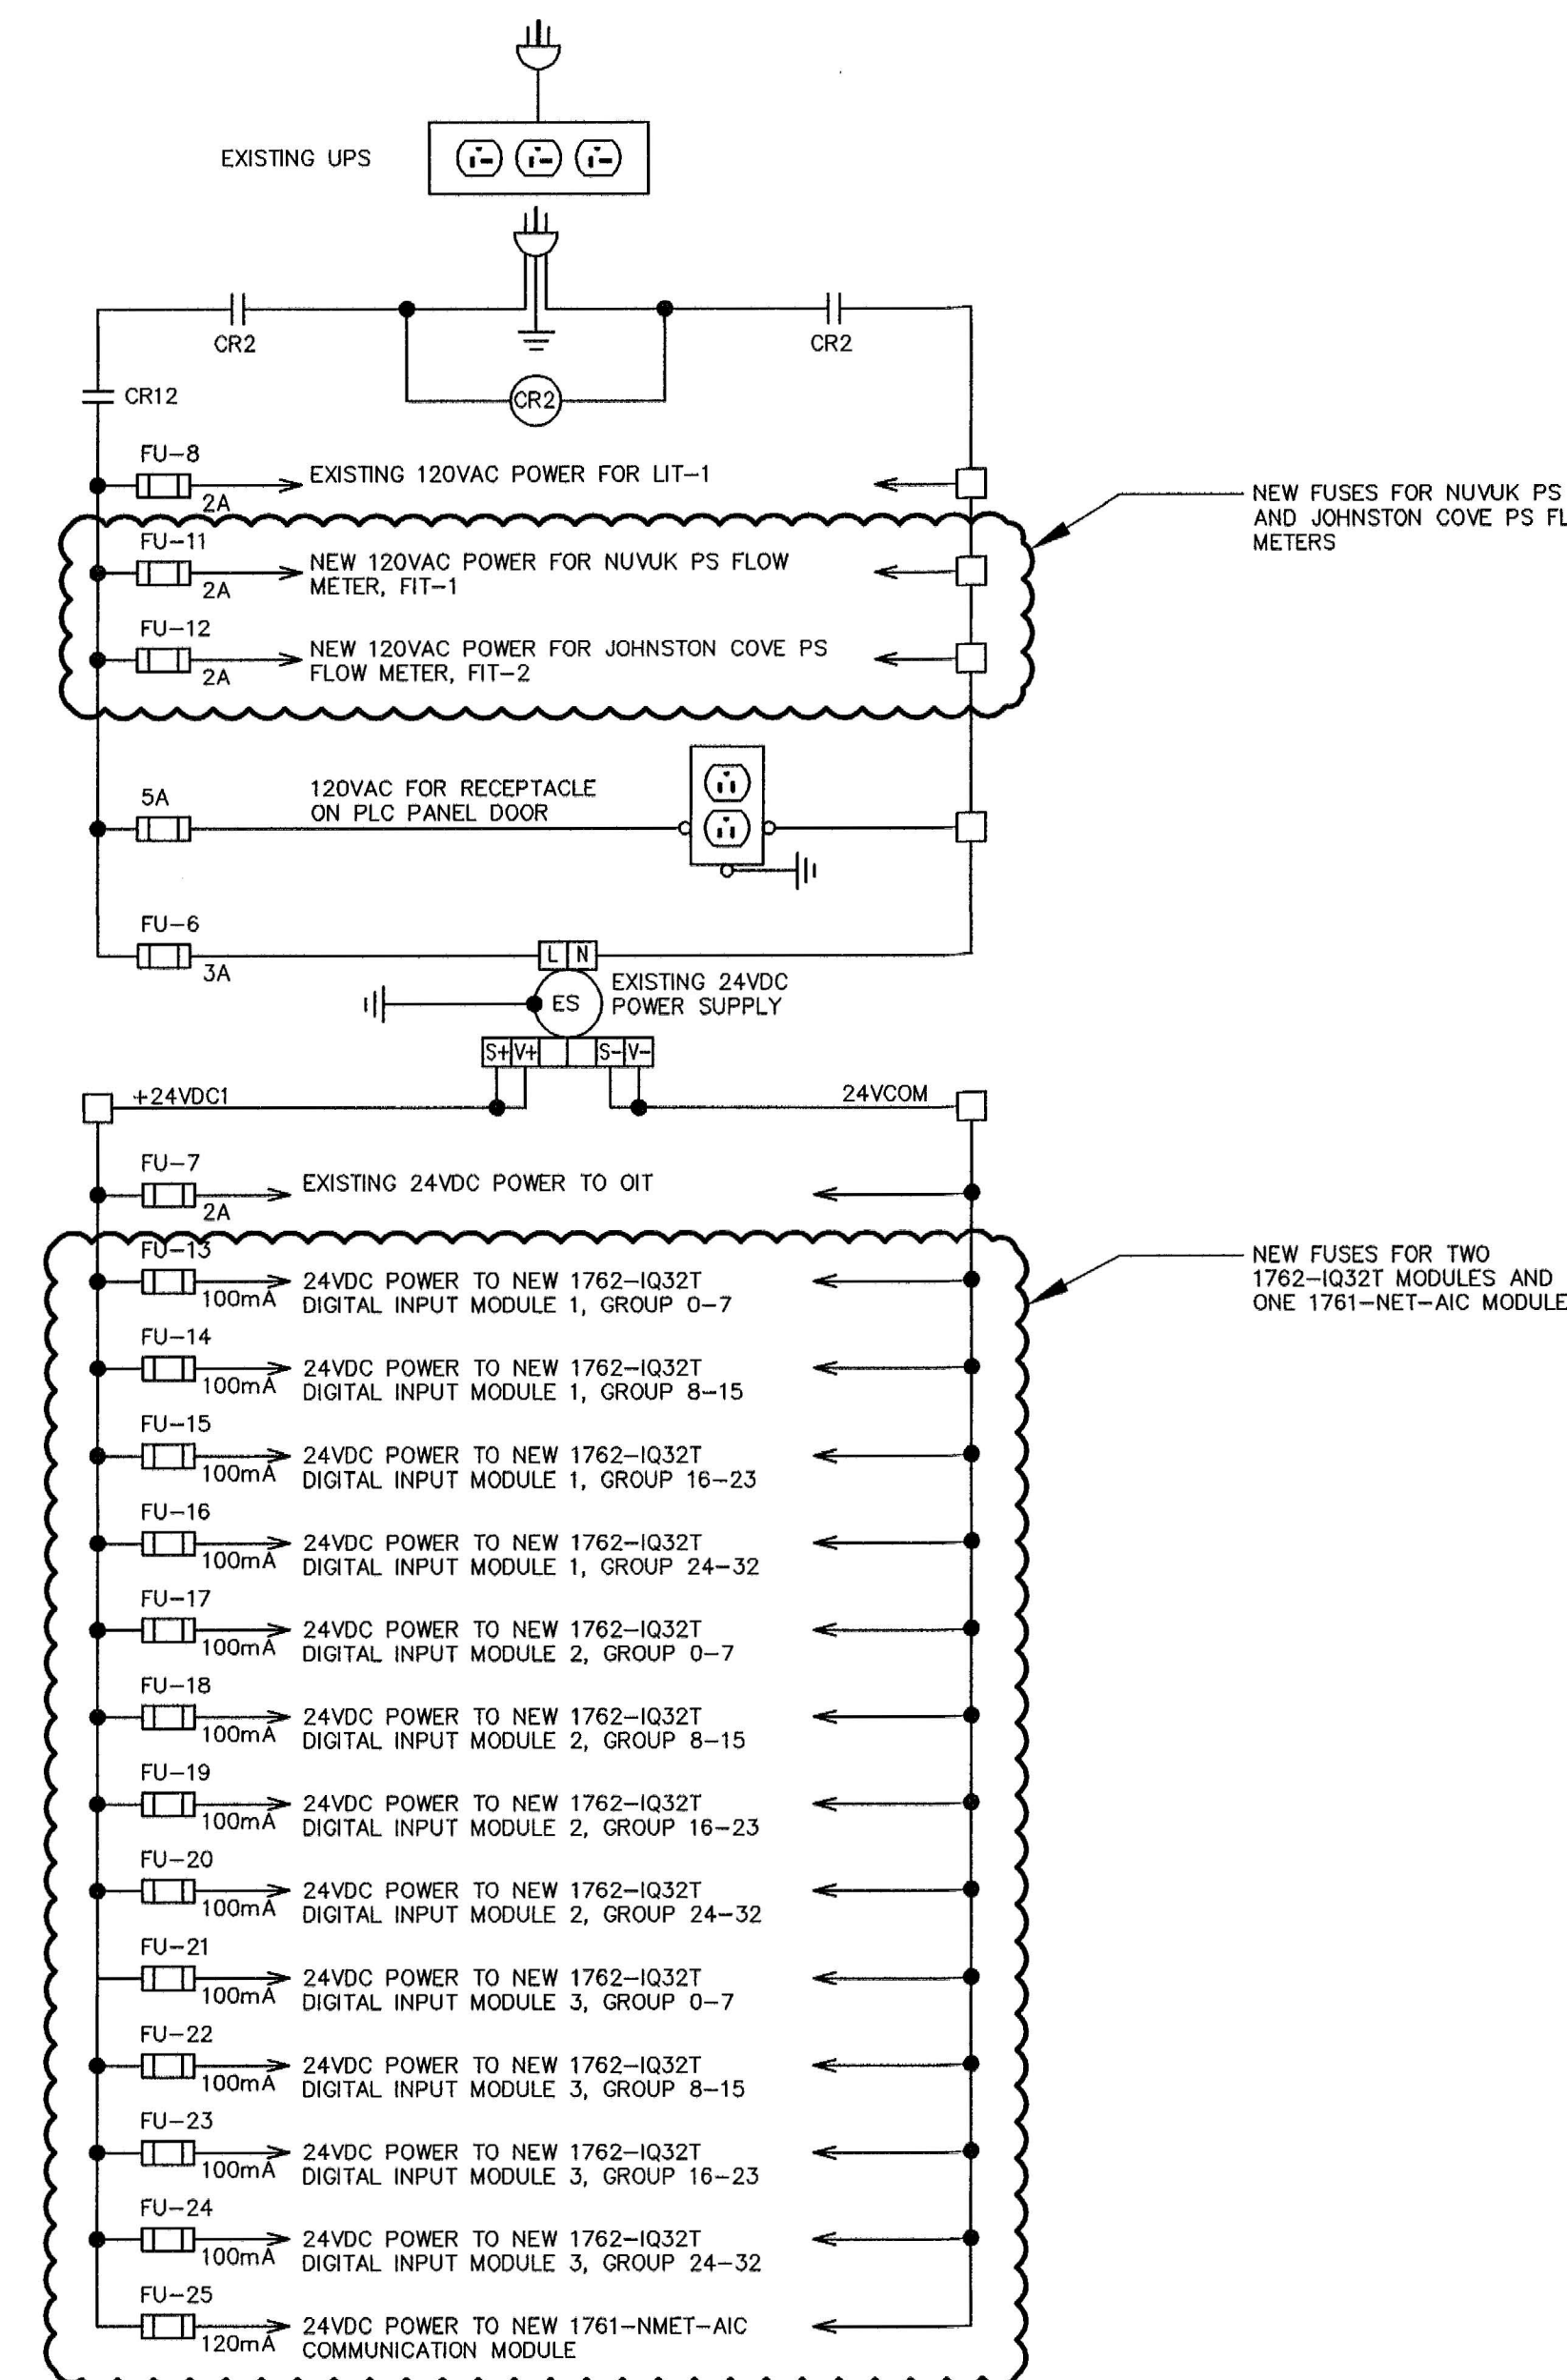


2 PLC PANEL - 120VAC AND 24VDC POWER DISTRIBUTION DIAGRAM

E7 UNLESS OTHERWISE NOTED, ALL DEVICES SHOWN ARE LOCATED IN PLC PANEL

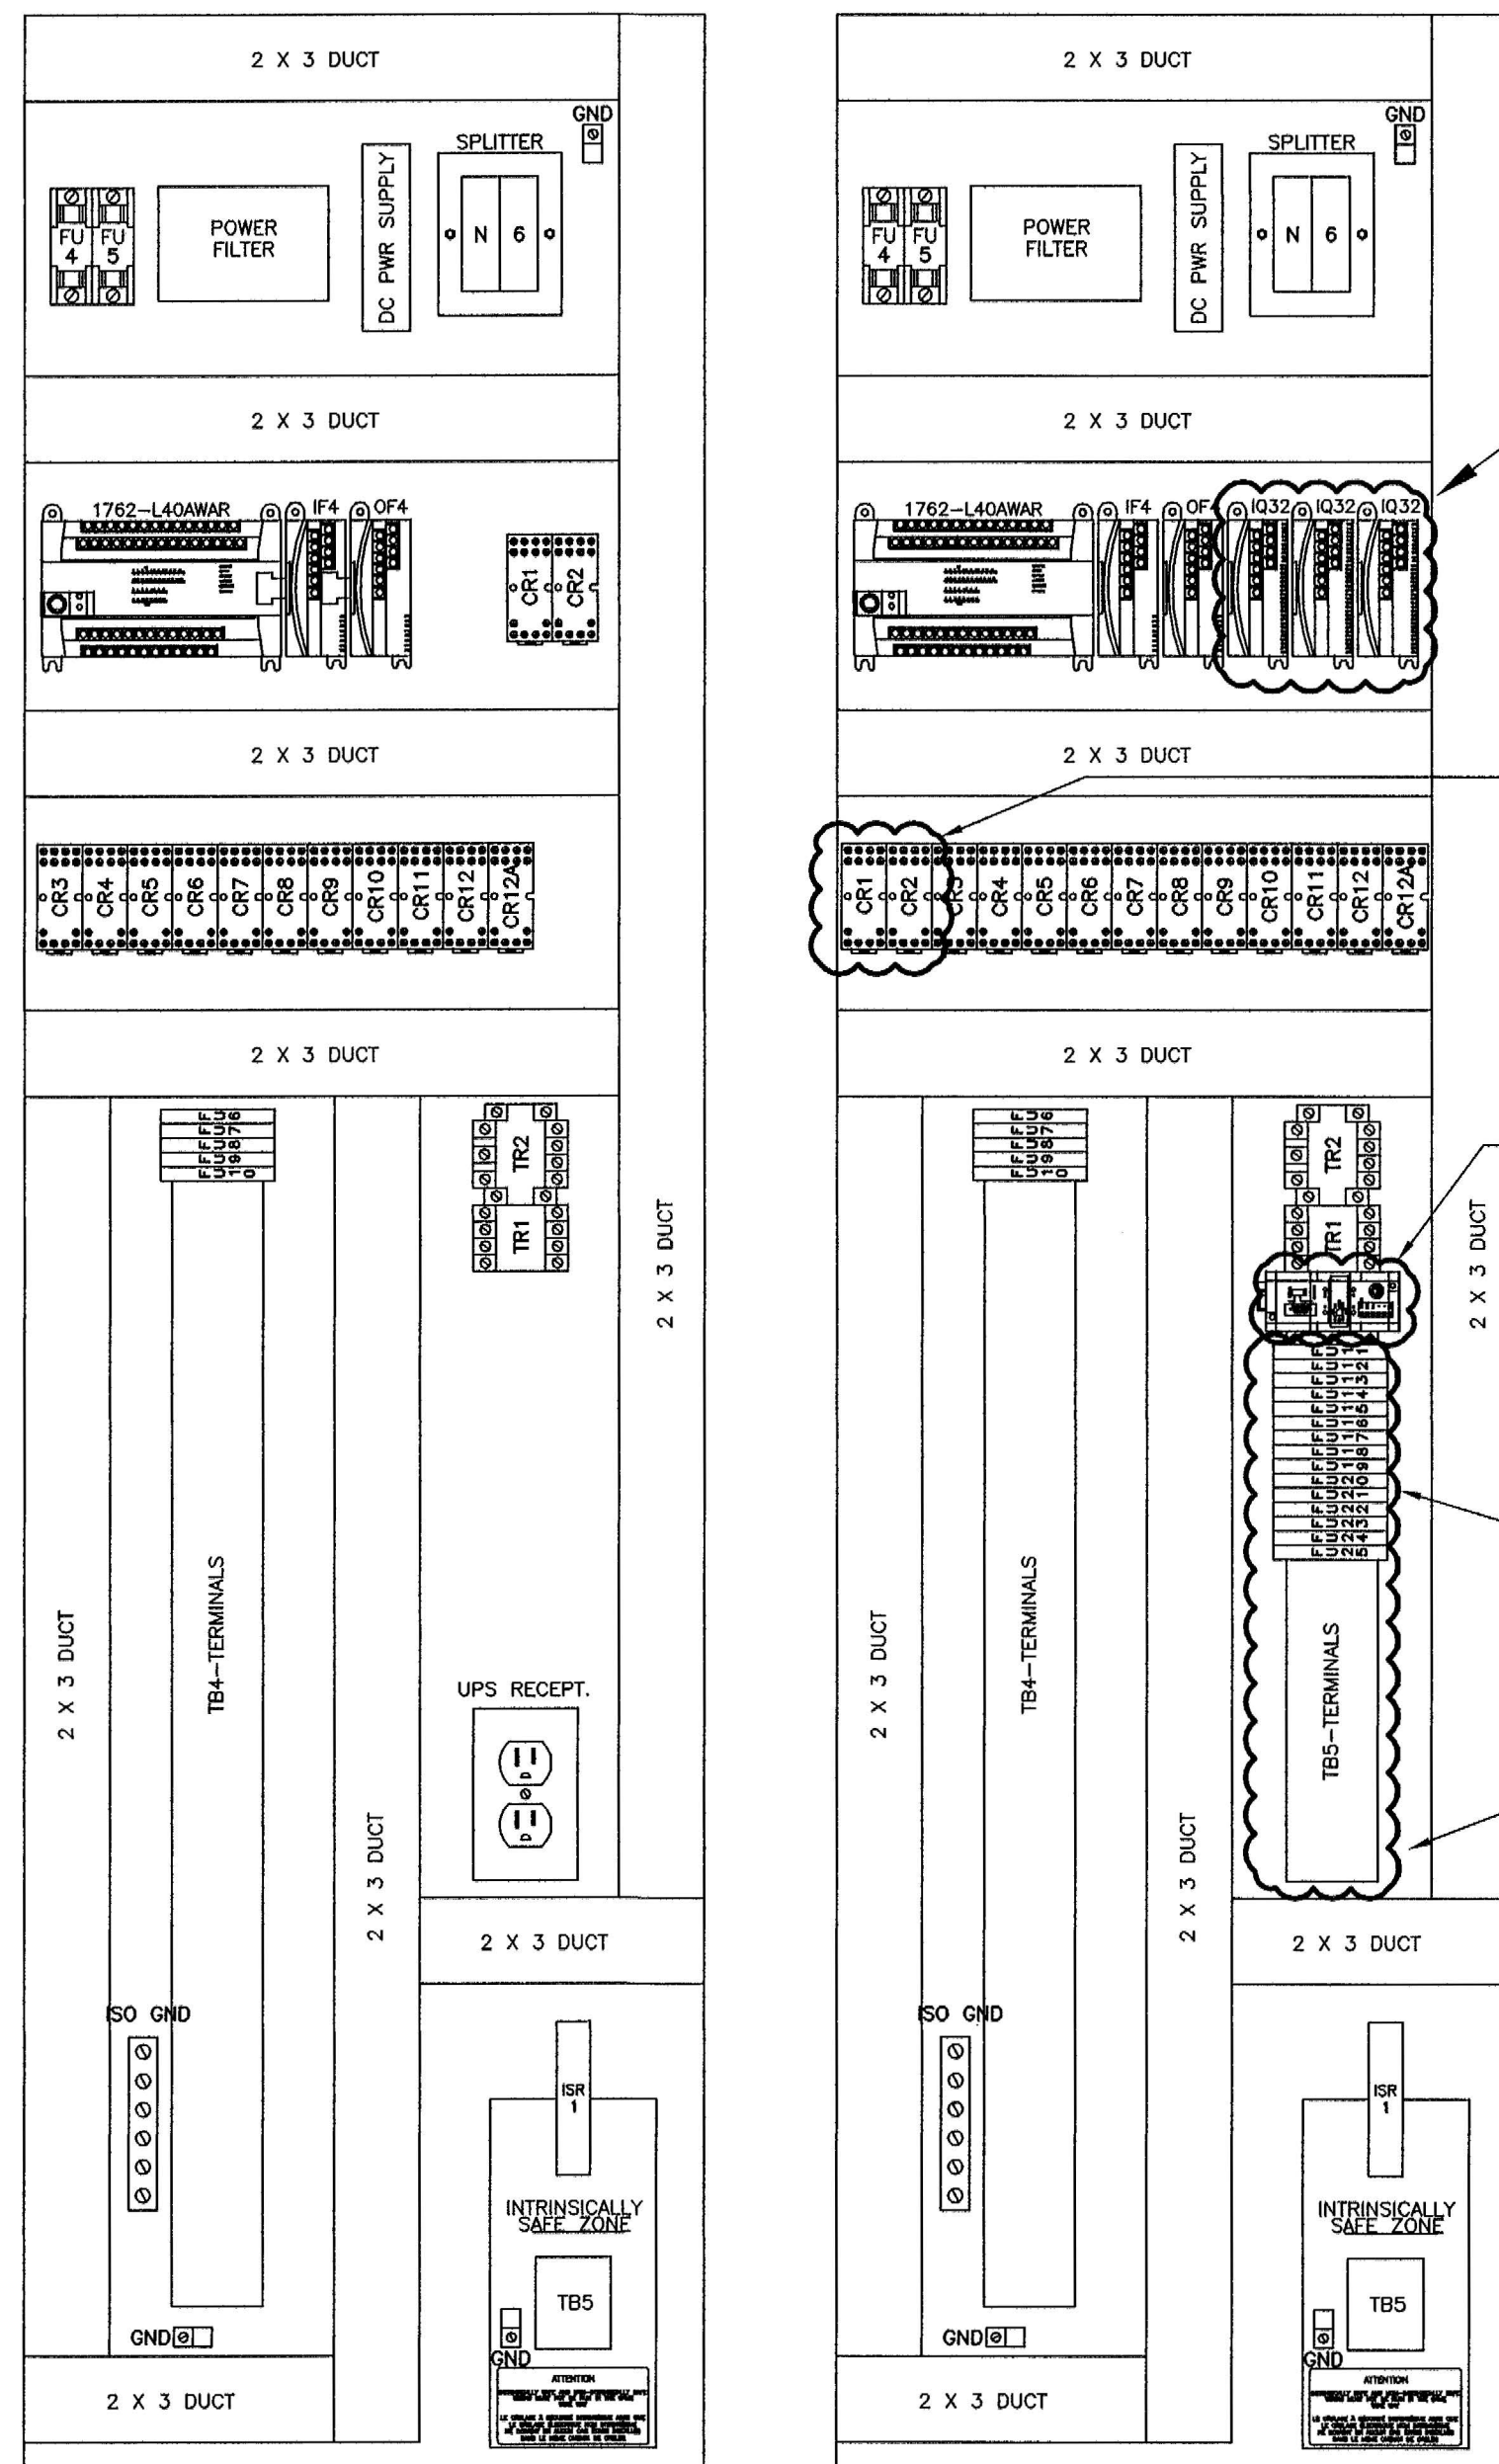

3 PLC PANEL COMPONENTS CONFIGURATION MODIFICATIONS

E7 -NTS

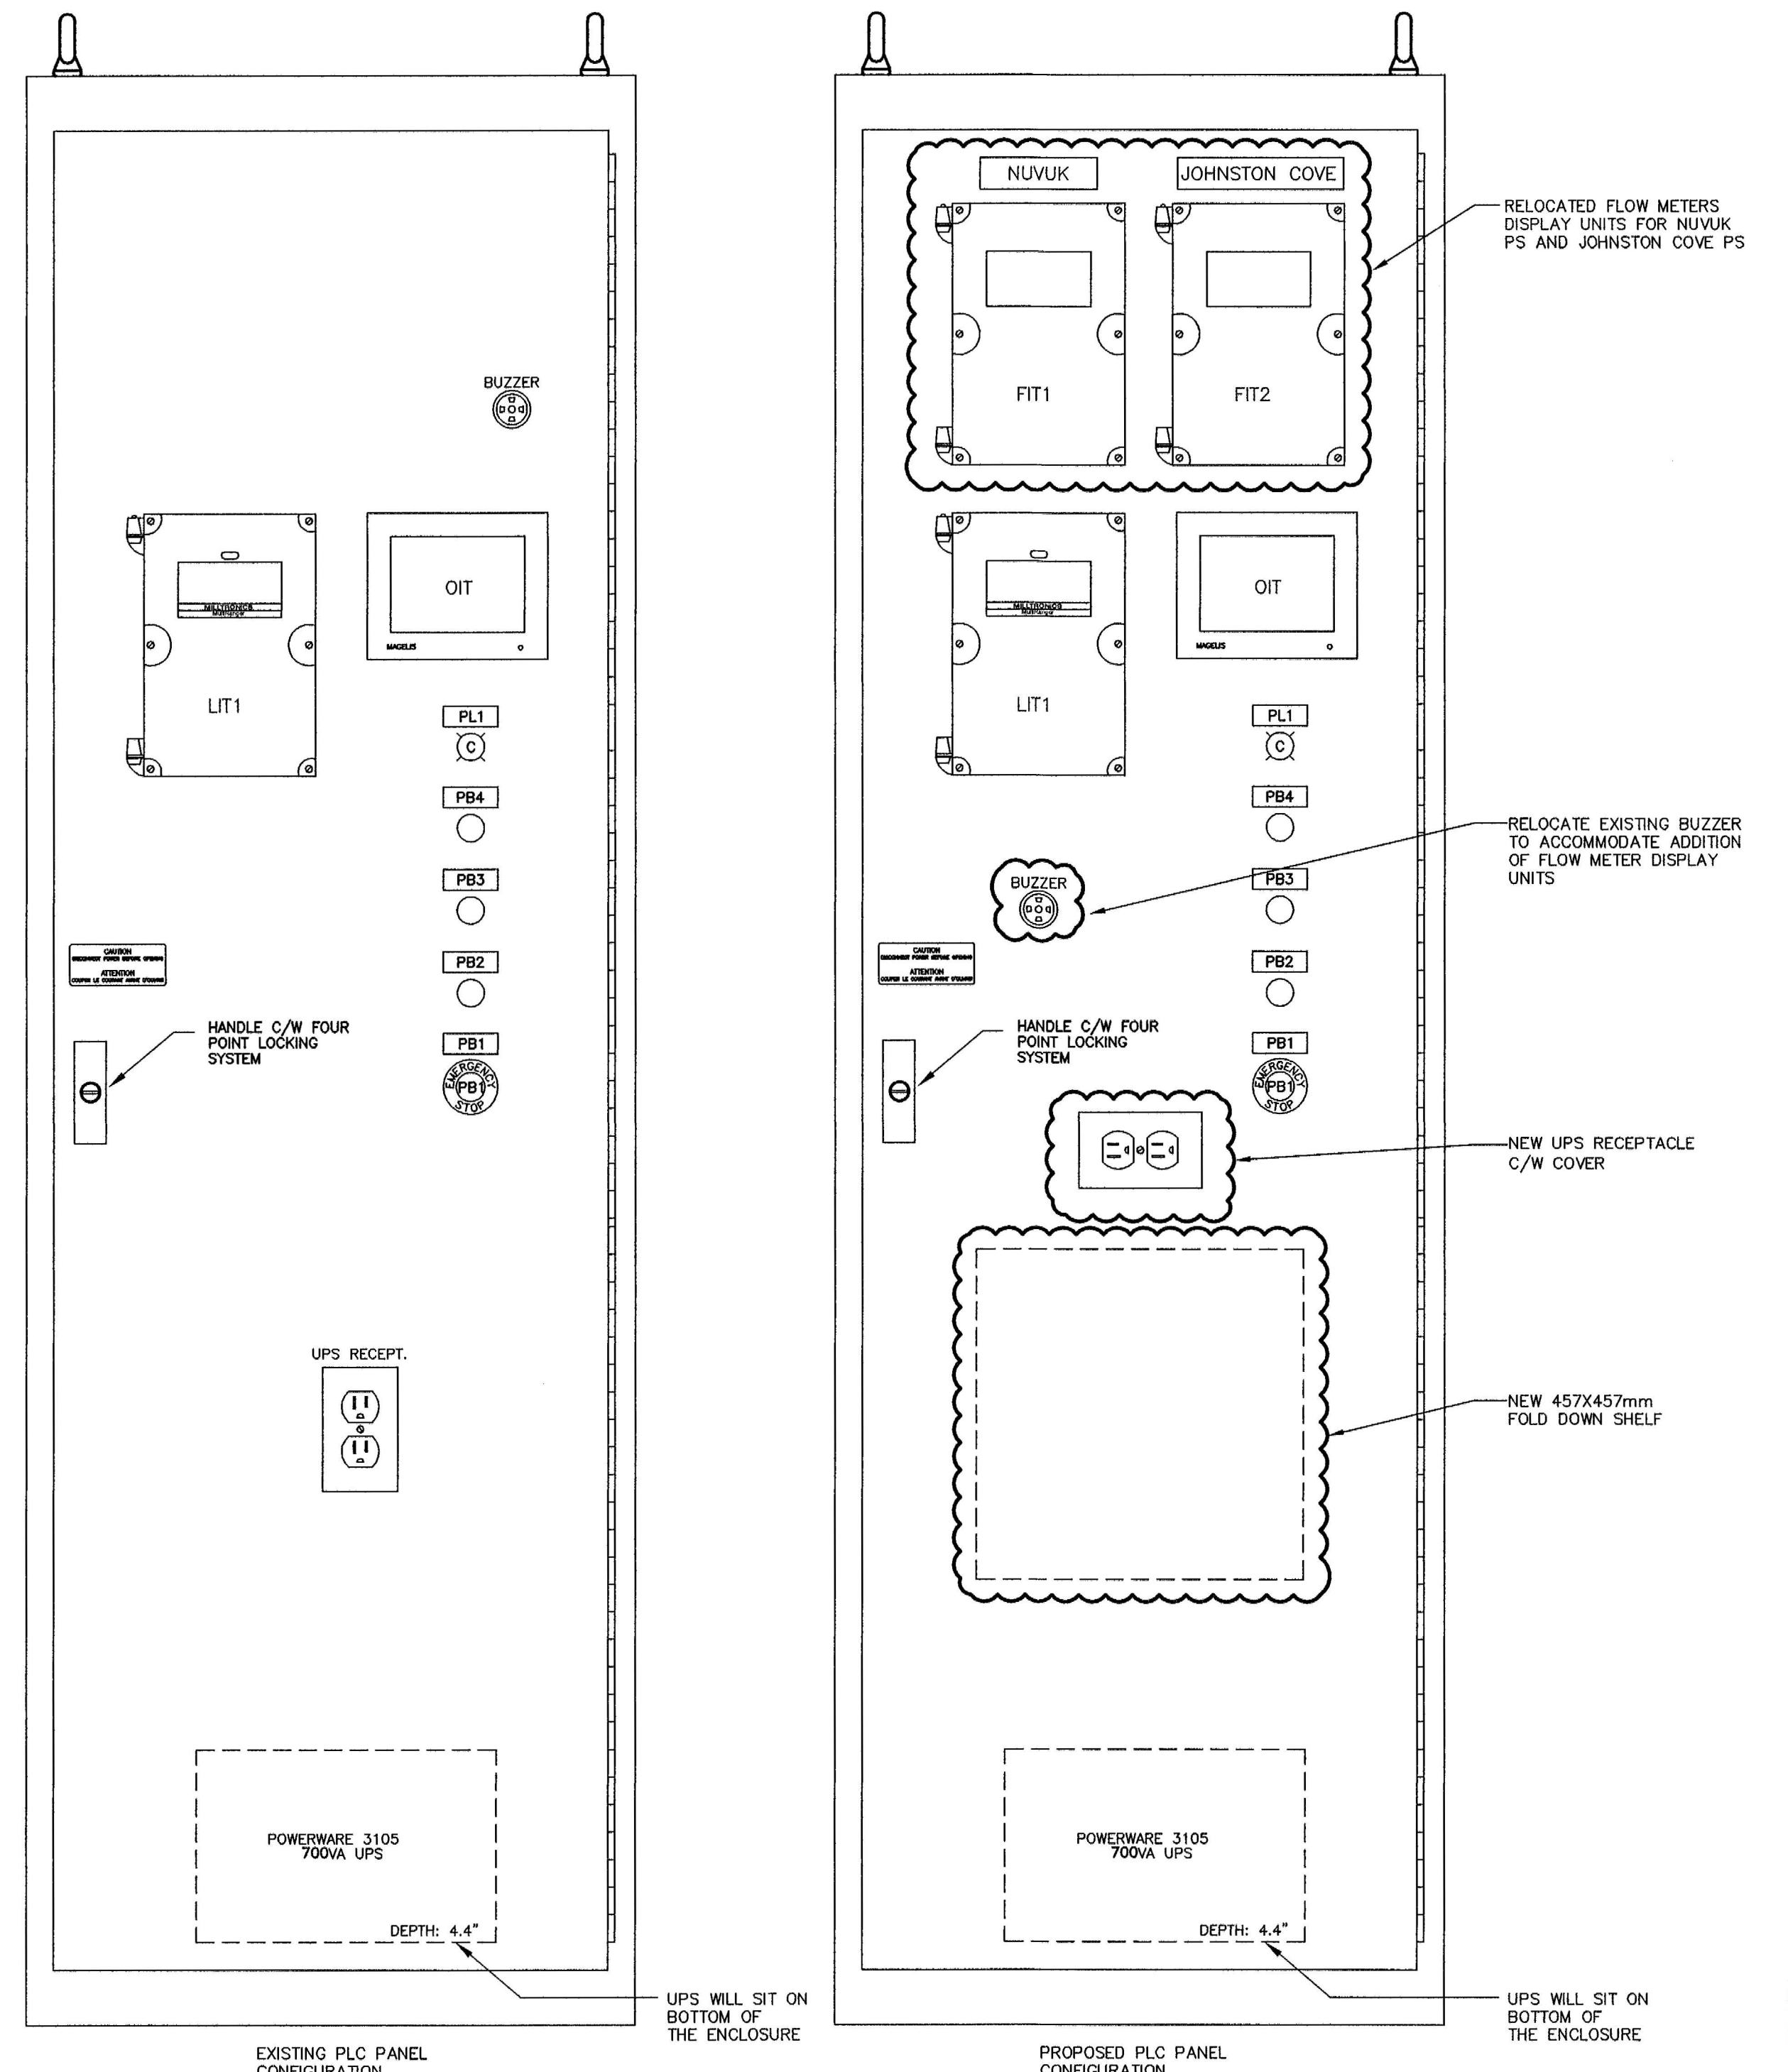

4 PLC PANEL DOOR CONFIGURATION MODIFICATIONS

E7 -NTS

- This drawing is the exclusive property of Runge & Associates Inc. and the reproduction of any part without prior written consent of this office is strictly prohibited.
- The contractor shall verify all dimensions, levels, and datums on site and report any discrepancies or omissions to this office prior to construction.
- This drawing is to be read and understood in conjunction with all other plans and documents applicable to this project.
- Drawing revision must be noted "Issued For Construction" before any work commences

Issue / Revision	Date dd/mm/yyyy
1 ISSUED FOR 66% SUBMISSION	06/09/2012
2 ISSUED FOR 99% SUBMISSION	JANUARY 2013
3 ISSUED FOR TENDER	FEBRUARY 2013
4 REVISED AS PER ADDENDUM 1 TO 4 AND ISSUED FOR CONSTRUCTION	APRIL 2013

PERMIT TO PRACTICE
Runge & Associates Inc.
Signature: *[Signature]*
Date: APRIL 22, 2013
PERMIT NUMBER: P617
The Association of Professional Engineers,
Geologists and Geophysicists of NWT (NWTAG)



runge
& associates inc. ENGINEERS
864 Hurontario Street
P.O. Box 387
Collingwood, ON, L9Y 3Z7
b: (705) 446-3590
f: (705) 446-3588
www.ranengineers.ca

burnside
Nuna Burnside Engineering & environmental LTD.
106B Scurfield Blvd., Winnipeg, Manitoba
telephone (204) 949-7110 fax (204) 949-7111
web www.neeganburnside.com

Client
GOVERNMENT OF NUNAVUT
COMMUNITY & GOVERNMENT
SERVICES
RANKIN INLET
SEWAGE TREATMENT PLANT

Drawing Title		
PLC CONFIGURATION AND PANEL LAYOUTS		
Drawn By T.T.	Checked By S.R.T.	Drawing No. E7
Scale AS SHOWN	Project No. 300031281	