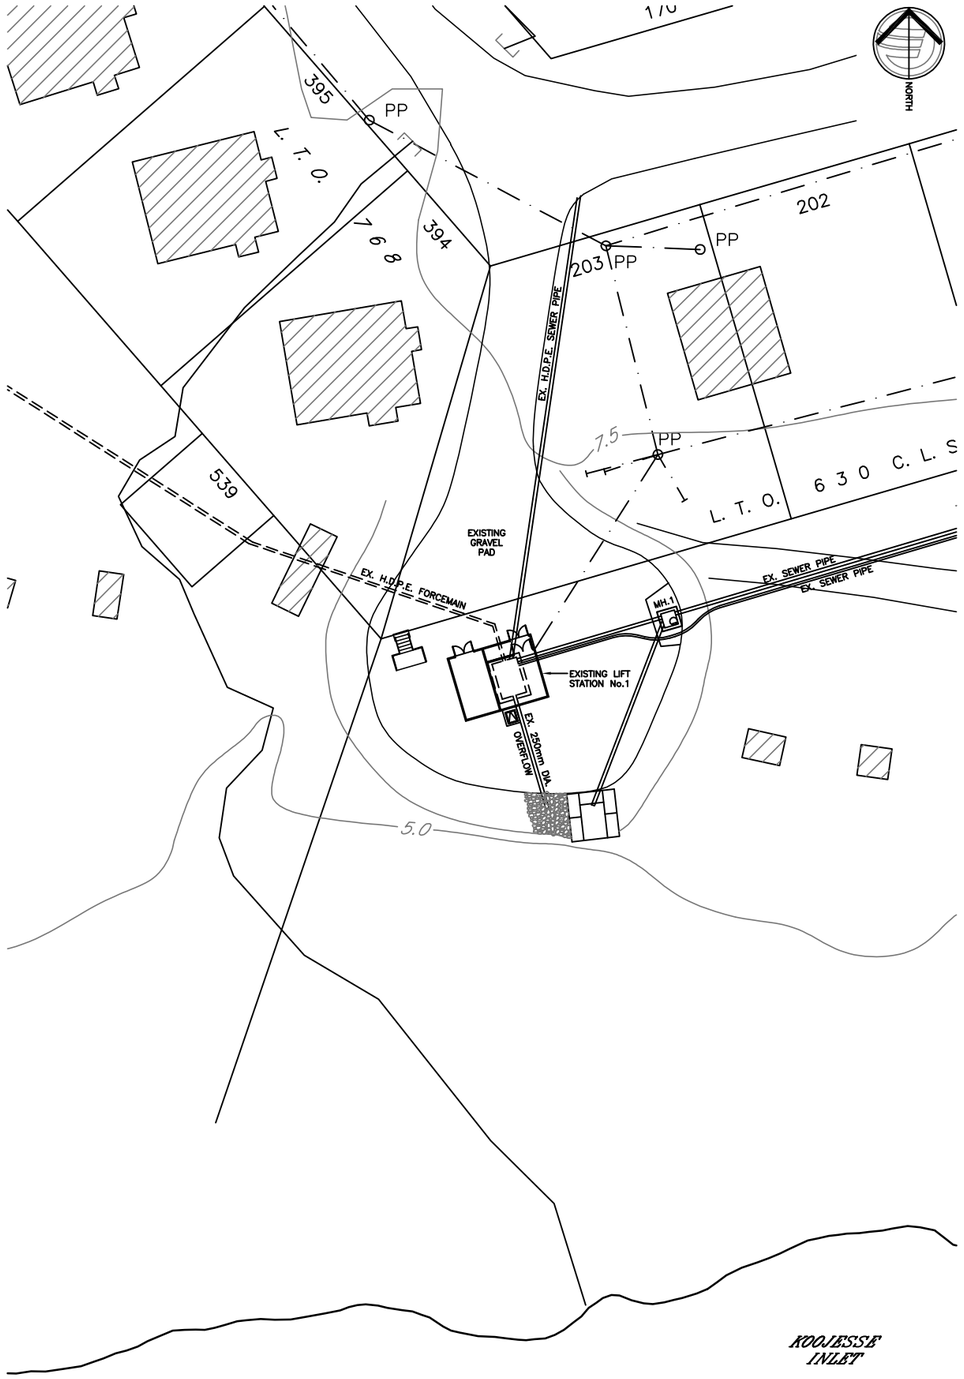

EXISTING SITE PLAN

0 5 10 15 20 25m

Scale 1:250

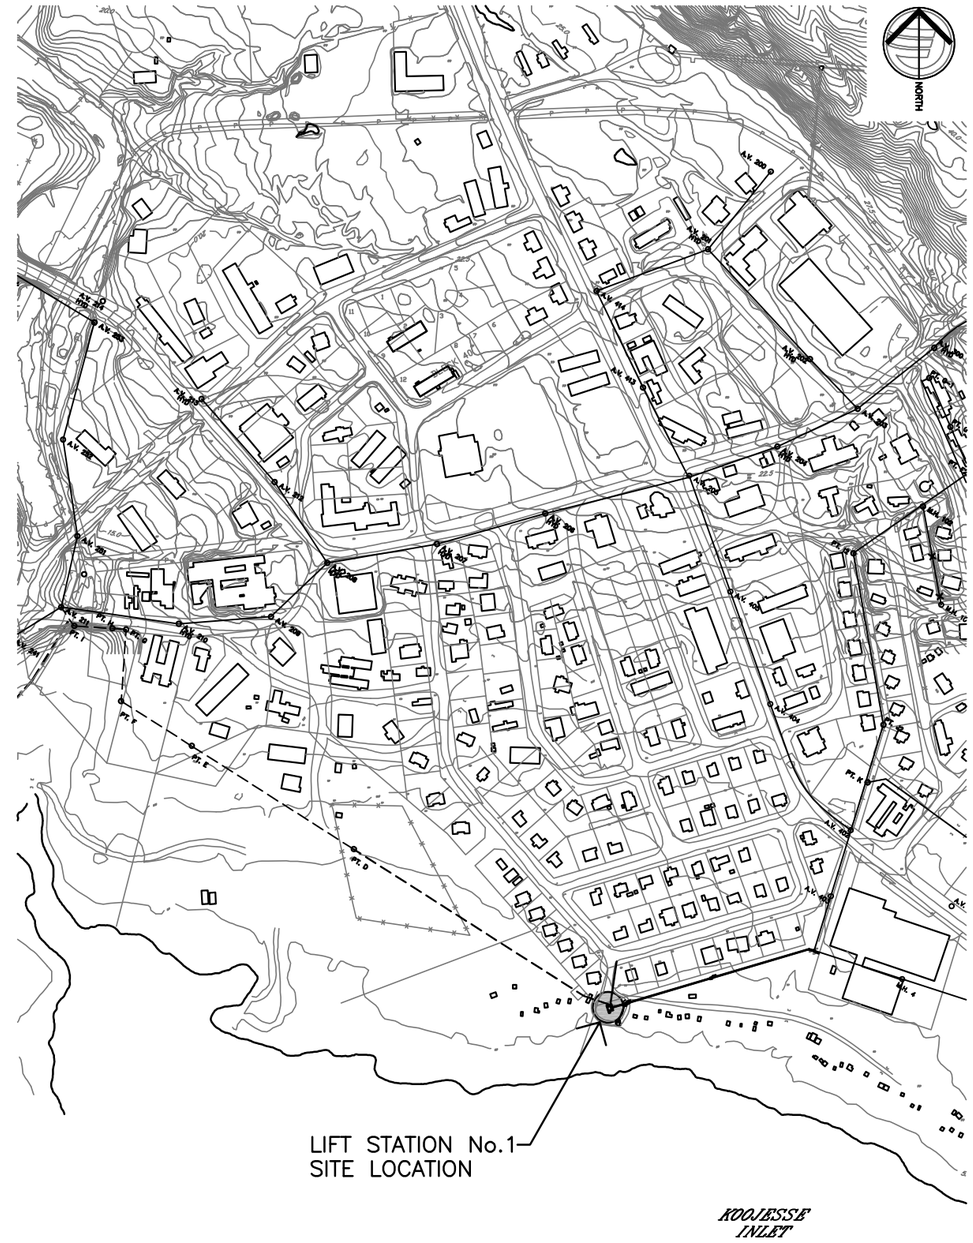

LOCATION PLAN

0 50 100 150 200 250m

Scale 1:2500

EarthTech
A Tyco International Ltd. Company

17203-103rd Avenue
EDMONTON, ALBERTA
T5S 1J4 CANADA

Tel. 780-488-6800
Fax. 780-488-2121
www.earthtech.ca

Stamp

RECORD DRAWING
INFORMATION CONTAINED IN THESE DRAWINGS IS AS SUPPLIED BY:
KUDLIK CONSTRUCTION LTD.
THE COMPLETENESS AND ACCURACY OF THIS RECORD DRAWING IS NOT GUARANTEED.
INFORMATION SHOULD BE VERIFIED AT THE ACTUAL LOCATION BEFORE USE.

No.	Date	Description
2	2007 05/20	RECORD DRAWING
1	2005 11/10	SITE GRADING
0	2005 06/20	ISSUED FOR TENDER

REVISIONS

Iqaluit
ᐃᖃᓗᒃᑐᑦ
CITY of IQALUIT, Nunavut

Design: R.H.B./J.L.R.
Drawn: R.J.H.
Approved:
Checked:

Project Title
LIFT STATION No. 1 UPGRADE

Drawing Title
LOCATION PLAN and EXISTING SITE PLAN

Scale: AS NOTED
Project No.: 84454
Date: 2005.04.27
Drawing No.: C1
Revision: 2

I:\1200\84000\84454\03a-CAD\PDF\Issued For Tender\(Joint File: 84454_C1.dwg)Last Edit: 2006-06-20 (17:00)\(Plot Scale: 1:0.2500)