


1 S2 **SECTION** 1:50

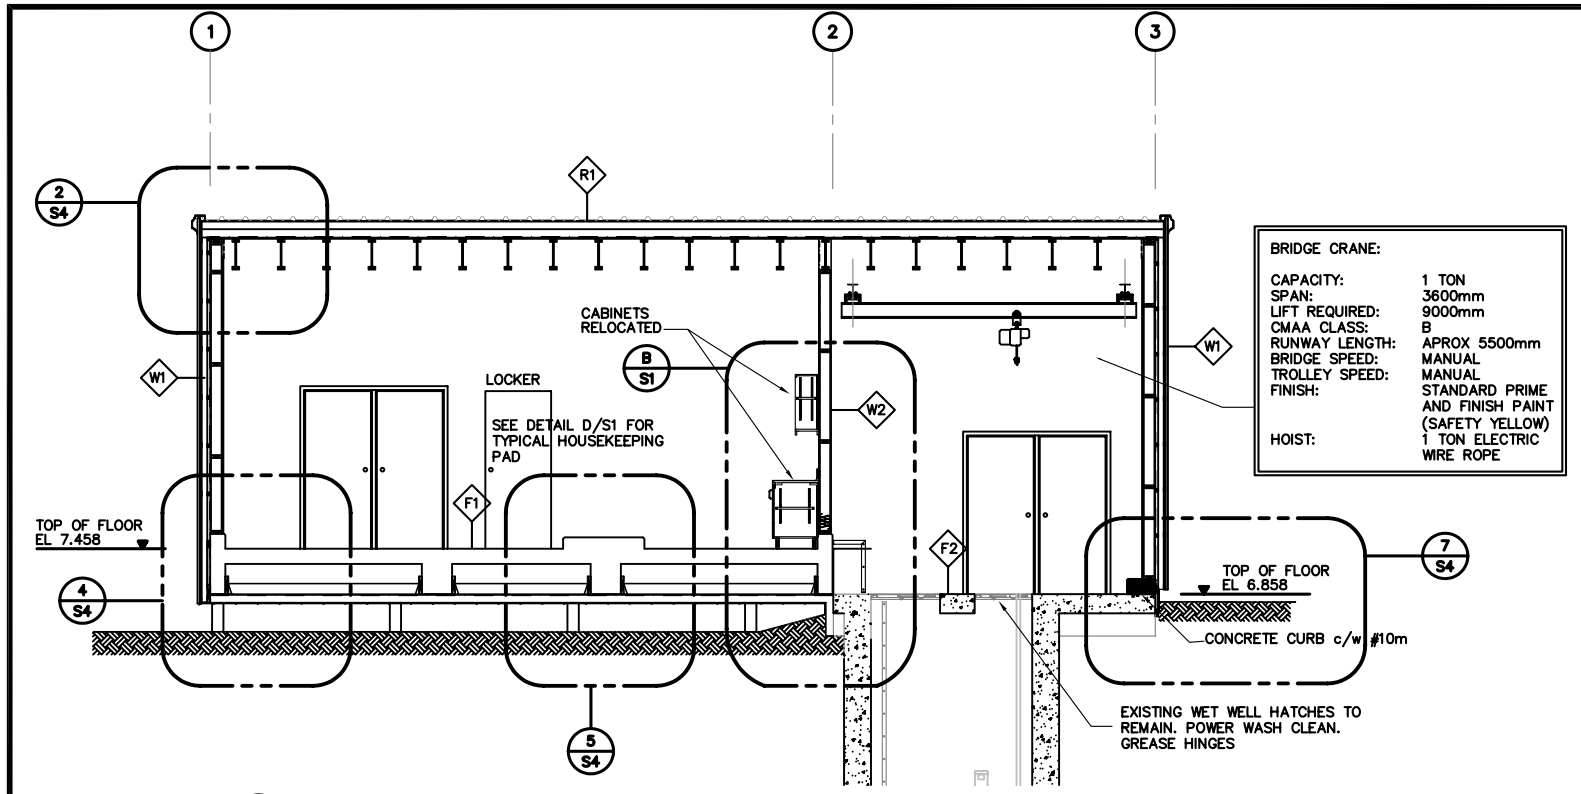


2 S2 **SECTION** 1:50




3 S2 **SECTION** 1:50

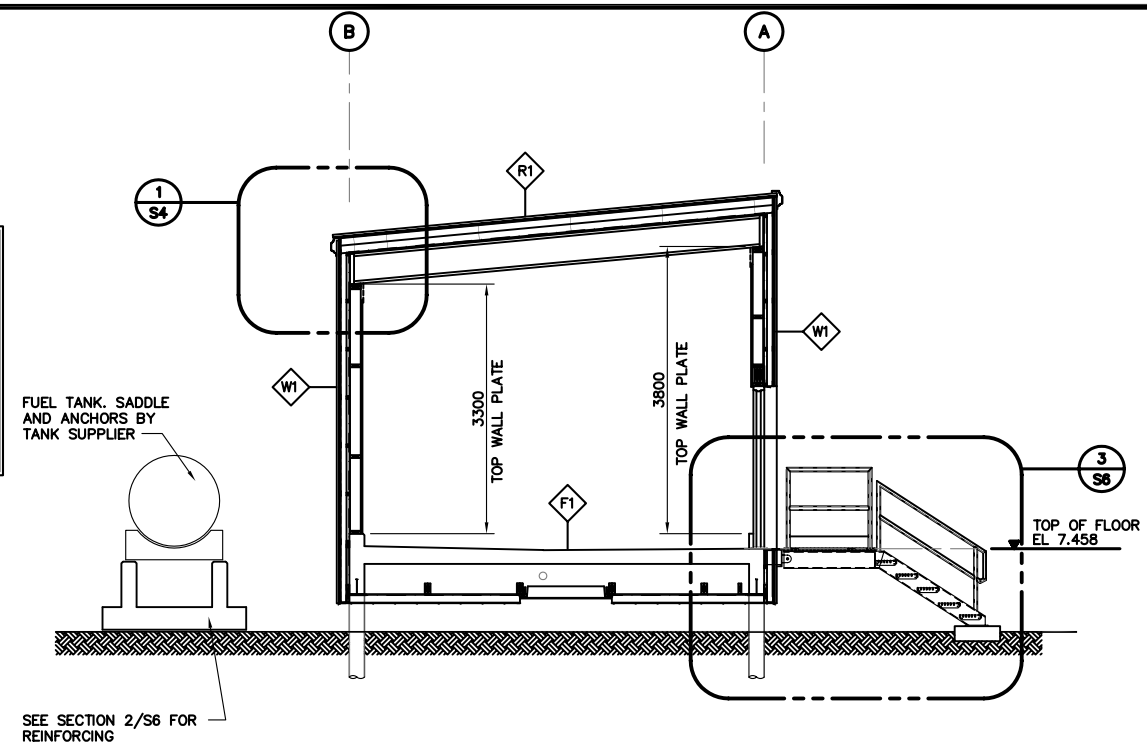


**SOUTH ELEVATION** 1:75

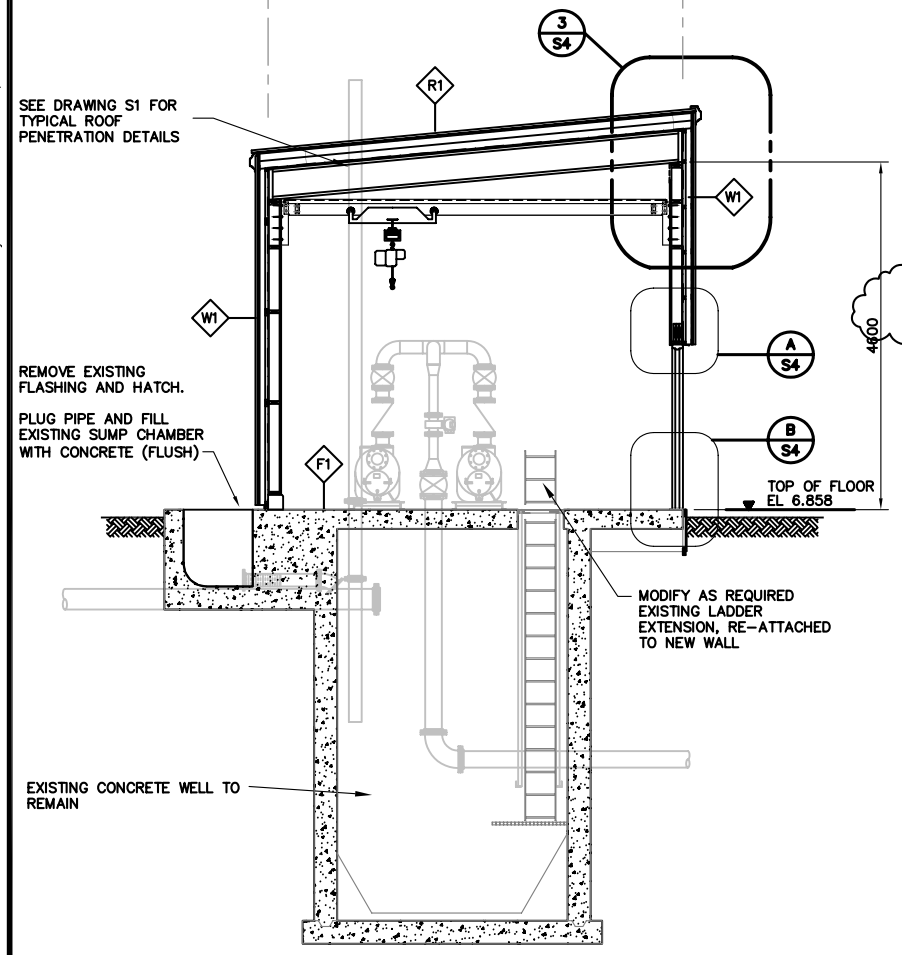


**WEST ELEVATION** 1:75

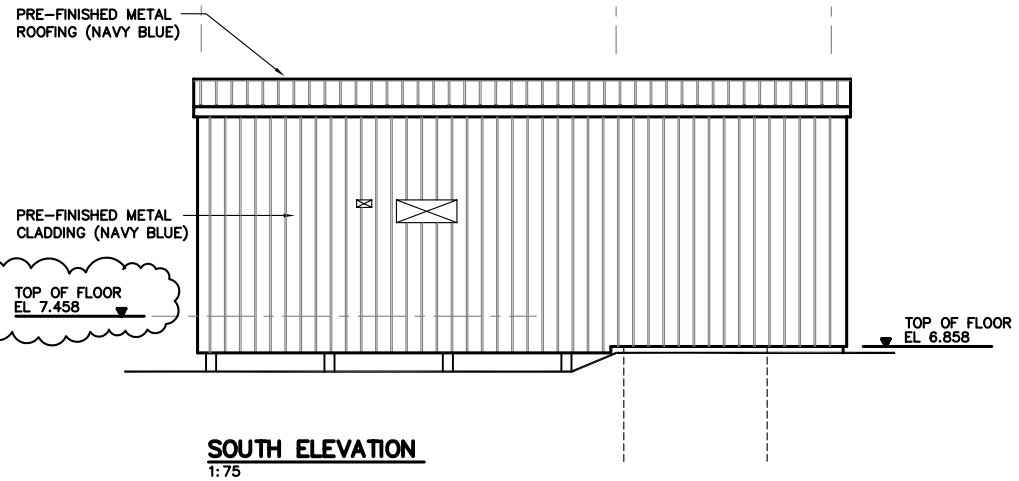


**EAST ELEVATION** 1:75

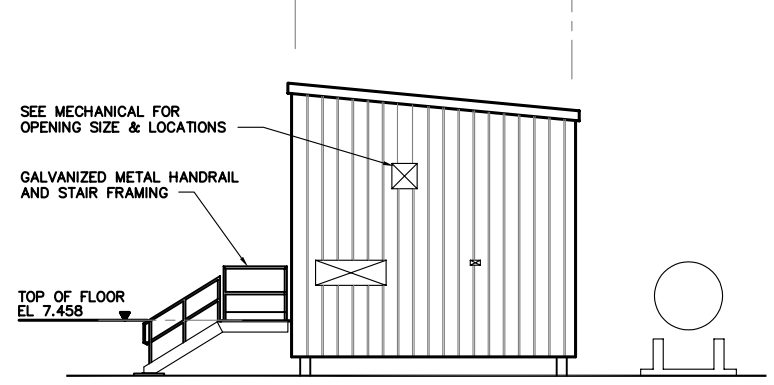


**NORTH ELEVATION** 1:75

EarthTech
A Tyco International Ltd. Company
17203-103rd Avenue
EDMONTON, ALBERTA
T5S 1J4 CANADA
Tel. 780-488-6800
Fax. 780-488-2121
www.earthtech.ca

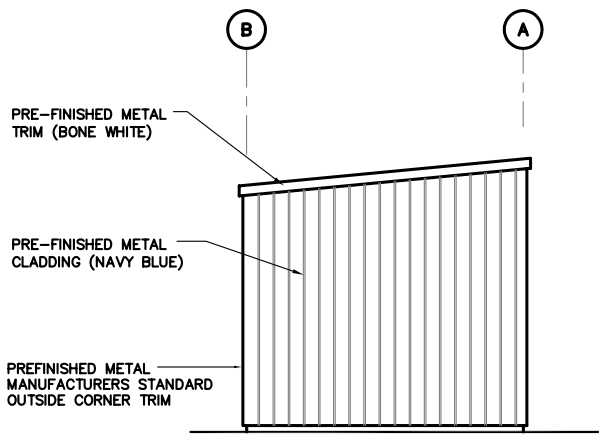Stamp

RECORD DRAWING
INFORMATION CONTAINED IN THESE DRAWINGS IS AS SUPPLIED BY:
KUDLIK CONSTRUCTION LTD.
THE COMPLETENESS AND ACCURACY OF THIS RECORD DRAWING IS NOT GUARANTEED.
INFORMATION SHOULD BE VERIFIED AT THE ACTUAL LOCATION BEFORE USE.
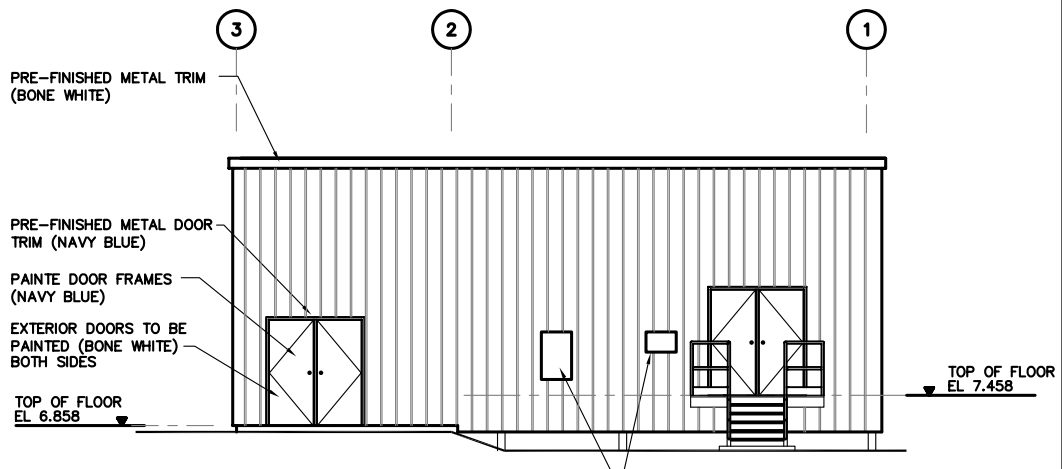
| No. | Date | Description |
|---|---|---|
| 2 | 2007 05/20 | RECORD DRAWING |
| 1 | 2005 09/20 | GENERAL REVISION |
| 0 | 2005 06/20 | ISSUED FOR TENDER |

REVISIONS

CITY of IQALUIT, Nunavut

| | |
|---|---|
| Design | RJG |
| Drawn | NV |
| Approved | |
| Checked | |

Project Title
LIFT STATION No. 1 UPGRADE

Drawing Title
**STRUCTURAL BUILDING SECTIONS ELEVATIONS**

Scale: AS NOTED

| Project No. | Date |
|---|---|
| 84454 | 13/04/05 |

| Drawing No. | Revision |
|---|---|
| S3 | 2 |

LAST SAVED: 5/7/2007 9:12 AM L:\work\84000\84454\02a-CAD\GF\Issued\Record_Drawings\Structural\S3.dwg PLOT DATE: 5 July 2007 PLOT BY: CARR, YVONNE