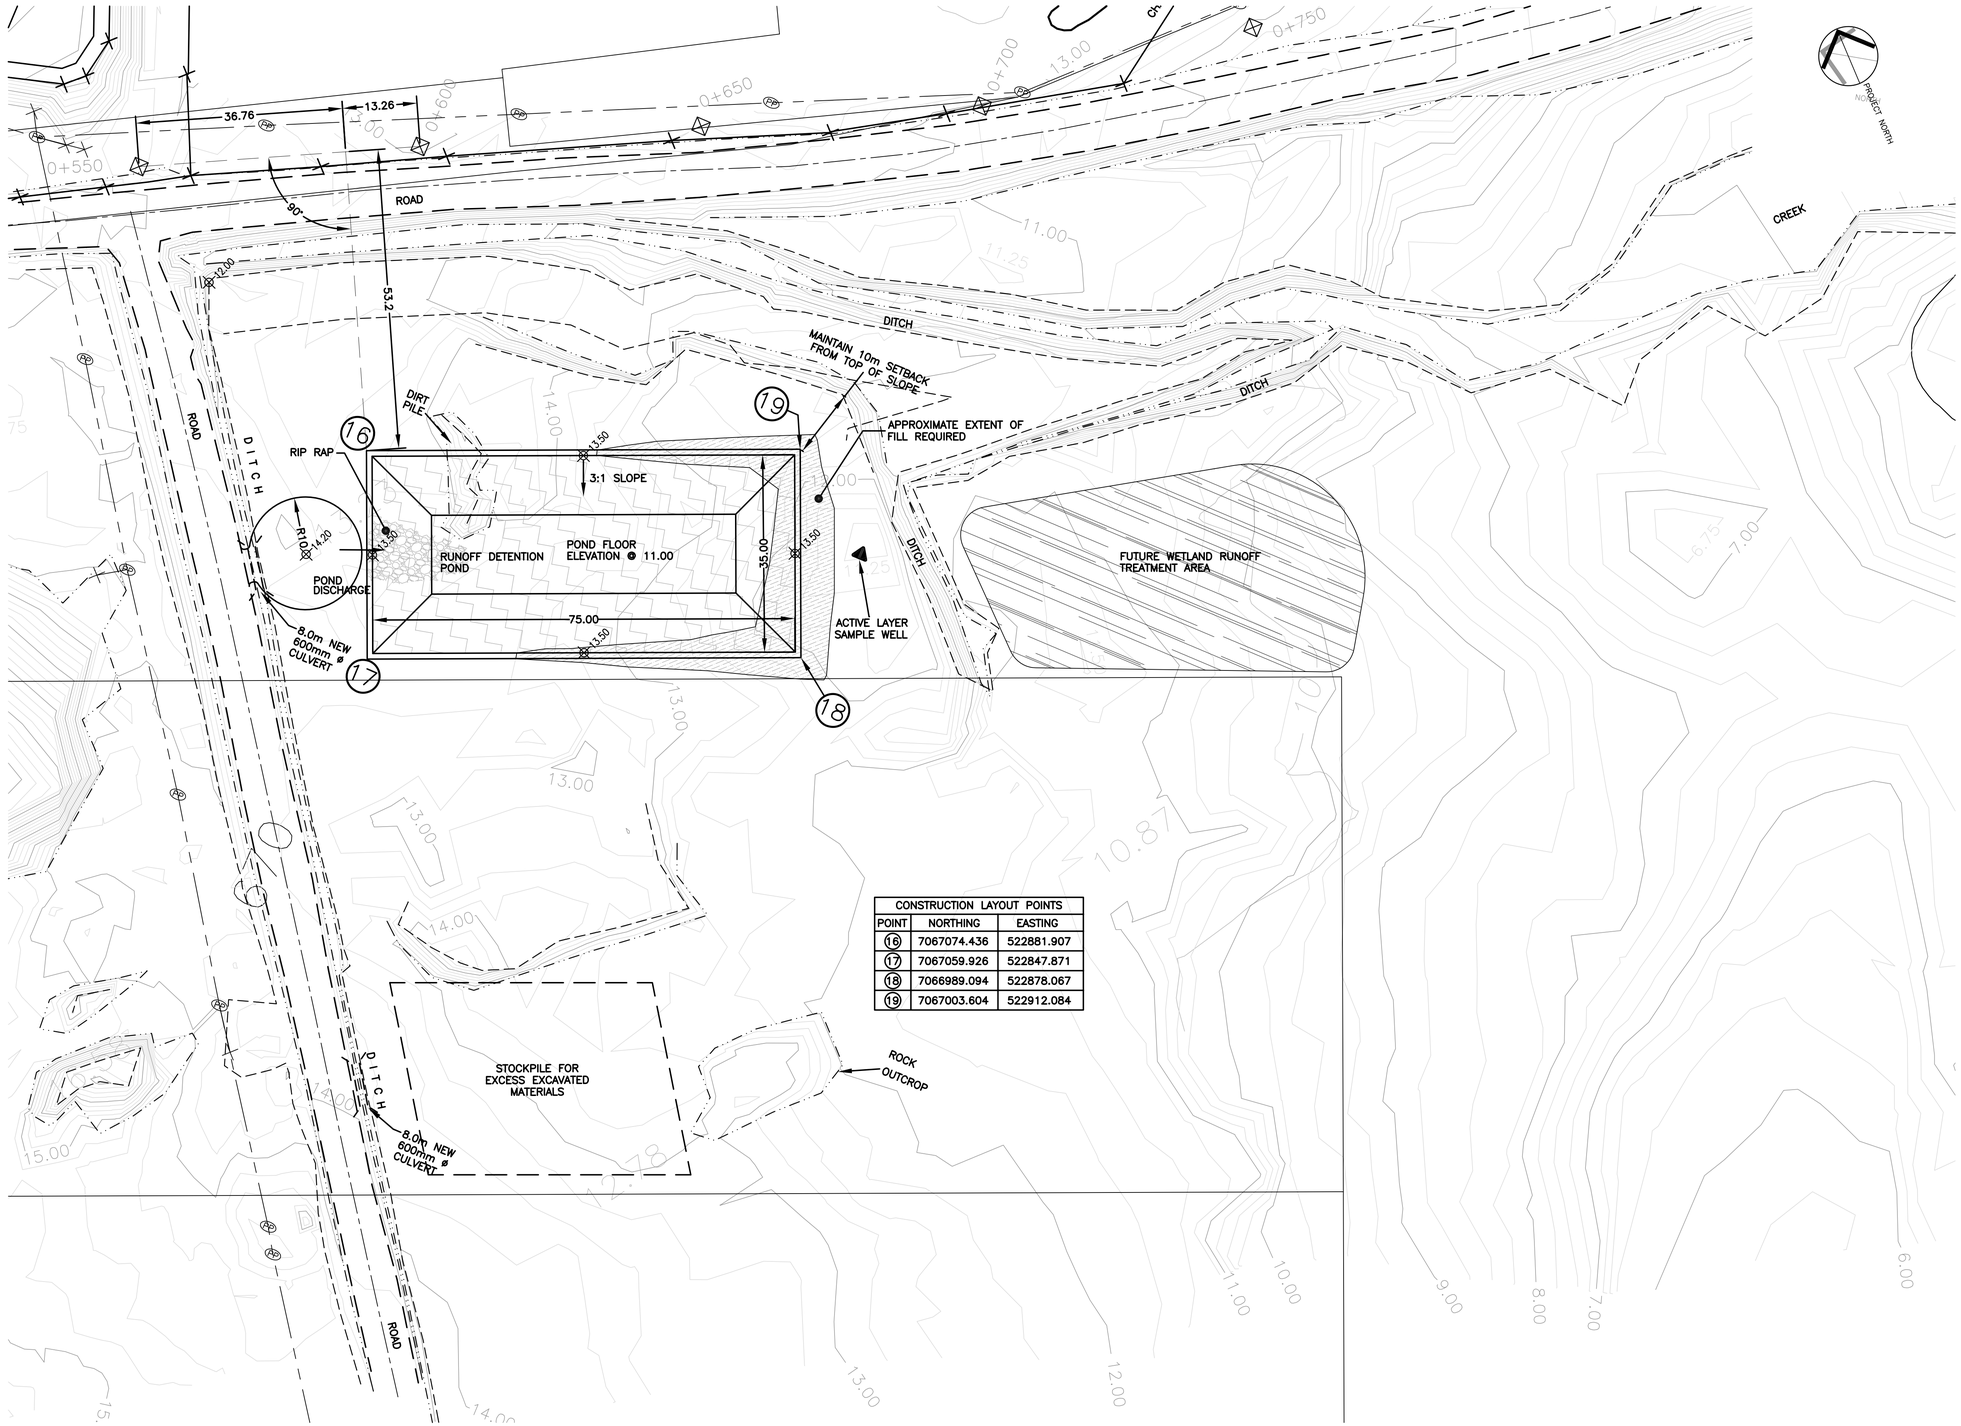

CONSTRUCTION LAYOUT POINTS		
POINT	NORTHING	EASTING
16	7067074.436	522881.907
17	7067059.926	522847.871
18	7066989.094	522878.067
19	7067003.604	522912.084

EarthTech
A Tyco International Ltd. Company
17203-103rd Avenue
EDMONTON, ALBERTA
T5S 1J4 CANADA
Tel. 780-488-6800
Fax. 780-488-2121
www.earthtech.ca

LEGEND

- PROPSED OFF-SITE DRAINAGE
- PROPOSED ON-SITE DRAINAGE
- PROPOSED CULVERT
- EXISTING CULVERT
- OVER HEAD POWER LINE
- SHACK
- PROJECT LIMIT
- CONSTRUCTION CONTROL POINT

Stamp

No.	Date	Description
4	04/16 2010	ISSUED FOR RECORD DRAWING BASED UPON CONTRACTOR DATA
3	09/07 2006	ISSUED FOR LAYOUT
2	08/23 2006	ISSUED FOR CONSTRUCTION
1	07/24 2006	ISSUED FOR TENDER
0	06/06 2006	PRELIMINARY

REVISIONS

CITY of IQALUIT, Nunavut

Design: MM/KRJ

Drawn: SB/CJD/RR

Project Title

IQALUIT LANDFILL IMPROVEMENTS-2006

Drawing Title

EAST EXPANSION IMPROVEMENTS

Scale: 1:500

Project No. 93107

Date 10.04.16

Drawing No. C04

Revision 4

LAST SAVED: 15/4/2010 1:56 PM
L:\work\93000\93107\02a-CAD\WAT\Issued\2010-04-15 Issued For Record Drawings\C04D3-93107E.C04E.DWG