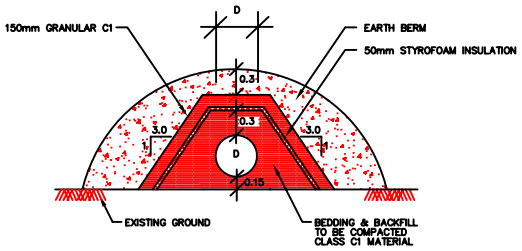

(1) BEDDING AND BACKFILL FOR PIPE ABOVE EXISTING GROUND

N.T.S.

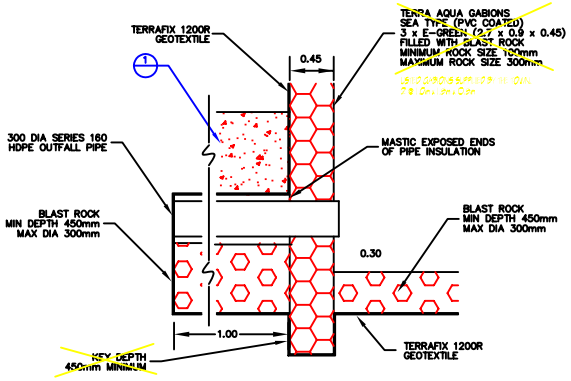

(3) RETAINING WALL FOR END OF PIPE OUTFALL

N.T.S.

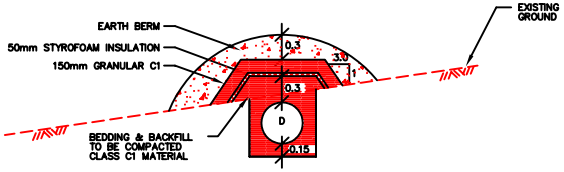

(2) BEDDING AND BACKFILL FOR PIPE BELOW EXISTING GROUND

N.T.S.

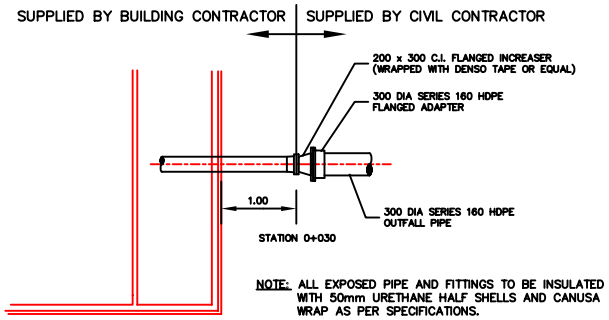

NOTE: ALL EXPOSED PIPE AND FITTINGS TO BE INSULATED WITH 50mm URETHANE HALF SHELLS AND CANUSA WRAP AS PER SPECIFICATIONS.

(4) OUTFALL CONNECTION AT BUILDING

N.T.S.

AS CONSTRUCTED
BY OMM/TROW – NOVEMBER 1999

No.	REVISIONS	DATE	BY	APPD
1	AS CONSTRUCTED	11/99	A.E.A.	A.E.A.
.	ISSUED FOR TENDER	JULY 99	A.E.A.	.

DESIGN A.E.A.
DRAWN A.E.A.
CHECKED D.P.H.

CLIENT: HILL MURRAY
PROJECT: IQALUIT WATER RECLAMATION FACILITY
TITLE: PLANT OUTFALL

OMM — CONSULTING ENGINEERS, HYDROGEOLOGISTS & PLANNERS
P.O. BOX 6 IQALUIT N.T.
Trow

DATE: NOVEMBER 1999
SCALE: N.T.S.
DRAWING NO. MD13153A–D5
REV. 1