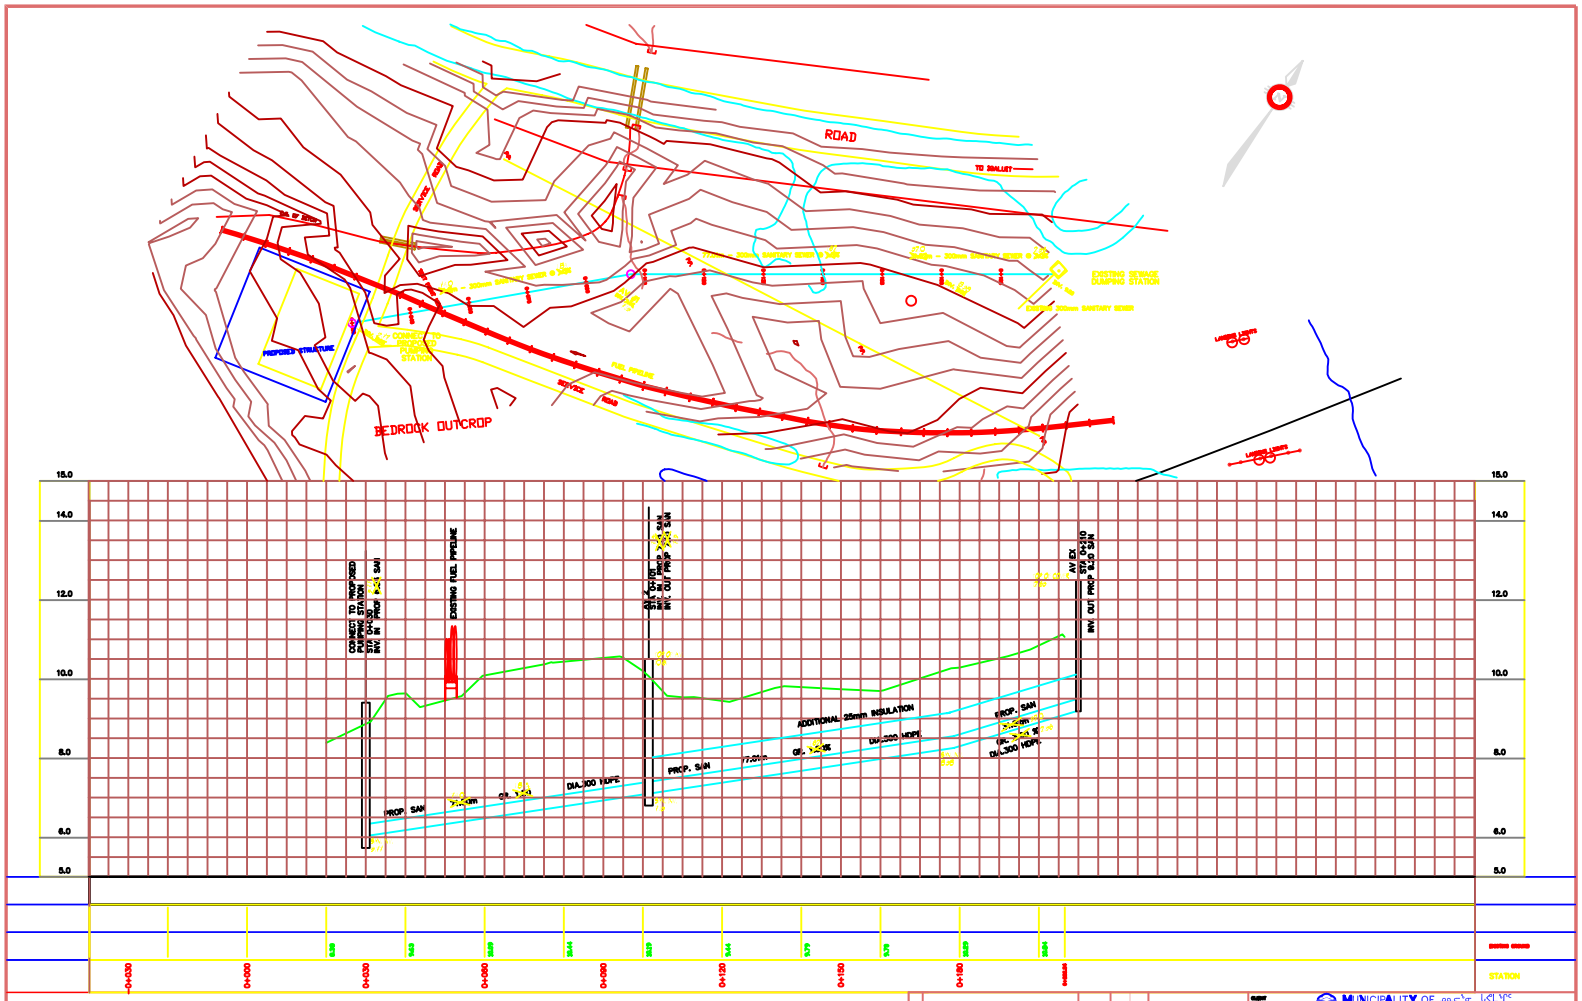

1	AS CONSTRUCTED	11/99	J.E.S. J.E.S.
.	ISSUED FOR TENDER	07/99	J.E.S. D.F.M.
NO.		DATE	BY APP'D

REVISIONS

DESIGN J.E.S.
DRAWN D.J.S.
CHECKED D.J.S.

REVISIONS

CLIENT: MUNICIPALITY OF IQALUIT

PROJECT: IQALUIT SEWAGE TREATMENT PLANT

TITLE: SITE PLAN

OMM — CONSULTING ENGINEERS, HYDROGEOLOGISTS & PLANNERS, P.O. BOX 4, IQALUIT, N.T.

Trow

DATE: NOVEMBER 1999

SCALE: HOR. 1:500, VERT. 1:50

DRAWING NO. MD13153A PP1

REV. 1