
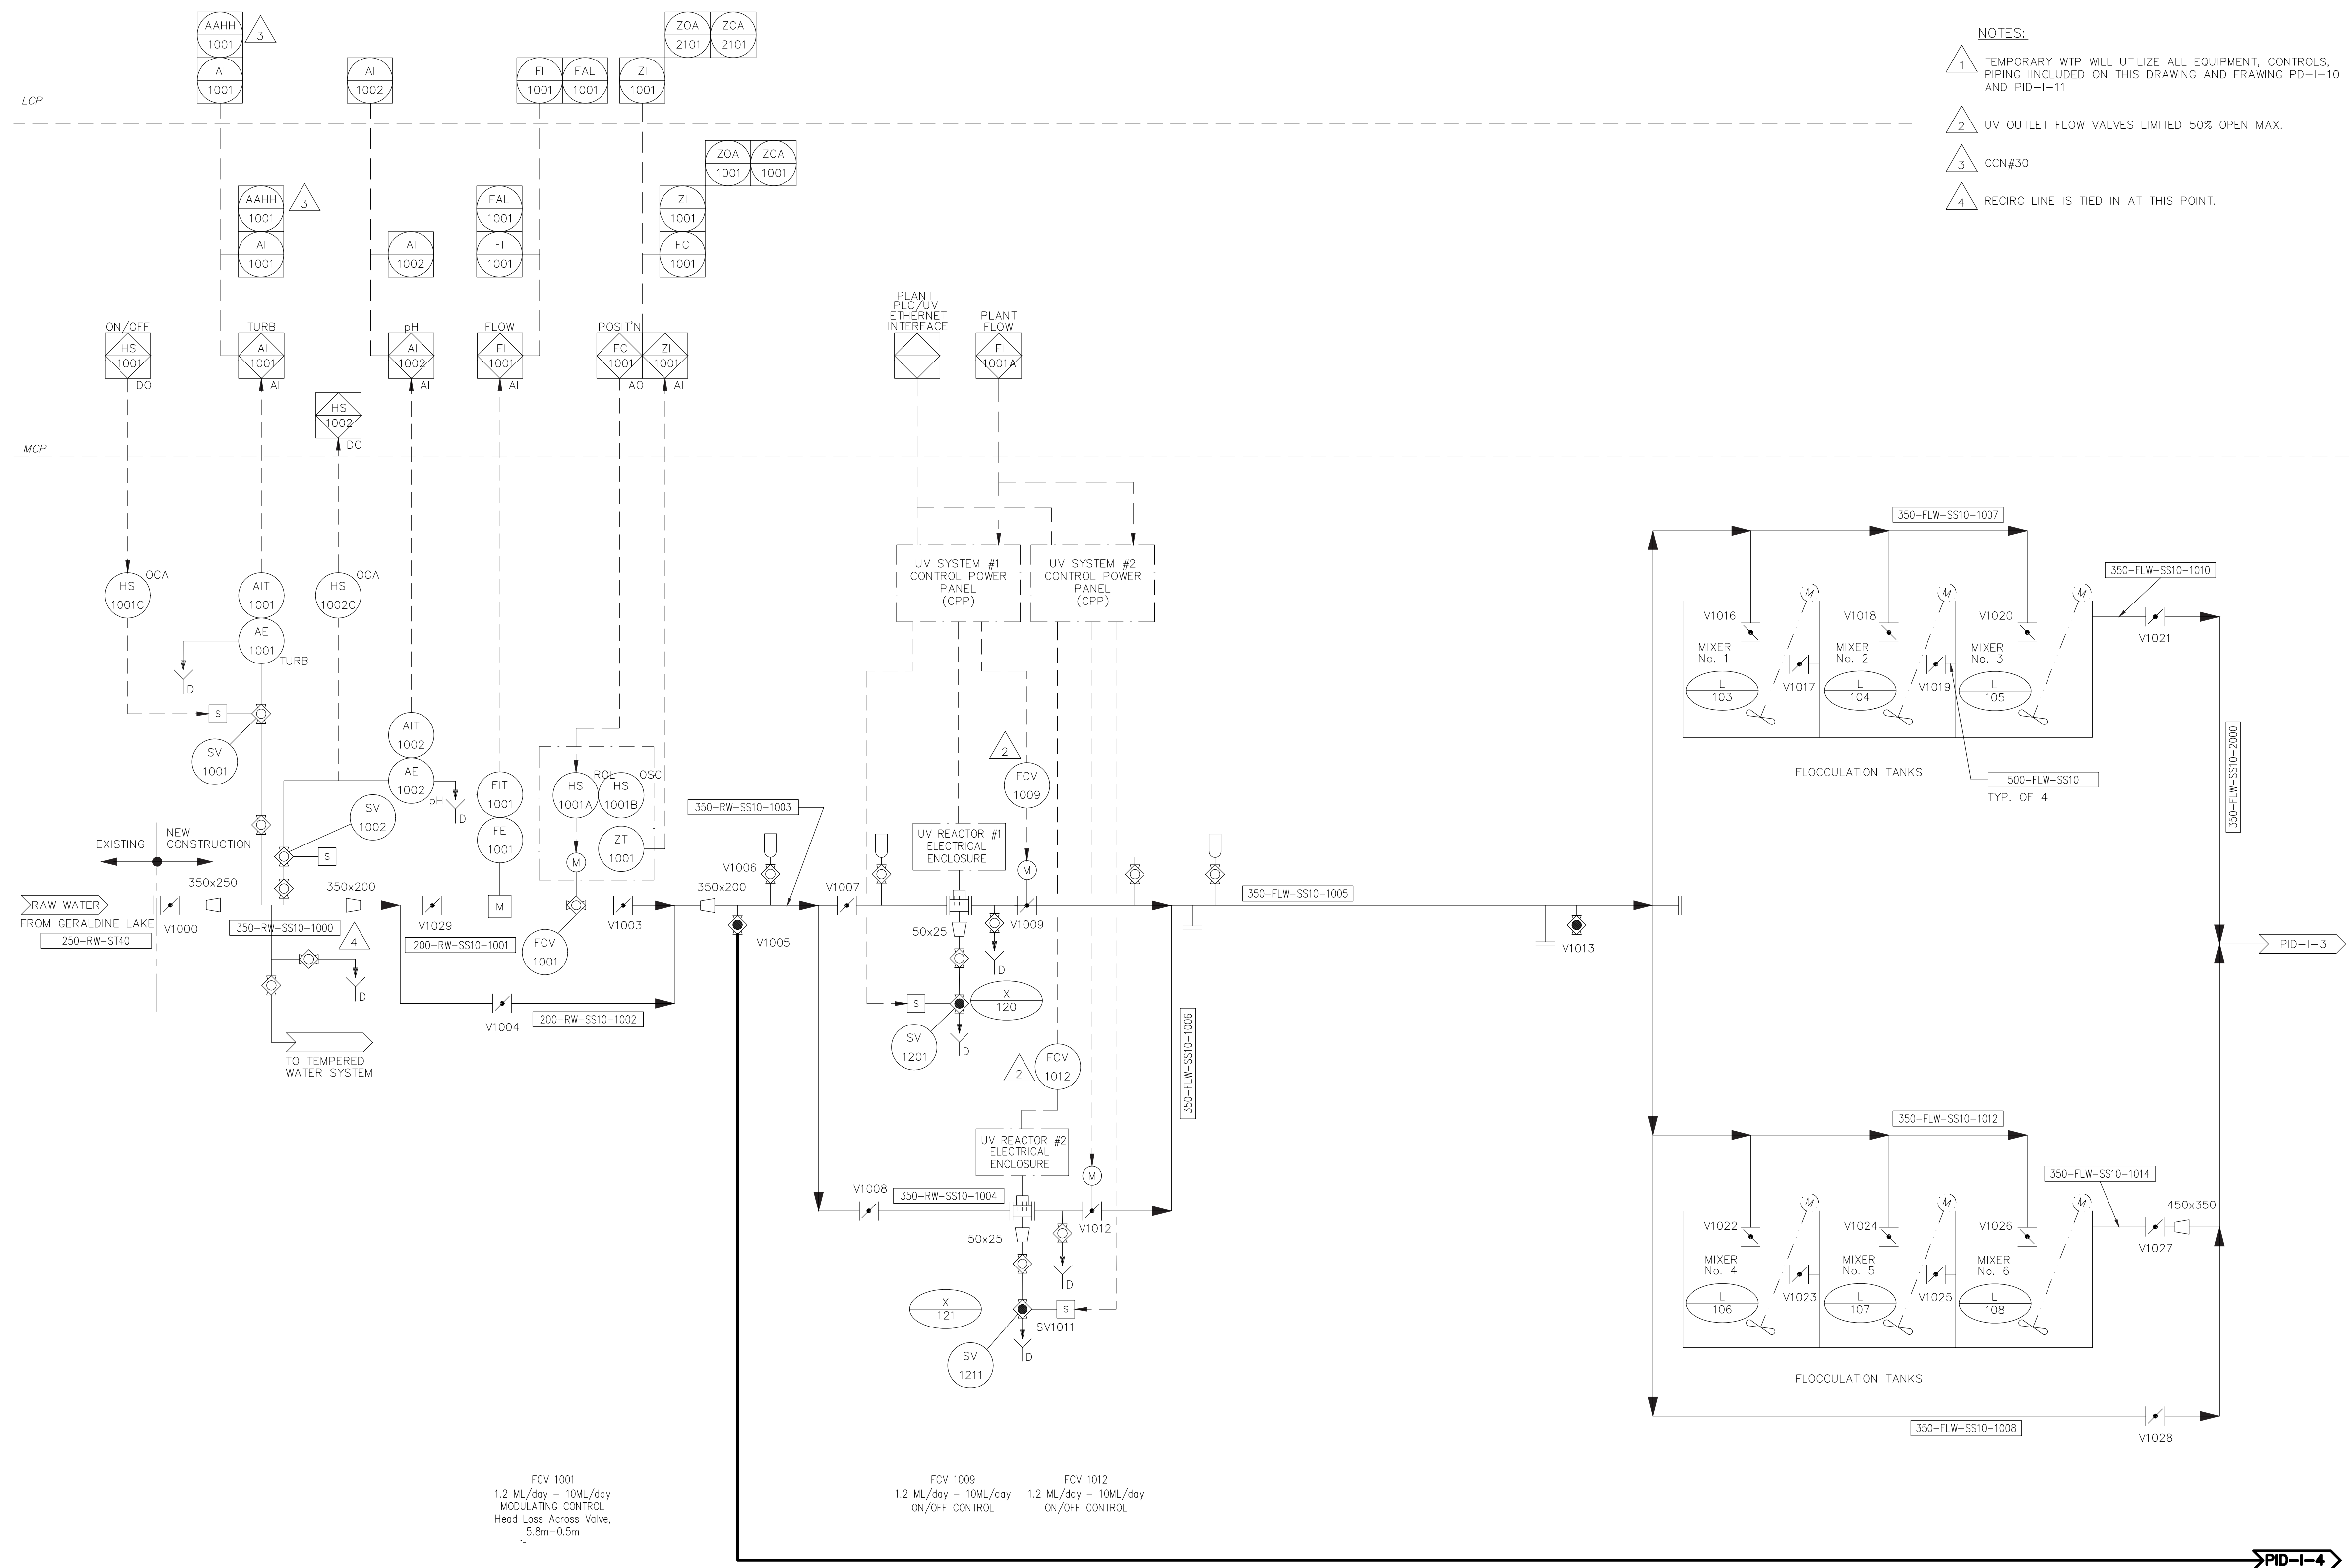


TITLE: MAIN FLOOR PLAN	PROJECT: IQALUIT WATER EMERGENCY	
	DRAWING NUMBER: P-101	REV. A




SEAL:		ORIGINAL SCALE	DATE:
		<u>SCALE</u>	<u>2021/11/12</u>
		DESIGNED BY:	
		<u>C.G.</u>	
		ASSISTED BY:	
		<u>I.M.</u>	
	DRAWN BY:	IF THIS BAR IS NOT 25mm LONG, ADJUST YOUR PLOTTING SCALE.	
	<u>V.A.A</u>		
	MODIFIED BY:		
	<u>V.A.A</u>	25mm	
	APPROVED BY:		
	<u>C.G.</u>		
DISCLAIMER: THIS DRAWING AND DESIGN IS COPYRIGHT PROTECTED WHICH SHALL NOT BE USED, REPRODUCED OR REVISED WITHOUT WRITTEN PERMISSION BY WSP. THE CONTRACTOR SHALL CHECK AND VERIFY ALL DIMENSIONS AND UTILITY LOCATIONS AND REPORT ALL ERRORS AND OMISSIONS PRIOR TO COMMENCING WORK.		COPYRIGHT DISCIPLINE: INFRASTRUCTURE	


TITLE: UNUSED FILTERED WATER TANK (1962)	PROJECT: IQALUIT WATER EMERGENCY	
	DRAWING NUMBER: P-103	REV. A



REVISION:				REVISION:			
A	2021/11/12	FOR DISCUSSION PURPOSES ONLY	C.G.				
REV	DATE	DESCRIPTION	BY	REV	DATE	DESCRIPTION	BY

<div><p>WSP Canada Inc. 1600 Buffalo Place, Winnipeg, Manitoba R3T 6B8 T 204-477-6650 www.wsp.com</p></div> <div>PROJECT NUMBER: 201-09487-00</div>	<div>CLIENT:</div> <div>CITY OF IQALUIT</div> <div>CLIENT REF. #: -</div>	<div>TITLE:</div> <div>PID 1</div>	<div>PROJECT:</div> <div>IQALUIT WATER EMERGENCY</div>
			<div>DRAWING NUMBER:</div> <div>P-104</div>


C:\p\proj\2021\11\21\1 PM IQUALUIT WATER EMERGENCY\2021-11-21 1 PM IQUALUIT WATER EMERGENCY.dwg
2021-11-21 1 PM IQUALUIT WATER EMERGENCY.dwg
2021-11-21 1 PM IQUALUIT WATER EMERGENCY.dwg

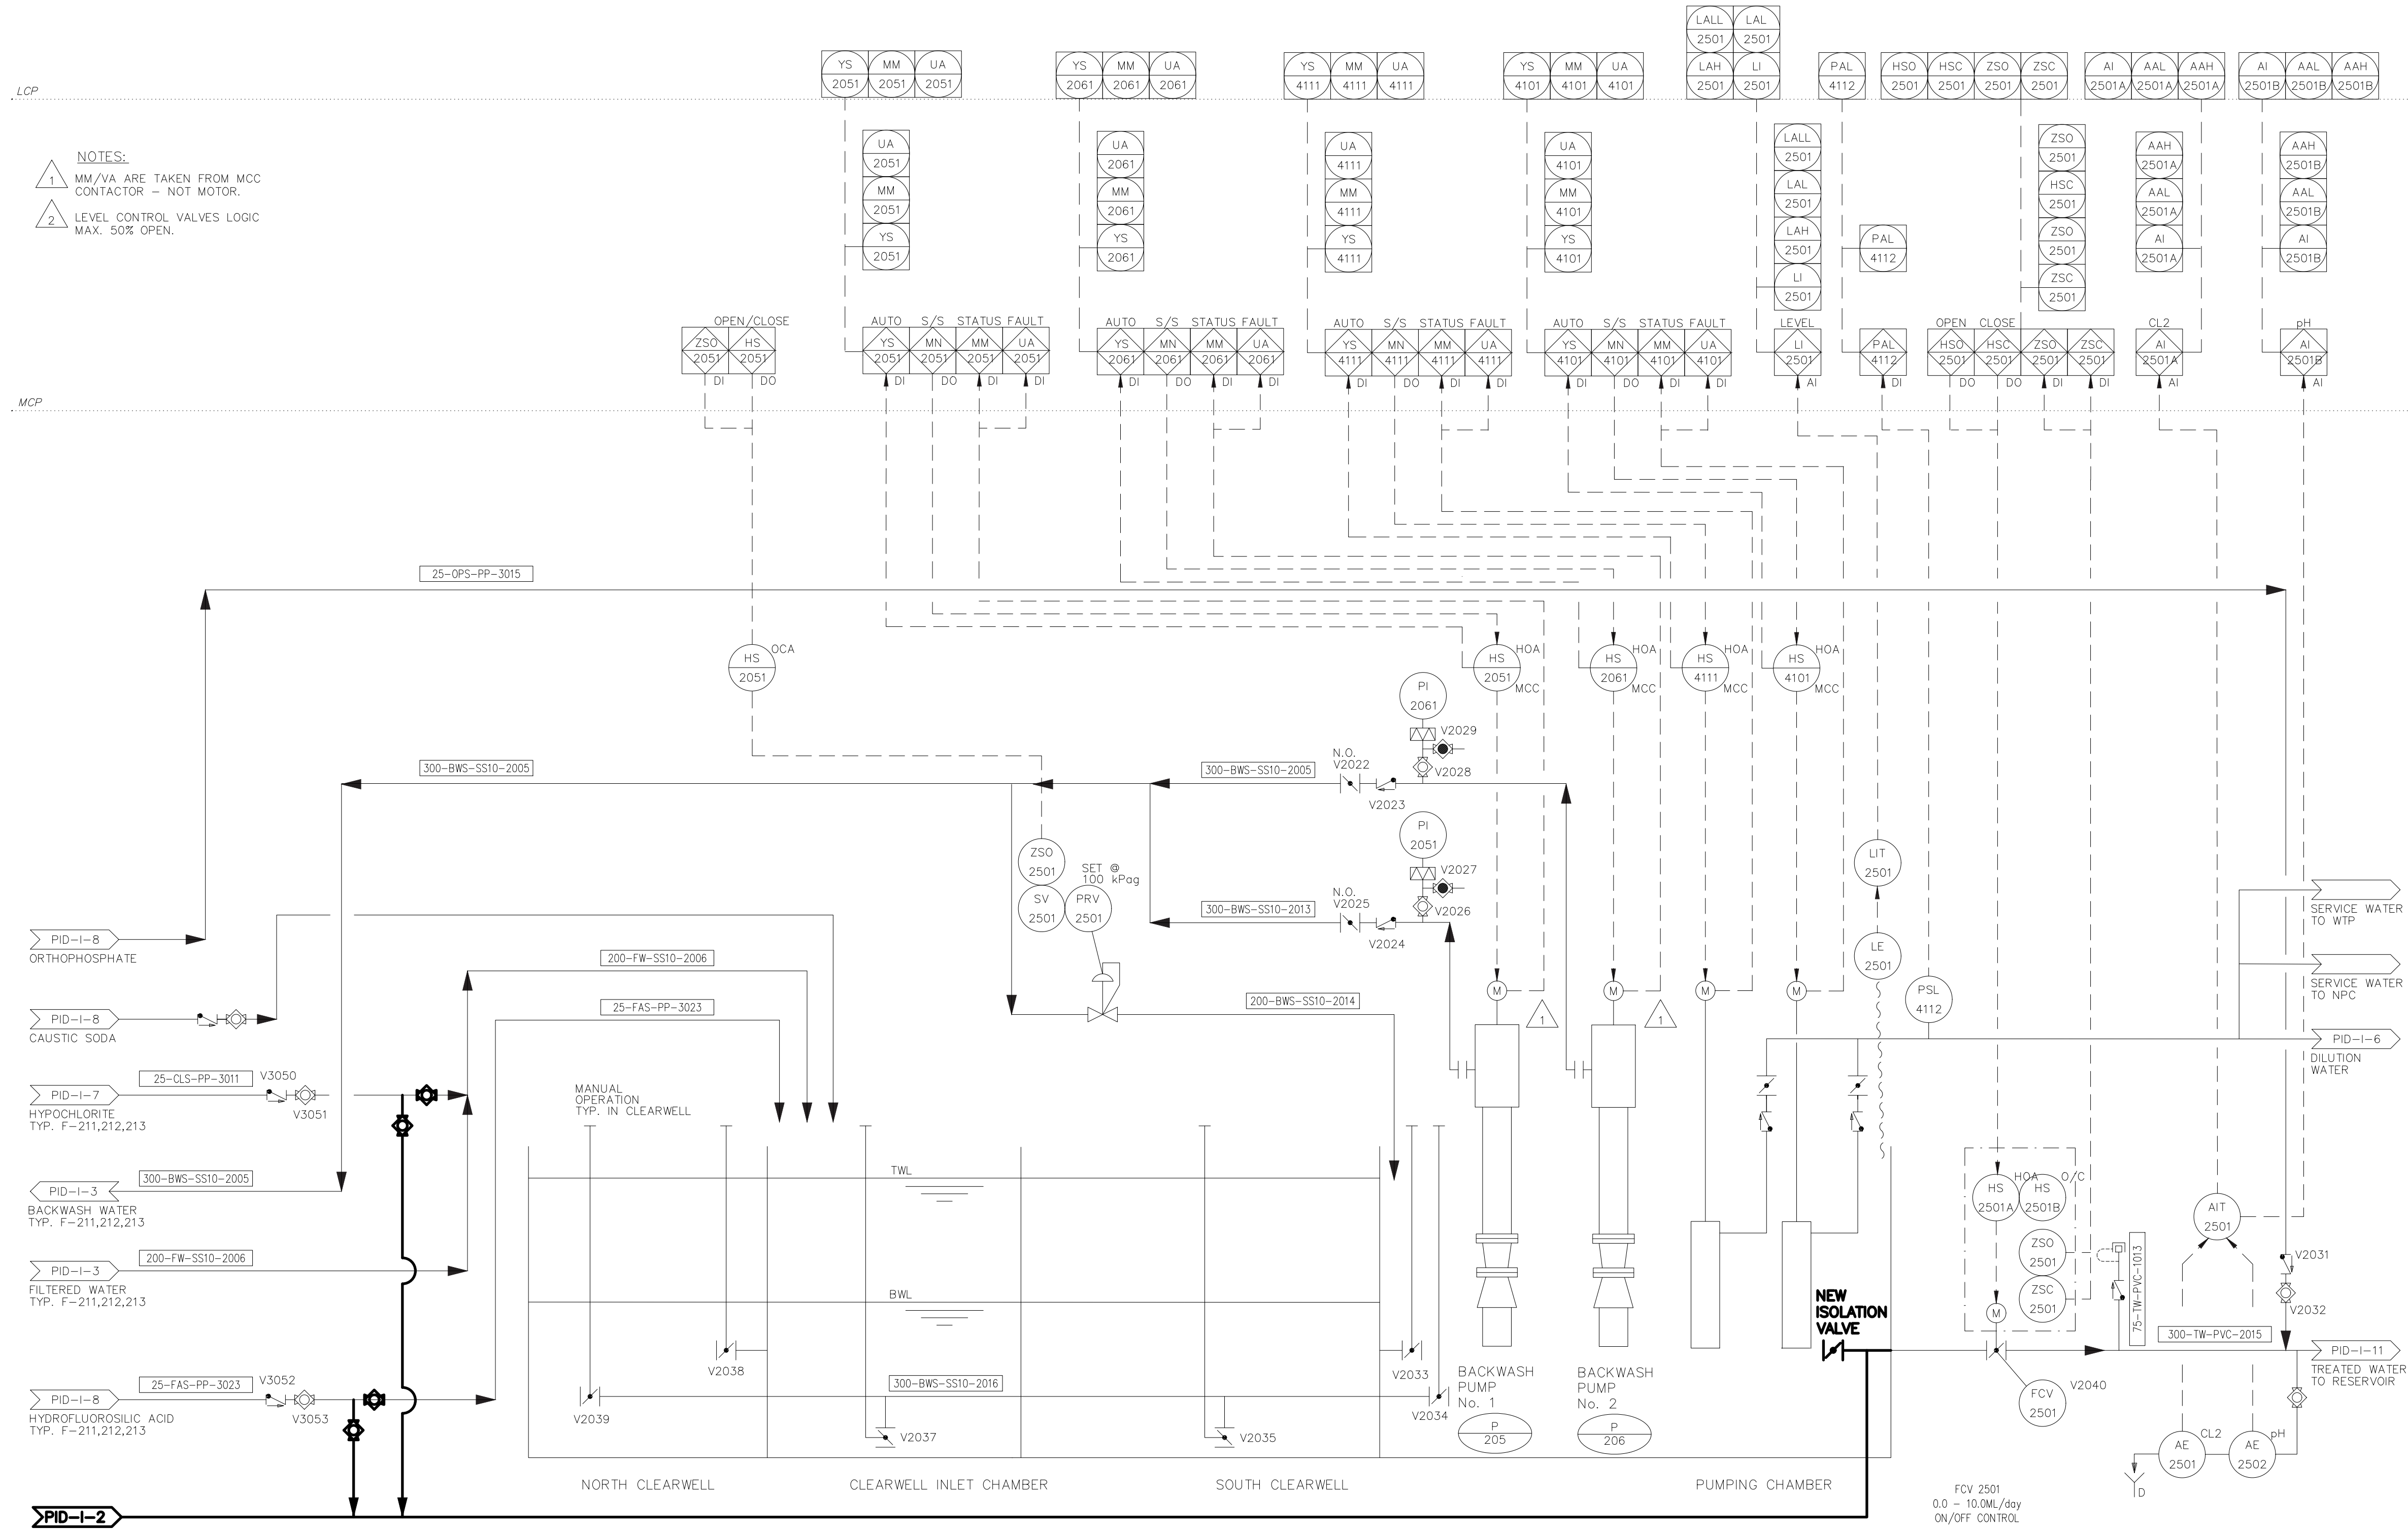

REVISION:				REVISION:			
REV	DATE	DESCRIPTION	BY	REV	DATE	DESCRIPTION	BY
A	2021/11/12	FOR DISCUSSION PURPOSES ONLY	C.G.				

SEAL:	
DISCLAIMER:	COPYRIGHT
THIS DRAWING AND DESIGN IS COPYRIGHT PROTECTED WHICH SHALL NOT BE USED, REPRODUCED OR REVISED WITHOUT WRITTEN PERMISSION BY WSP. THE CONTRACTOR SHALL CHECK AND VERIFY ALL DIMENSIONS AND UTILITY LOCATIONS AND REPORT ALL ERRORS AND OMISSIONS PRIOR TO COMMENCING WORK.	

ORIGINAL SCALE:	SCALE	DATE:	2021/11/12
DESIGNED BY:	C.G.	IF THIS BAR IS NOT 25mm LONG, ADJUST YOUR PLOTTING SCALE.	
ASSISTED BY:	I.M.		
DRAWN BY:	V.A.A.		
MODIFIED BY:	V.A.A.		
APPROVED BY:	C.G.		
DISCIPLINE:	INFRASTRUCTURE		

 WSP Canada Inc. 1600 Buffalo Place, Winnipeg, Manitoba R3T 6B8 T 204-477-6650 www.wsp.com		CLIENT:	CITY OF IQALUIT
PROJECT NUMBER: 201-09487-00		CLIENT REF. #:	-

TITLE:		PID 2	PROJECT:	IQUALUIT WATER EMERGENCY
DRAWING NUMBER:		P-105	REV:	A