



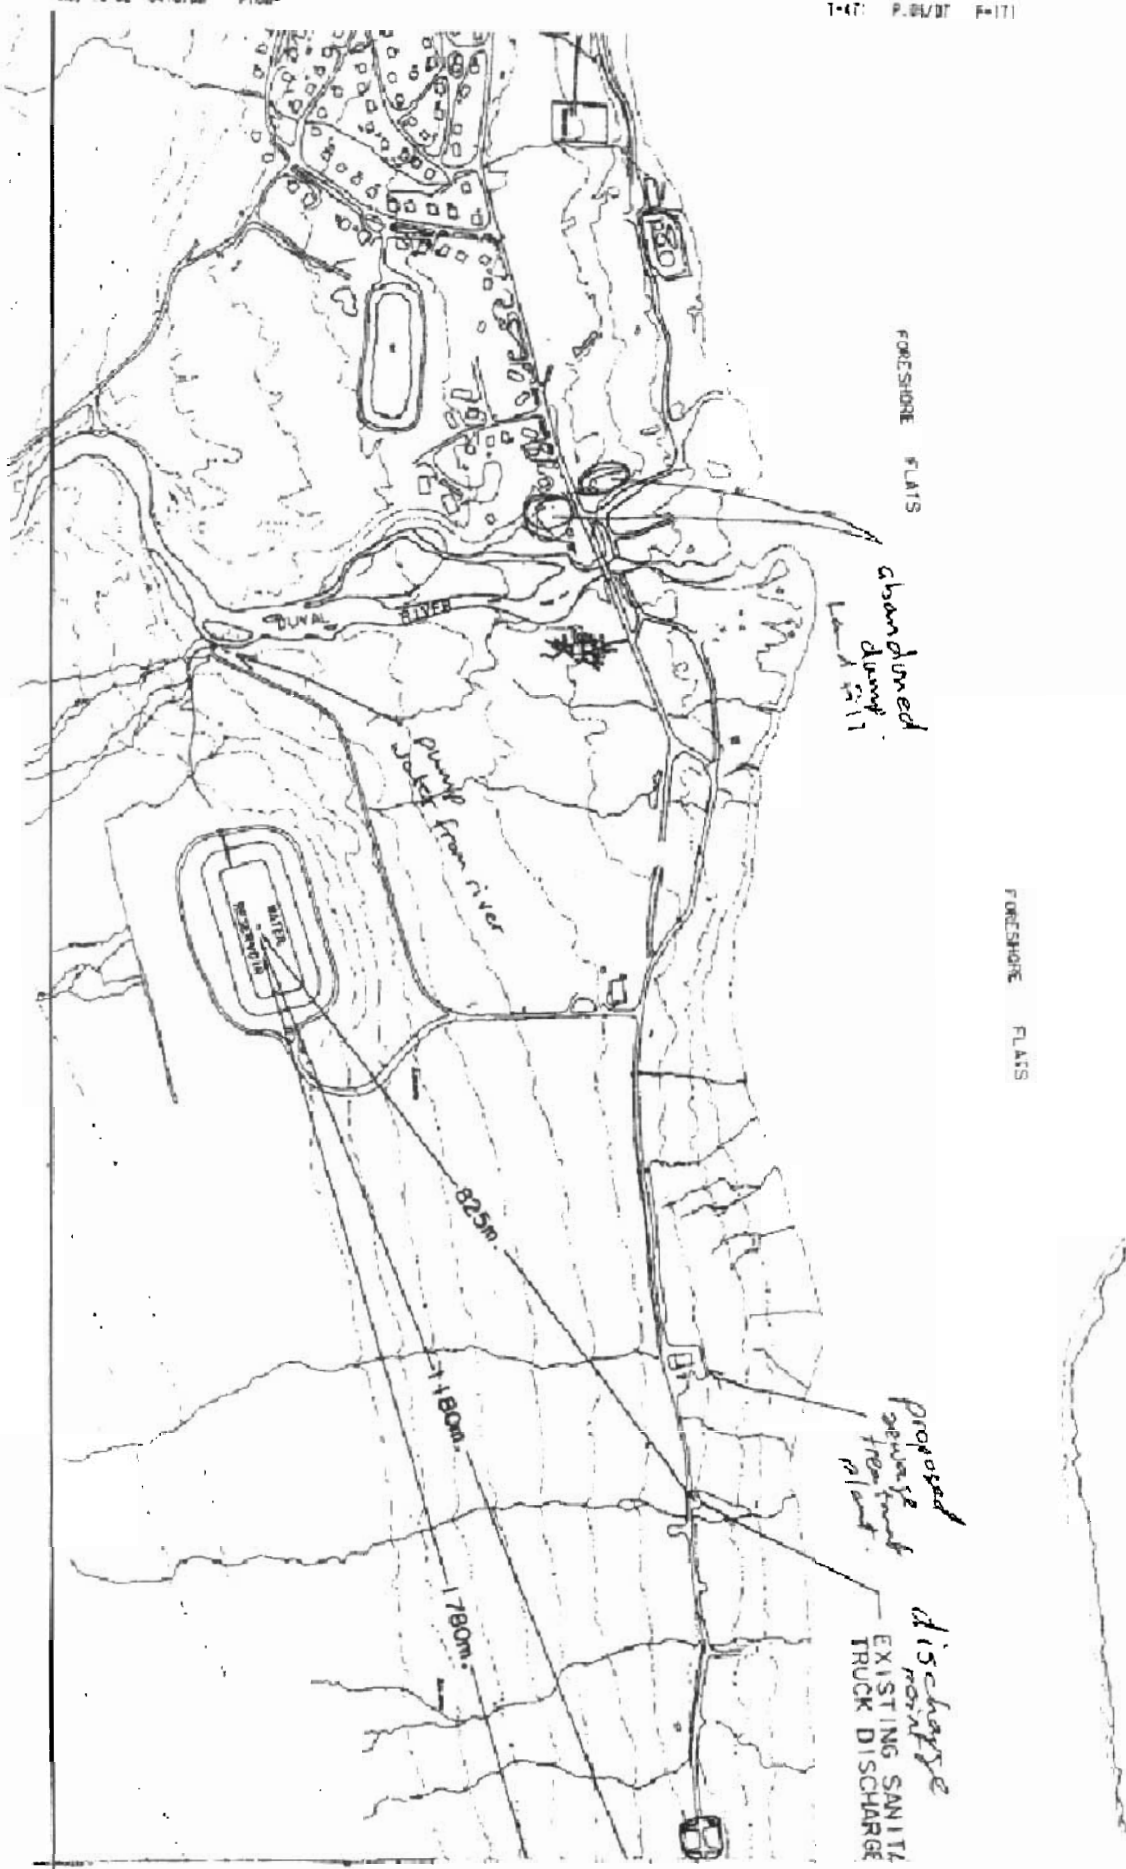

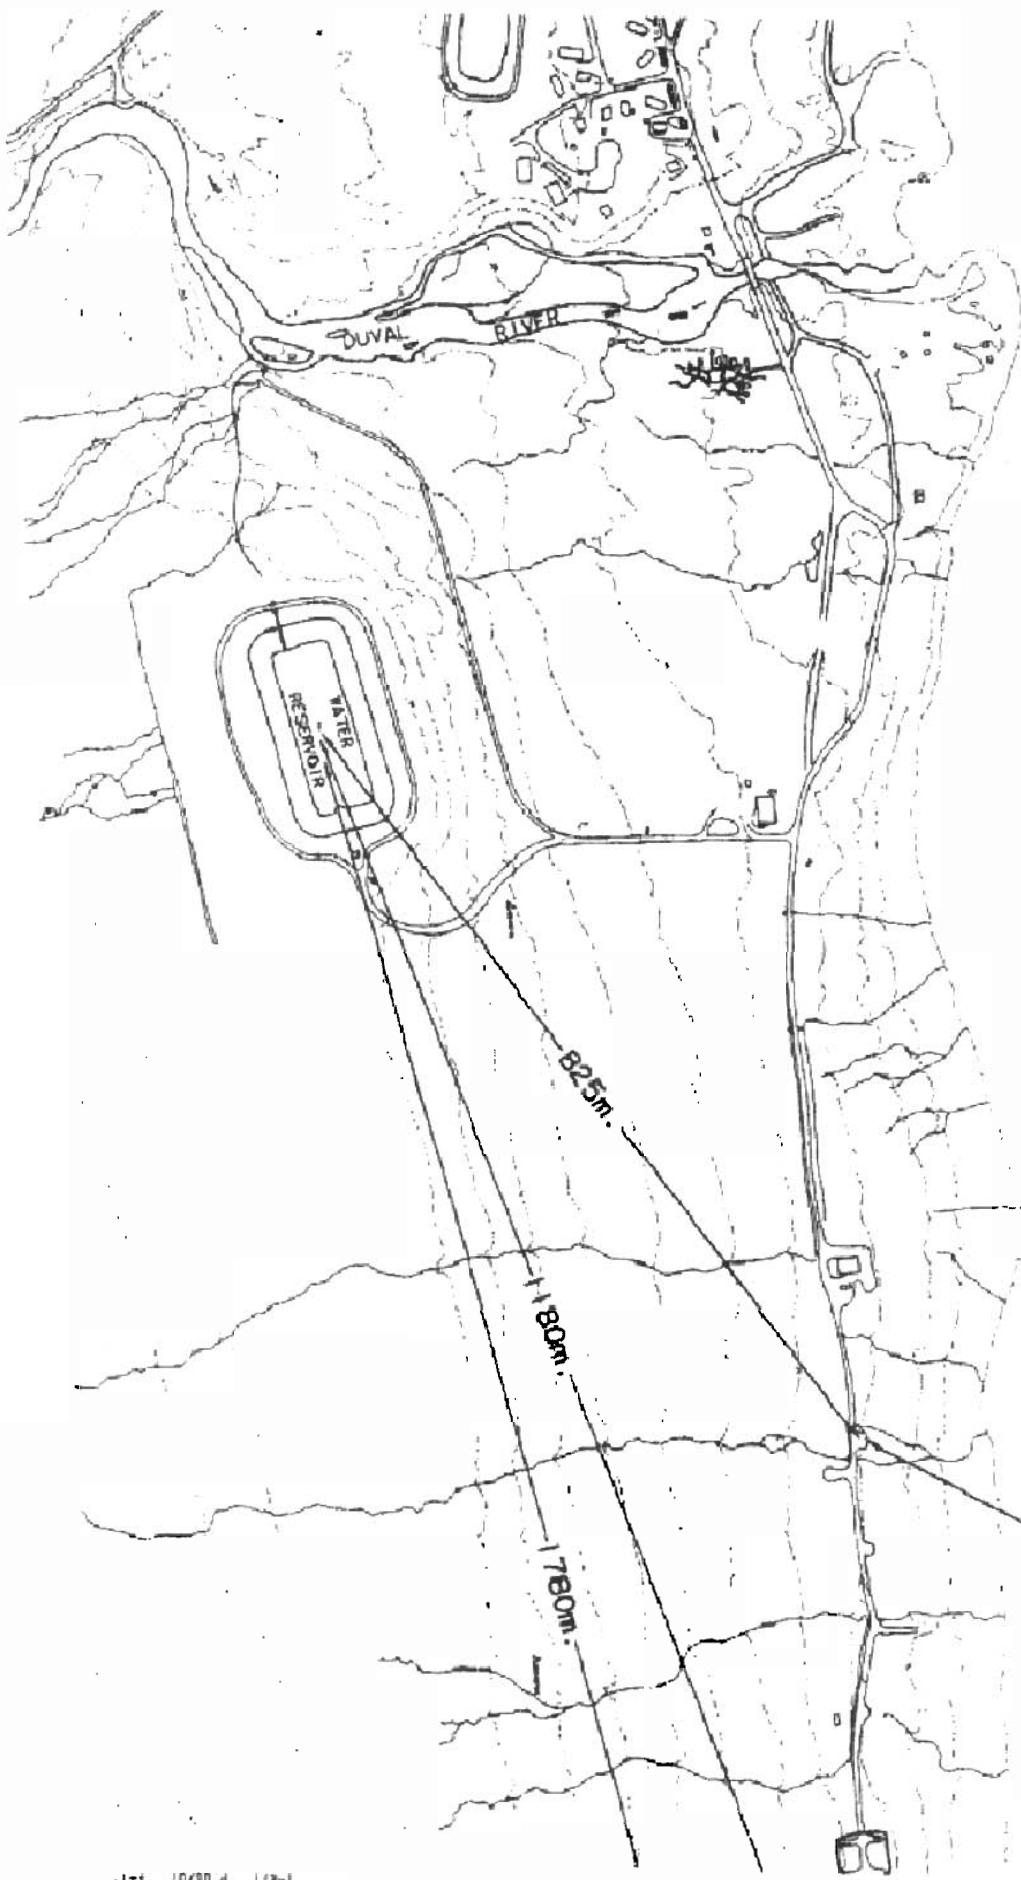

EXISTING SANITARY
TRUCK DISCHARGE

PANGNIPTUNG FJORD

scale 1:2000 m.

