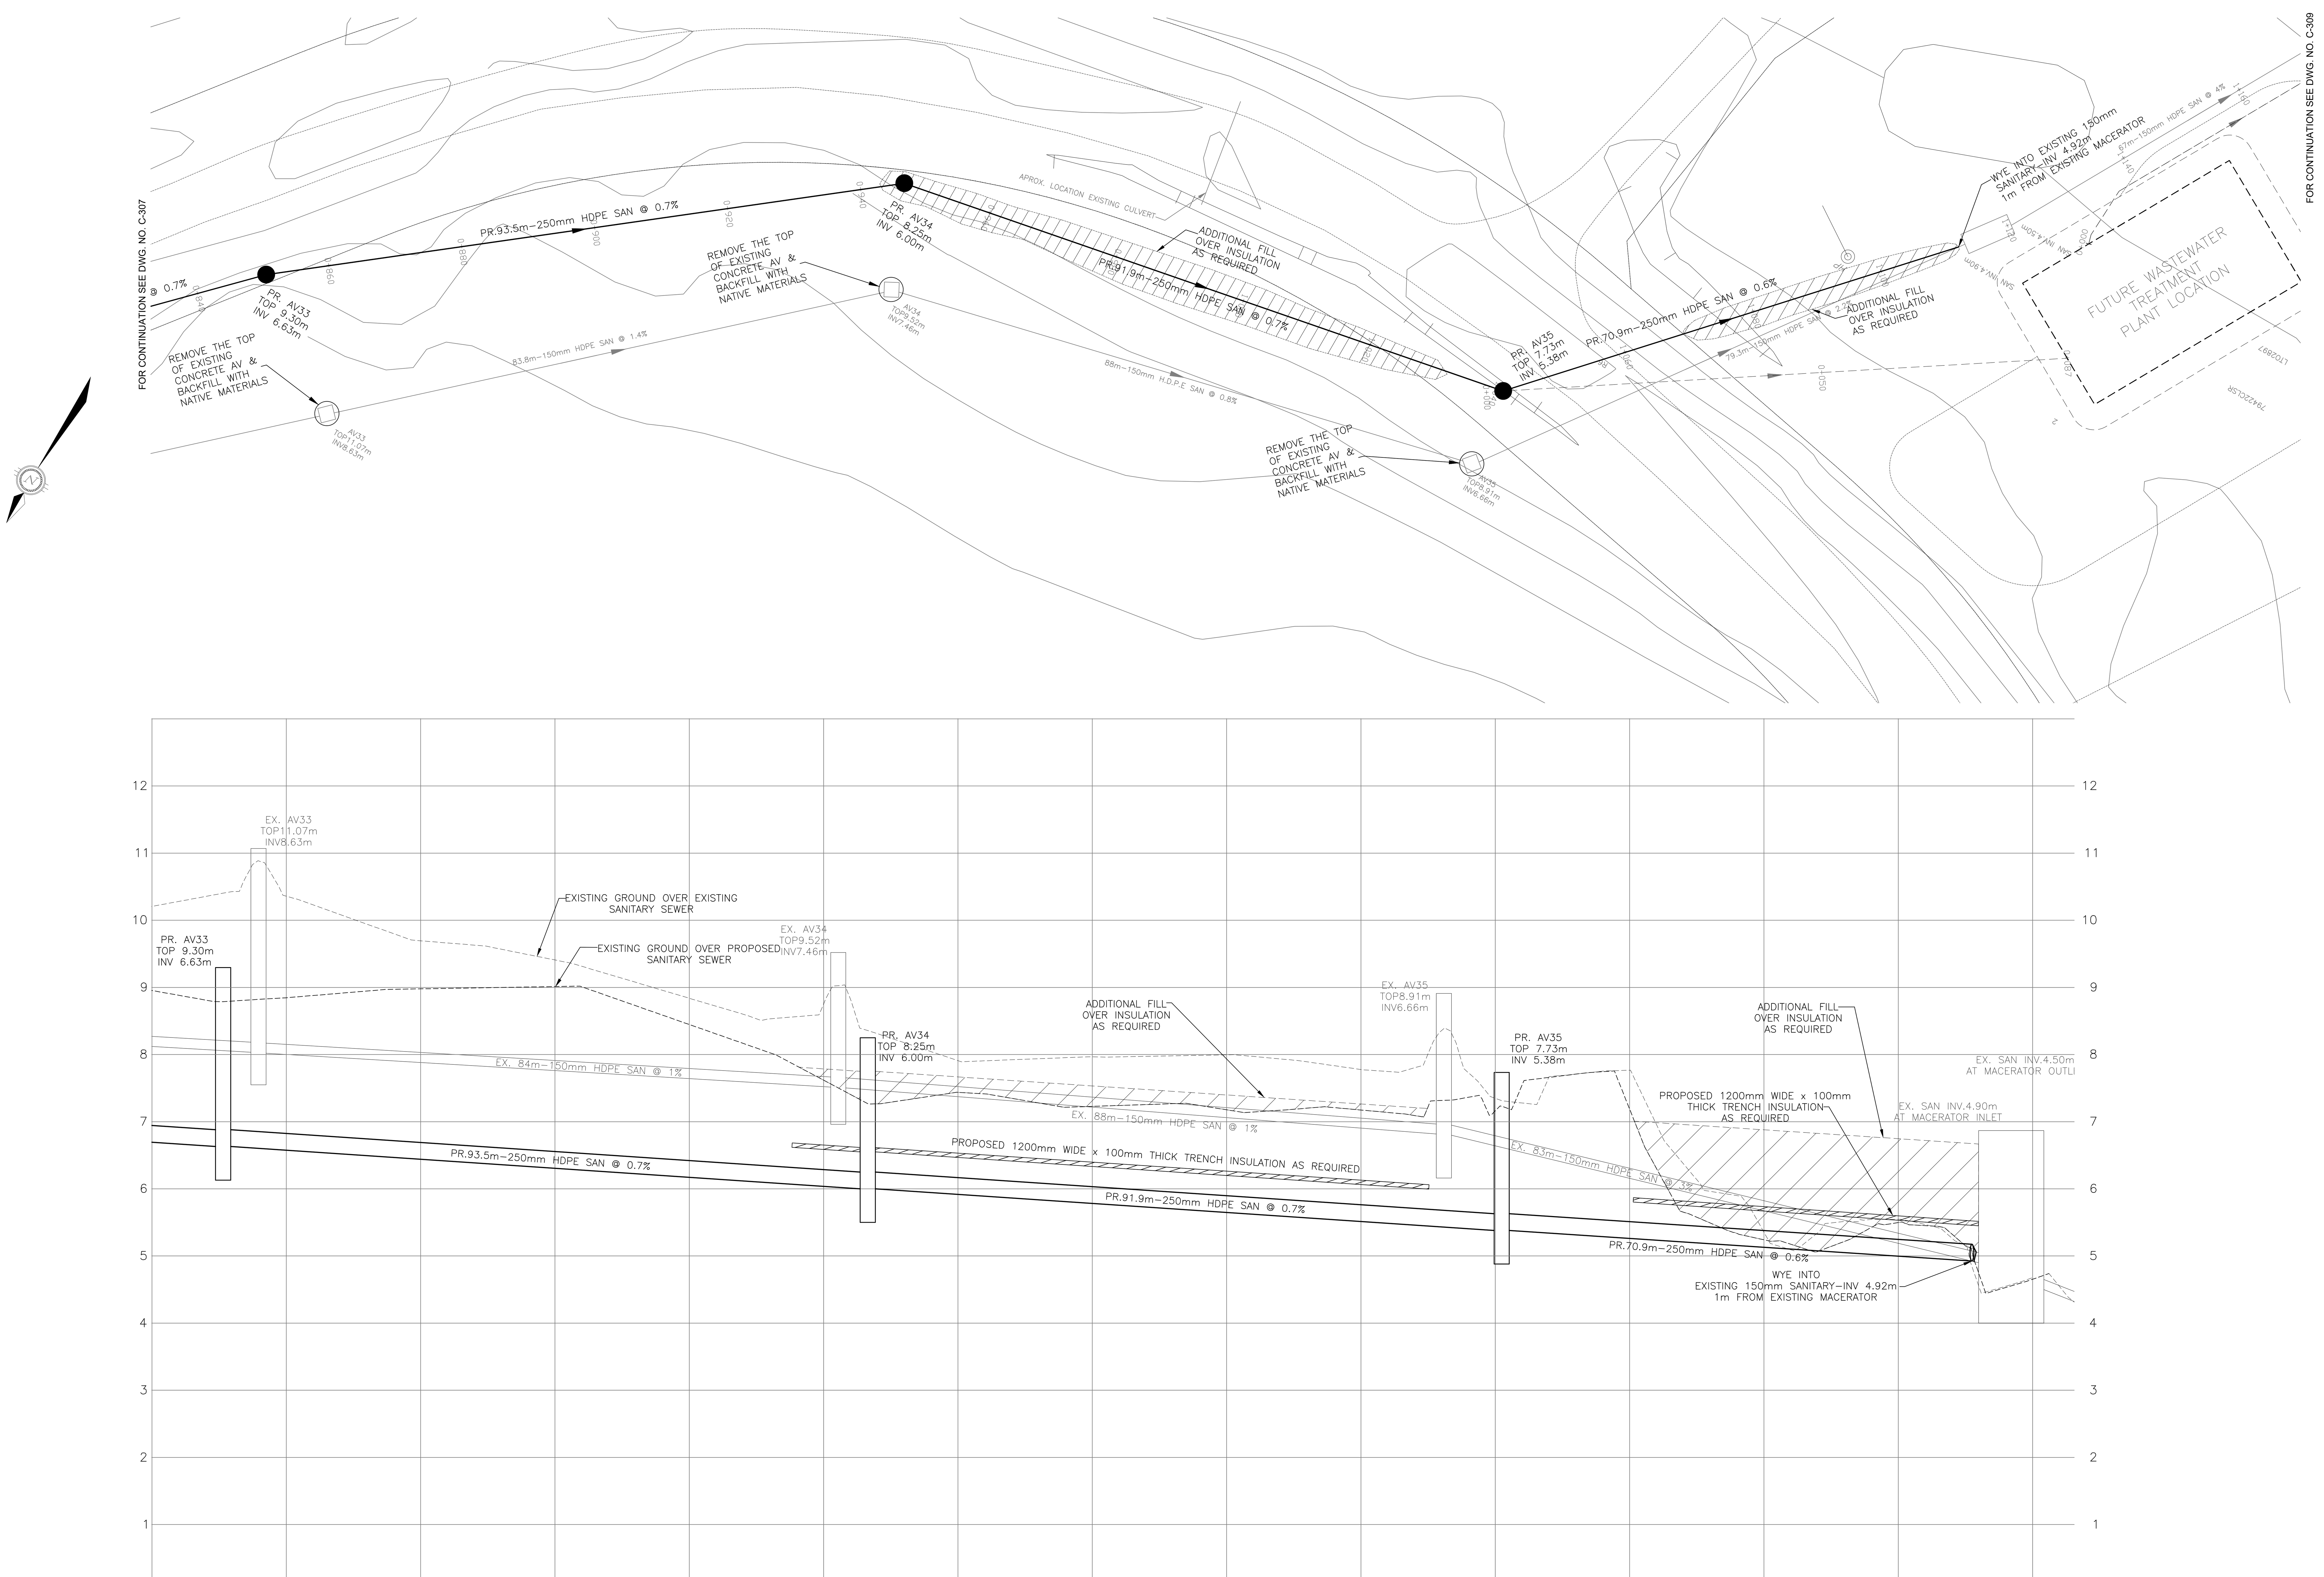

CHAINAGE	0+850.60	0+860	0+880	0+900	0+920	0+940	0+946.58	0+960	0+980	1+000	1+020	1+040	1+040.96	1+060	1+080	1+100	1+111.97	1+120	1+121.67
PROPOSED ELEVATION		8.85	8.98	9.01	8.45	7.62		7.44	7.23	7.18	7.17	7.16		7.19	5.24	5.50		4.65	
TOP OF WATERMAIN ELEVATION																			
TOP OF WATER RECIRC ELEVATION																			
SANITARY SEWER INVERT	6.63 6.63			93.5m–250mmø SERIES 128 HDPE SAN @ 0.7%			6.00 6.00			91.9m–250mmø SERIES 128 HDPE SAN @ 0.7%			5.38 5.38		70.9m–250mmø SERIES 128 HDPE SAN @ 0.6%		4.92 EX.4.90		EX.4.50
EXISTING ELEVATION		8.04	8.73	6.07	6.13	6.07		6.10	6.08	6.04	6.08	6.06		6.72	6.41	6.08		6.94	

No.	Issue	Date
01	ISSUED FOR TENDER	2013-MAR-25
02	REISSUED FOR TENDER	2013-OCT-25
02	ISSUED FOR CONSTRUCTION	2014-APR-21
04	ISSUED FOR AS-BUILT	2016-APR-26

Nunavut

AS-BUILT

DATE: APRIL 26, 2016

No.	Revision	Ckd. By	Date
00	100% SUBMISSION	SLB	2013-MAR-04

Const. North

Date Printed

Drawn By: I.CRAWFORD

Dwg. Standards Ckd. By:

Designed By: A. ZARAD

Dwg. Design Ckd. By: S. BURDEN

exp Services Inc.
t: +1.613.688.1899 | f: +1.613.225.7330
2650 Queensview Drive, Unit 100
Ottawa, ON K2B 8H6
CANADA
www.exp.com

• BUILDINGS • EARTH & ENVIRONMENT • ENERGY • INDUSTRIAL • INFRASTRUCTURE • SUSTAINABILITY •

Project Title

NEW UTILIDOR DESIGN
RESOLUTE BAY, NU

Dwg. Title

PLAN AND PROFILE AV33 TO EXIST. SAN

Project No. OTT-00206333-A0

Dwg. No. C-308

Rev. No. 03

Scale 1:500

This drawing is not to be scaled

exp Services Inc. © 2012