


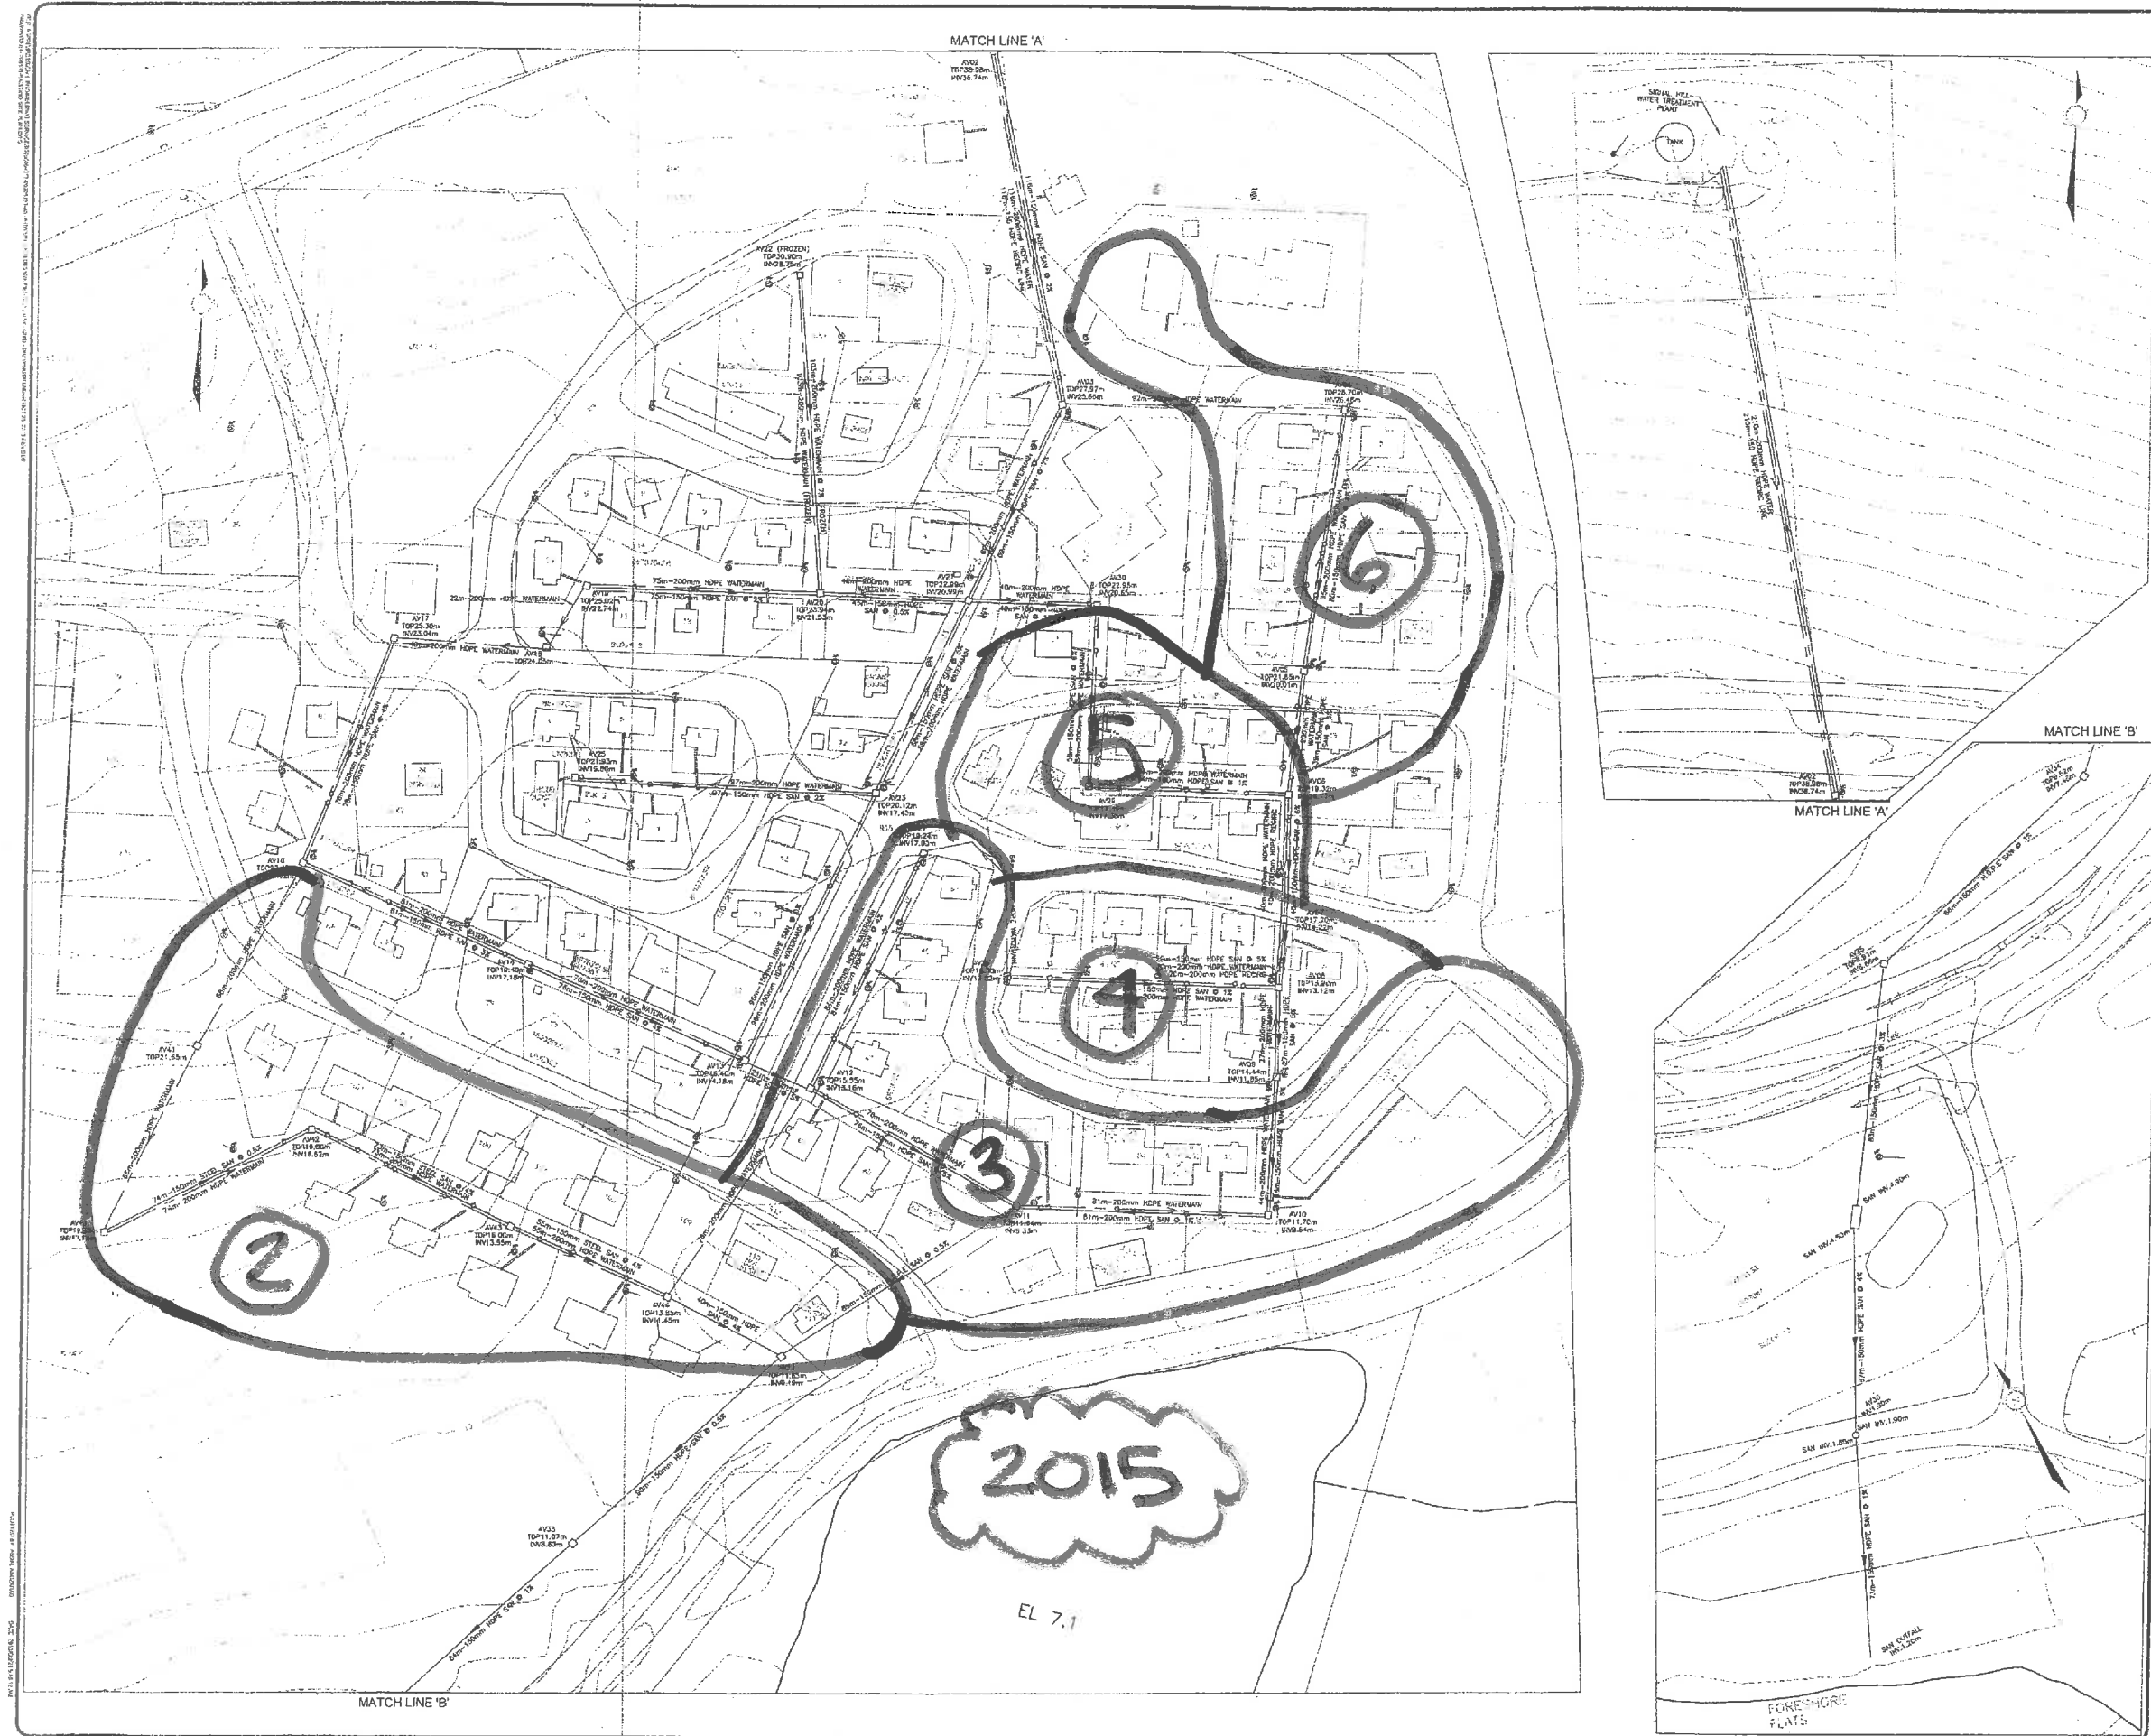

No.	Issue	Date
01	ISSUED FOR TENDER	2013-MAR-23
02	REISSUED FOR TENDER	2013-OCT-25



Nunavut

No.	Revision	Clk. By	Date
00	100% SUBMISSION	SLB	2013-MAR-31


PERMIT OF PRACTICE
EXP SERVICES INC.

Signature: S. Burden

Date: Oct 3, 2013

PERMIT NUMBER: P483
NT/NU Association of Professional
Engineers and Geoscientists

ISSUED FOR TENDER

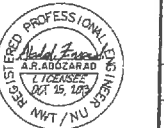

Registered Professional Engineer
A. R. ADGARAD
Licenses
NWT / NU

Drawn By:	
I. CRAWFORD	

Dwg. Standards	
Clk. By:	

Designed By:	
A. ZARAD	

Dwg. Design	
Clk. By: S. BURDEN	

exp Services Inc.
P: +1 813 686 1869 | F: +1 813 226 7330
2550 Greenview Drive, Unit 100
Ottawa, ON K2B 6H6
CANADA
www.exp.com



• BUILDINGS • EARTH & ENVIRONMENT • ENERGY •
• INDUSTRIAL • INFRASTRUCTURE • SUSTAINABILITY •

Project Title	
NEW UTILIDOR DESIGN RESOLUTE BAY, NU	

Dwg. Title	
SITE PLAN EX. UTILIDOR SYSTEM	

Project No.	
OTT-00206333-A0	

Dwg. No.	
C-302	

Rev. No.	
02	

Scale	
1:1000 This drawing is not to be scaled	

PROJ. NO. 00206333-0001
DRAWN BY: I. CRAWFORD
CHECKED BY: A. ZARAD
DATE: 2013-03-31