

Figure 1
Location Plan



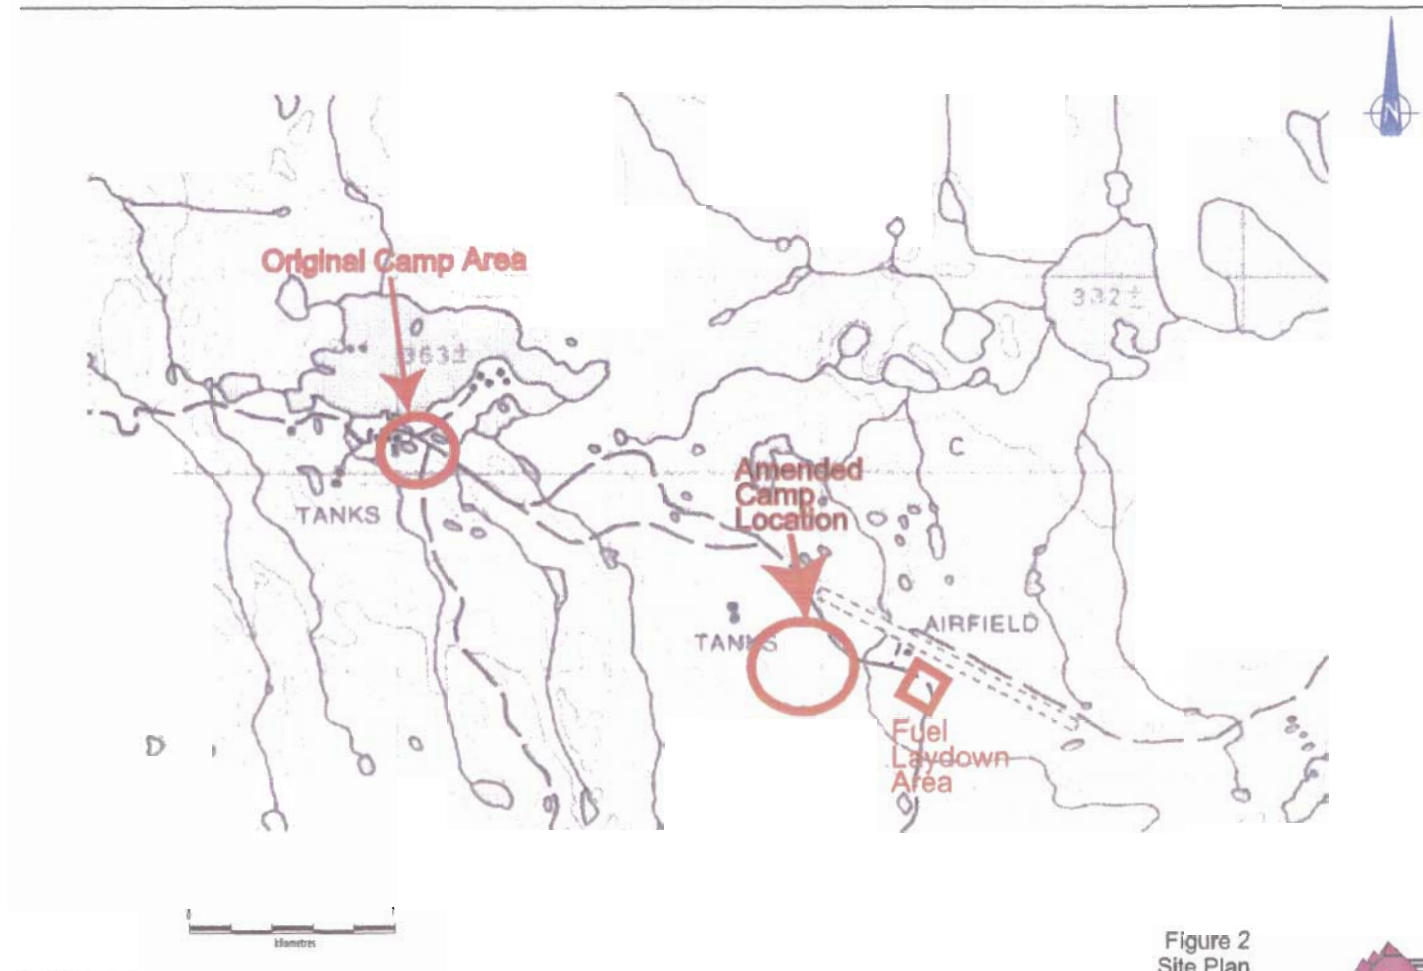


Figure 2
Site Plan

Location:
Latitude: 67°26.088 N
Longitude: 116°24.85 W
NTS Map No. 86N/8



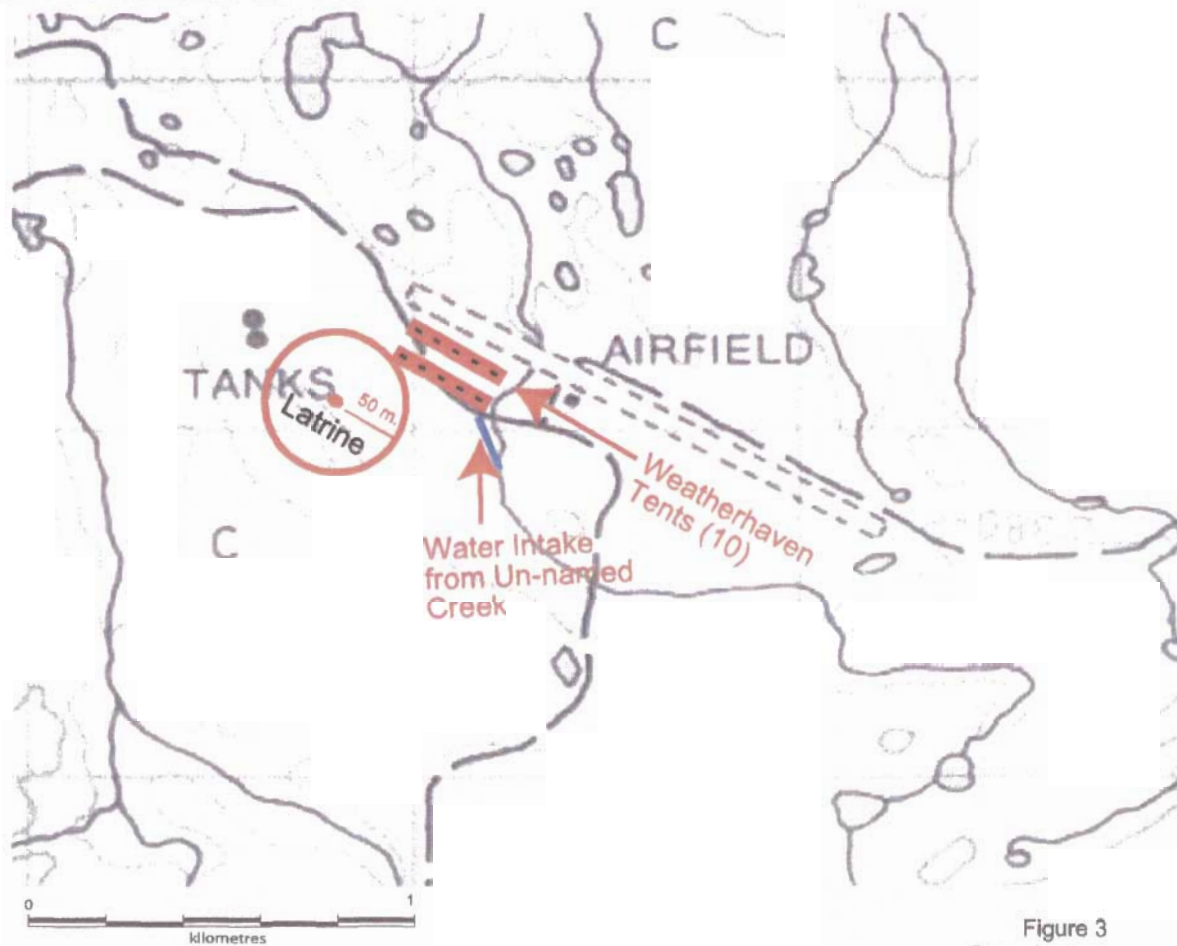


Figure 3
Camp Layout

Location:
Latitude: 67°26.088 N
Longitude: 116°24.85 W
NTS Map No. 88N/8

