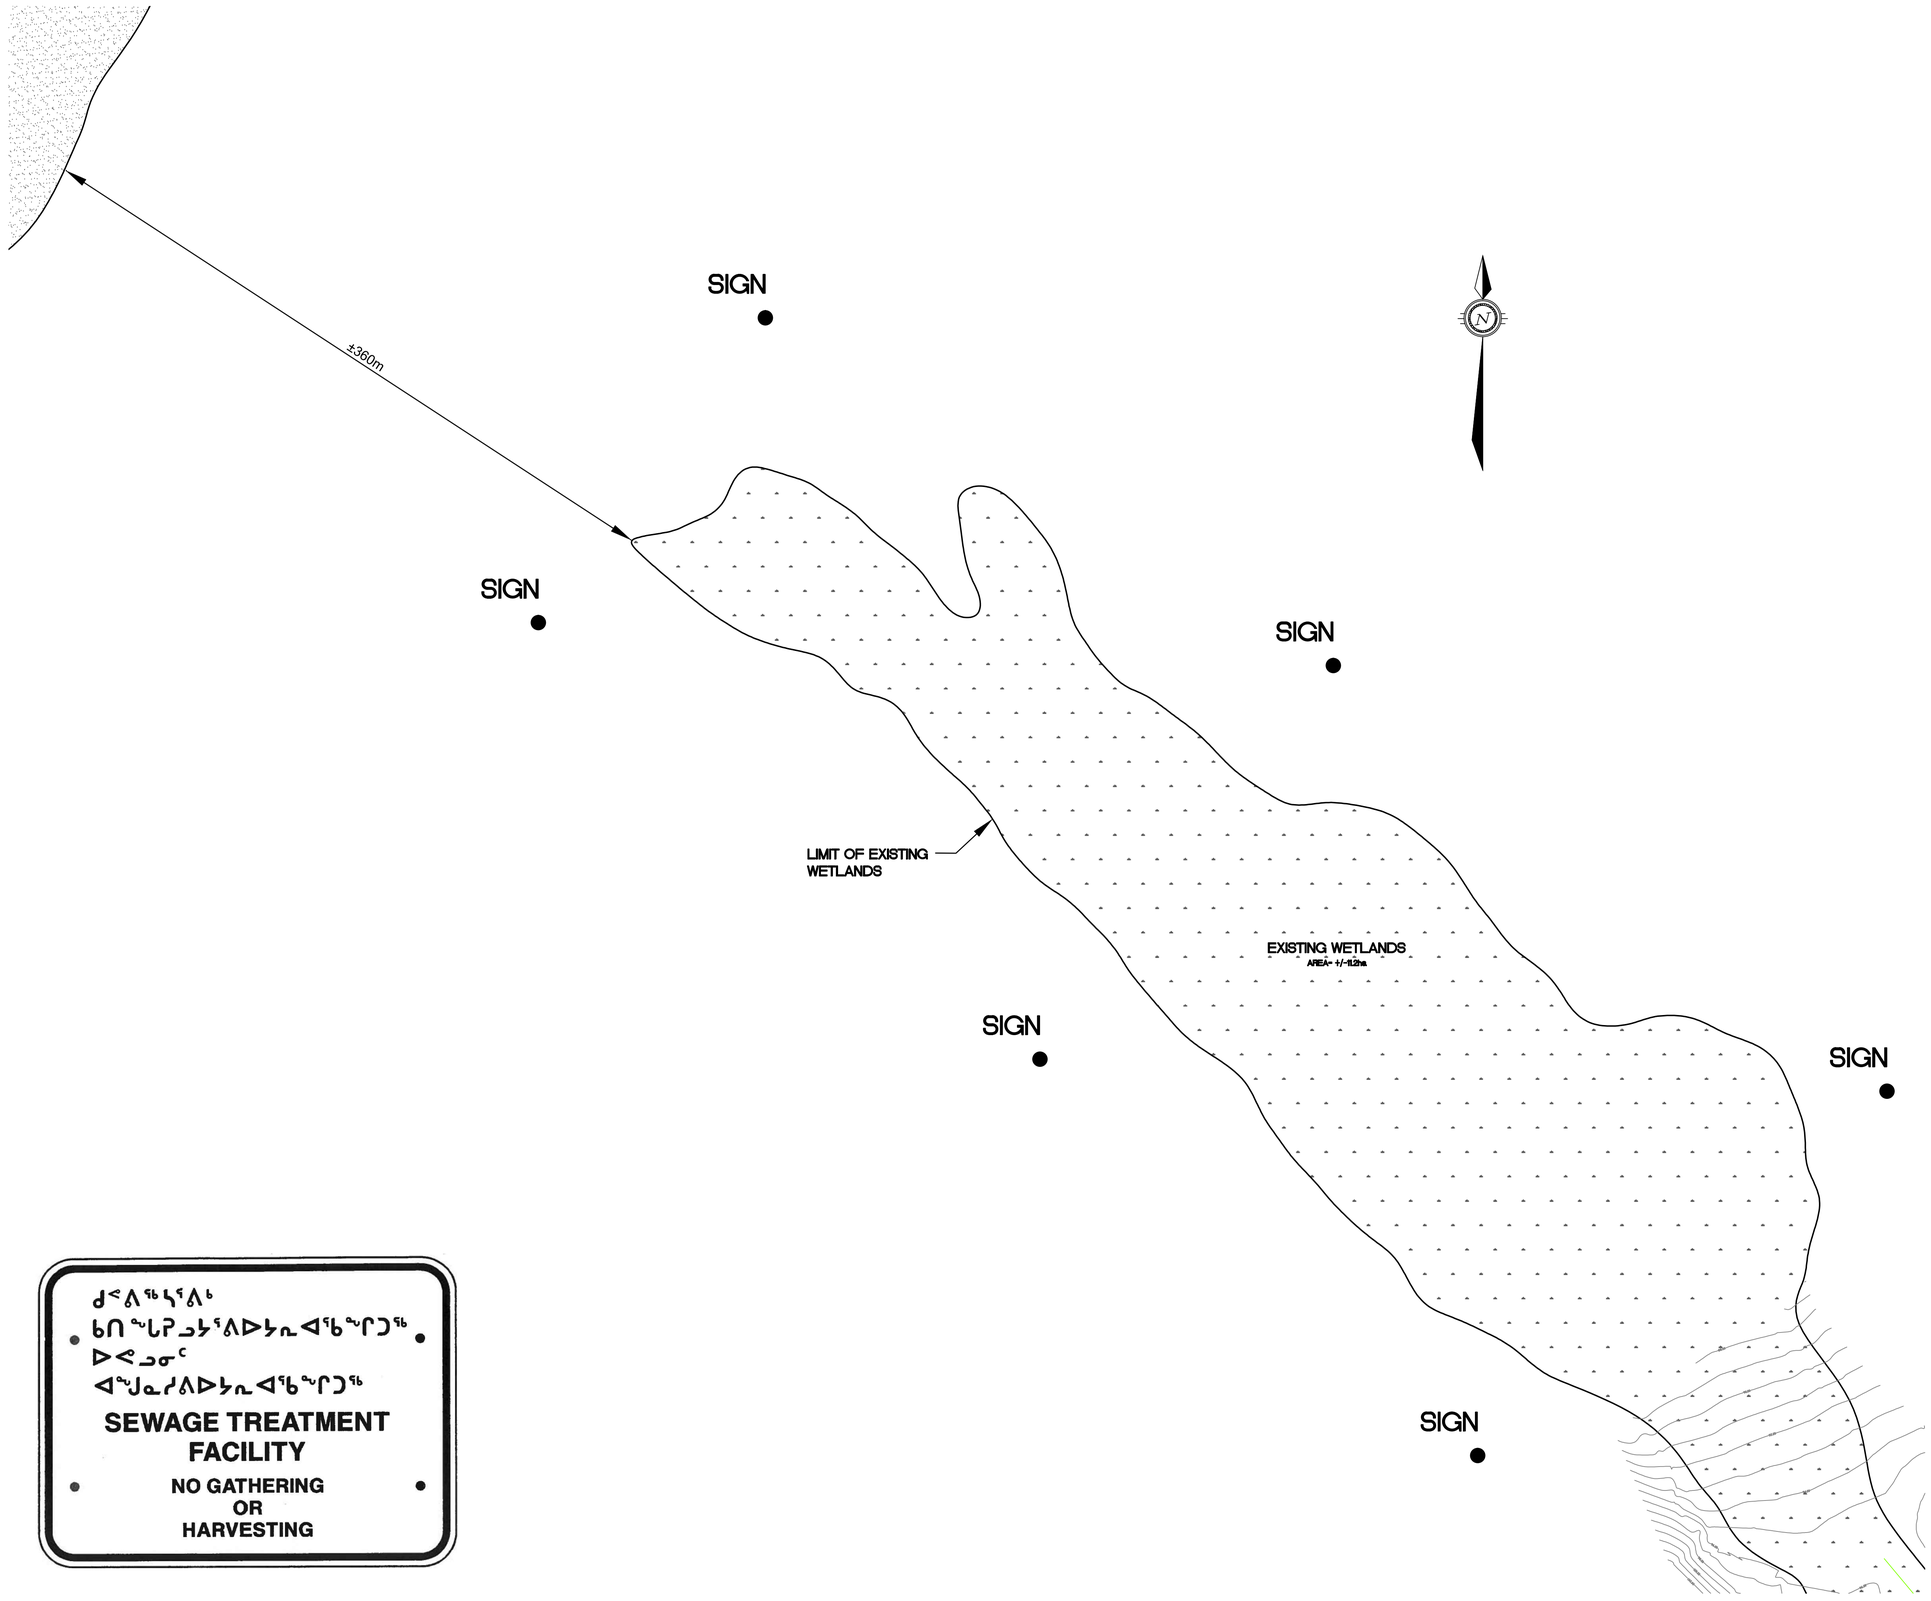

ᑯᐸᐃᖅᓴᕐᐃᒃ
ᑲᑎᖕᒐᕈᓗᒃᑐᐅᔭᕆᐊᖃᖕᒋᑐᖅ
ᐅᐸᓗᓂᑦ
ᐊᖑᓇᓱᐃᐅᔭᕆᐊᖃᖕᒋᑐᖅ

SEWAGE TREATMENT FACILITY

NO GATHERING OR HARVESTING

KEY PLAN

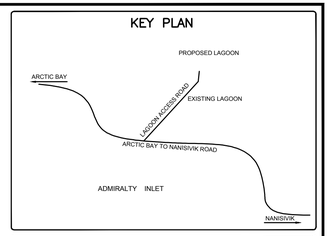

LEGEND

AS-BUILT

DATE: NOVEMBER 30, 2011

BENCH MARK

BM 1 ELEV. = 59.12

CONTOUR ELEVATIONS WERE DREIVED FROM NAD 83 CONTROL MONUMENT 7038914 LOCATED NORTH OF THE ARCTIC BAY AIRPORT UNDER CONSTRUCTION.

No.	DESCRIPTION	DATE	BY	APP'D
4	AS-BUILT	30/11/11	SAB	SLB
3	AS-CONSTRUCTED	17/11/11	MEB	SLB
2	TENDER SET	27/04/09	MMR	SLB
1	ISSUED FOR APPROVAL	24/04/08	MMR	SLB

R E V I S I O N S

DRAWINGS ORIGINALLY SEALED BY S.L.BURDEN, P.eng. OF exp. SERVICES Inc. APRIL 27TH, 2009

Trow Associates Inc.
154 Colonnade Road South
Ottawa, Ont. K2E 7J5
Tel:(613)225-9940
Fax:(613)225-7337

CLIENT
GOVERNMENT OF NUNAVUT

PROJECT
ARCTIC BAY WASTEWATER LAGOON

TITLE
SIGNAGE LOCATION PLAN

design by	SAD	project no.	OTCD000190544
drawn by	MEB	drawing no.	SLP-1
checked by	SLB		
date	15/01/2008		
scale	HORIZ 1:1500		