


GOVERNMENT OF NUNAVUT

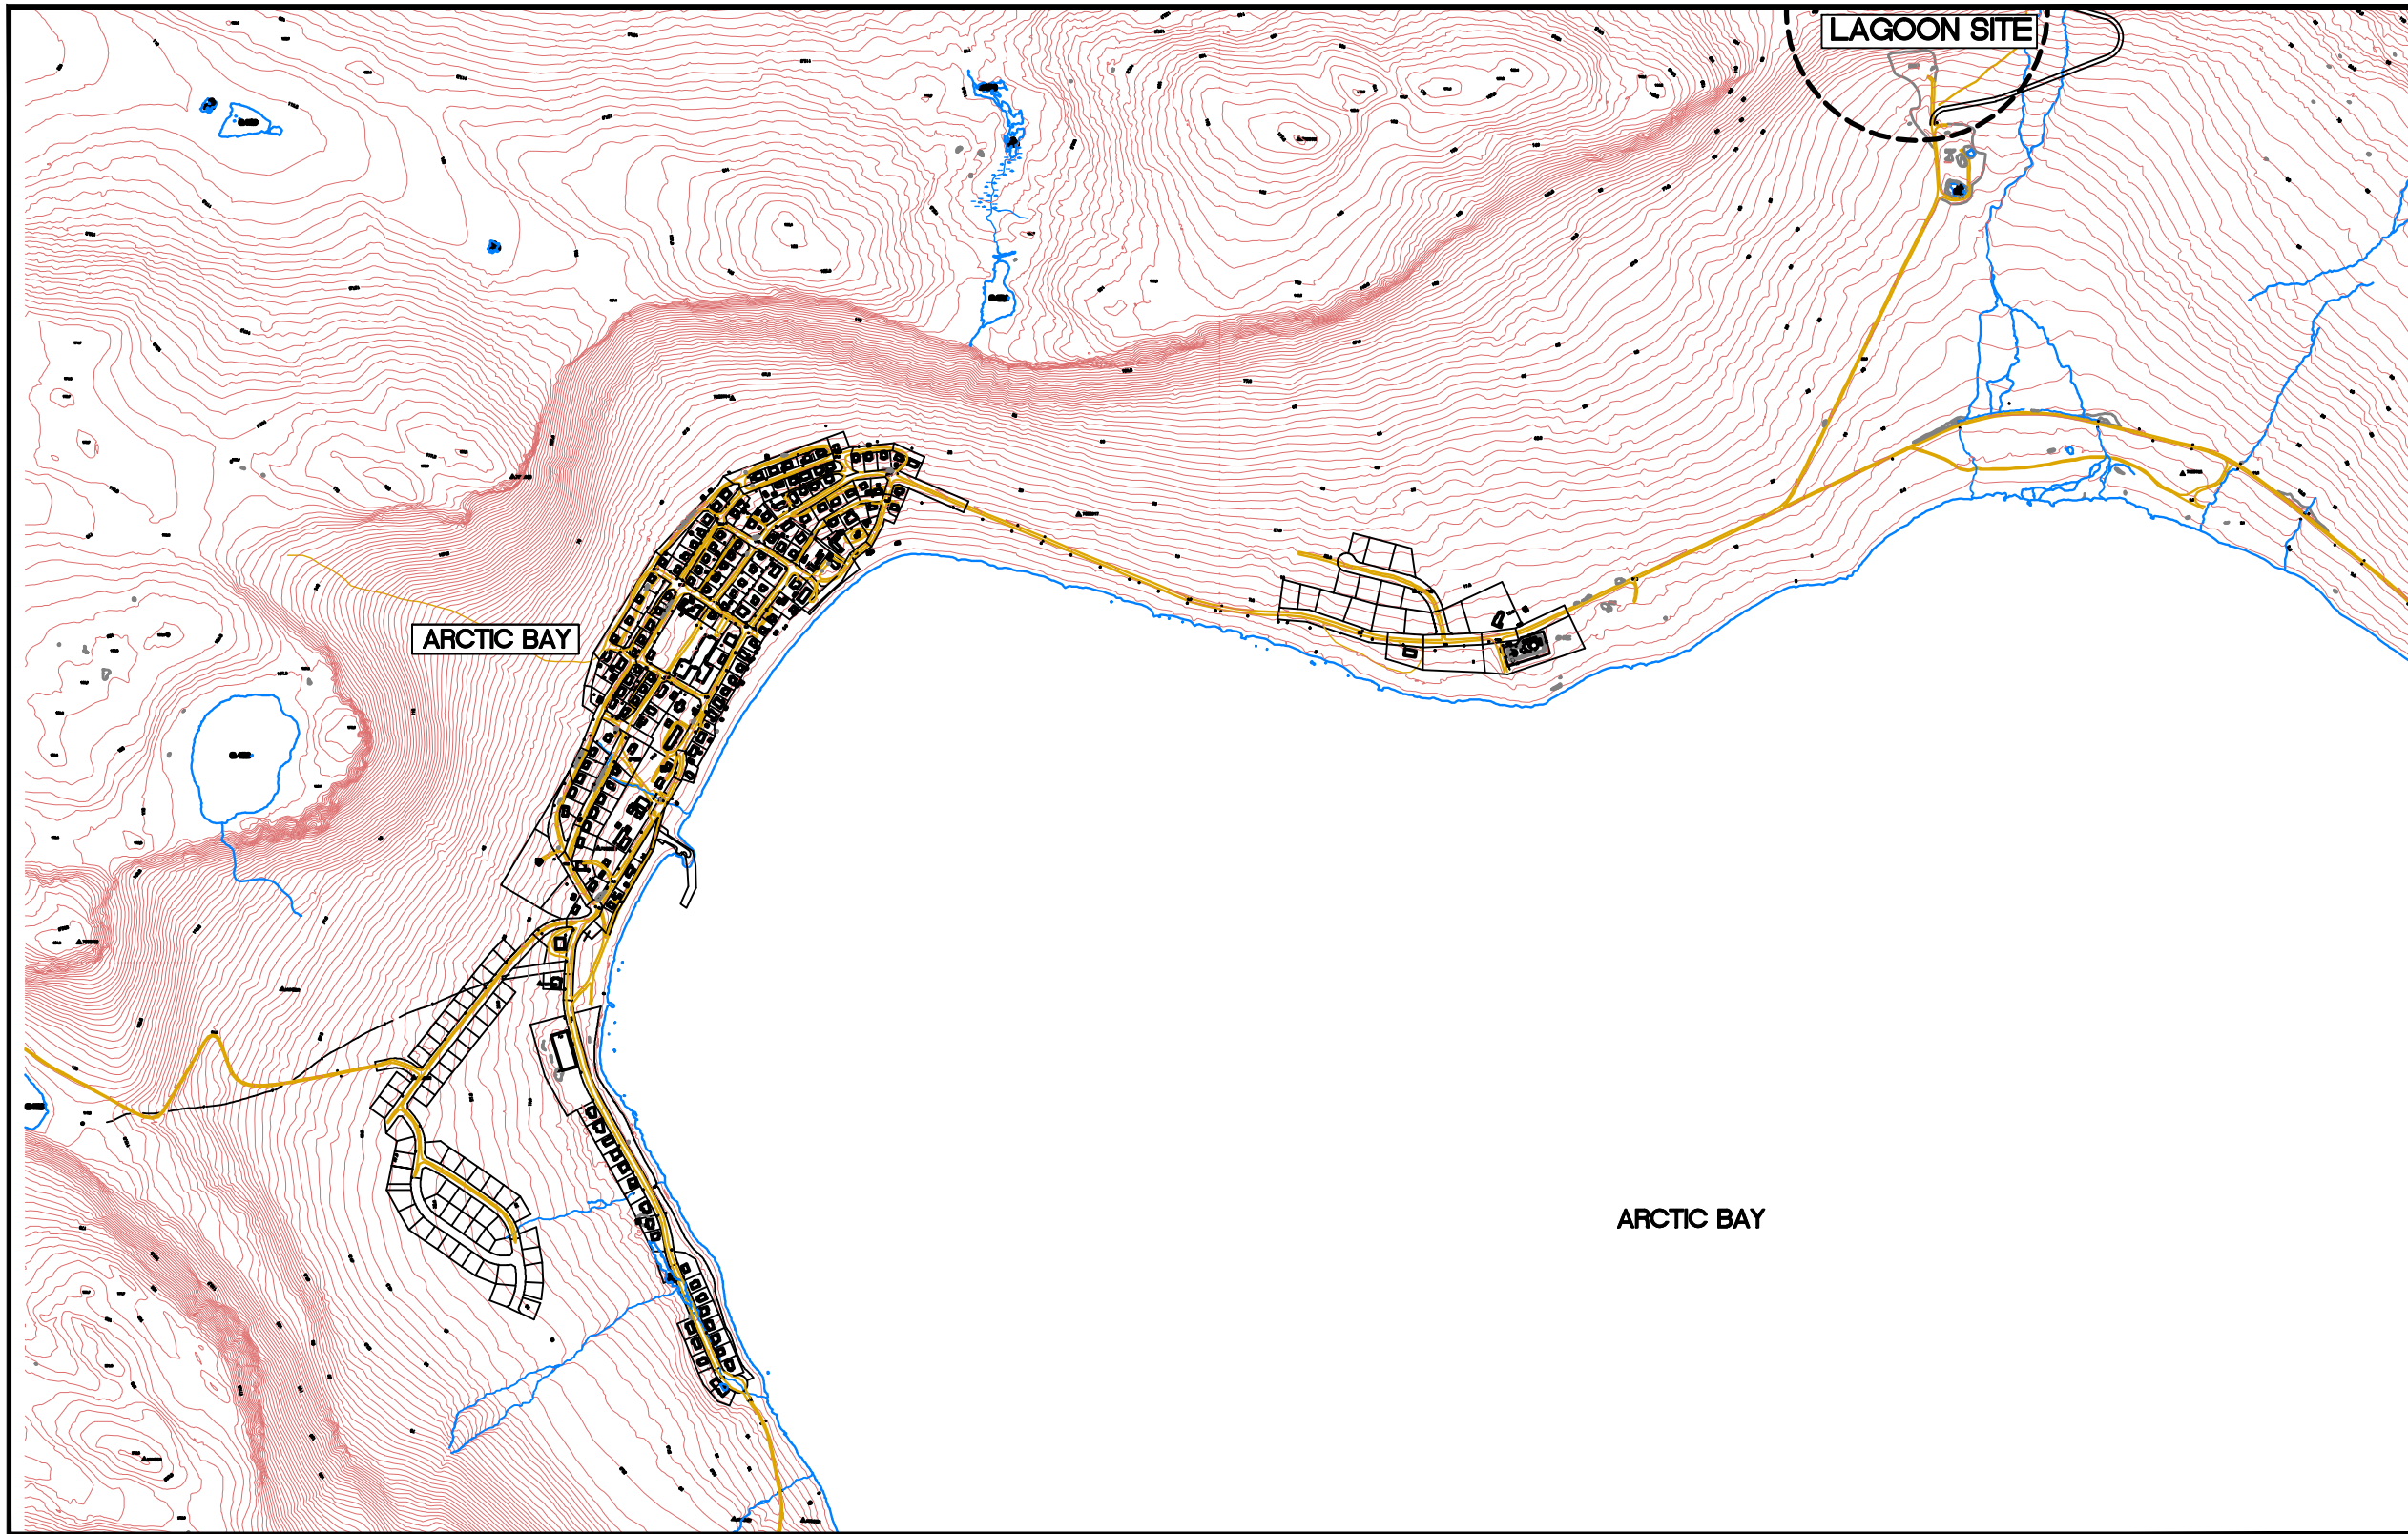

INDEX OF INCLUDED DRAWINGS

DRAWING NO.	REVISION	DESCRIPTION
OTCD00019054A-OSP1	REV 3	OVERALL SITE PLAN
OTCD00019054A-ES1	REV 3	EXISTING SITE
OTCD00019054A-L1	REV 3	PROPOSED LAGOON
OTCD00019054A-TD1	REV 3	TRUCK DISCHARGE PLAN
OTCD00019054A-DE1	REV 3	DETAILS
OTCD00019054A-DE2	REV 3	DETAILS
OTCD00019054A-SLP1	REV 3	SINAGE LOCATION PLAN
OTCD00019054A-CS1	REV 3	CROSS SECTIONS

ARCTIC BAY WASTEWATER LAGOON

 **Trow** Associates Inc.
154 COLONNADE ROAD SOUTH PHONE (613) 225-9940
OTTAWA, ONTARIO K2E 7J5 FAX (613) 225-7337

**RECORD
DRAWING**
DATE: _____