


# GOVERNMENT OF NUNAVUT

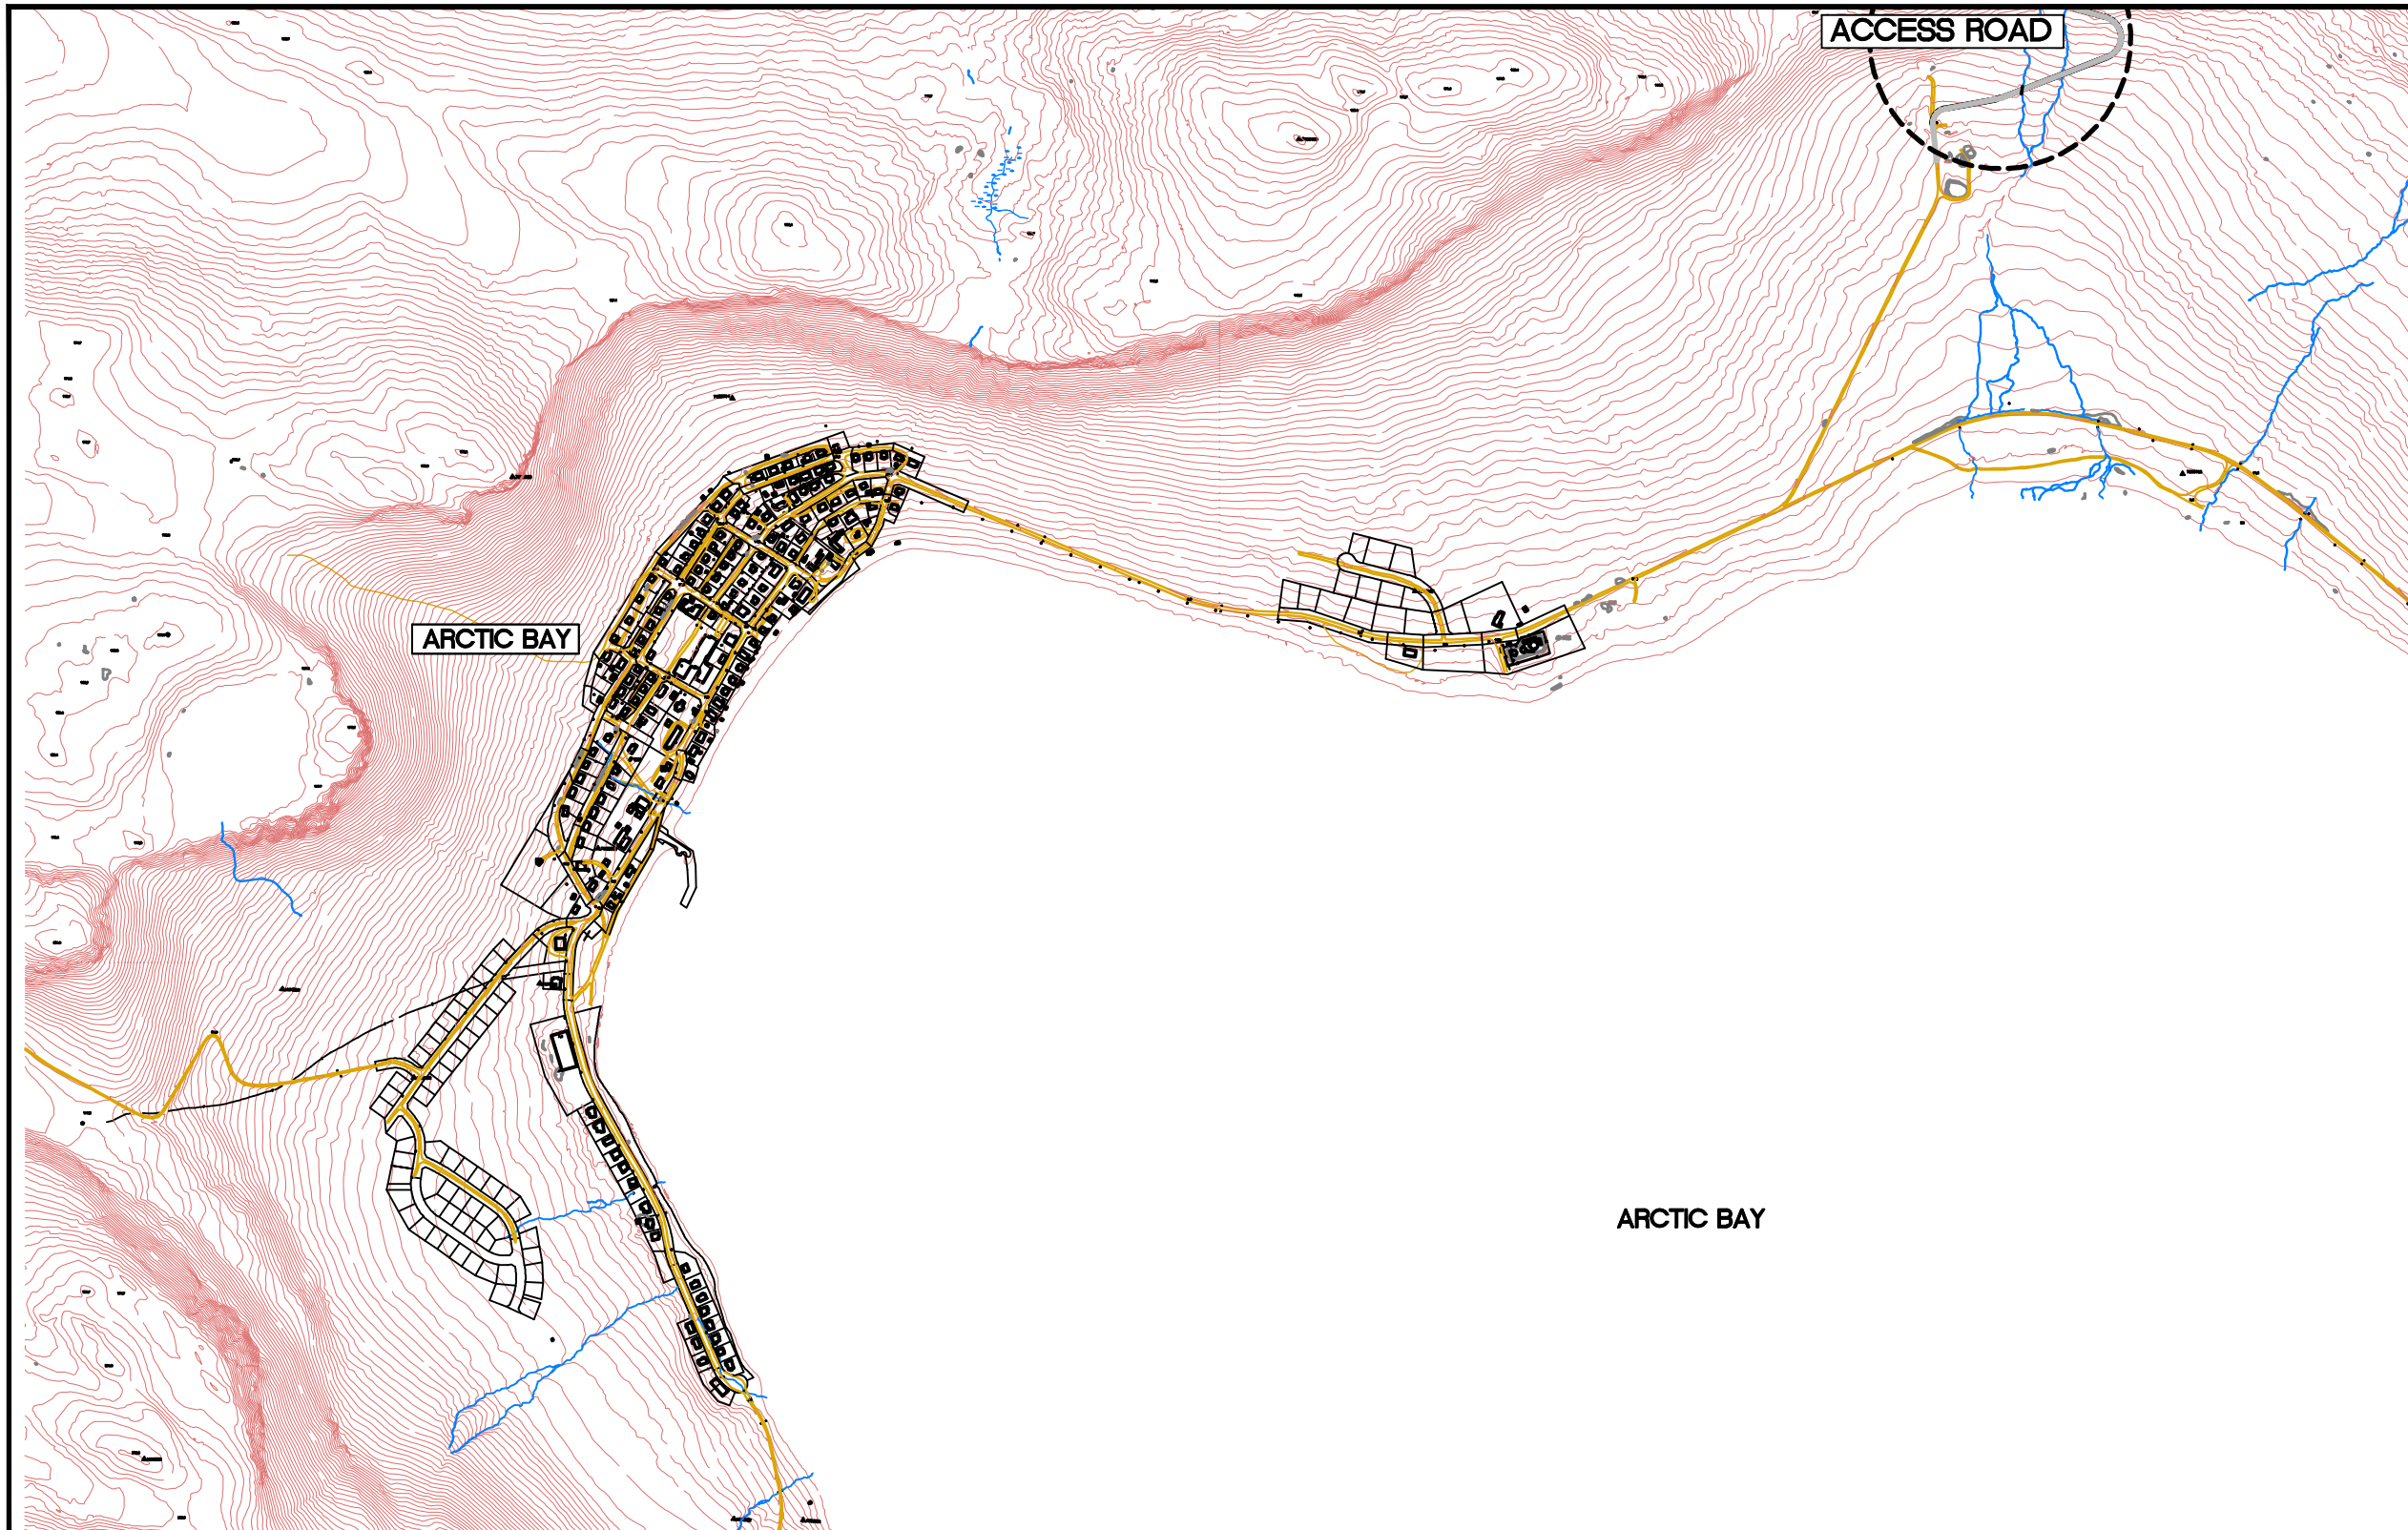

INDEX OF INCLUDED DRAWINGS

DRAWING NO.	REVISION	DESCRIPTION
OTCD00019054A-SP1	REV 4	SITE PLAN
OTCD00019054A-PP1	REV 4	ACCESS ROAD PLAN & PROFILE
OTCD00019054A-PP2	REV 4	ACCESS ROAD PLAN & PROFILE
OTCD00019054A-PP3	REV 4	ACCESS ROAD PLAN & PROFILE
OTCD00019054A-PP4	REV 4	ACCESS ROAD PLAN & PROFILE
OTCD00019054A-PP5	REV 4	ACCESS ROAD PLAN & PROFILE
OTCD00019054A-PP6	REV 4	ACCESS ROAD SECOND BERM PLAN & PROFILE
OTCD00019054A-PP7	REV 4	ACCESS ROAD SECOND BERM PLAN & PROFILE
OTCD00019054A-DE1	REV 5	ROAD DETAILS

## ARCTIC BAY WASTEWATER LAGOON ROAD

Trow Associates Inc.

154 COLONNADE ROAD SOUTH  
OTTAWA, ONTARIO K2E 7J5

PHONE (613) 225-9940  
FAX (613) 225-7337

RECORD  
DRAWING

DATE: \_\_\_\_\_