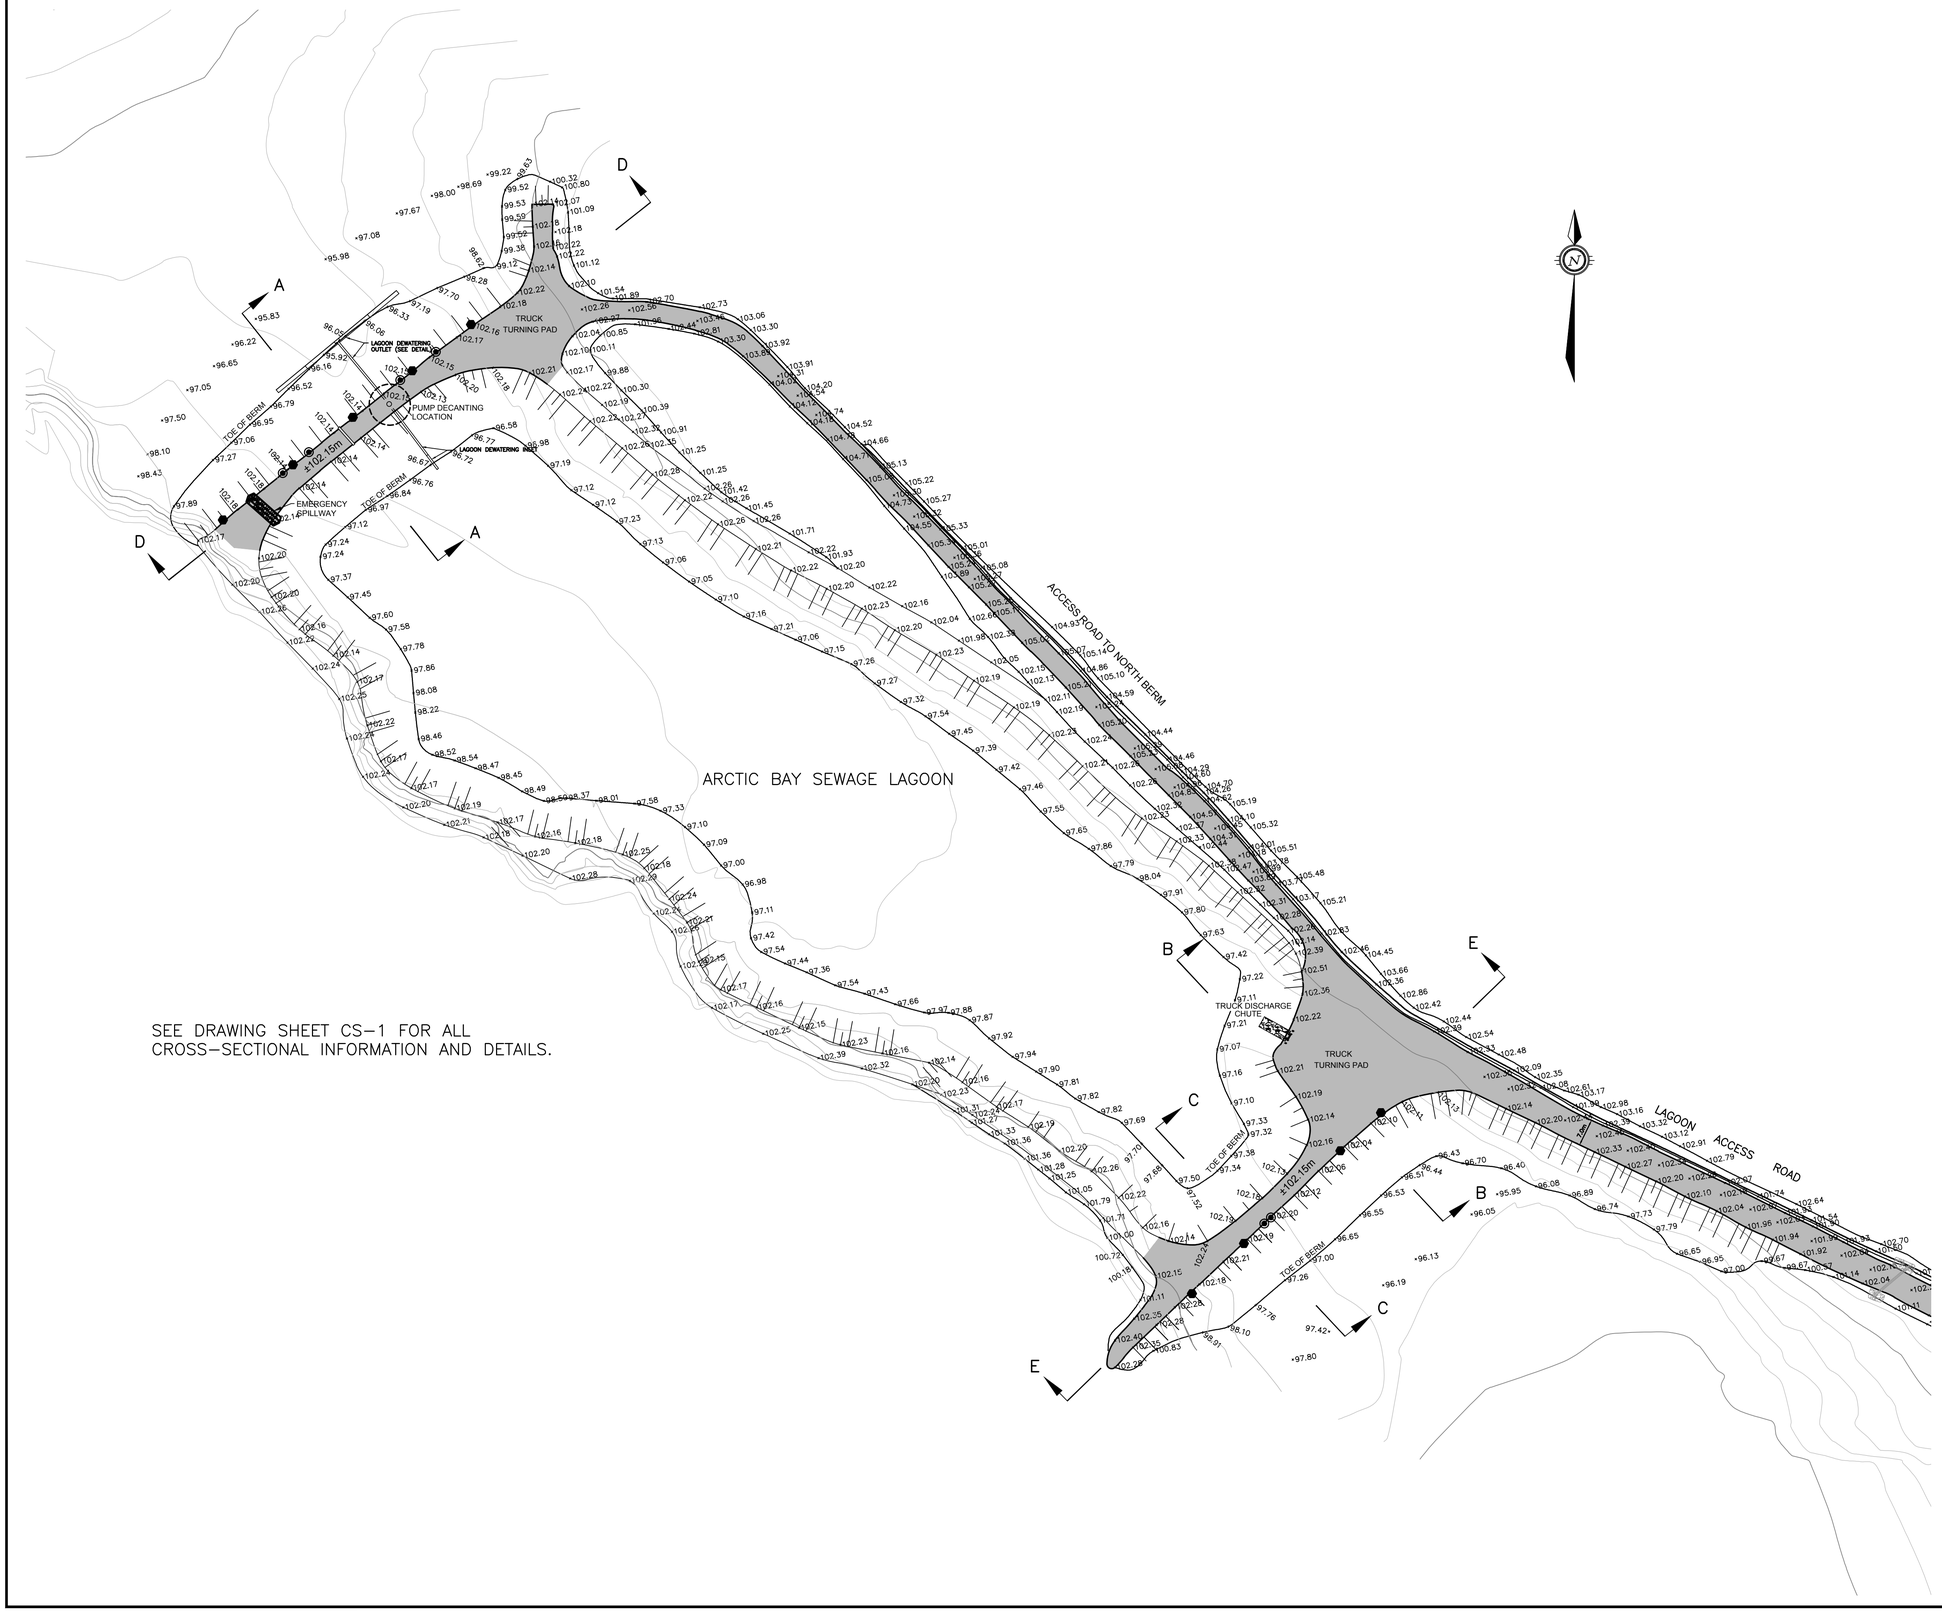

SEE DRAWING SHEET CS-1 FOR ALL CROSS-SECTIONAL INFORMATION AND DETAILS.

KEY PLAN

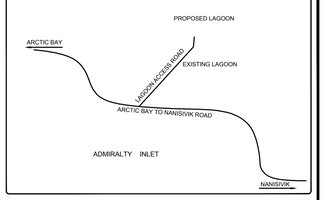

LEGEND

- BERM CORE DETECTION - THERMISTOR CASING c/w THERMISTOR STRING AND DATA LOGGER CONNECTION.
- SAMPLING POINT

PERMIT OF PRACTICE
TROW ASSOCIATES INC.
Signature _____
Date _____
PERMIT NUMBER: P184
The Association of Professional Engineers Geologists and Geophysicists of the NWT/NU

BENCH MARK

BM 1 ELEV. = 59.12

CONTOUR ELEVATIONS WERE DREIVED FROM NAD 83 CONTROL MONUMENT 7038914 LOCATED NORTH OF THE ARCTIC BAY AIRPORT UNDER CONSTRUCTION.

No.	DESCRIPTION	DATE	BY	APP'D
3	AS-CONSTRUCTED	17/11/11	MEB	SLB
2	TENDER SET	27/04/09	MMR	SLB
1	ISSUED FOR APPROVAL	24/04/08	MMR	SLB

R E V I S I O N S

REGISTERED PROFESSIONAL ENGINEER
S.L. BURDEN
LICENSEE
N.W.T.

Trow Associates Inc.
154 Colonnade Road South
Ottawa, Ont. K2E 7J5
Tel:(613)225-9940
Fax:(613)225-7337

CLIENT
GOVERNMENT OF NUNAVUT

PROJECT
ARCTIC BAY WASTEWATER LAGOON

TITLE
PROPOSED LAGOON

design by	SAD	project no.	OTCD000190544
drawn by	MEB	drawing no.	L-1
checked by	SLB		
date	15/01/2008		
scale	HORIZ 1:750		