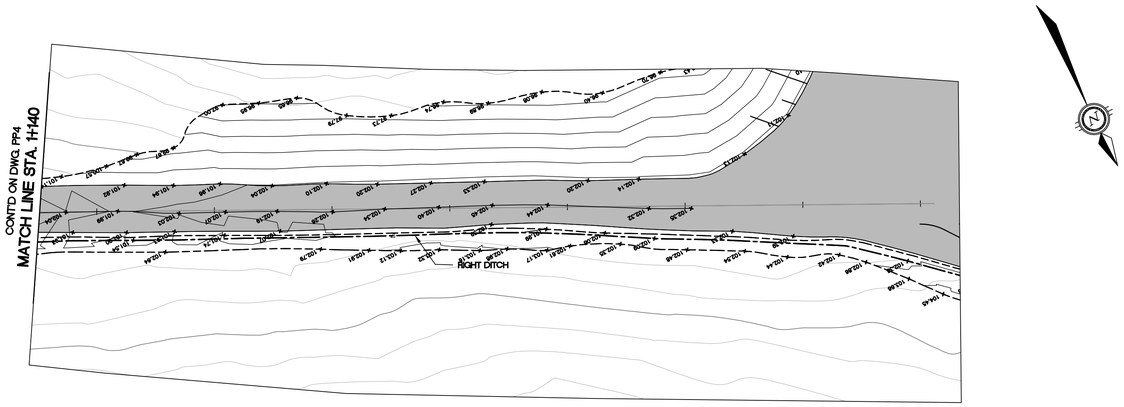

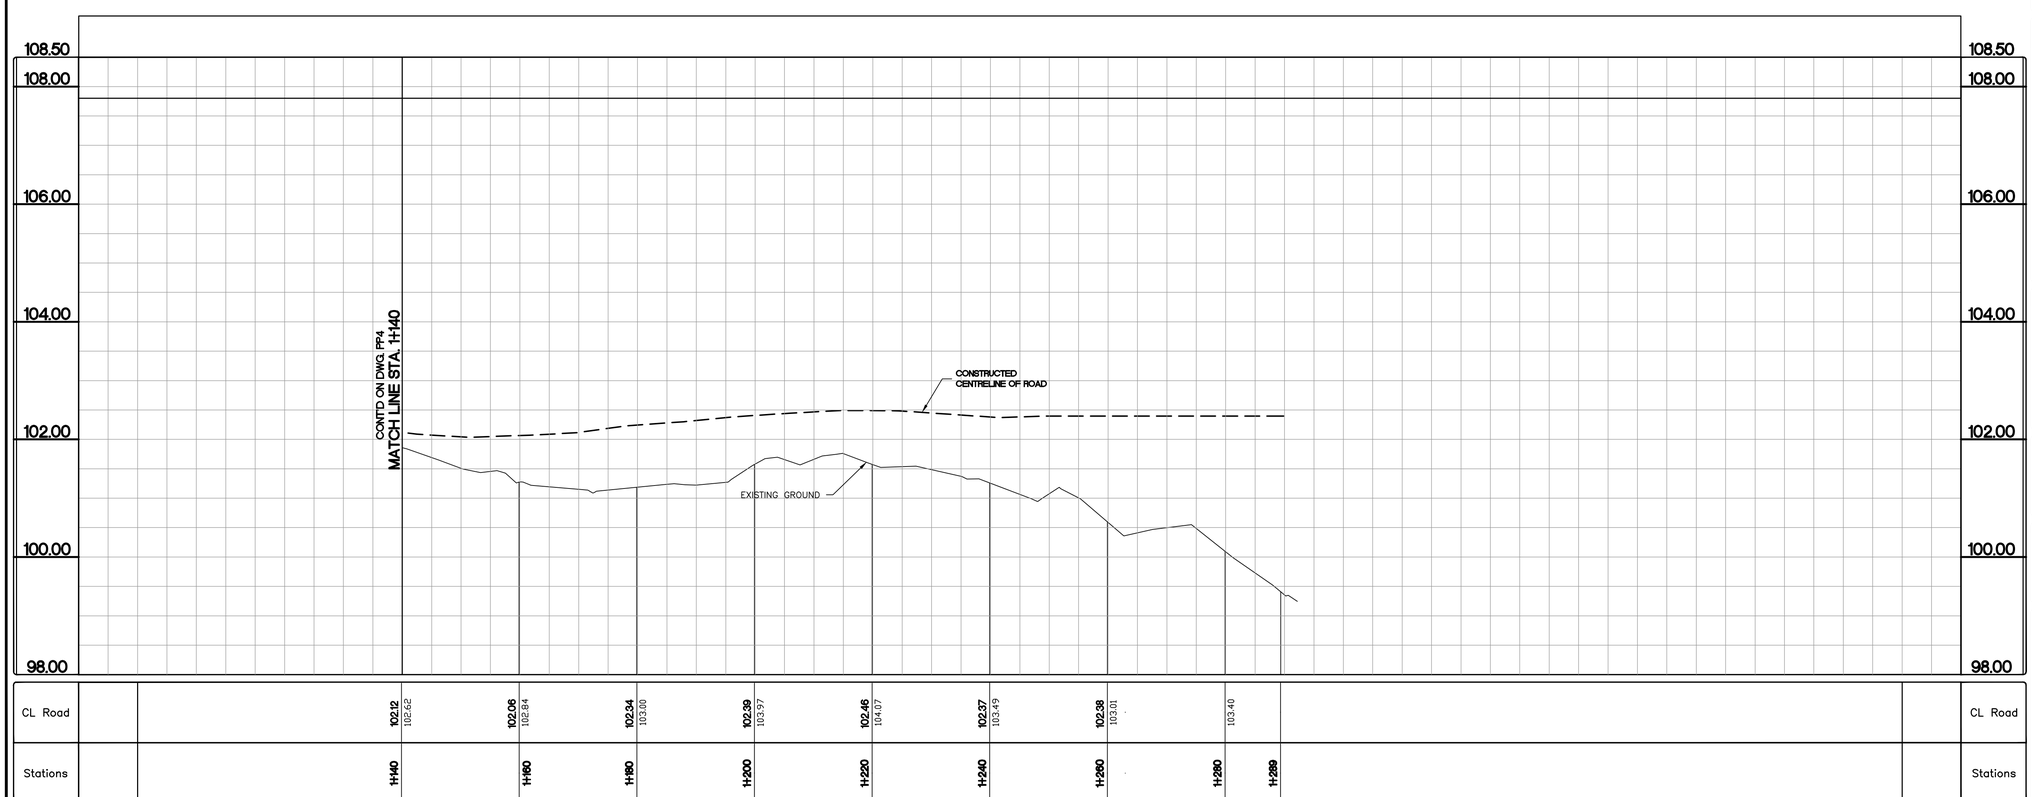

KEY PLAN

LEGEND

PERMIT OF PRACTICE
TROW ASSOCIATES INC.
Signature _____
Date _____
PERMIT NUMBER: P184
The Association of Professional Engineers Geologists and Geophysicists of the NWT/NU

BENCH MARK
BM 1 ELEV. = 000.00
DESCRIPTION HERE

No.	DESCRIPTION	DATE	BY	APP'D
4	AS–CONSTRUCTED	17/11/11	MEB	SLB
3	ISSUED FOR CONSTRUCTION	14/09/09	MMR	SLB
2	TENDER SET	27/04/09	MMR	SLB
1	ISSUED FOR APPROVAL	24/04/08	MMR	SLB

R E V I S I O N S

REGISTERED PROFESSIONAL ENGINEER
S.L. BURDEN
LICENSEE
N.W.T.

Trow Associates Inc.
154 Colonnade Road South
Ottawa, Ont. K2E 7J5
Tel:(613)225–9940
Fax:(613)225–7337

CLIENT
GOVERNMENT OF NUNAVUT

PROJECT
ARCTIC BAY
WASTE WATER
LAGOON ROAD

TITLE
ACCESS ROAD
PLAN & PROFILE
STA. 1+140 TO STA. 1+245

design by	S.A.D.	project no.	OTCD19054A
drawn by	M.M.R.	drawing no.	PP5
checked by	S.L.B.		
date	21/04/08		
scale	HORIZ 1:500 VERT 1:50		