


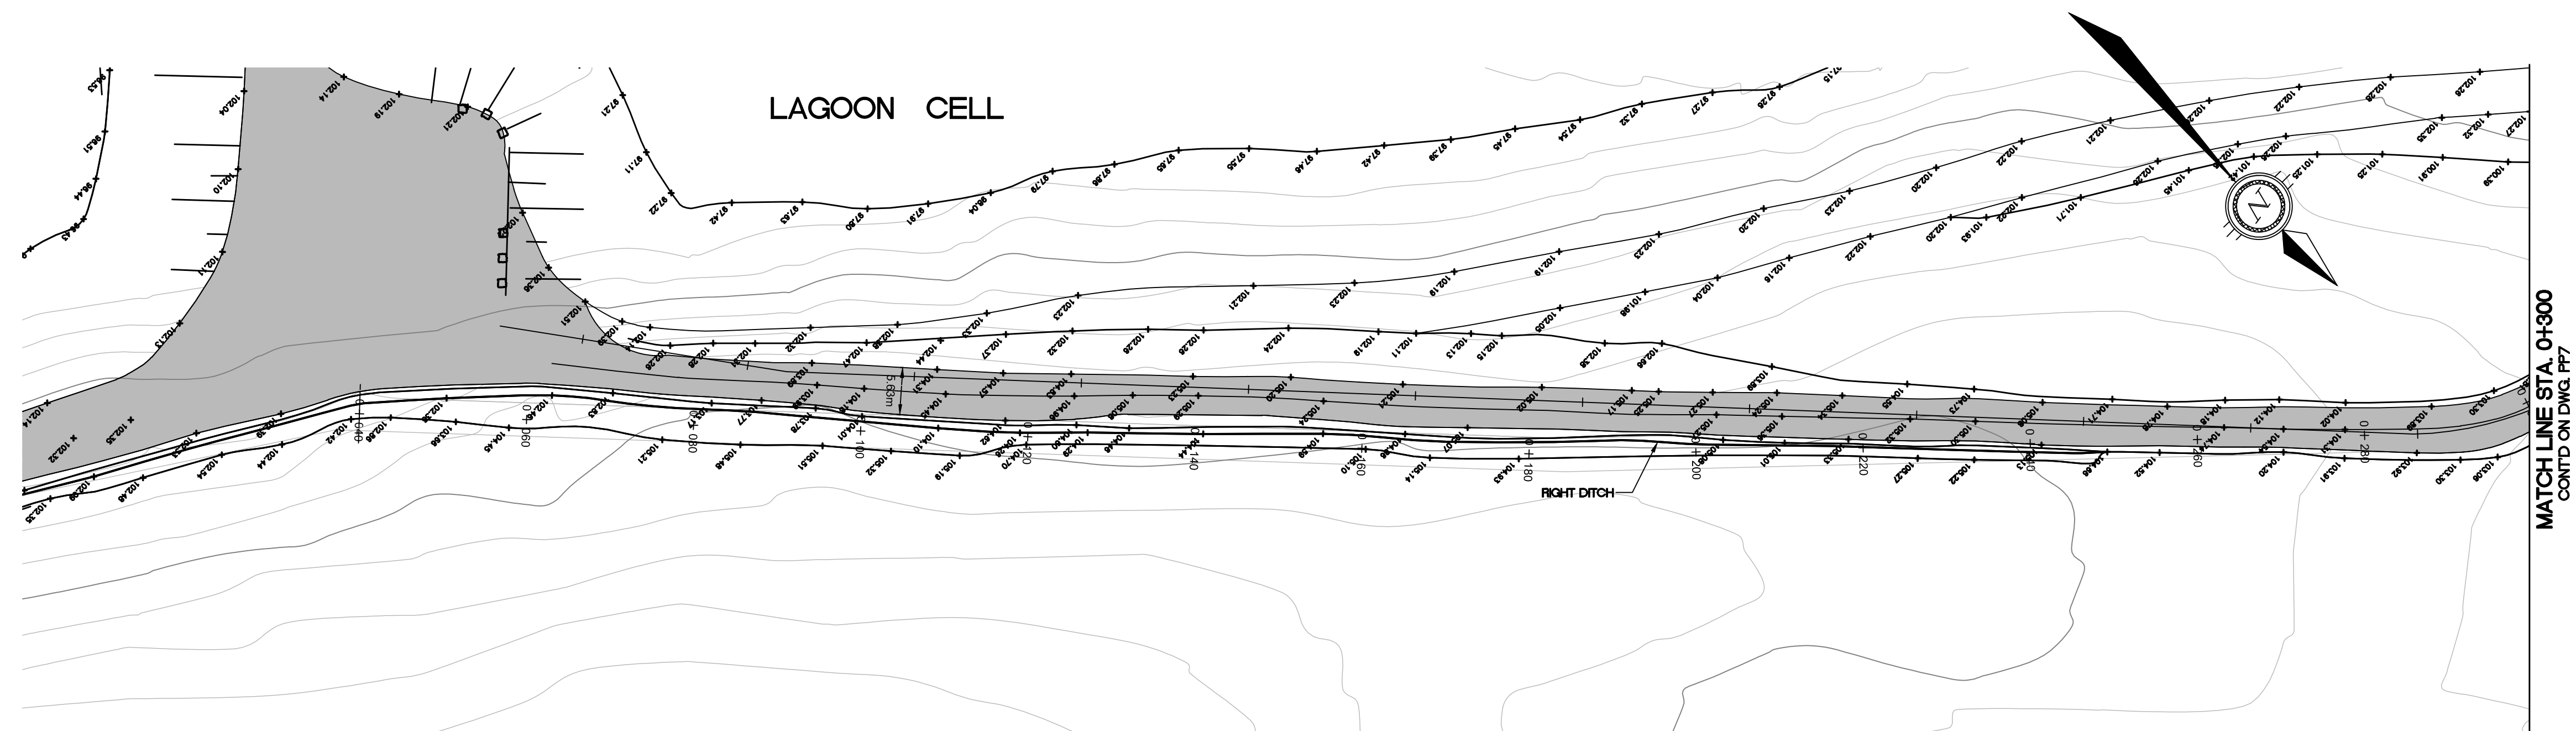

KEY PLAN

LEGEND

PERMIT OF PRACTICE
TROW ASSOCIATES INC.

Signature _____

Date _____


PERMIT NUMBER: P184
The Association of Professional Engineers
Geologists and Geophysicists of the NWT/NU

BENCH MARK

BM	DESCRIPTION
BM 1	DESCRIPTION HERE

ELEV. = 000.00

4	AS--CONSTRUCTED	17/11/11	MEB	SLB
3	ISSUED FOR CONSTRUCTION	14/09/09	MMR	SLB
2	TENDER SET	27/04/09	MMR	SLB
1	ISSUED FOR APPROVAL	24/04/08	MMR	SLB
No.	DESCRIPTION	DATE	BY	APP'D
R E V I S I O N S				

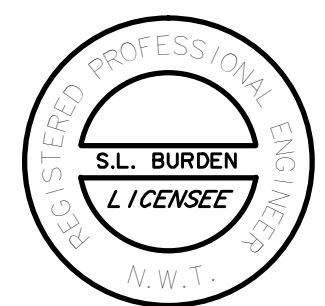

154 Colonnade Road South
Ottawa, Ont. K2E 7J5

Tel:(613)225-9940
Fax:(613)225-7337

CLIENT

GOVERNMENT OF NUNAVUT

PROJECT

ARCTIC BAY
WASTE WATER LAGOON

TITLE	
-------	--

ACCESS ROAD
SECOND BERM
PLAN & PROFILE

design by

S.A.D.

project no. OTCD19054A

drawn by

M.M.R.

drawing no.

checked by

S.L.B.

date	
------	--

07/12/07

scale

HORIZ 1:500 VERT 1:50

PP6