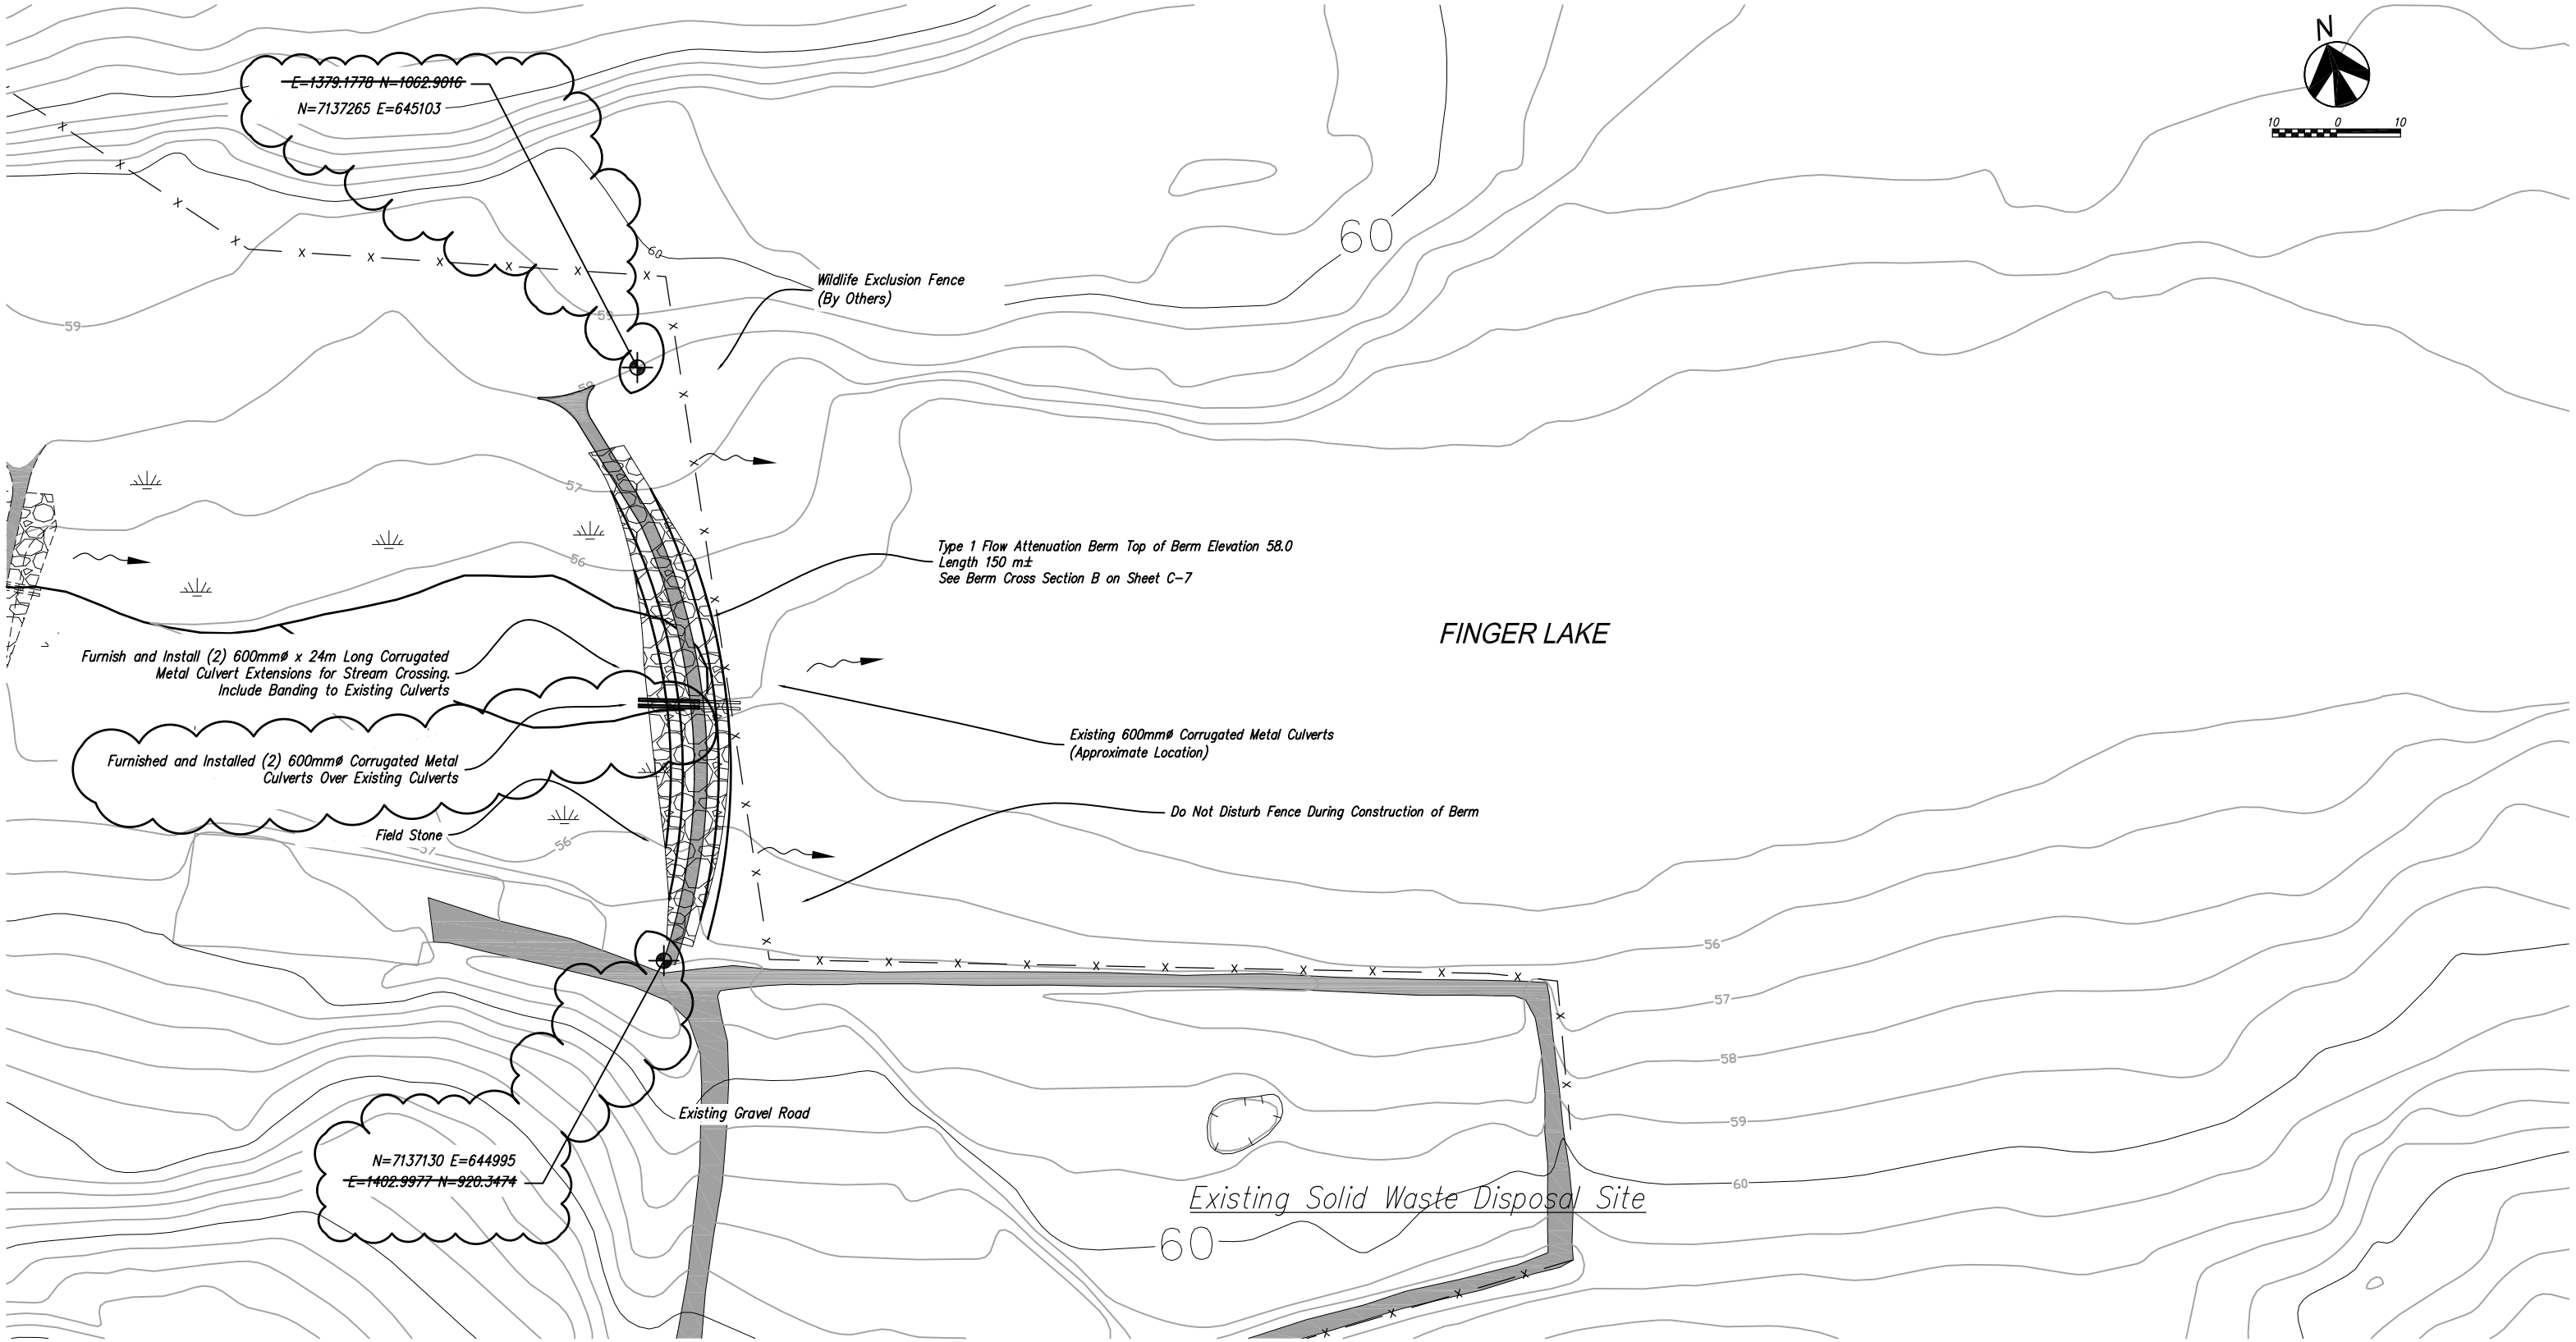

Plot Date: 3 November 2011 By Wagner, Richard

Stantec
4444 Centerville Road, Suite 140
White Bear Lake, MN 55127
651-255-5050
651-255-5060 (fax)

NUNAMI
JACQUES WHITFORD LIMITED

Rev	Date	Description
8	11/03/11	Record Drawing

GOVERNMENT OF NUNAVUT
DEPARTMENT OF COMMUNITY AND GOVERNMENT SERVICES
BAKER LAKE SEWAGE SYSTEM IMPROVEMENTS
QAMANI'TUAQ, NUNAVUT

Type 1 Finger Lake Flow Attenuation Berm Plan

C-6

1015263-C002-C008.dwg

C:\Users\rwagner\Desktop\Stantec Projects\Baker Lake\Record\1015263-C002-C008.dwg

Copyright © 2011 Stantec