


SEWAGE EFFLUENT TREATMENT PLANT

EFFLUENT DISCHARGE
POINT

Nunavut Water
Board
FEB 20 2001
Public Registry

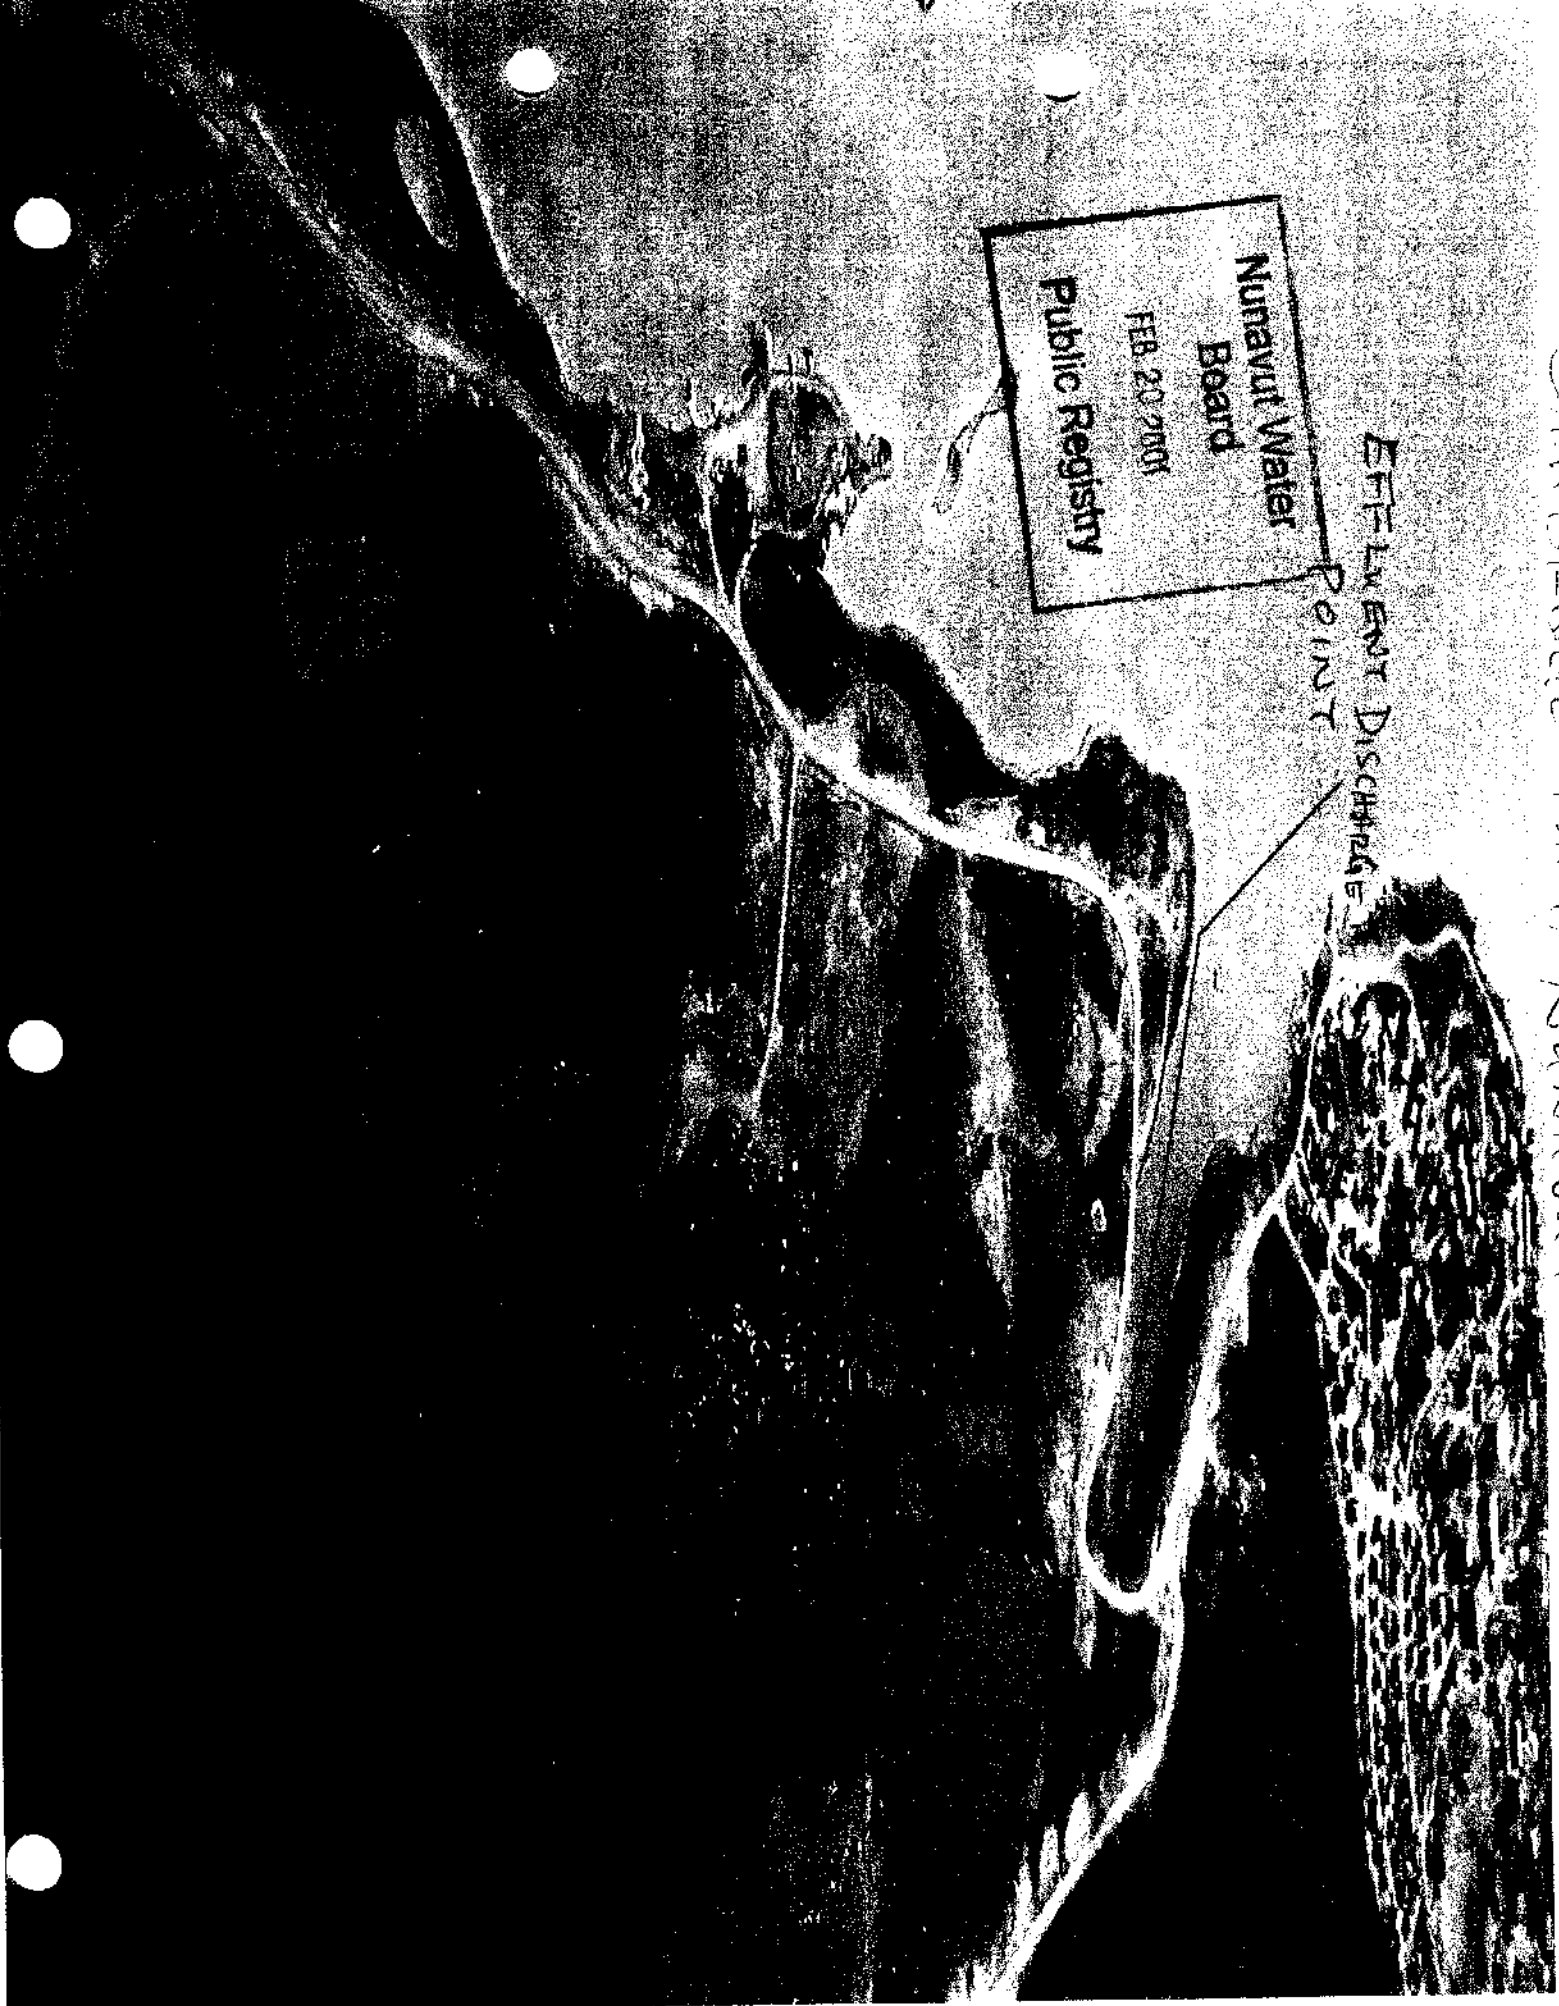

BULK MATERIAL DISPOSAL SITE; SEWAGE EFFLUENT DISCHARGE POINT

Public Registry

SEWAGE EFFLUENT
DISCHARGE POINT



CAMBRIDGE BAY
BULK MATERIAL DISPOSAL SITE

"EXHIBIT" : MISC.