





#4 is located on the side of Annabek Trench Area. At the from

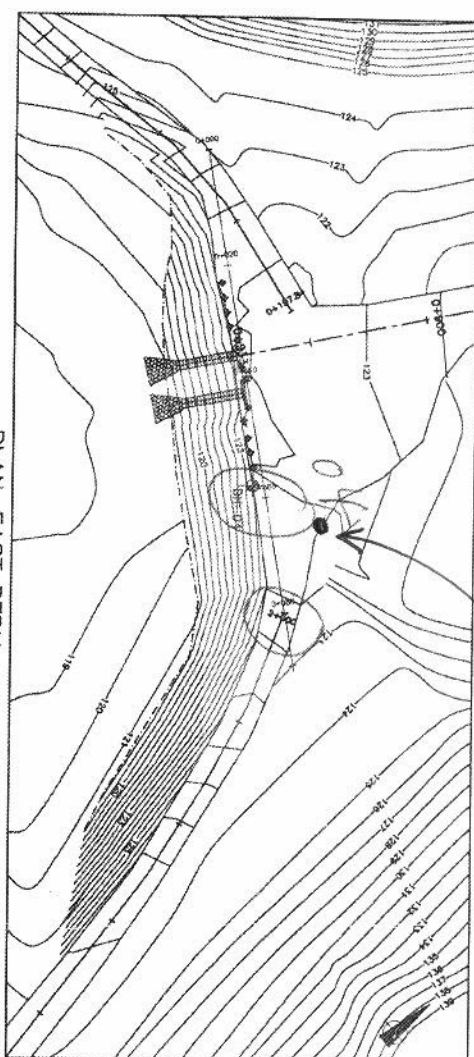

PLAN-EAST BERM
SCALE 1:750

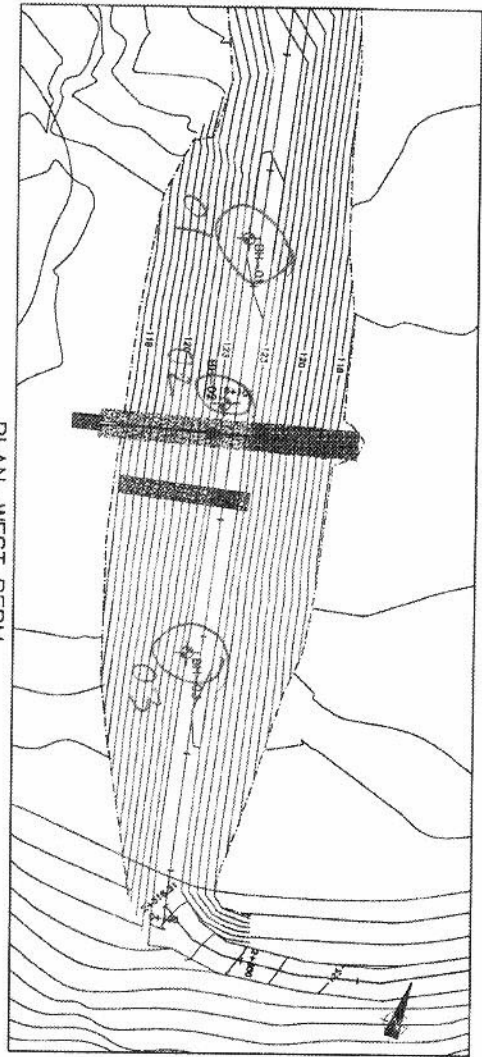

PLAN-WEST BERM
SCALE 1:750

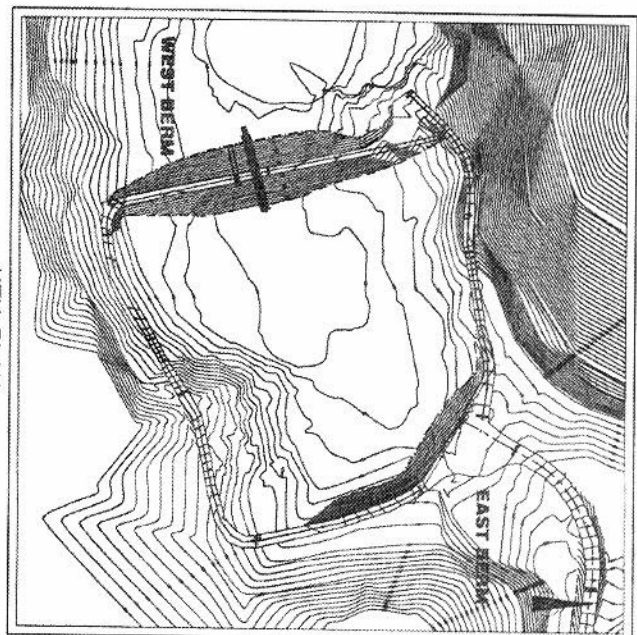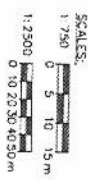

KEY PLAN
SCALE 1:2500

BOREHOLE LOCATIONS			
	NORTHING	EASTING	
BH-01	7122537.98	424004.63	
BH-02	7122510.20	424010.67	
BH-03	7122468.42	424019.74	
BH-04	7122510.13	424168.93	

Please Review

amec Earth & Environmental DILLON CONSULTING LIMITED		PROJECT: CAPE DONNET SEWAGE LAGOON TITLE: BOREHOLE LOCATION PLAN	
DATE: MAY 2008	CDR No: 7000748	DESIGN: 00748.00.dwg	SCALE: 1:750 FIGURE 1 REV: A