

Northwest Territories Canada

Department of Public works

PROJECT NO: 90-4306-6

PROJECT : WATER STORAGE TANK

CAPE DORSET, N.W.T.

OLIVER, MANGIONE, MCCALLA & ASSOCIATES LIMITED

(ENGINEER)

BY: CONSTRUCTIONS GAÉTAN GRENIER INC

October 1992



Water Storage Tank

Cape Dorset, NWT

table of contents

Section

1	General specifications
2	List of suppliers
3	Suppliers manual
4	Shop drawing
5	<u>Mechanical systems</u>
5,1	----general specification
5,2	----list of suppliers
5,3	----supplier Manuals
5,4	----Material test reports
5,5	----Non-destructive testing reports
5,6	----Drawings

Where is the
description
+
Location of
the tank



memo

To: Consultant
Subject: Comments on OSM manual
Date: Nov 17th 1992

① Where are the climatic
conditions described

Operation of tank in
conjunction with the
Truckbill / Supply line
+ ~~the~~ Tee Lake

② Location -
reasoning behind storage tank

3 Day storage, One operating cesspool
+ Fire fighting DMP

③ Explain water Truck Delivery
System within community
and need for the new tank
General History of water system
etc.

Water storage Tank, Cape Dorset, N.W.T.

Owner:

Public Works , NWT

Mr. Dave MacPherson

phone: 819-979-5150

P.O. Bag 1000

Iqaluit, N.W.T

XOA OHO

Engineer:

Oliver, Mangione, McCalla & As.

Mr. Steven Burden

phone: 613-225-9940

154, Colonnade Road South

Nepean, Ontario

K2E 7J5

General contractor:

Constructions Gaétan Grenier Inc

Mr. Gaétan Grenier

phone: 819-548-5424

106 Colette Street

Mr. Réjean Jacques

phone: 819-897-8434

St-Ludger, Québec

GOM IWO

Sub-contractors:

Universal Industries Limited

5014, 65 St

P.O. Box 1590

Lloydminster Sask., Alberta

S9V 1K5

Mr. Gary Ward

phone: 403-875-6161

Isolations Grenier Inc

106, Colette Street

St-Ludger, Québec

GOM IWO

Mr. Luc Doyon

phone: 819-548-5397

Suppliers

Peinture L.C.I. Canada

2580 rue Dalton

Ste-Foy, Québec

G1P 3S4

Mr. André Trudel

Phone: 418-657-6772

VicWest steel Inc


707 Industrial Boul. East

Victoriaville, Quebec

G6P 6T2

Mr. Jean-Marc Anger

phone: 800-463-4694

 

Not ready
yet

Water storage tank

Cape Dorset, NWT

Drawing index:

Tank exterior treatment / 04225

Tank primer

Tank rigid insulation

Protective coating

Cladding

Metal tank / 04250

Design requirements

Internal protective coating / 04275

Internal coating

Mechanical / 04400

see section 5 Mechanical

Glidden**PROTECTIVE MAINTENANCE COATINGS DATA**

**Alkyd Rust-Inhibitive Primer
For Industrial Use Only**

GLID-GUARD® Tank & Structural Metal Primer Nos. 5205/5206/5207

For Interior-Exterior Metal

PRODUCT DESCRIPTION

A high solids, rust-inhibitive, interior-exterior alkyd primer for ferrous and non-ferrous metal, including galvanized. May be topcoated with epoxy, vinyl, urethane and chlorinated rubber coatings as well as conventional oil, alkyd and latex products. Excellent for use as a barrier coat when applied over sound old oil or alkyd finishes which are to be topcoated with heavy-duty coatings. This product has exceptional resistance to exterior weathering, making it especially suitable for use as a shop primer. Typical uses include structural steel, tank exteriors, piping, machinery and fences.

PRODUCT FEATURES

- May be used on both ferrous and galvanized metal
- Rust inhibitive — excellent corrosion resistance
- High volume solids
- Fast dry
- Will withstand two years exterior exposure without a topcoat
- May be topcoated with heavy-duty coatings — an excellent tie coat
- Lead and chromate free
- VOC less than 420 grams per litre (3.5 lbs. per gallon)
- Flash point above 40°C (100°F.)

PRODUCT LIMITATIONS

Do not use for immersion or direct food contact service. Do not use in Type A-Aggressively Corrosive environments. May be used in Type C-Corrosive environments only if topcoated with a product suitable for the environment (such as an epoxy, vinyl, etc.) Will withstand 93°C. (200°F.) continuous dry heat. The color may change as this limit is approached, but the film will remain in tact.

PRODUCTS AVAILABLE

GLID-GUARD Tank & Structural Primer, Red No. 5205
GLID-GUARD Tank & Structural Primer, Gray No. 5206
GLID-GUARD Tank & Structural Primer, White No. 5207

SURFACE PREPARATION

All surfaces must be clean, dry and free of all contaminants.

Ferrous Metal Surfaces

Remove dirt and dust. Remove oil and grease with solvents such as mineral spirits or xylene in compliance with SSPC-SP1-82 Solvent Cleaning. Further clean the surface by one of the following methods depending upon the service environment. See Glidden Surface Preparation Data Sheet No. 5 "Ferrous Metal/Iron & Steel" for more information.

Type C-Corrosive

This exposure is characterized by moderately aggressive chemical fumes, mists or dusts that combine with moisture and high humidity to corrode zinc at rates less than one mil per year. Type A-Aggressively Corrosive exposures may, in some instances, become Type C exposures outside a radius of about 50 yards from the source of contamination for a limited further distance. For Type C-Corrosive environments, Near-White Sandblasting SSPC-SP10 is recommended.

TECHNICAL DATA

*Product Numbers - 5205

Generic Type - Alkyd

Colours - Red

Gloss - 15 maximum @ 60°

Type of Cure - Oxidation

Percent Solids by Volume - 52% ± 1%

Theoretical Coverage per 1.0 dry mil (1.9 mils wet)

834 sq. ft./gallon. (20.3m²/L)

**Recommended Film Thickness & Coverage
(Calculated, Unreduced)

Minimum — 2.0 mils dry (4.0 mils wet) —

417 sq. ft./gallon (10 m²/L)

Recommended — 2.0-2.5 mils dry (4.0-5.0 mils wet)

334-417 sq. ft./gallon (8-10m²/L)

Maximum 3.0 mils dry (6.0 mils wet) 278 sq. ft./gallon
(7²/L)

When computing working coverage, allow for application losses, surface irregularities, any solvent addition, etc.

Percent Solids by Weight — 71 ± 1%

Percent Vehicle by Weight — 24% ± 1%

Percent Pigment by Weight — 47% ± 1%

Percent Solvent by Weight — 29% ± 1%

Viscosity — 70-80 KU

Weight per Gallon — 11.8 lbs. (5.4 kg)

Flash Point (Closed Cup) — 42°C. (108°F.)

VOC — 3.45 lbs/gallon (414 gm/litre)

unreduce; 3.79 lbs/gal (454 gm/litre), reduced 10% by volume with xylene; 3.73 lbs/gal (447 gm/litre), reduced 10% by volume with mineral spirits

Drying Time - (20°C, 50% .H.)

Touch - 20 minutes Handle - 30 minutes

Recoat - 2 hours Full Cure - 8 hours

Reduction Solvent — Xylene (spray) or mineral spirits brush/roll)

Clean-up Solvent — Xylene or methylethyl ketone

Tinting — DO NOT TINT

* Compositional data for other products in this series may differ slightly.

** As measured over the peaks of any blast profile or surface irregularities.

Type M-Moderate

This exposure is generally outdoors and is characterized by normal weathering and/or light or moderate concentrations of chemical fumes that combine with humidity and condensed moisture to corrode carbon steel at rates less than three mils per year. Zinc in this exposure is virtually free of corrosion. Light to moderate chemical fume concentrations in indoor areas without excessive humidity may produce similar conditions. For Type M-Moderate environments, Commercial Blast Cleaning SSPC-SP6 is recommended. Where exposure is normal weathering only, Brush-Off Blast Cleaning SSPC-SP7 or power Tool Cleaning SSPC-SP3 will provide excellent service.

SURFACE PREPARATION

Type P-Protected (Architectural)

Surfaces are generally indoors in the normal humidity range and are not subjected to chemical contaminants which will attack paint or steel. For Type P-Protected environments, Brush-Off Blast Cleaning SSPC-SP7, Power Tool Cleaning SSPC-SP3, or Hand Tool Cleaning SSPC-SP2 will provide the sound substrate needed for proper adhesion.

Galvanized Metal and Aluminum Surfaces

Remove oil, grease, dirt, dust and chemical contaminants using the prescribed cleaning methods. See Glidden Surface Preparation Data Sheet No. 4 "Aluminum" or No. 6 "Galvanized Metal" for more information.

NOTE: Many new galvanized surfaces are chemically treated (passivated) by the supplier to prevent wet storage staining (also known as "white rust"). This is especially true for galvanized metal in sheet or coil form. Such treatment may interfere with the bonding of paint films, and their removal by brush abrasive blast prior to the application of this product will result in maximum adhesion. Other types of chemical treatments may not lessen paint adhesion. Consult the metal supplier for specific surface preparation recommendations.

Previously Painted Surfaces

Hard or glossy finishes should be dulled by sanding, sandblasting or other abrasive method to ensure adhesion. Clean thoroughly. Remove any loose old coating. Spot prime any exposed non-metal substrate with a primer recommended for that substrate. If more than 25% of the previous coating has failed, if the previous coating can be easily scraped off the surface, or if a test application of this product lifts or wrinkles the previous coating, it should be completely removed.

APPLICATION

Apply by spray (airless or conventional) or brush or roller. Do not apply when surface temperature is below 10°C. (50°F.)

SPRAY APPLICATION

Airless Spray

Fluid tip: 617

Pressure 1900-2100 psi

COVERAGE

Recommended coverage (calculated, unreduced) is 335-417 sq. ft./gallon at 2.0-2.5 mils dry (4.0-5.0 mils wet). Maximum film thickness is 3.0 mils dry (6.0 mils wet) 278 sq. ft./gallon, minimum 2.0 mils dry (4.0 mils wet) 417 sq. ft./gallon. When computing working coverage, allow for any solvent addition, application losses, surface irregularities, etc. **NOTE:** When this product is to be topcoated with heavy-duty coatings such as epoxies, vinyls, etc., it is very important that the maximum recommended film thickness of 3.0 mils dry not be exceeded.

DRYING

Dries to touch in 20 minutes, to handle in 30 minutes, to recoat in 2 hours, to full cure in 8 hours at 20°C. (70°F.), 50% R.H. Allow longer drying times under cooler or more humid conditions.

FORCE CURING

Drying time can be shortened by exposing the painted surface to elevated temperatures. Suggested schedule is 2-3 minutes flash-off followed by 15 - 30 minutes at 93°C. (200°F.). Additional cure time may be required if immediate topcoating with heavy-duty coatings is desired. The flash-off time may be omitted for convection ovens. Allow the part to cool to room temperature before topcoating, handling or stacking. **NOTE:** Thoroughly test any proposed force cure schedule on the actual application site to verify that degree of cure, film hardness, and recoatability are acceptable.

CLEAN-UP

Clean all equipment immediately after use with xylene or methyl ethyl ketone.

TOPCOATS

May be topcoated with epoxy, urethane, vinyl and chlorinated rubber coatings as well as conventional oil, alkyd and latex products. **NOTE:** The use of any alkyd primer under heavy-duty coatings such as epoxy, urethane, vinyl and chlorinated rubber may compromise the chemical or physical resistance properties of the overall coating system.

Alkyd Rust-Inhibitive Gloss Enamel

GLID-GUARD® Alkyd Industrial Enamel No. 4550 Series

For Interior-Exterior Metal, Masonry, Plaster & Gypsum Wallboard

PRODUCT DESCRIPTION

An exceptionally durable interior/exterior urethane fortified alkyd gloss enamel for structural steel and general maintenance use. Provides maximum protection to structural steel tanks, signs, piping, fences and other metal surfaces.

PRODUCT FEATURES

- Available in safety colours
- May be brushed, rolled or sprayed
- Good exterior gloss retention
- Available in any colour
- Qualified CGSB Standards: 1-GP-59, 1-GP-60
- Meets or exceeds CGSB 1-GP-61 requirements

PRODUCT LIMITATIONS

- Not recommended for immersion
- Not recommended for direct food contact service

PRIMERS, FILLERS, SEALERS**For Ferrous Metals —**

GLID-GUARD Alkyd Metal Primer No. 595 Red Oxide
GLID-GUARD Universal Fast Dry Metal Primer No. 5205 Red Oxide

For Galvanized and Aluminum Metals —

GLID-GUARD All-Purpose Metal Primer No. 5229 White
GLID-GUARD Universal Fast Dry Metal Primer No. 5205 Red Oxide

**For Masonry, Poured Concrete, Brick, Concrete Block —
Smooth Surfaces**

Interior/Exterior — Ultra Primer-Sealer No. 36600 White

Rough Surfaces (Block or Brick with voids)

Interior — ULTRA Interior Block Filler No. 36250 White
Exterior — ULTRA Acrylic Latex Block Filler No. 5317-0 White

For Wood —

Interior — ULTRA Undercoater No. 9431-0 White or GLID-GUARD Alkyd Industrial Enamel
Exterior — ULTRA Basecoat No. 9421-0

For Plaster, Gypsum Wallboard —

ULTRA Primer-Sealer No. 36600

Consult your Glidden representative for job specific recommendations.

SURFACE PREPARATION

Surfaces must be dry, clean and free of all contaminants. Remove dust and dirt with stiff bristle or wire brushes and compressed air. Remove oil and grease with solvents such as turpentine, mineral spirits or xylene in compliance with SSPC-SP1-82 — Solvent Cleaning.

TECHNICAL DATA

Product Number — 4550*

Generic Type — Alkyd

Colour — White

Sheen — High Gloss

Type of Cure — Oxidation

Percent Solids by Volume — 44%

Theoretical Coverage @ 25 microns (one mill)
— 17.5 M²/L (847 sq. ft./gal.)

Recommended Dry Film Thickness Per Coat
— 50 microns (2 mils)

Total Solids by Weight — 61%

Vehicle Solids by Weight — 33%

Solvent by Weight — 10%

Density — 1.12

Flash Point — 40°C

Dry Time — 25°C, 50% R.H.

Touch — 4 hours

Recoat — 16 hours

**Reducer — Mineral Spirits for brush & roll,
VM&P Naphtha for spray**

Clean-up — Mineral Spirits

*Compositional Data for other colours in this product series will differ slightly.

This data is not intended to cover specific applications. Consult your Glidden representative for assistance in making recommendations for specific situations.

SURFACE PREPARATION (continued)

Metal Surfaces

All rust and mill scale must be removed by sandblasting, power tool cleaning, sanding or scraping. Wash with mineral spirits or xylene to remove oil or grease. See Glidden Coatings Data Sheets "Surface Preparation" Nos. 2, 5 and 6 for more details.

Masonry Surfaces

Level any surface projections and mortar spatters by grinding, stoning or scraping. Rake mortar joints clean. Remove oil, grease, dirt, dust and chemicals with prescribed methods. See Glidden Maintenance Coatings Data Sheet "Surface Preparation" No. 3 for more details. Masonry block should be filled free of voids, pinholes.

Wood Surfaces

Sand smooth and apply primer as specified. Holes, splits and scratches should be puttied or spackled smooth after applying the primer. See Glidden Maintenance Coatings Data Sheet "Surface Preparation" No. 9 for more details.

Plaster Surfaces

Plaster nibs should be scraped and sanded smooth. Cracks should be spackled, smoothed and sealed. No paint or sealer should be applied on plaster when the moisture content exceeds 8% as determined by a reliable electronic moisture meter. See Glidden Maintenance Coatings Data Sheet "Surface Preparation" No. 8 for more details.

Gypsum Wallboard Surfaces

Tape joints and spackled nailheads should be sanded smooth and dusted. See Glidden Maintenance Coatings Data Sheet "Surface Preparation" No. 8 for more details.

Previously Painted Surfaces

The performance of any coating system applied over previously painted surfaces is directly influenced by the type, age and condition of the old coating. If the previous coating can be easily scraped off the surface or if it lifts upon application of first new coat, it should be completely removed. Hard or glossy paints should be dulled by sanding, sandblasting, or other abrasive methods to assure maximum adhesion.

Consult your Glidden representative for more specific surface preparation recommendations.

MATERIAL PREPARATION

Mix thoroughly before using. Thin, if necessary, with mineral spirits for brush and rol application and VM&P Naphtha for spray (approx. 6:1). Do not add other thinners or driers or mix with other paints.

APPLICATION

Apply by brush, roller or spray. Do not apply when air or substrate temperature is below 10°C.

EQUIPMENT RECOMMENDATIONS

Airless Spray

Fluid Tip: 513
Pressure: 2100 - 2400 psi.

Conventional Spray

- Material pressure pot with separate gauges for air & fluid
- Air supply required - 80 P.S.I. at 20 CFM at the gun
- Gun - Devilbiss MBC, JGA, or equivalent
- 765 Cap "E" needle and tip
- Air hose $\frac{5}{16}$ " or $\frac{3}{8}$ " I.D.
- Material hose - $\frac{1}{2}$ " I.D. solvent resistant

DRYING

Dries to touch in one hour, overnight for recoating at 25°C, 50% R.H. Allow longer drying time under cooler, more moist conditions.

For further information concerning this and other Glidden products as well as recommendations for specific coating purposes, contact your Glidden representative.

FOR BEST RESULTS AND SAFEST USAGE, USER IS SPECIFICALLY DIRECTED TO CONSULT THE CURRENT MATERIAL SAFETY DATA SHEET FOR THIS PRODUCT. EMERGENCY PHONE: (416) 669-1020.

WARNING! FLAMMABLE. HARMFUL IF INHALED. CAUSES IRRITATION.

Keep away from heat, sparks and flame. Vapors may cause flash fire. Do not breathe vapors or spray mist. Do not get in the eyes, on skin or on clothing. Wear appropriate, properly fitted respirator (NIOSH/MSHA approved) during and after application unless air monitoring demonstrates vapor/mist levels are below applicable limits. Follow respirator manufacturer's directions for respirator use.

FIRST AID: IN CASE OF SKIN CONTACT, wash thoroughly with soap and water. FOR EYES flush immediately with plenty of water for 15 minutes. Call a physician. IF INHALED, remove to fresh air. If not breathing, give artificial respiration, preferably mouth-to-mouth. If breathing is difficult, give oxygen. Call a physician.

Keep closures tight and upright to prevent leakage. Keep containers closed. In case of spillage, absorb and then dispose of in accordance with local applicable regulations.

USE ONLY WITH ADEQUATE VENTILATION. KEEP OUT OF REACH OF CHILDREN.

NOTICE: Reports have associated repeated and prolonged occupational over-exposure to solvents with permanent brain and nervous system damage. Intentional misuse by deliberately concentrating and inhaling the contents may be harmful or fatal.

LIMITATION OF LIABILITY

To the best of our knowledge the technical data contained herein are true and accurate at the day of issuance but are subject to change without prior notice. We guarantee our product to conform to Glidden's specifications. **WE MAKE NO OTHER WARRANTY OR GUARANTEE OF ANY KIND, EXPRESS OR IMPLIED, INCLUDING MERCHANTABILITY AND FITNESS FOR PARTICULAR PURPOSE.** Liability, if any, is limited to replacement of the product or refund of the purchase price. **LABOR OR COST OF LABOR AND OTHER CONSEQUENTIAL DAMAGES ARE HEREBY EXCLUDED.**



ICI PAINTS (CANADA) INC.
CONCORD, ONTARIO L4K 2A5

**Polyurethanes**

HEATLOK R279

HEATLOK R279

TECHNICAL DATA SHEET

- 2.0 lb/ft³ General Purpose Spray Foam
- Has successfully passed CAN-4-S102-M83 and ULC-S127-M82 <500 Flame Spread
- Cold Weather Application - 10C to 10C
- Use with ICI Iso 276 below 0C

FOR MORE INFORMATION:

1-800-668-0929 (English)

1-800-668-2237 (French)

ICI Polyurethanes warrants that its products, when delivered, shall conform to the specifications applicable thereto in its product data sheets. This warranty is in lieu of all other warranties, express or implied. No warranty is made as to merchantability or fitness for any particular purpose.

Reaction times, etc., and characteristics of finished product, will vary with mix conditions, equipment type, stream temperatures, and other factors. As final application is under user's exclusive control, user must test for suitability of a formulation in any particular application. Adjustments may be required in certain cases.

Caution: Finished product is combustible. Do not expose to flame or other ignition sources. Can present fire hazard if not adequately protected against ignition.

ICI SPRAY SYSTEM

ICI System 279 is a polyurethane chemical foam system consisting of two components
 ICI Resin 279 and ICI Isocyanate 100 / 276

TYPICAL PROPERTIES AS SHIPPED

	Iso 100 (A-Component)	Resin (B-Component)
.color	brown	amber
.viscosity @ 23oC (cPs)	250	275
.specific gravity (oC)	1.24	1.10
.flash point (oC)	>200	>200
.isocyanate equivalent weight	133	N/A
.NCO content %	31.5	N/A
.acidity, % as HC	0.03	N/A

TYPICAL PHYSICAL PROPERTIES


Property	Gusmer Hill	ASTM
.Reaction Profile(sec.)		
Cream Time	1	N/A
Tack Free Time	2	
.Density core		
(lb/ft3)	2.0	
(kg/m3)	32.7	D1622
The following properties were measured on core samples with the above recommended in-place densities.		
.Thermal Properties	R-Value	K-Value (Btu.In/ft2hroF)
Initial	8.70	0.115
Aged (28 days @ 100oC)	6.92	0.145
.Dimensional Stability	% Volume Change @ 28 Days	
29oC	-0.43	D1621
100oC	+7.20	
70oC > 97% R.H.	10.10	
Compressive Strength (10% compression)		
(lb/in2)	27	D1621
Tensile Strength		
(lb/in2)	44	D1623
Open Cell Content		
%	8.0	D2856
Water Absorption (by volume)		
%	2.9	D2842
Water Vapour Permeance		
(ng/Pa.s.m2)	N/A	E 96
<u>Storage Recommendations</u>	Resin	Isocyanate
.Shelf Life(months)	6	12
.Temperature Range (oC)	10-24	16-38

This data is based on laboratory tests conducted by ICI. Results in the field will be influenced by the precise conditions of each application.

MAR 92

Steel cladding

CL 6025R

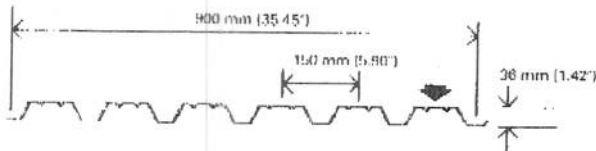

PHYSICAL PROPERTIES

This table has been compiled in accordance with Canadian Standards Association Specification S 136 1974. Properties for one metre width.

M
E
T
R
I
C

BASE STEEL NOMINAL THICKNESS (mm)	NOMINAL THICKNESS Z275 COATING (mm)	MASS FOR Z275 COATING (kg/m ²)	MIDSPAN SECTION MODULUS (mm ² x 10 ³)	SUPPORT SECTION MODULUS (mm ² x 10 ³)	MIDSPAN MOMENT OF INERTIA (mm ⁴ x 10 ³)	ALLOWABLE SUPPORT REACTIONS	
						END (kN)	INTERIOR (kN)
0.46	0.50	5.334	4.51	4.74	89.5	—	—
0.61	0.65	6.898	6.73	7.19	132.3	—	—
0.76	0.80	8.490	8.61	9.20	181.6	—	—
0.91	0.95	10.082	10.54	10.97	236.1	—	—
1.22	1.26	—	—	—	—	—	—

LOADING TABLE Uniformly distributed load in kPa (kN/m²)

SUPPORT SPACING (mm)		1-SPAN					2-SPAN					3-SPAN				
		BASE STEEL NOMINAL THICKNESS (mm)					BASE STEEL NOMINAL THICKNESS (mm)					BASE STEEL NOMINAL THICKNESS (mm)				
		0.46	0.61	0.76	0.91	1.22	0.46	0.61	0.76	0.91	1.22	0.46	0.61	0.76	0.91	1.22
1200	B	3.6	5.4	6.9	8.4		3.8	5.7	7.3	8.8		4.7	7.2	9.2	11.0	
	D	f	f	f	f		f	f	f	f		f	f	f	f	
1400	B	2.6	3.9	5.1	6.2		2.8	4.2	5.4	6.4		3.5	5.3	6.7	8.0	
	D	f	f	f	f		f	f	f	f		f	f	f	f	
1600	B	2.0	3.0	3.9	4.7		2.1	3.2	4.1	4.9		2.7	4.0	5.2	6.2	
	D	1.9	2.8	3.8	f		f	f	f	f		f	f	f	f	
1800	B	1.6	2.4	3.1	3.7		1.7	2.6	3.3	3.9		2.1	3.2	4.1	4.9	
	D	1.3	2.0	2.7	3.5		f	f	f	f		f	f	f	f	
2000	B	1.3	1.9	2.5	3.0		1.4	2.1	2.6	3.2		1.7	2.6	3.3	3.9	
	D	1.0	1.4	2.0	2.6		f	f	f	f		f	f	f	f	
2200	B	1.1	1.6	2.0	2.5		1.1	1.7	2.2	2.6		1.4	2.1	2.7	3.3	
	D	0.7	1.1	1.5	1.9		f	f	f	f		f	2.0	f	f	
2400	B		1.3	1.7	2.1			1.4	1.8	2.2		1.2	1.8	2.3	2.7	
	D		0.8	1.1	1.5			f	f	f		1.1	1.6	2.2	f	
2600	B		1.1	1.5	1.8			1.2	1.6	1.9		1.0	1.5	2.0	2.3	
	D		0.7	0.9	1.2			f	f	f		0.8	1.2	1.7	2.2	
2800	B			1.3	1.5			1.1	1.3	1.6			1.3	1.7	2.0	
	D			0.7	0.9			f	f	f			1.0	1.4	1.8	
3000	B			1.1	1.3				1.2	1.4			1.1	1.5	1.8	
	D			0.6	0.8				f	f			0.8	1.1	1.4	
3200	B				1.2				1.0	1.2			1.0	1.3	1.5	
	D				0.6				f	f			0.7	0.9	1.2	
3400	B				1.0					1.1				1.1	1.4	
	D				0.5					f				0.8	1.0	

Top Side (Prepainted)

Grade A Steel having a minimum yielding stress of 230 MPa (33 000 psi) and a working stress of 144 MPa (20 825 psi) has been assumed for the above properties and loads.


Figures in row "B" denote total loading for allowable working stress.

"f" Values have been reduced for Web Crippling.

Figures in row "D" denote total loading for allowable deflection of 1/180th span. "f" indicates the load for stress to govern.

For allowable deflection limits of 1/600th span, use the lesser of

VicWest Steel
Branches coast-to-coast

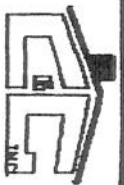

ees Constructions

TITLE:


Water Tank

REF: Metal Roof



BY:

S.D.

DATE: 08/08/12

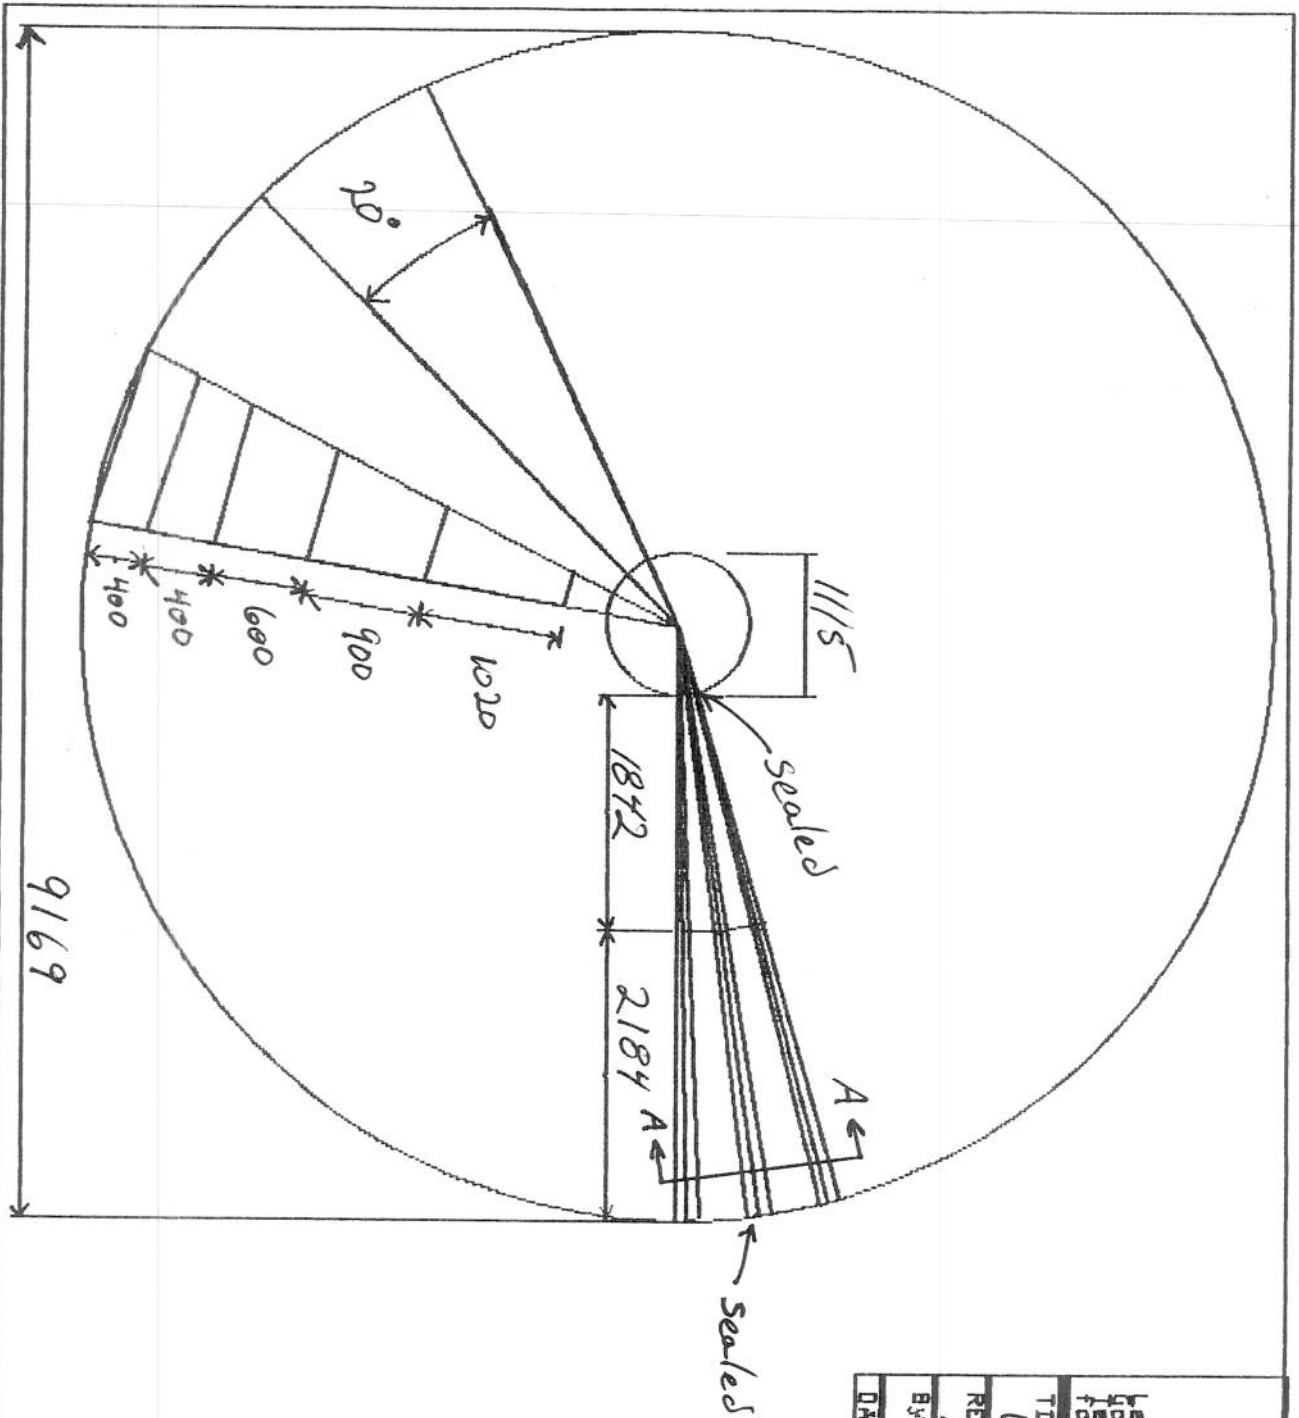

METAL ROOFING FIXATION

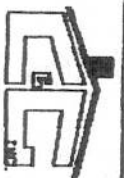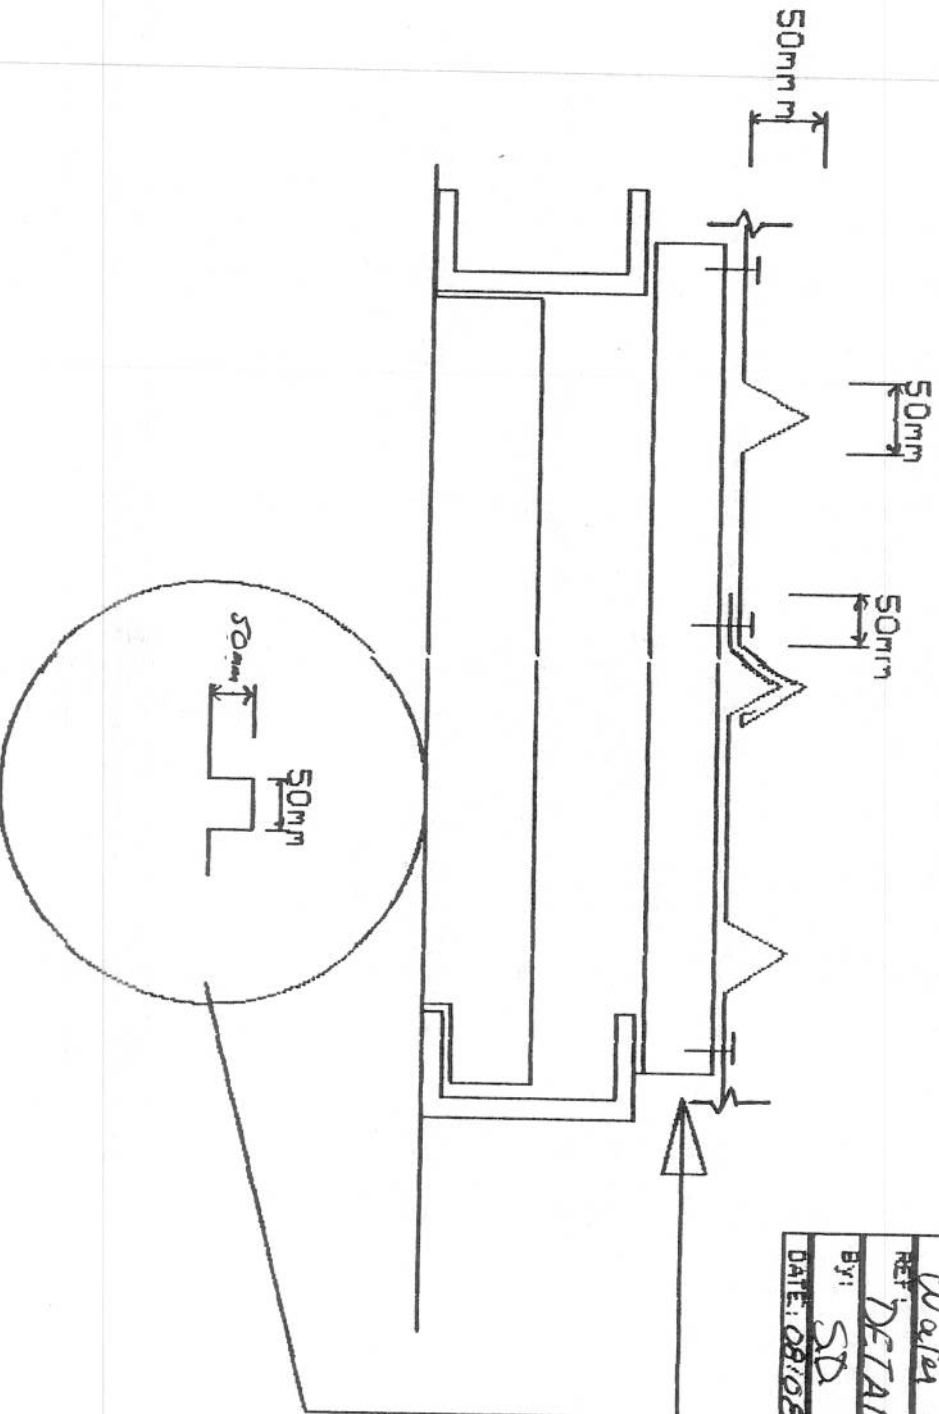

Lee's Construction

TITLE:

Water Tank

REF:

DETAIL "A"

BY:

SD

DATE: 08/08/92

Glidden

PROTECTIVE MAINTENANCE COATINGS DATA

Converted Epoxy Coating System

For Industrial Use Only & Professional Application Only

GLID-GUARD® Potable Water

Epoxy No. 5230 Series

For Potable Water Service

PRODUCT DESCRIPTION

GLID-GUARD Potable Water Epoxy is a two component polyamide epoxy coating tested and approved by the National Sanitation Foundation (NSF) for direct contact with potable water, including immersion service. It is available in white or light gray.

For potable water applications, two or three coats of this product untinted are used without a separate primer. Use of an unauthorized primer or the addition of any tinting colorants will void NSF acceptance of the coating system.

GLID-GUARD Potable Water Epoxy has excellent moisture, abrasion, and chemical resistance. It is suitable for use on metal, masonry, and wood. May be applied directly to ferrous metal, aluminum, and galvanized metal (see SURFACE PREPARATION below).

PRODUCT FEATURES

- * Approved by NSF
- * Long term flexibility
- * Hard and abrasion resistant
- * Easy 1:1 mixing ratio
- * Excellent alkali and solvent resistance
- * Resistant to fresh and salt water immersion
- * Tolerant of surface moisture

PRODUCT LIMITATIONS

Will withstand 120°C. (250°F.) continuous and 150°C. (300°F.) intermittent dry heat. Some discoloration may occur as these limits are approached, but the coating will remain intact.

Will chalk and lose gloss on exposure to direct sunlight.

PRODUCTS AVAILABLE

GLID-GUARD Potable Water Epoxy White No. 5230 (Component A)
GLID-GUARD Potable Water Epoxy Light Gray No. 5233 (Component A)
GLID-GUARD Potable Water Epoxy Curing Agent No. 5453 (Component B)
GLID-GUARD Potable Water Epoxy Reducer No. 5569

SURFACE PREPARATION

Surfaces to be painted should be internally dry and cleaned free of dirt, grease, wax, soap or powdery residue, rust or mill scale, and any other contaminants.

TECHNICAL DATA

All data shown is for a mixed (converted) gallon unless otherwise noted.

*Product Number - 5230/5453

Generic Type - Polyamide epoxy

Colour - White

Sheen - Approximately 80 @ 60°

Type of Cure - Converted

Percent Solids by Volume - 44 ± 1%

Theoretical Coverage per 1.0 dry mil (2.3 mils wet)
— 706 sq. ft./gallon U.S.

**Recommended coverage (Calculated)

Minimum 3.0 mils dry (7.0 mils wet) — 235 sq. ft./gallon U.S.

Maximum 5.0 mils dry (11.5 mils wet) - 141 sq. ft./gallon U.S.

When computing working coverage, allow for application losses, surface irregularities, any solvent addition, etc.

Percent Solids by Weight - 58 ± 1%

Percent Vehicle (Solids) by Weight - 36 ± 1%

Percent Pigment by Weight - 22 ± 1%

Percent Solvent by Weight - 42 ± 1%

Viscosity - 65-70 KU

Weight per Gallon - 9.4 lbs.

Flash Point - (Closed Cup) - Base 5230 - 9°C

Curing Agent 5453 — 20°C

VOC - 3.9 lbs/gallon (470 gm/litre) un-reduced

Drying Time - (25°C, 50% R.H.)

Touch - 3 hours Handle- 8 hours Recoat - 16 hours

Full Cure - 7 days (21 Days @ 15°C., 4 days @ 32°C.)

Reduction Solvent - GLID-GUARD Potable Water Epoxy Reducer No. 5569 (if needed)

Clean-up Solvent - GLID-GUARD Potable Water Epoxy Reducer No. 5569

Mixing Ratio (Base: Curing Agent) by Volume - 1:1

Induction Before Use - 30 minutes @ R.H. Less than 70% or surface/material temperature less than 25°C. 60 minutes @ R.H. more than 70% or surface/material temperature 18° - 24°C.

90 minutes @ surface/material temperature 10° - 17°C.

Pot Life - 7 hours @ 27°C., 3 hours @ 38°C.

Tinting - DO NOT TINT

* Compositional data for other products in this series may differ slightly.

** As measured over the peaks of any blast profile or surface projections.

Ferrous Metal Surface

For immersion service or other aggressive environments, abrasive blast ferrous metal to White Metal (SSPC-SP5-82) or Near White Metal (SSPC-SP10-82). Commercial Blast (SSPC-SP6-82) Power Tool Cleaning (SSPC-SP3-82), or Hand Tool Cleaning (SSPC-SP2-82) may be used in mild exposure conditions. **NOTE:** Unless ground smooth, irregular weld seams should be double primed. Treat with a brush coat of 5230/5453 reduced 25% with Glid-Guard Potable Water Epoxy Reducer No. 5569 just prior to spray application of first coat. **Do not add any other thinner or reducer.**

Non-Ferrous Metal (Galvanized, Aluminum)

Non-ferrous metals must be cleaned free of dirt, oil, grease, and any other contaminants. Abrasive blasting is not necessary.

Wood

Sand smooth and dust clean.

Poured Concrete

Verify that surface projections have been leveled by grinding, stoning, or scraping. Remove weak or powdery surfaces. Clean to remove form release oil or parting compound. Patch voids and cracks with patching material approved for potable water service. **NOTE:** Prime poured concrete with this product reduced 25% by volume with GLID-GUARD Potable Water Epoxy Reducer No. 5569. **Do not add any other thinner or reducer.**

Previously Painted Surfaces

The performance of this coating over previously painted surfaces is directly influenced by the type, age, and condition of the old coating. For best results in immersion situations, completely remove any old coating. For non-immersion service, remove all blistered, loose, or peeling old coating. Hard or glossy finishes should be dulled by sanding or other abrasive means. Apply to a test area; If wrinkling or lifting occurs after overnight drying, remove the old coating.

MATERIAL PREPARATION

Do not tint with DRAMATONE® or any other colorants. Combine White No. 5230 (Component A) or Light Gray No. 5233 (Component A) with Curing Agent No. 5453 (Component B) in equal parts by volume using power agitation. Allow the mixed material to stand 30 minutes before use. Extend this induction (standing) time to 60 minutes if the relative humidity is above 70% or the surface or material temperature is 18° - 24°C (65° - 70°F.) and to 90 minutes if the surface or material temperature is 10° - 17°C (50° - 64°F.) Thinning is not recommended for brush or roller application. If necessary to obtain satisfactory application properties when spray applying, use GLID-GUARD Potable Water Epoxy Reducer No. 5569 only, not exceeding 10% by volume of converted (mixed) material. **The addition of reducers other than No. 5569 will void the NSF approval for the coating, as will the use of other curing agents or mixing with other paints.** Pot life is 7 hours at 27°C (80°F.), 3 hours at 38°C (100°F.) **NOTE:** Application after the pot life has been exceeded will result in unacceptable sag resistance.

APPLICATION

May be applied by brush, roller, or airless spray. **Do not apply when surface or material temperature is below 10°C. (50°F.)**

For bare metal, three coats of No. 5230/5453 at 3.0 dry mils per coat or two coats of No. 5230/5453 at 5.0 dry mils per coat are required for immersion service. For bare poured concrete, one reduced prime coat of No. 5230/5453 (**see SURFACE PREPARATION-Poured Concrete above**) followed by two coats of No. 5230/5453 at 5.0 dry mils per coat are recommended. Coats of alternating colors (Light Gray and White) should be used since the color contrast will help prevent holidays and thin spots. The color of the first coat should be selected to provide maximum contrast to the color of the substrate. **Other primers are not required and cannot be used for potable water service.**

IMPORTANT NOTE: Polyamide epoxy coatings may yellow excessively and/or dry with substandard gloss under certain application and drying conditions. To minimize the possibility of this happening, always:

1. Use power agitation when combining Nos. 5230 and 5453 (do not box or stir).
2. Allow the mixed material to stand for 60 minutes before use if the relative humidity is above 70% or the surface or material temperature is 18° - 24°C. (65° - 75°F.) and for 90 minutes if the surface or material temperature is 10° - 17°C. (50° - 64°F.).
3. Make any solvent addition after the induction (standing) period.
4. Avoid application at relative humidities above 75% when possible.
5. Avoid application in acid fume or gas fume environments (which often result from the use of portable kerosene heaters).
6. Avoid using if the pot life has been exceeded.

SPRAY APPLICATION

Airless Spray

Fluid Tip: 517

Pressure: 1600-1700 psi

All pumps must be kept well away from areas where vapors from this product may collect.

COVERAGE

Theoretical per coat coverage : 235 sq. ft./gallon at 3.0 mils dry (7.0 mils wet) or 144 sq. ft./gallon at 5.0 mils dry (11.5 mils wet). When computing working coverage, allow for application losses, surface irregularities, any solvent addition, etc.

DRYING

Dries to touch in 3 hours, to handle in 8 hours, to recoat in 16 hours, to full cure in 7 days at 25°C. (77°F.), 50% relative humidity. Allow longer drying times under cooler or more humid conditions. 21 days are required for full cure at 15°C. (60°F.)

RECOMMENDED CURING FOR POTABLE WATER SERVICE

1. Normally, full curing of this product will take place in 7 days at 25°C. (77°F.) More time is required at lower temperatures. For example, at 15° C (60°F.) 21 days are required to reach full cure.
2. Force curing is recommended when the coating is to be used for potable water service in order to insure the complete removal of solvents and odor. Force curing is strongly recommended if the surface temperature is in the range of 10°-17°C. (50°-64°F.) and for enclosed tanks. Force curing is required when the coat surface is to be immersed before the 7 day room temperature curing can take place.
3. Curing schedules to be used as a guide for time and work planning are listed below. Prior to subjecting the coat surface to the force curing metal temperature, the coating must be air dried for 2-5 hours at temperatures between 20°C. (70°F.) and 40°C. (100°F.). After the air dry period has elapsed, the temperature should be raised in increments of approximately 20°C. (40°F.) every 30 minutes until the desired force cure metal temperature is reached. "Curing Time" in the schedule below indicates the time required after the metal temperature is reached. It does not include the time spent bringing the metal to the force curing temperature.

Metal Temperature

Curing Time

150°F. (65°C.)
175°F. (80°C.)
200°F. (93°C.)
225°F. (107°C.)

12 hours
10 hours
6 hours
4 hours

4. Approximate final cure of the material is indicated when the surface is hard and cannot be marred by the fingernail. 10 minutes exposure to methyl isobutyl ketone (MIBK) should result in only slight softening.
5. Before filling potable water tanks, rinse thoroughly with fresh water to remove any traces of solvent. This will insure that the coating will not impart taste, odor, or color to the water.

CLEAN-UP

Clean all equipment immediately after use with GLID-GUARD Potable Water Epoxy Reducer No. 5569.

LIMITATION OF LIABILITY

To the best of our knowledge the technical data contained herein are true and accurate at the date of issuance but are subject to change without prior notice. We guarantee our product to conform to Glidden's specifications. WE MAKE NO OTHER WARRANTY OR GUARANTEE OF ANY KIND EXPRESS OR IMPLIED, INCLUDING MERCHANTABILITY AND FITNESS FOR PARTICULAR PURPOSE. Liability, if any, is limited to replacement of the product or refund of the purchase price. LABOR OR COST OF LABOR AND OTHER CONSEQUENTIAL DAMAGES ARE HEREBY EXCLUDED.

FOR BEST RESULTS AND SAFEST USAGE, USER IS SPECIFICALLY DIRECTED TO CONSULT THE CURRENT MATERIAL SAFETY DATA SHEET FOR THIS PRODUCT.

EMERGENCY PHONE: (416) 669-1020

WARNING! FLAMMABLE. VAPOR HARMFUL — MAY IGNITE EXPLOSIVELY. CAN CAUSE IRRITATION OF EYES, SKIN AND RESPIRATORY TRACT.

Keep away from heat, sparks and flame. Do not smoke. Vapors may ignite explosively. Extinguish all flames, burners, stoves, heaters and pilot lights and disconnect all electrical motors and appliances before use and until all vapors are gone. Vapors may spread long distances. When spray applying in confined or enclosed areas, use portable explosion-proof lighting and ventilating equipment connected to exterior self-contained power source. Non explosion-proof equipment must be placed well away from areas where vapors may collect. Use non-ferrous tools and wear conductive and non-sparking shoes in areas where explosion hazards exist. Keep closures tight and upright to prevent leakage. Keep container closed when not in use. Store below 40°C. (100°F.) **Do not** incinerate closed containers as they may explode when exposed to extreme heat or fire. In case of spillage, absorb and dispose of in accordance with local applicable regulations.


Avoid contact with eyes and skin. Impervious clothing, footwear and equipment including gloves and splash-proof goggles should be worn, especially when spray applying. **Do not** take internally.

Avoid breathing of vapor, spray mist or sanding dust. Wear an appropriate, properly fitted respirator (NIOSH/MSHA approved) during and after application unless air monitoring demonstrates vapor/mist levels are below applicable limits. Follow respirator manufacturer's directions for respirator use.

FIRST AID: In case of skin contact, wash off **quickly** with plenty of water, then soap and water; remove contaminated clothing. For eye contact, flush **immediately** with large amounts of water, especially under lids, for at least 15 minutes. **Obtain emergency medical treatment.** If swallowed, **GET MEDICAL ATTENTION IMMEDIATELY.** If inhalation causes physical discomfort, remove to fresh air. Restore and support continued breathing. Have trained person give oxygen if necessary. If discomfort persists or any breathing difficulty occurs, **GET EMERGENCY MEDICAL ASSISTANCE.**

USE ONLY WITH ADEQUATE VENTILATION. KEEP OUT OF REACH OF CHILDREN.

NOTICE: Reports have associated repeated and prolonged occupational over-exposure to solvents with permanent brain and nervous system damage. Intentional misuse by deliberately concentrating and inhaling the contents may be harmful or fatal.

 

CAPE DORSET WATER STORAGE TANK

TABLE OF CONTENTS

	Section
General Specifications	1
List of Suppliers	2
Supplier Manuals	3
Material Test Reports	4
Non-Destructive Testing Reports	5
Drawings	6





CAPE DORSET WATER STORAGE TANK

GENERAL SPECIFICATIONS

Inside Diameter:	8,900 mm (29'2-3/8")
Shell Height:	9,000 mm (29'6-5/16")
Floor Material:	5/16" thick, A-36
Shell Material:	3/16" thick, A-36
Roof Material:	3/16" thick, A-36
Pipe:	A-53-B ERW sch. std.
Flanges:	A-105 150# flat faced



UNIVERSAL INDUSTRIES LTD.

BOX 1590 LLOYDMINSTER, SASK. ALTA S9V 1K5 (403) 875-6161 FAX (403) 875-6169



CAPE DORSET WATER STORAGE TANK


LIST OF SUPPLIERS

Items Supplied	Supplier
Hattersley Valves	Westland Industrial Supply 3691 - 98th Street Edmonton, AB T6E 5N2 Phone: 1-800-661-0273
Dezurik Valves	Dezurik of Canada 385 Franklin Boulevard Cambridge, ON N1R 5V5 Phone: (519) 621-8980
Dupont Sclairpipe	Perma Engineering Sales Ltd. Box 735 Martinsville, SK S0K 2T0 Phone: (306) 931-2900
Grinnel Clamps	Grinnel Corporation Box 2285 11340 - 120th Street Edmonton, AB T5G 0W5 Phone: (403) 452-9841



UNIVERSAL INDUSTRIES LTD.

BOX 1590, LLOYDMINSTER, SASK. ALTA. S9V 1K5 (403) 875-6161 FAX (403) 875-6169

 

Victaulic® Couplings


Victaulic® couplings are a simple, mechanical method of joining SCLAIRPIPE without fusion providing reliable and leak-free joints. They allow for the joining of plain end pipe and fittings without preparation or special equipment. The two housings that make up the Victaulic coupling are cast in ductile iron and are bolted together, metal-to-metal with oval neck track head bolts allowing tightening of the nuts from one side with a single wrench until the housing bolt pads meet.

The Victaulic coupling has been designed to meet or exceed the maximum working pressure of the pipe itself, and has been proven through extensive field testing and installation experience. The couplings are painted with orange enamel or optional zinc coating.



TABLE 15


STYLE 995 VICTAULIC® COUPLING

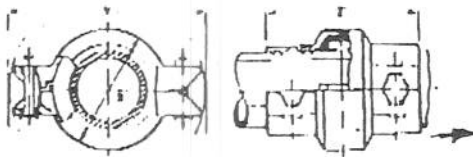

Style 995 coupling is designed for joining plain end Sclairpipe together

Nominal Pipe Size	Pipe O.D.	COUPLING DIMENSION			BOLT DIMENSIONS		Assembled Coupling Weight
		x dia.	y	z	Number	Dia. x Length	
2"	2.375"	3.640"	5.813"	3.620"	2	0.500" x 2.500"	3.5 lb.
3"	3.500"	4.625"	6.813"	4.560"	4	0.500" x 2.750"	7.7 lb.
4"	4.500"	5.875"	7.750"	5.750"	4	0.500" x 2.750"	11.6 lb.
6"	6.625"	8.000"	10.500"	6.875"	4	0.625" x 3.250"	16.4 lb.
8"	8.625"	10.188"	13.000"	8.000"	4	0.625" x 3.250"	24.9 lb.
10"	10.750"	12.375"	15.813"	8.500"	4	0.750" x 5.000"	37.4 lb.
12"	12.750"	14.375"	17.750"	7.000"	4	0.875" x 5.000"	49.0 lb.
14"	14.000"	16.250"	21.000"	7.750"	4	0.875" x 7.000"	81.0 lb.

STYLE 994 VICTAULIC® FLANGE

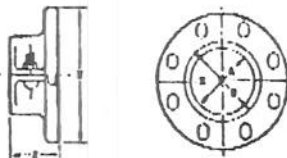


Flange Style 994 permit directly joining Sclairpipe to flanged valves, pumps and other equipment. Housing teeth grip into Sclairpipe as assembled. Flange face mates to ANSI Class 125 or 150 flanges using standard Victaulic Flange pressure responsive gasket (supplied).

FLANGE NOMINAL SIZE Inches	DIMENSIONS				VICTAULIC® FLANGE				APPROX. WT. EA. lbs.
	BOLTS AND NUTS		FLANGE TO FLANGE		X" Z"		SEALING SURFACE (MAX.)	SEALING SURFACE (MIN.)	
	SIZE Inches	NO. REQ'D.	SIZE Inches	NO. REQ'D.	Inches	Inches	"	"	
4	5/8 x 1 3/4	2	5/8 x 2 3/4	8	9	3 3/4	4 1/2	5 5/8	12.5
6	3/4 x 2 1/4	2	3/4 x 3	8	11	4	6 1/2	7 1/2	17.3
8	3/4 x 2 1/4	2	3/4 x 3	8	13 1/2	4 1/2	8 1/2	10	30.8

1. Standard Flange bolts not supplied with Victaulic Flange.
2. Victaulic Flange uses Victaulic Pressure Responsive Gasket, Standard Flange Gasket not required.
3. Minimum/Maximum sealing surface on mating flange must be available for proper gasket sealing. Entire area must be flat. Heavy serrated (Phonograph Record) finishes are not acceptable. When used with rubber seated Water Butterfly Valves, a flat metal adapter plate is needed. Contact KWH Pipe for details.

STYLE 995T TRANSITION COUPLING

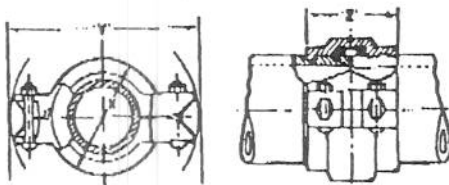

Style 995T coupling provides a transition from Sclairpipe to steel pipe or fittings. The key section on the steel side of the housing engages a specially grooved fitting. No. 43HT or No. 42HT shown below.

Nominal Size Inches	Pipe-Inches Outside Diameter	Coupling Dimensions			Approx. Wgt. Ea. Lbs.
		X	Y	Z	
2	2.375	3 1/2	6 1/16	3 1/2	3.5
3	3.500	4 1/2	6 3/16	4 1/16	7.7
4	4.500	5 1/2	7 3/4	5 1/4	11.8
6	6.625	8	10 1/2	5 1/2	16.4
8	8.625	10 3/16	13	6	24.9
10	10.750	12 3/4	15 3/16	6 1/2	37.4
12	12.750	14 1/2	17 3/4	7	49.0

SUPERBALL from NEWMAN HATTERSLEY LTD., CANADA



• 1969 THREADED ENDS

The SUPERBALL is a super ball valve with all the most-wanted features usually found in only more expensive valves. Features such as:

- Large ports to minimize pressure drop, turbulence.
- P.T.F.E. seats, stem packing seal, and thrust washer to assure long life.
- SUPERBALLS have a bottom loaded, pressure-retaining stem of rugged construction.

• Each SUPERBALL is tested twice: air under water; in the open and in the closed position.

- Self-cleaning chrome-plated brass ball for erosion resistance and durability.
- Fast, quarter-turn operation.
- Non-slip vinyl grip on cadmium plated steel handle.
- Can be installed with flow in either direction.
- Compact design for installation ease.

Fig. 1969 CGA - THREADED ENDS

• C.G.A. APPROVED FOR USE WITH NATURAL AND PROPANE GAS
-30°C to 65°C at 125 P.S.I.G. MAX. (1/2" - 2")



• 1979 SOLDER ENDS

Dimensions in Inches

Valve	• 1969						• 1979						Cv Factor Imperial
	A	B	C	D	E	F	A	B	C	D	E	F	
1/4"	0.15	1.028	1.733	0.768	1.635		1/4"						7.48
3/8"	0.394	1.280	2.031	0.886	1.728		3/8"						7.79
1/2"	0.500	1.327	2.070	1.052	2.126		1/2"	500	1.327	2.070	1.184	2.848	11.67
3/4"	0.687	1.791	2.306	1.220	2.441		3/4"	687	1.791	2.306	1.575	3.150	21.41
1"	0.891	1.913	2.386	1.476	2.958		1"	891	1.913	2.386	1.911	3.822	42.8
1-1/4"	1.109	2.114	2.386	1.654	3.307		1-1/4"	1.109	2.114	2.386	2.125	4.250	65.6
1-1/2"	1.378	2.244	4.483	1.831	3.461		1-1/2"	1.378	2.244	4.483	2.437	4.874	121.2
2"	1.772	2.540	4.843	2.106	4.812		2"	1.772	2.540	4.843	2.970	5.980	184.00
2-1/2"	2.264	2.476	5.827	2.818	5.630		2-1/2"	2.264	2.476	5.827	3.500	7.000	279.3
3"	2.677	2.811	6.827	3.071	6.148		3"	2.677	2.811	6.827	4.000	8.000	313.1
4"	3.543	4.461	8.827	4.018	7.992		4"						534.6

The Cv Factor is the Gallons of water per minute passed through the valve with 1 PSI pressure drop.


Material Specification

1	Lower nut	Brass plated steel
2	Lower	Brass plated steel vinyl coated
3	Stem packing	P.T.F.E.
4	O-Ring	Urethane
5	Stem drill	P.T.F.E.
6	Stem	Brass QT 68 UNI 8705-68 (BS 2872 CS 125)
7	Ball	Chromium plated brass nickel chrome plated
8	Seals	P.T.F.E.
9	End Connector	Forged brass QT 68 UNI 8705-68 (BS 2872 CS 125)
10	Body	Forged brass QT 68 UNI 8705-68 (BS 2872 CS 125)

Pressure Rating

1/4"-3/4"	600 lb. W.O.G. non-shock
1"-2"	500 lb. W.O.G.
2-1/2"-3"	400 lb. W.O.G.
4"	300 lb. W.O.G.

All sizes rated at 150 W.S.P.

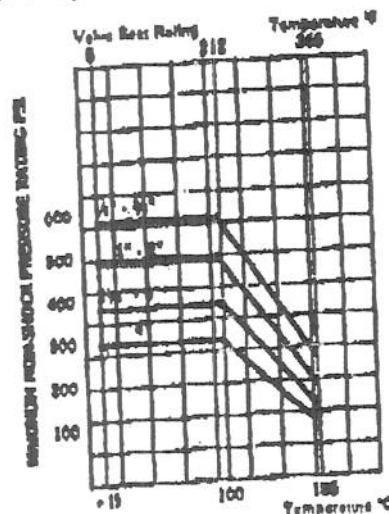


HEAD OFFICE
#1, 9735 - 51 Avenue
EDMONTON, Alberta
T6E 0A8

#205, 259 Midpark Way S.E.
CALGARY, Alberta
T2X 1M2
(403) 278.0222

#48, 2400 Lucknow Drive
MISSISSAUGA, Ontario
L5S 1V2
(416) 878-2870

4378 Gilles Street
PIERREFONDS, PQ
H9H 2N1
(514) 824-4388
FAX (514) 824-4389

DeZURIK[®] DRAWINGS

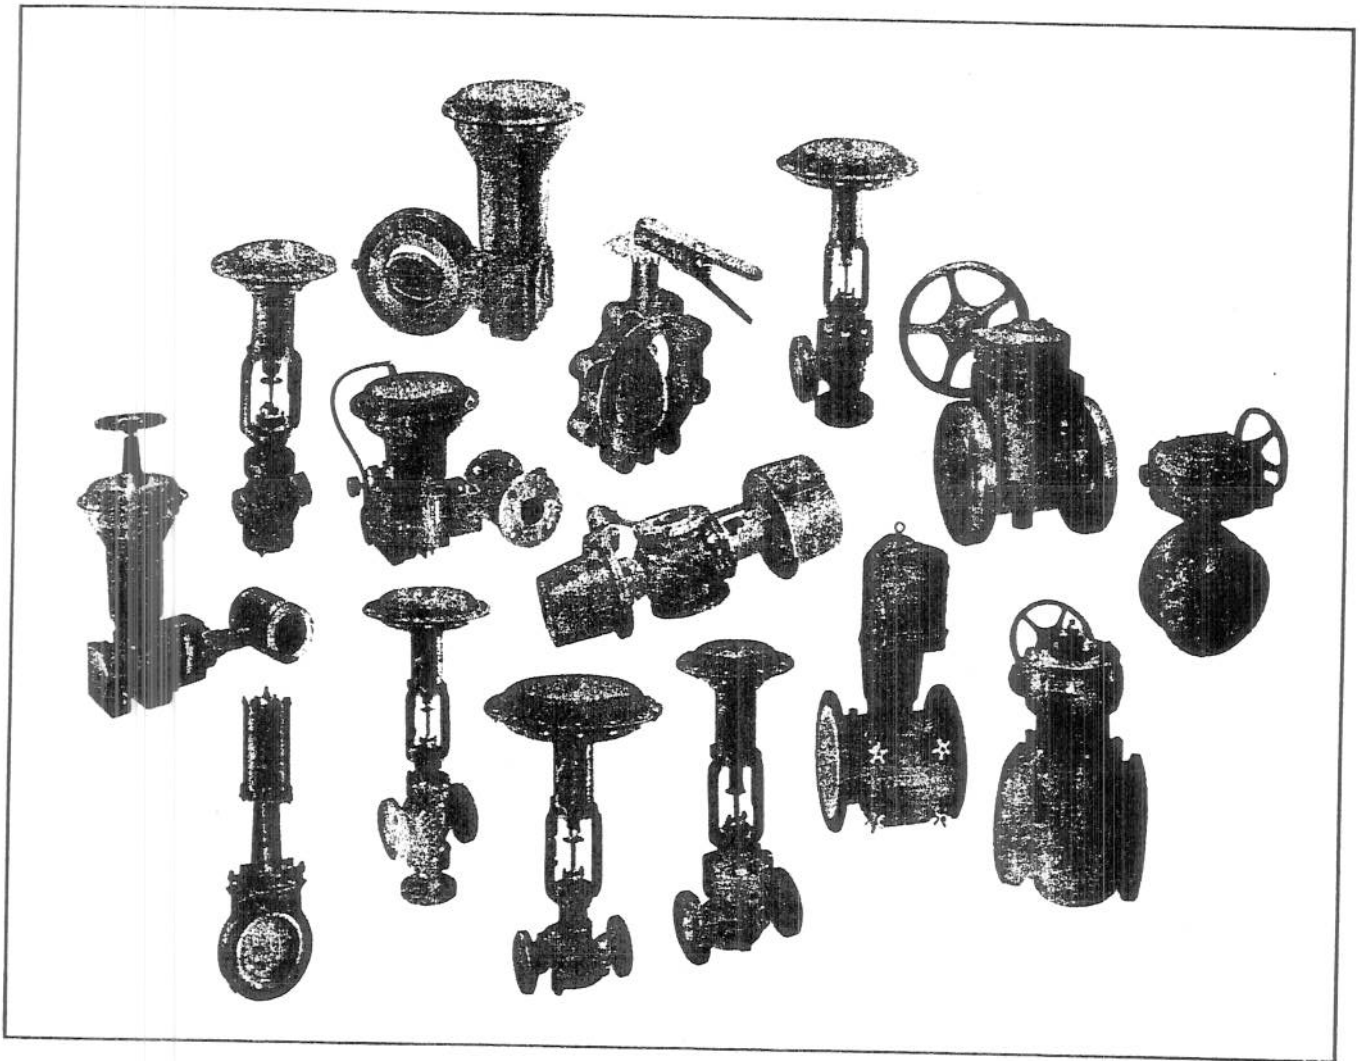

DeZURIK
250 Riverside Avenue
Sartell, MN 56377
Phone 612/259-2000
Fax 612-259-2227

DeZURIK Canada Ltd.
P.O. Box 1300
Cambridge, Ontario N1R 5V5
Canada
Phone 519/621-8980
Fax 519-621-3006

DeZURIK **GS**
A UNIT OF GENERAL SIGNAL

THESE DATA ARE CERTIFIED FOR

479251-0 UNIVERSAL INDUSTRIES
P.O. BOX 1590

LLOYDMINSTER

AB S9V-1

A UNIT OF GENERAL SIGNAL

YOUR ORDER NO P4438
DEZ ORDER NO 095716 REV-

DEZ CUST
ITEM ITEM

QTY PRODUCT DESCRIPTION PART NO. 9229556

01-C 2 0600, FIG632, L, D, RS66, 3, KWG3N, MSX003.

SIZE 0600 6 INCH
FIGURE NUMBER FIG632
END STYLE L RESILIENT SEATED BUTTERFLY VALVE, CAST IRON CONSTRUCTION
PACKING 2 D LUGGED (2-20 INCH SINGLE FLANGE) (24-36 INCH DOUBLE
RUBBER MATL RS66 NORDEL (TERPOLYMER OF ETHYLENE PROPYLENE)
TRIM 3 NORDEL (TERPOLYMER OF ETHYLENE PROPYLENE)
ACTUATOR KWG3N 316 SST DISC, 316 SST SHAFT, TFE COATED SST BRGS IN2"-2
0" REINFORCED TFE BRGS IN 24"-36"

PROD. MOD. MSX003 TYPE 416 STAINLESS STEEL SHAFT
225 PSI CWP (AND TO INCLUDE FIG655 FLANGE SEALS
4 IN AND LARGER)

DRAWING NUMBER
A22063
A20806
A21219
D10035
D10004






DRAWING DESCRIPTION
DWG INST L G3N
DWG VALVE ASSY L RS BFLY
DWG ACT G3H-W-L-N
IM VALVE RS BFLY
IM ACT MAN ROTARY T-BOX

VALVE SIZE	DIMENSIONS									
	A	B	C	D	E	F	G	H	J	K
2	1.56 39.8	6.00 152.4	2.94 74.7	5.50 139.7	.50 12.7	6.08 153.5	4 5/8 - 11 UNC	4.75 120.6	NOT REQ'D	NOT REQ'D
2 1/2	1.75 44.4	6.75 171.4	3.18 81.0	6.12 155.4	.50 12.7	6.89 174.5	4 5/8 - 11 UNC	6.50 165.1	NOT REQ'D	NOT REQ'D
3	1.75 44.4	7.25 184.2	3.50 88.9	6.50 165.1	.50 12.7	6.08 153.5	4 5/8 - 11 UNC	8.00 203.2	.25 6.4	3.44 87.4
4	2.00 50.8	8.75 222.2	4.12 104.8	7.12 180.8	.62 15.7	6.82 173.1	8 5/8 - 11 UNC	7.50 190.5	.25 6.4	4.38 111.3
5	2.08 52.3	10.00 254.0	4.75 120.6	7.12 180.8	.75 19.0	8.56 218.3	8 3/4 - 10 UNC	9.50 241.3	.12 3.0	5.44 138.2
6	2.06 52.3	11.00 279.4	5.50 139.7	8.82 223.9	.75 19.0	8.06 204.7	8 3/4 - 10 UNC	9.50 241.3	.12 3.0	6.44 163.6

A	VALVE ASSEMBLY
B	ACTUATOR

NOTES:

1. VALVE FITS CLASS 125 AND 150 A.N.S.I. STANDARD FLANGES.
2. FOR FLANGES OTHER THAN A.N.S.I. STANDARD SEE A-17173 FOR DIMENSIONS.
3. DO NOT USE GASKETS BETWEEN VALVE AND MATING FLANGES.
4. FLOW MAY BE IN EITHER DIRECTION. INSTALL VALVE WITH THE HIGHER PRESSURE AT THE END SHOWN ON DRAWING.
5. WHEN USING NOMINAL PIPE SIZE PIPING USE HARD ASBESTOS GASKETS TO PROVIDE DISC SWING CLEARANCE. GASKETS TO BE ".25" THICK WITH "K" I.D.
6. 8 TURNS OF WRENCHING SQUARE TO OPEN VALVE.
7. WHEN FIG. 655 FLANGE SEALS ARE USED WITH VALVE, LAYING LENGTH (DIMENSION "A") INCREASES BY .19 INCHES (4.8 MILLIMETERS).

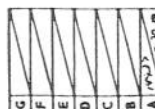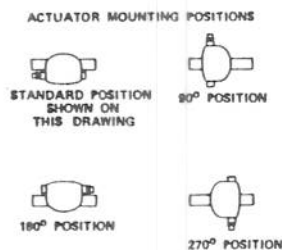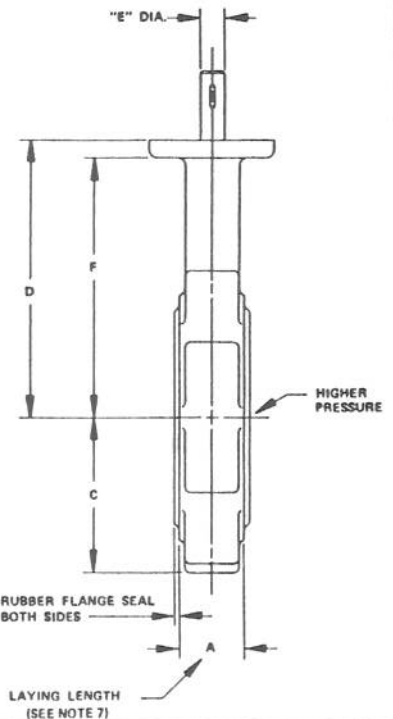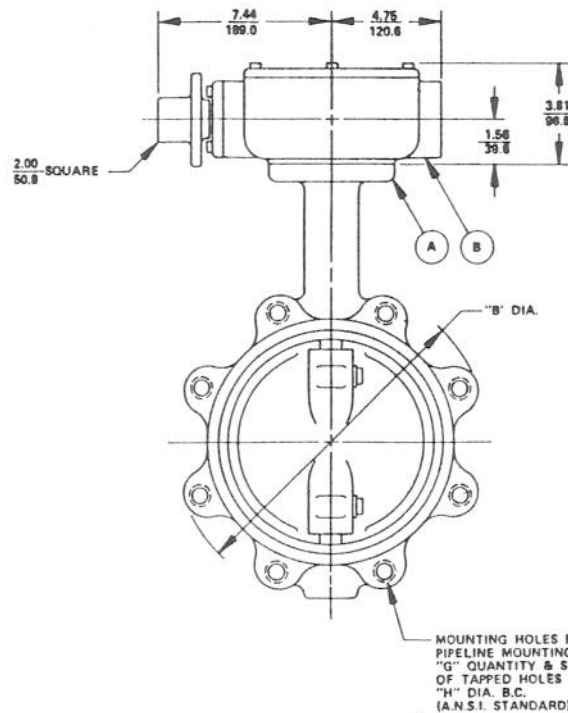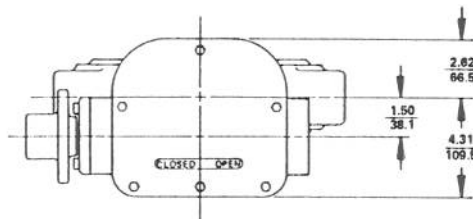

DeZURIK






SARTELL, MINNESOTA, U.S.A. 56377
CAMBRIDGE, ONTARIO, CANADA
SUNBURY, VICTORIA, AUSTRALIA
CRAMINGTON, ENGLAND

2-6 LUGGED FIG. 632 R.S. BUTTERFLY VALVES
K-G3N NUT ACTUATED

DOCT. CODE	DRAWN D.H.	APPROVED R.H.
CHECKED T.S.	DATE 11-15-80	

A-22063

A-20806

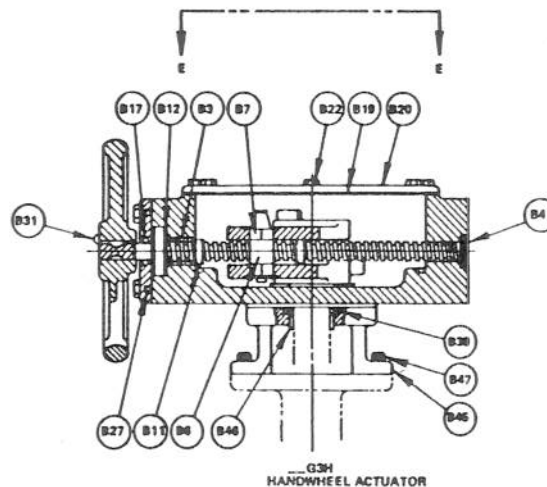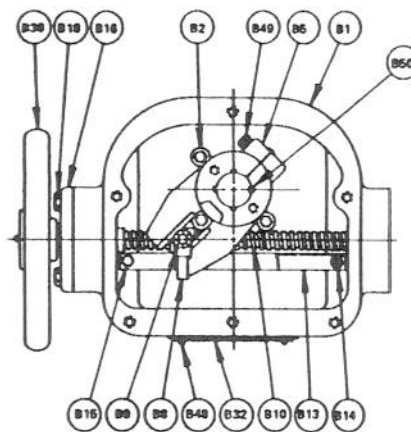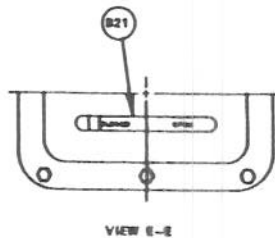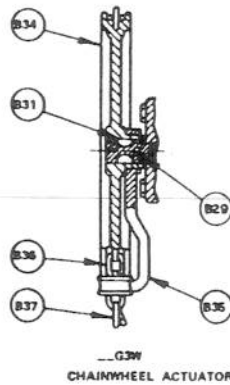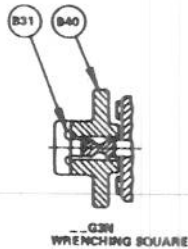

PART NAME	QTY
HOUSING	1
B2 SCREW	4
B3 BEARING (HOUSING)	1
B4 EXPANSION PLUG	1
B5 YOKE	1
B6 YOKE NUT	1
B7 BEARING	2
B8 POINTER	1
B9 RETAINER	2
B10 SHAFT	1
B11 STOP NUT	2
B12 THRUST BEARING	2
B13 GUIDE RAIL	1
B14 SPACER	2
B15 SCREW	2
B16 THRUST PLATE	1
B17 O-RING (EXCEPT _EG3_ ACT'R)	1
B18 SCREW	4
B19 GASKET (_WG3_ & _BG3_ ACT'R)	1
B20 COVER (SEE NOTE)	1
B21 WINDOW (EXCEPT _BG3_) (SEE NOTE)	1
B22 SCREW (_EG3_ ACT'R) (SEE NOTE)	3
B23 SCREW (_WG3_ ACT'R) (SEE NOTE)	6
B24	
B25	
B26	
B27 O-RING (EXCEPT _EG3_ ACT'R)	1
B28	
B29 PIN	1
B30	
B31 KEY (_G3L_ _G3H_ & _G3W_ ACT'R)	1
B32 KEY (_G3W_ ACT'R)	2
B33 DATA PLATE	1
B34 CRANK	1
B35 CHAINWHEEL	1
B36 CHAIN GUIDE	1
B37 CHAIN	1
B38 CLOSING LINK	1
B39 HANDWHEEL	1
B39 SEAL (_MWG3_ & _MBG3_ ACT'R)	1
B40 SEAL (_NWG3_ & _NBG3_ ACT'R)	1
B40 WRENCHING SQUARE	1
B46 BRACKET (_M_ _G3_ ACTUATOR)	1
B46 BEARING (_M_ _G3_ ACTUATOR)	1
B47 SCREW (_M_ _G3_ ACTUATOR)	4
B47 SCREW (_M_ _G3_ ACTUATOR)	4
B48 DRIVE SCREW	2
B49 SCREW	1
B50 KEY (_M_ _G3_ ACTUATOR)	1
B50 KEY (SEE NOTE 5)	1

- NOTES:
1. RECOMMENDED SPARE PARTS ARE ITEMS NO. B17, B18, B27, B31 & B38.
 2. ITEMS NO. B20, B21 & B22 ARE OMITTED WHEN SWITCH ACCESSORIES ARE FURNISHED.
 3. WHEN ORDERING PARTS REFER TO VALVE SIZE AND MODEL NUMBER ON DATA PLATE. ALSO GIVE DRAWING NUMBER WITH PART NAME, ITEM NUMBER AND QUANTITY.
 4. ON THE 1-4 FULL BORE VALVES AND 1 1/2-5 (EXCEPT 3 & 4 FIG. 951, 952) STANDARD BORE VALVES ITEM NO. B47 (SCREW) IS NOT REQUIRED. BRACKET MOUNTS TO VALVE USING GLAND BOLTS (ITEM NO. A23) ON VALVE ASSEMBLY.
 5. ON VALVE PRODUCT LINES OTHER THAN V-PORT BALL VALVES, KEY IS STOCKED WITH VALVE ASSEMBLY.



DeZURiK


SARTELL, MINNESOTA, U.S.A. 56377
CAMBRIDGE, ONTARIO, CANADA
SUNBURY, VICTORIA, AUSTRALIA
CRAWLINGTON, ENGLAND

DOCT. CODE	DRAWN	APPROVED
1	1	1
	CHECKED	DATE
	T-13	10-27-80

G3 MODULAR ACTUATOR
W/HANDWHEEL, CHAINWHEEL, CRANK AND NUT

A-21219

INSTRUCTION MANUAL FOR DeZURIK® 2"—20" FIG 632 BUTTERFLY VALVES

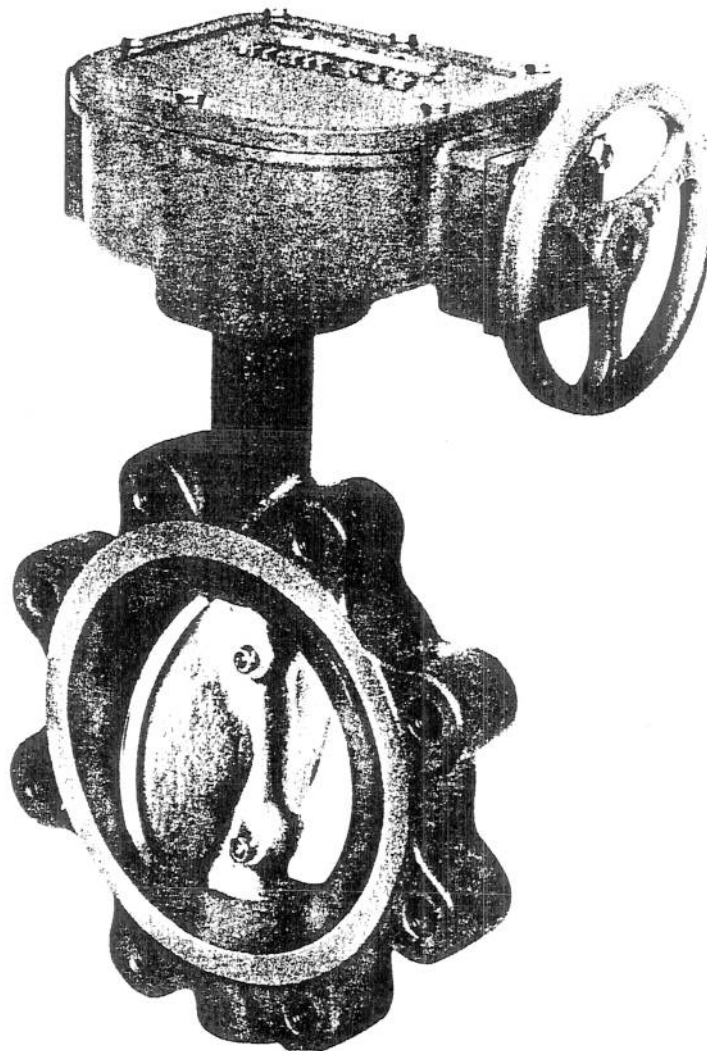

Gg DeZURIK
A UNIT OF GENERAL SIGNAL

© 1989 DeZURIK, A UNIT OF GENERAL SIGNAL

D-10035
March 1991
Rev C

INTRODUCTION

The 2" thru 20" DeZurik FIG 632 Butterfly valves are quarter turn butterfly valves designed to provide reliable service. Each DeZurik valve is tested at the factory to some of the most stringent standards in the industry.

A copy of these instructions should be made available to the personnel responsible for the installation and maintenance of this equipment. Refer to the applicable sales bulletin and to the valve data plate regarding materials of construction and product limitations.

The following instructions are written following a modular concept. Each separate major assembly in this product will have a separate instruction. Thus the basic valve will have a separate instruction, as will the actuator and any accessories your unit may have. The assembly drawings you receive also follow this concept. This concept was created to make the entire product seem less complicated by breaking it down into smaller, easier to understand modules.

INSPECTION

This equipment has been adequately packaged and protected for shipping; however, due to improper handling, the possibility of damage in transit exists. When the valve arrives at its final destination, it should be carefully inspected for damage and equipment malfunction.

STORAGE

Because the rubber seat in this valve may deteriorate if it is not protected from dust, freezing water, sunlight or other ultraviolet rays, store the valve in a clean, dry, cool location with the flange protectors intact. The valve should be stored with the disc horizontal and partially open.

If it is necessary to store the valve outdoors, it should be wrapped in plastic and stored high enough off the ground to ensure it will not be immersed in water or buried by snow. The plastic plugs in the cylinder or positioner (if equipped) must be replaced with pipe plugs.

REPLACEMENT PARTS

It is advised that one set of Recommended Spare Parts be inventoried for each valve size and type. Recommended Spare Parts are identified on the Assembly Drawing.

When ordering parts, please include the valve size and part number (7-digit) from the data plate. If possible, also include the Assembly Drawing number, Part Name, Balloon Number and Quantity of parts as shown on the Assembly Drawing.

DESCRIPTION The DeZURIK FIG. 632 Butterfly valve is a resilient seated valve featuring a double seat design. After normal cycle life of the first seat, the disc can be rotated 180 degrees to utilize the second seating surface.


INSTALLATION Before installation, remove foreign material such as weld spatter, oil, grease, and dirt from the valve and pipeline. Handle the valve carefully so that the flange seals are not damaged. Refer to the Installation drawing for dimensional information and gasket requirements.

Use ANSI Class 125 or 150 flanges, and ensure that the flanges conform to the dimensions in Table A. DeZURIK Figure 655 flange seals must be used with the following flanges and/or piping:

- 5" and larger Slip-on flanges
- Cast iron pipe with integral flanges
- Cast iron pipe with threaded flanges
- Schedule 5S and 10S thin wall tubing (Figure 655 flange seals recommended but not required)

Pipeline flow may be in either direction. Install the valve so that the higher pressure will be against the flat side of the closed disc.

For proper flange sealing, ensure that the valve and the pipeline flanges are concentric. Before final tightening of the pipeline flange bolts or studs, open the valve slowly to ensure that adequate clearance exists between the open disc and the pipeline. Tighten the flange bolts or studs in a crisscross pattern.

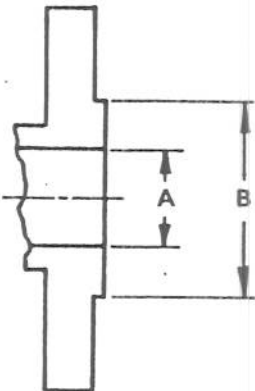

VALVE SIZE	DIMENSION A FLANGE INSIDE DIAMETER (inches)		DIMENSION B MINIMUM OUTSIDE DIAMETER OF FLANGE CONTACT SURFACE (inches)
	MINIMUM	MAXIMUM	
2	2.07	2.44	3.76
2.5	2.42	2.94	4.22
3	3.00	3.57	4.70
4	3.93	4.57	5.62
5	4.88	5.66	6.68
6	5.84	6.72	7.72
8	7.79	8.72	9.71
10	9.75	10.88	11.86
12	11.60	12.88	13.88
14	12.84	14.14	15.12
16	14.78	16.16	17.17
18	16.73	18.18	19.28
20	18.66	20.20	21.21

DIMENSIONS FOR MATING FLANGES FOR FIG 632 BUTTERFLY VALVES
TABLE A

TOOLS REQUIRED This valve is assembled using only standard SAE fasteners. To service this valve, you should have a full set of combination wrenches, a pin punch, a dead blow hammer and a hacksaw to remove the old seat. A small torch may be required when Loctite bonds must be broken.

MAINTENANCE Periodic lubrication is not necessary with the basic valve. See the Actuator and Accessory Instruction Manuals for any lubrication requirements these assemblies may have.

If the valve is disassembled, lubricate the valve as follows:

OXYGEN SERVICE VALVES Lubricate the quad ring seals, the seal grooves in the seat, and the inside and outside diameters of the bearings with Hooker Fluorolube GR-362, no substitutes are acceptable.

ALL OTHER APPLICATIONS Valves with RS66 Seat Material — Lubricate the quad ring seals, the seal grooves in the seat, and the inside and outside diameters of the bearings with a silicone based lubricant such as Dow Corning Molycote 44.

Valves with RS18, RS47, RS49, RS50 or RS63 Seat Material — Lubricate the quad ring seals, the seal grooves in the seat, and the inside and outside diameters of the bearings with a medium aluminum complex lubricant such as Keystone Nevastane.

CLOSED POSITION The valve is in the closed position when the disc is parallel to the flange face. The actuator stops have been adjusted at the factory to stop valve rotation in the proper closed position. See the Actuator Instruction Manual for details on adjusting the Open and Closed Position Stops.

DISC POSITION INDICATOR A chamfer corresponding with the flat side of the disc is machined on top of the valve shaft to show the position of the disc when the disc is not visible. The location of the indicator mark is shown on the valve assembly and installation drawings.

USING THE SECOND SEATING SURFACE After normal cycle life of the first seating surface, the disc can be rotated 180 degrees to utilize the second seating surface. To rotate the disc, follow these steps:

1. Discontinue flow thru the pipeline.
2. Remove the actuator from the valve. A detailed procedure on actuator removal is presented in the Actuator Instruction Manual.
3. Rotate the valve shaft 180 degrees.
4. Install the actuator on the valve. See the Actuator Instruction Manual for step-by-step instructions.
5. Check the actuator Open and Closed Position Stops and readjust if necessary. See the Actuator Instruction Manual for details.

NOTE: It is normally recommended that the higher pipeline pressure be against the flat side of the disc. This will require the valve be removed from the pipeline, rotated 180 degrees and reinstalled. See the VALVE REMOVAL FROM PIPELINE section of this instruction for the proper valve removal procedure.

6. After reinstalling the valve, pipeline flow and pressure can be reinstated.

SEAT, SEAL AND BEARING REPLACEMENT

To replace the seat, seal, and/or bearings, you will need the following: a full set of combination wrenches, a pin punch, a dead blow hammer, a hacksaw, Loctite 222 and a lubricant (as described in the MAINTENANCE section of this instruction). A small torch may be required to break the Loctite seal which retains the bearings.

1. Relieve pipeline pressure and drain the portion of the system where the valve is located.
2. Remove the valve from the pipeline. See the VALVE REMOVAL FROM PIPELINE section of this instruction.
3. Remove the actuator; see the Actuator Instruction Manual for a detailed procedure on actuator removal.
4. Lay the valve in a horizontal position, seat side down. Place support blocks under the disc so it will not drop when the shaft is removed.
5. Remove the plug from the bottom of the valve body.

6. Remove the disc pin(s) as follows:

2" thru 3" Valves

Drive the pin out using the punch and dead blow hammer.

4" thru 20" Valves

- a) Remove the nut and washer from each disc pin.
- b) Drive out the tapered disc pin using the dead blow hammer.

7. Remove the shaft from the valve body.

8. Lift the disc from the valve.

9. Remove the seat from the valve as follows:

2" thru 12" Wafer
Valves

With the disc and shaft removed, the seat can be slid out of the valve body. It may be necessary to pry the seat to loosen any oxidation adhering it to the valve body.

14" thru 20" Wafer
Valves and
All Lugged Valves

On these valves, the seat is held in place with a retaining ring. See Figure 1.

- a) Using a hacksaw, cut thru the seat in the bearing area.
- b) Pry one end of the seat into the valve opening until it is free of the retaining ring, then pull the seat out of the valve.

10. Heat the bearing areas to break the Loctite seals, then slide the bearings out of the valve body.
11. Apply Loctite 222 to the outside diameters of the replacement bearings. See the Loctite container for proper application of the adhesive.

7. Screw the shaft into the yoke nut, placing a stop nut on each side of the yoke nut.
8. Install the thrust plate and secure it with four screws.
9. Install the guide rail(s) and secure in place.
10. Install the operator on the shaft and install the pin or key to retain it.
11. Perform the Open and Closed Position Stop Adjustments as described in the appropriate Section of this Instruction.
12. Apply a layer of grease approximately 1/2" thick to the appropriate surfaces described in the LUBRICATION Section of this Instruction.
13. If your actuator has a window in the cover, locate the pointer so it indicates valve position.
14. Install the cover gasket (used with cast iron covers only), then fasten the cover in place.

ACTUATOR DISASSEMBLY To properly disassemble this actuator, follow the Steps in the ACTUATOR REMOVAL Section of this Instruction.

ACTUATOR REASSEMBLY To properly assemble this actuator, follow the Steps in the ACTUATOR INSTALLATION Section of this Instruction.

CHANGING ACTUATOR MOUNTING POSITIONS The actuator may be mounted in 90 degree increments around the valve shaft. To change actuator mounting positions, remove the actuator from the valve, position it in the desired position, then reinstall it on the valve. Detailed removal and installation procedures are described in this manual.

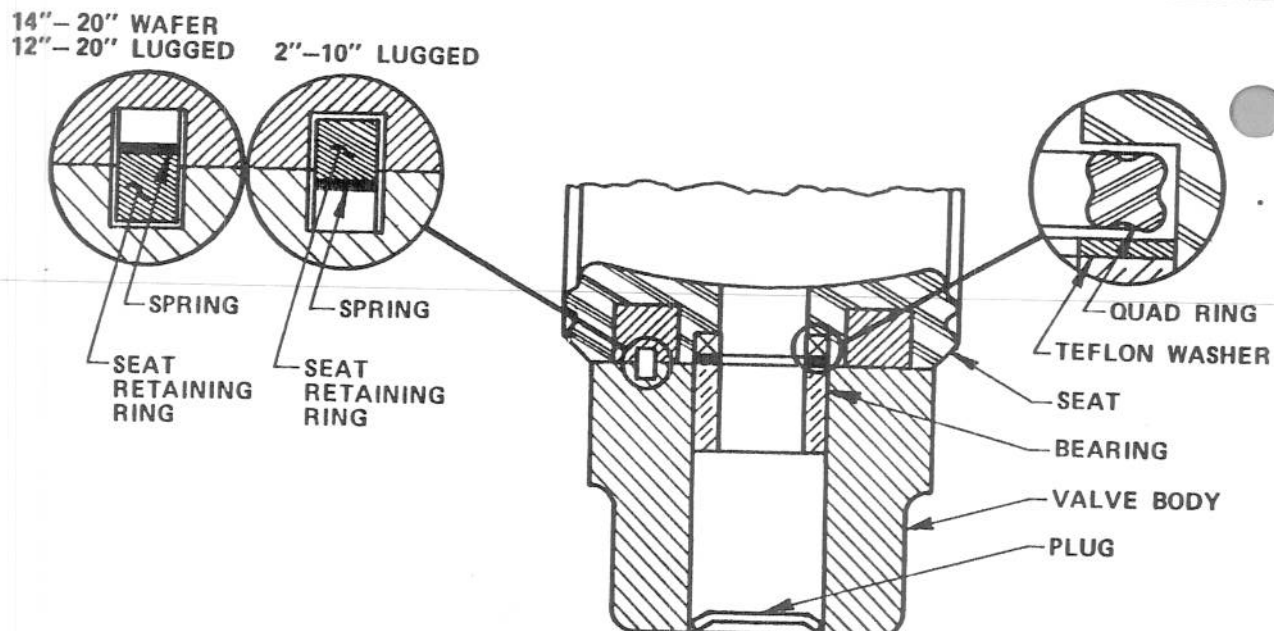


FIG 632 COMPONENT LOCATION
FIGURE 1

12. Insert the replacement bearings into the bores. The two bearings in the seat area should be flush with the seat bore in the valve body; the upper bearing in the valve body neck should be pushed into the valve body just far enough so a quad ring seal can be completely pushed into the bore after the bearing.

NOTE: All three bearings are identical.

13. Lubricate the seal grooves in the seat, the quad ring seals and the inside diameters of the bearings with the lubricant described in the MAINTENANCE section of this instruction.
14. Slide the quad ring seals into the seal grooves in the seat.
15. Place a PTFE back-up ring over the quad ring seals.
16. Place the spring and seat retaining ring in the seat as follows:

- | | |
|---|--|
| 2" thru 12" Wafer Valves | These sizes do not use springs and seat retaining rings. |
| 2" thru 10" Lugged Valves | Place a spring, then a seat retaining ring in the groove in each side of the body; center the spring and retaining ring in the groove. |
| 14" thru 20" Wafer and 12" thru 20" Lugged Valves | Place the spring, then the seat retaining ring in the groove in the outside diameter of the seat. |
17. Slide the seat into the body. Position the seat so the word TOP (molded in the rubber seat) is toward the top of the valve; see Figure 2. On valves utilizing springs and seat retaining rings, you will hear the retaining rings snap into the groove.

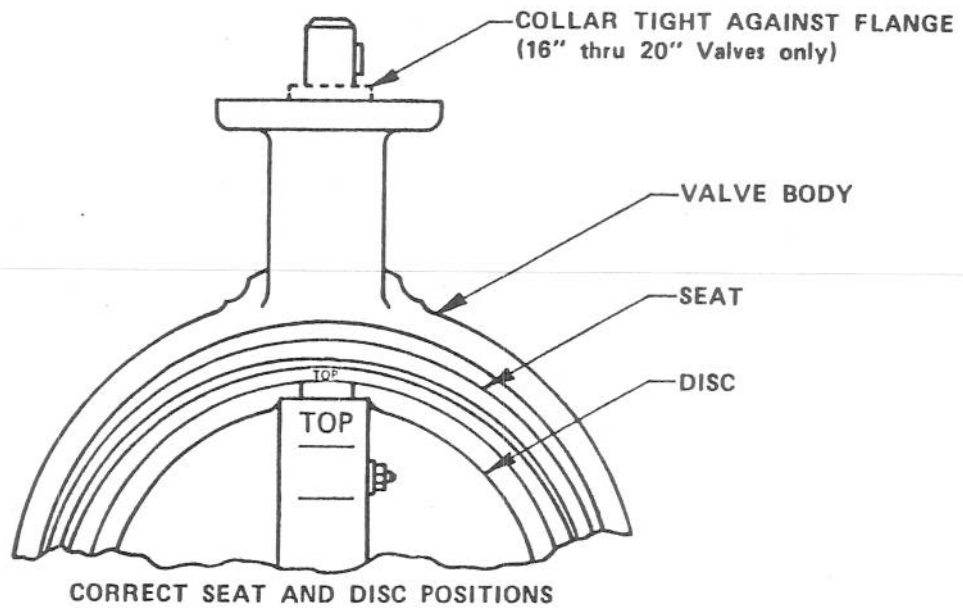


FIGURE 2

18. Position the disc so the word TOP (stamped in the disc) lines up with the word TOP (molded in the rubber seat), then lower the disc into place in valve body.
19. Prepare the shaft for installation by lightly greasing the bottom chamfer and the flat spots for the pins with a flow media compatible lubricant.
20. Slide the shaft into place with a rotary motion to prevent damage to the valve seals.
21. Line up the flat spots or holes in the shaft with the holes in the disc.
22. Insert the disc pin(s) into the holes. Pins with threaded ends must be installed with the threads to the right (see Figure 2). Lightly tap the pins to seat them before tightening the nuts to the torques shown in Table B.
23. Slide the new upper quad ring seal down the valve shaft until it contacts the upper bearing.

VALVE SIZE	TORQUE (ft. lbs.)
4	2
5 thru 8	6
10 thru 14	11
16 thru 18	20
20	31

DISC PIN NUT TORQUE
TABLE B

24. Install the plug in the bottom of the valve body.
25. Install the actuator. See the Actuator Instruction Manual for the correct procedure.
26. Check the actuator Open and Closed Position Stop adjustments and readjust if necessary.

27. With the valve in the closed position, install it in the pipeline as described in the INSTALLATION section.

NOTE: If the valve is to be stored, it must be left in the partially open position.

28. Pipeline flow and pressure can now be restored.

**VALVE REMOVAL
FROM PIPELINE**

To remove the entire valve assembly from the pipeline, follow these steps carefully.

1. Relieve pipeline pressure and drain the portion of the system where the valve is located.
2. Close the valve.
3. Turn off the supply air and/or electricity if the valve has a powered actuator, then disconnect the piping and/or wiring from the valve assembly.
4. Support the valve assembly, then remove the flange bolts.
5. Remove the valve from the pipeline.

GUARANTEE: Products, auxiliaries and parts thereof, of DeZURIK's manufacture, are guaranteed for a period of one year from date of shipment against defective workmanship and material only, when properly installed, operated and serviced in accordance with DeZURIK's recommendations. Replacement for items of DeZURIK's manufacture will be made free of charge if proved to be defective within such time. No claim for transportation, labor or special or consequential damages shall be allowed. Purchaser shall be solely responsible for determining suitability for use and in no event shall DeZURIK be liable in this respect. Equipment or parts manufactured by others but furnished by DeZURIK will be repaired or replaced, but only to the extent provided in the original manufacturer's warranty to DeZURIK. DeZURIK does not guarantee resistance to corrosion, erosion, abrasion or other sources of failure, nor does DeZURIK guarantee a minimum length of service. Failure of purchaser to give prompt written notice of any alleged defect under this guarantee forthwith upon its discovery, or use and possession thereof after an attempt has been made and completed by someone other than DeZURIK or an authorized representative to remedy the defects therein, or failure to return product or parts for replacement as herein provided, or failure to install and operate said products and parts according to instructions furnished by DeZURIK, or failure to pay entire contract price when due, shall be a waiver by purchaser of all rights under these representations. The foregoing guarantee shall be null and void if, after shipment from our factory, the item is modified in any way or a component of another manufacturer, such as, but not limited to, an actuator, is attached to the item by anyone other than DeZURIK Factory Service personnel. All orders accepted shall be deemed accepted subject to this guarantee, which shall be exclusive of any other or previous guarantee, and this shall be the only effective guarantee or warranty binding on DeZURIK, anything to the contrary contained in the purchase order or represented by any agent or employee of DeZURIK, in writing or otherwise, notwithstanding, including but not limited to implied warranties.

THE FOREGOING OBLIGATIONS ARE IN LIEU OF ALL OTHER OBLIGATIONS AND LIABILITIES INCLUDING ALL WARRANTIES OF FITNESS OR OF MERCHANTABILITY OR OTHERWISE, EXPRESSED OR IMPLIED IN FACT OR BY LAW, AND STATE DeZURIK's ENTIRE AND EXCLUSIVE LIABILITY AND PURCHASER'S EXCLUSIVE REMEDY FOR ANY CLAIM IN CONNECTION WITH THE SALE OR FURNISHING OF SERVICES, GOODS OR PARTS, THEIR DESIGN, SUITABILITY FOR USE, INSTALLATION OR OPERATIONS.

LIMITATION OF LIABILITY: IN NO EVENT SHALL DeZURIK BE LIABLE FOR ANY DIRECT, INDIRECT, SPECIAL OR CONSEQUENTIAL DAMAGES WHATSOEVER, AND DeZURIK's LIABILITY, UNDER NO CIRCUMSTANCES, WILL EXCEED THE CONTRACT PRICE FOR THE GOODS AND/OR FOR WHICH LIABILITY IS CLAIMED. ANY ACTION FOR BREACH OF CONTRACT MUST BE COMMENCED WITHIN 1 YEAR AFTER THE CAUSE OF ACTION HAS ACCRUED.

PRODUCTS

Eccentric Plug Valves - Sizes 0.5" through 72" in a wide choice of materials and resilient plug facings.

HP Butterfly Valves - Sizes 2" through 48" for applications to 740 psi plus fire tested and metal seated models.

V-Port Ball Valves - Sizes 1" through 20", pressures to 740 psi and temperature ratings to 1000°F.

Resilient Seated Butterfly Valves - Sizes 2" through 36" in two styles with 150, 175 and 225 psi pressure ratings and wafer and lugged body styles.

AWWA Butterfly Valves - Sizes 4" through 120". Meets AWWA C504 standards.

3 & 4 Way Plug Valves - Sizes 3" through 16" for shutoff and switching applications plus a variety of body materials.

Precision Electric Control Valves - Unmatched control accuracy provides 2000 discrete repeatable throttling positions in 90° plug rotation. Accepts analog or digital signals. Sizes 4" through 20".

Permaseal® Plug Valves - Sizes 0.5" through 6" in ANSI Class 150 and 300 ratings. Body styles include 2-Way, 3-Way, jacketed, double block and bleed and flush through for corrosive and high temperature applications.

Knife Gate Valves - Rugged design for corrosive and abrasive service on liquids, slurries and dry materials. Pressures to 150 psi and sizes 2" through 72".

Consistency Transmitters - Light sensor, rotating sensor, blade sensor, open type and pan type for pulp and paper consistency control applications.

Cage Guided Control Valves - Sizes 1" through 8", ratings to ANSI 2500 plus balanced construction and noise reducing trim.

Cage Retained Globe Valves - Sizes 0.5" - 3", top entry, double stem guided, and no threaded internal parts for corrosive services.

Top & Bottom Guided Globe Control Valves - Sizes 0.5" through 20", single or double seated designs, pressures to ANSI 2500 and balanced construction.

3-Way Globe Control Valves - Sizes 0.5" through 12" for mixing and diverting service.

Split Body Globe Control Valves - Sizes 0.5" through 4", ratings to ANSI 600, temperatures to +800°F and easily replaceable seat and trim.

K-Max™ Rotary Control Valves - Sizes 1" - 8", ratings to ANSI 600, flanged or flangeless bodies and bi-directional shutoff.

Synflo™ Valves - Available in 316 or 347 stainless steel construction with tungsten carbide trim for high temperature/pressure applications in synthetic fuel processing.

SALES AND SERVICE

DeZurik representatives are located in major cities throughout the world. For the name of the representative nearest you, phone or write:

DeZURIK

250 Riverside Ave.
Sartell, MN 56377
Phone 612/259-2000
Telex 29-0505
Fax 612-259-2227

DeZURIK SERVICE CENTER

5927 South Loop East
Houston, TX 77033
Phone 713/643-3107
Fax 713-643-8086

DeZURIK SERVICE CENTER

600 Kirk Road N.W.
Suite B
Marietta, GA 30060
Phone 404/425-6493
Fax 404-425-6545

DeZURIK OF CANADA, LTD.

P.O. Box 1300
Cambridge, Ontario N1R 5V5
Canada
Phone 519/621-8980
Telex 0695-9328
Fax 716-856-2841

DeZURIK OF AUSTRALIA PTY. LTD.

P.O. Box 204
Sunbury, Victoria 3429
Australia
Phone 61-3-744-2244
Telex AA33732 DeZIK
Fax 61-3-744-4533

DeZURIK INTERNATIONAL

Nelson Way
Nelson Industrial Estates
Cramlington
Northumberland NE23 9BJ
England
Phone: 44-670-714111
Telex: 537198 DZURIK G
Fax: 0670-737813

DeZURIK JAPAN, LTD.

1-11, Ueno 6-Chome
Taiko-ku, Tokyo 110
Japan
Phone 81-3-8363918
Telex 22153
Cable Valve Tokyo
Fax 81-3-8363929

DeZURIK INDIA, LTD.

Plot 73 Industrial Estate
Perungudi
Madras 600096
India
Phone 91-44-411449/419223
Telex 41-21090 URIK IN

DeZURIK
A UNIT OF GENERAL SIGNAL




DeZURIK reserves the right to incorporate our latest design and material changes without notice or obligation. Design features, materials of construction and dimensional data, as described in this bulletin, are provided for your information only and should not be relied upon unless confirmed in writing by DeZURIK. Certified drawings are available upon request.

DESCRIPTION

The DeZurik manually operated T-Series actuator is an economical operator capable of providing a long lasting, dependable means of valve operation. The T-Series actuator is available in three sizes: The Size 3, Size 5 and Size 7. The actuator has been sized to achieve optimum performance from your valve.

Figure 1 provides the information needed to identify your actuator.

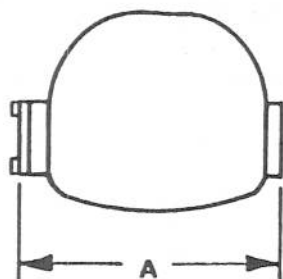

ACTUATOR SIZE	DIMENSION "A"
SIZE 3	9 1/2"
SIZE 5	12"
SIZE 7	15 1/8"

ACTUATOR IDENTIFICATION

FIGURE 1

ACTUATION

Clockwise rotation of the valve operator (handwheel, chainwheel, crank or nut) will move the valve in the closed direction. Counterclockwise rotation will open the valve. To actuate the valve from fully open to fully closed (or vice-versa), the Size 3 requires 9 revolutions, the Size 5 requires 15 revolutions and the Size 7 requires 24 revolutions.

LUBRICATION

The T-Series actuator does not require lubrication as regular maintenance. If this actuator is disassembled, lubricate the following components during reassembly with a light grease such as Keystone Zeniplex 1 **except** if the actuator is mounted on a DeZurik Metal Seated HP Butterfly valve. If the actuator is mounted on a DeZurik Metal Seated HP Butterfly valve, lubricate the parts with a high temperature grease such as Chemplex 710/GR. See the Assembly drawing for parts identification.

- The bearing at each end of the shaft.
- The shaft collar counterbore.
- The inside of the thrust plate where it contacts the thrust bearing.
- The threads on the shaft.
- The stop nuts.
- The slots in the yoke.
- The sides of the yoke bearings.
- The side of the guide rail.

After the actuator is fully assembled, a layer of grease approximately 1/2" thick should be applied to the surfaces described above which are accessible and inside the housing.

OPEN AND CLOSED POSITION STOP ADJUSTMENTS


1. Cycle the valve to determine the need for stop adjustment.
2. Remove the actuator cover.

3. Guide Rails

Sizes 3 and 5 — **Loosen** the guide rail screw closest to the cylinder, and **remove** the other screw.

Size 7 — **Loosen** the two Guide Rail "B" screws as shown in Figure 2.

4. Move the valve to midstroke, then turn the appropriate stop nut(s) to achieve the desired stop settings. The stop nut closest to the operator end is the closed position adjustment.
5. Actuate the valve to check the adjustments. Readjust if necessary.
6. Tighten the guide rail screws.
7. Install the cover gasket (when used) and cover.

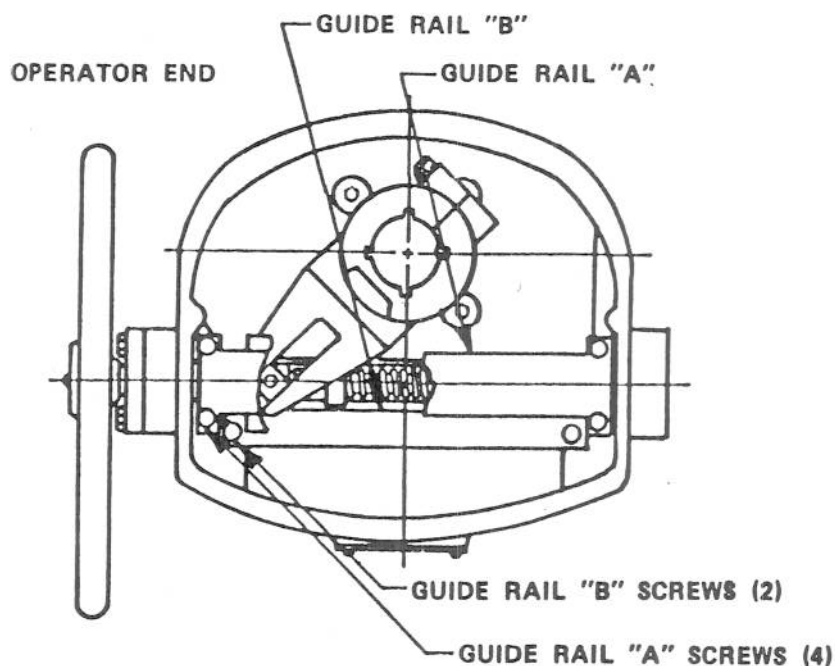

GUIDE RAIL IDENTIFICATION (SIZE 7 ACTUATORS ONLY)

FIGURE 2

**ACTUATOR
REMOVAL**

1. Discontinue pipeline flow.
2. Place the valve in the closed position.
3. Remove the cover screws and cover.
4. Loosen the screw clamping the yoke onto the valve shaft.

5. Remove the valve operator (handwheel, chainwheel, etc.) as follows:
 - *Chainwheel — Remove the pin, then pull the chainwheel off the shaft.
 - *All other operators — Straighten the key, then pull the operator off the shaft.
6. Remove the four thrust plate screws, then separate the thrust plate from the housing.
7. Remove the shaft from the housing by turning it until it is completely backed out. Retrieve the two stop nuts from inside the actuator housing.
8. Guide Rails
 - Sizes 3 and 5 — Remove the two guide rail screws.
 - Size 7 — Remove the four guide rail "A" screws (see Figure 2).
9. Remove the guide rail.
10. Remove the yoke from the actuator. Do not lose the yoke nut or the two bearings.
11. Remove the four screws (inside the actuator) securing the actuator to the bracket, then separate the actuator from the bracket.

ACTUATOR INSTALLATION

1. Close the valve.
2. Set the actuator on the valve. If the actuator has a cast iron cover, apply a thin layer of Permatex to the machined surface on the bottom of the actuator housing.
3. Apply a hand tool removable fastening agent such as Loctite 242 to the mounting screws, then fasten the actuator to the valve with these screws. Tighten the screws to the torque specified in Table A.

BOLT SIZE	BOLT TORQUE
1/4-20	75-100 inch lbs (6-8 foot lbs)
3/8-16	205-350 inch lbs (18-30 foot lbs)
1/2-13	625-850 inch lbs (50-70 foot lbs)
3/4-10	1600-2100 inch lbs (135-175 foot lbs)

T-SERIES MOUNTING SCREW TORQUES
TABLE A

4. Lubricate the actuator components as described in the LUBRICATION Section of this Instruction.
5. Install the yoke, yoke nut bearings and yoke nut. Position the yoke so it points toward the operator end of the actuator as shown in Figure 2.
6. Tighten the screw to clamp the yoke onto the valve shaft.

7. Screw the shaft into the yoke nut, placing a stop nut on each side of the yoke nut.
8. Install the thrust plate and secure it with four screws.
9. Install the guide rail(s) and secure in place.
10. Install the operator on the shaft and install the pin or key to retain it.
11. Perform the Open and Closed Position Stop Adjustments as described in the appropriate Section of this Instruction.
12. Apply a layer of grease approximately 1/2" thick to the appropriate surfaces described in the LUBRICATION Section of this Instruction.
13. If your actuator has a window in the cover, locate the pointer so it indicates valve position.
14. Install the cover gasket (used with cast iron covers only), then fasten the cover in place.

**ACTUATOR
DISASSEMBLY** To properly disassemble this actuator, follow the Steps in the ACTUATOR REMOVAL Section of this Instruction.

**ACTUATOR
REASSEMBLY** To properly assemble this actuator, follow the Steps in the ACTUATOR INSTALLATION Section of this Instruction.

**CHANGING
ACTUATOR
MOUNTING
POSITIONS** The actuator may be mounted in 90 degree increments around the valve shaft. To change actuator mounting positions, remove the actuator from the valve, position it in the desired position, then reinstall it on the valve. Detailed removal and installation procedures are described in this manual.

DeZURIK RECOMMENDED SHORT AND LONG-TERM STORAGE PROCEDURES

LONG TERM STORAGE

1. All resilient seated valves shall be stored in the open (unseated) position.
2. All valves with adjustable packing glands should have the packing gland loosened prior to storage.
3. Valves shall be separately packaged in a sealed polyethylene plastic enclosure with a minimum of one package of desiccant inside, dependent upon valve size.
4. Prepared valves shall be warehoused in a clean, dry, indoor facility on concrete or raised racks, with temperature ranging from + 35°F to + 95°F.
5. Valves shall not be stored near electric motors or other equipment which may emit Ozone which can cause deterioration of elastomers used for valve and actuator components.
6. The valves shall be inspected periodically to replace the desiccant if required, and to repair any damage to the polyethylene plastic enclosures.
7. Valves with cylinder operators and control valves which are stored for extended periods may be subject to cylinder blow-by caused by permanent distortion of any of the seals. Valves should be operated prior to installation and damaged seals replaced.
8. Valves with electric motor operators shall be stored in accordance with the individual motor manufacturer's recommended long-term storage procedures in addition to Paragraphs 1, 2 and 3 above.
9. All electrical components, if applicable, should be inspected and all electrical contacts cleaned before operation.
10. Valves shall be enclosed in fully sheathed wooden crates or boxes.

SHORT TERM STORAGE

1. Valve should be protected from the weather, avoid exposure to excessive moisture or dirt. Store at temperatures ranging from + 35°F to + 95°F.

五

CUSTOMER PURCHASE ORDER NUMBER
3904

ENTRY DATE	SHIP DATE
JUN 09/91	91-07

SHIPPER'S NUMBER 03-347799
CARRIER'S NUMBER 03-347799

-608395-

PAGE NO.

ALL ORDER

UNIVERSAL INDUSTRIES
PO BOX 1590
LLOYDMINSTER ALBERTA
S9V 1K5

SHIP TO CUSTOMER NAME AND ADDRESS

UNIVERSAL INDUSTRIES LIMITED
UNIVERSAL STREET
5208-51ST STREET
LLOYDMINSTER ALBERTA

MILL TEST REPORTS
THE ALGOMA STEEL CORPORATION
LIMITED HEREBY CERTIFIES THAT THE
MATERIAL HEREIN DESCRIBED WAS
MADE AND TESTED IN ACCORDANCE
WITH THE RULES OF THE SPECIFICATION
SHOWN HEREIN AND A
CONTAINED IN THE CORPORATION RECORDS.

G. MONIN
SENIOR METALLURGI

CUSTOMER SPECIFICATION
HR PLATE - CARBON - CSA STD G40.21 44W (1987) - SHEARED

SUPPLEMENTARY INSTRUCTIONS

FAX S/M TO 403-875-6169 ATTN B MILKE

NSP T/R MILL SM/TR

CUSTOMER USE TANKS

CUSTOMER ITEM	6	OUR ITEM 006	DIMENSIONS .250 X .96 X .384
---------------	---	--------------	------------------------------

TAG	HEAT	PIECES	WEIGHT
788104A	4602K	5	7840
788107A	4602K	3	5227
788108B	4602K	3	7840
788110B	4602K	3	5227
788112B	4602K	3	7840
788115A	4602K	3	5227
788116	4602K	3	7840
788124	4602K	3	5227
788934	4602K	3	7840
788936	4602K	3	5227

TAG NUMBER	HEAT	NO. OF PIECES	AL	PROPERTIES	* % ELONG
788105B	4602K	5			2.54
788108A	4602K	5			2.24
788109	4602K	5			
788111A	4602K	5			
788114	4602K	5			
788115B	4602K	5			
788117	4602K	5			
788925	4602K	5			
788935	4602K	5			
788937	4602K	5			

WEIGHT
784
7261
7261
784
784
522
784
522
784
784
522
522

[illegible]

CONTINUED ON NEXT



TEST CERTIFICATE - REDUCE SMALL

6 STA 036

 $\frac{1}{2}$

CUSTOMER **VESTON INDUSTRIAL SUPPLY**













FORM 114 - 11-68

96836
L 100

OPROBE - ORDER - COMMAND
75115/MO

100

:51

15:49 WESTLOND EDM 462-0392

[illegible]

11

1

1







INSPECTION CERTIFICATE

BENKAN

Date: Feb. 8, 1997

Specification
for Material:

ASTM A234 GR. WPB

Specification

MADE FROM SEAMLESS PIPE
NACE MR0175 - 90

Certificate No.

T-206015

for Inspection: ANSI B31.3 B16.28
DIN 50049 3.18

BENKAN No.	MFG No.	Product & Size (T:*1)		Quantity	Visual & Dimen- sional Inspection	HEAT TREATMENT (NOTE 1)	HARDNESS ACTUAL DATA							
06-1A-160	10039	90ES	WPB 4 STD	100	GOOD	A	HB : 115 - 145							
06-1A-161	1A035	90ES	WPB 6 STD	60	GOOD	A	HB : 115 - 145							
06-1A-162	1B030	90ES	WPB 8 STD	60	GOOD	A	HB : 115 - 145							
06-1A-163	1A036	90ES	WPB 10 STD	7/20	GOOD	A	HB : 120 - 150							
06-1A-163	21031	90ES	WPB 10 STD	13/20	GOOD	A	HB : 120 - 150							
Specification														
Min.	Chemical Composition %										Tension Test #2		HARDNESS MAX	
	C	Si	Mn	P	S	Cu	Ni	Cr	Mo	V	YS	TS		E
Max.	X 100	X 100	X 100	X 1000	X 1000	X 100	X 100	X 100	X 100	X 100	P.S.I		%	
		10	29								35,000	60,000	30	
Heat No.	30		106	50	58									Material Manufacturer
36715	20	23	67	16	3	3	2	4	TR	TR	42,300	72,100	57	NKK CORPORATION
38978	18	17	43	11	9	1	2	2	TR	TR	46,900	68,900	45	NKK CORPORATION
35110	18	17	46	12	9	1	2	3	1	TR	49,700	66,500	44	NKK CORPORATION
05490	20	19	48	8	10	1	3	3	TR	TR	49,200	70,600	40	NKK CORPORATION
05491	19	19	46	17	5	1	3	3	TR	TR	53,700	70,500	36	NKK CORPORATION

A : HOT FORMED WITH FINAL
TENSILE STRENGTH BETWEEN 780-820 MPa

N : NORMALIZING 810-830 °C

A : HOT FORMED WITH FINAL

URE BETWEEN 780°C & 980°C. AIR COOLING

RELIEVING 660°C x 0.5 HR. AIR COOLING

N : NORMALIZING 910°C x 0.5 HR.
AIR COOLING
"CSA 2245 - 10"

hereby certify that the product described herein has been manufactured in accordance with the specifications concerned also with the purchaser's requirements and that the test results shown herein are correct.

embossed wall thickness in mm 0.7 - Vg Yield strength TS - Tensile strength F - Flange

T. Sank

Manager of Quality Assurance Section

Thai Benkan Co., Ltd.

58 Soi Watrunai, Bangkok, Prapadaeng.

need 1 copy

j P.6 913-5400

WESTLUND

INDUSTRIAL SUPPLY LTD.

3691 - 90 STREET
EDMONTON, ALBERTA
T6E 5N2
TELEPHONE 463-7473
TELEX 037-2967

TO:

ATTENTION:

REF:

This is to certify that the Hattersley 1" 1969 ball valve
you purchased from us June 23 1992 is manufactured to
C.I.A. : U1 Approved and meets all chemical, yield
and strength requirements of the above mentioned standard.

Regards,

WESTLUND INDUSTRIAL SUPPLY LTD.



Product manager: UAWES.

GENERAL NOTES

DESIGN DATA

DESIGN CODE: AFWA 0100 & API 650
DESIGN PRESSURE/VAC: ATM
DESIGN TEMPERATURE: N/A
DESIGN SPECIFIC GRAVITY: 1.0
SEISMIC ZONE: N/A
DESIGN WIND LOAD: 180 kPa (100 mph)
DESIGN LIVE ROOF LOAD: 36.79 kPa
CORROSION ALLOWANCE: 20mm (1 1/8")
MAXIMUM FILLING HEIGHT: 8925 (29'-3 3/8")

MATERIAL SPECIFICATIONS

ROOF: A-36 COUPLERS: A-105
SHELL: A-36 FITTINGS: A-234-WP
FLOOR: A-36 STUD BOLTS: A-325
STRUCTURAL: 240-21-447 HEX NUTS: SA-194-2H
PIPE: A-53-B GALVANIZED GASKETS: BUTYL RUBBER
FLANGES: A181-051 HEAT COIL: N/A

EXTERNAL FINISH

INTERNAL FINISH

TESTING


INSULATION

NOZZLE SCHEDULE


MK	NO	SIZE	SCH	RATE	TYPE	EXT. PROJ.	REPAD		DESCRIPTION
							YES	NO	
M1	1	168	STD	ANSI 150	FFSO	200	✓		SUCTION/FILL
M2	1	80	STD	ANSI 150	FFSO	200	✓		RETURN
M3	1	168	STD	ANSI 150	FFSO	200	✓		SUCTION/FILL
M4	1	168	STD	ANSI 150	FFSO	200	✓		VENT/OVERFLOW C/W BIRD SCREEN
M5	1	80	STD	ANSI 150	FFSO	200	✓		LEVEL SWITCH C/W BLIND FLANGE
C1	1	25	1"	3000#	FULL C/L	1/2"	✓		AIR LINE (FUTURE) C/W BALL VALVE & PLUG
M1	1	810	2"	API 650	FRST	150	✓		SHELL MANWAY
M2	1	810	2"	API 650	FRST	150	✓		ROOF MANWAY

MATERIAL LIST

MK	QTY.	DESCRIPTION	REFERENCE	WT
A		ROOF PLATE 3/16" THK	A-36	
B		SHELL PLATE 3/16" THK	A-36	
C		FLOOR PLATE 5/16" THK	A-36	
D	1	RUNAROUND ANGLE 2" x 2" x 3/16" x 92'-6" LG	040.21-44W	
E	10	ROOF CHIMNEL C/W 5.4"	REF. DWG.	
F	1	COMPRESSION RING	T-5400-D101	
G	1	CENTER POLE SUPPORT	REF. DWG.	
H				
I	1 SET	NOZZLE SPOOL	REF. DWG.	
J	1	ANCHOR BOLTS	REF. DWG.	
K	1	ROOF PLATFORM	REF. DWG.	
L	1	LADDER C/W GAGE	REF. DWG.	
M	5	ISOLATION RINGS	T-5400-D101	
N	1	PAINTER'S POST	REF. DWG.	
O	1	SHELL MANWAY	REF. DWG.	
P	1	ROOF MANWAY	REF. DWG.	
Q	1	ISOLATION VALVE ENCLOSURE	REF. DWG.	
R	1	EMERGENCY CONNECTION ENCLOSURE	REF. DWG.	
S	1	LEVEL SWITCH	REF. DWG.	
T				
U				
V				
W				
X				
Y				
Z				
AA				
BB				
CC				
DD				
EE				
FF				
GG				
HH				
II				
JJ				
KK				
LL				
MM				
NN				

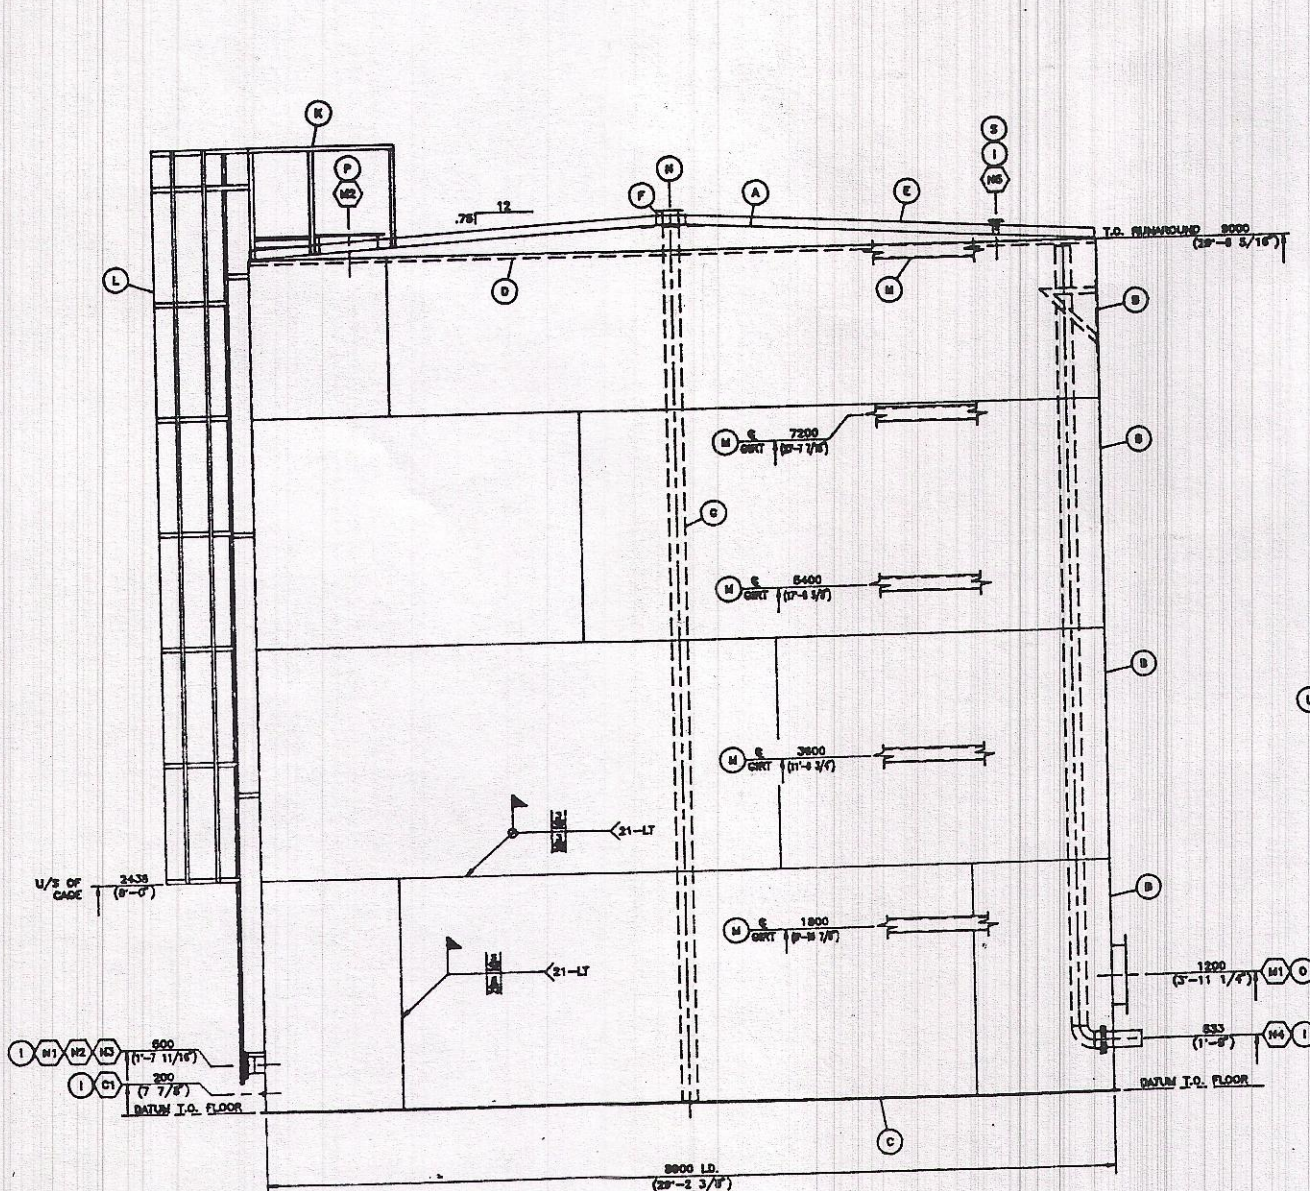


ELEVATION

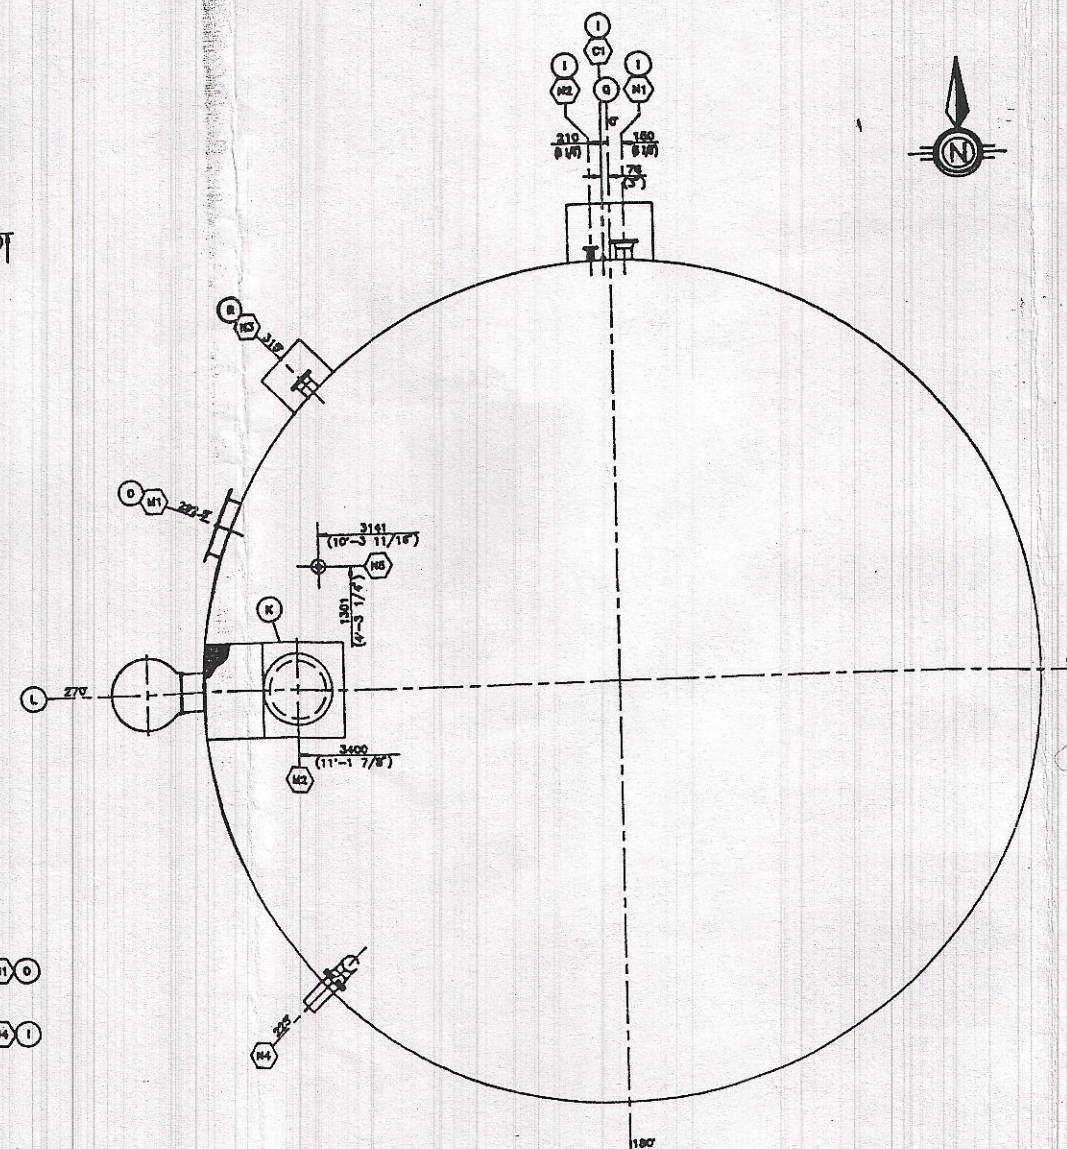

ORIENTATION

NOTES

1. ALL DIMENSIONS ARE IN MILLIMETERS. DIMENSIONS IN BRACKETS ARE FOR REFERENCE ONLY.
2. ALL NOZZLE FLANGE RATINGS TO BE ANSI B16.5-1988
3. ALL NOZZLE PROJECTIONS ARE GIVEN ALONG CENTERLINES.
4. DRILL AND TAP 6mm(1/4") DIA. TELL TALE HOLES IN REINFORCING PADS.
5. FLANGE AND BOLT HOLES TO STRADDLE PRINCIPLE CENTERLINES OF TANK.

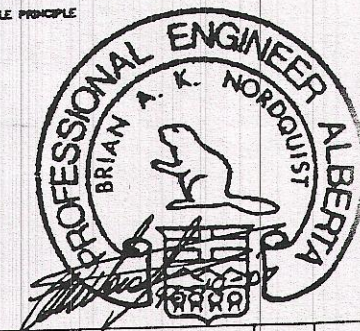

NO	DATE	REVISIONS	BY	APP
1	16/08/91	AS-BUILT		TBA
2	30/08/91	ISSUED FOR CONSTRUCTION		LLC
3	22/11/91	ISSUED FOR APPROVAL		CLS

UNIVERSAL INDUSTRIES LTD.


P.O. BOX 1590
LLOYDMINSTER, ALTA./SASK. S9V 1K5

CAPE DORSET
NORTHWEST TERRITORIES


WATER STORAGE TANK
8900mm(29'-2 3/8") I.D. x 9000mm(29'-6 5/16") HIGH
GENERAL ARRANGMENT

SCALE: 1:40	DATE: 14/11/91	BY: C. GRESNER	APP: [Signature]	REV. NO. 1
-------------	----------------	----------------	------------------	------------


T-5400-D101

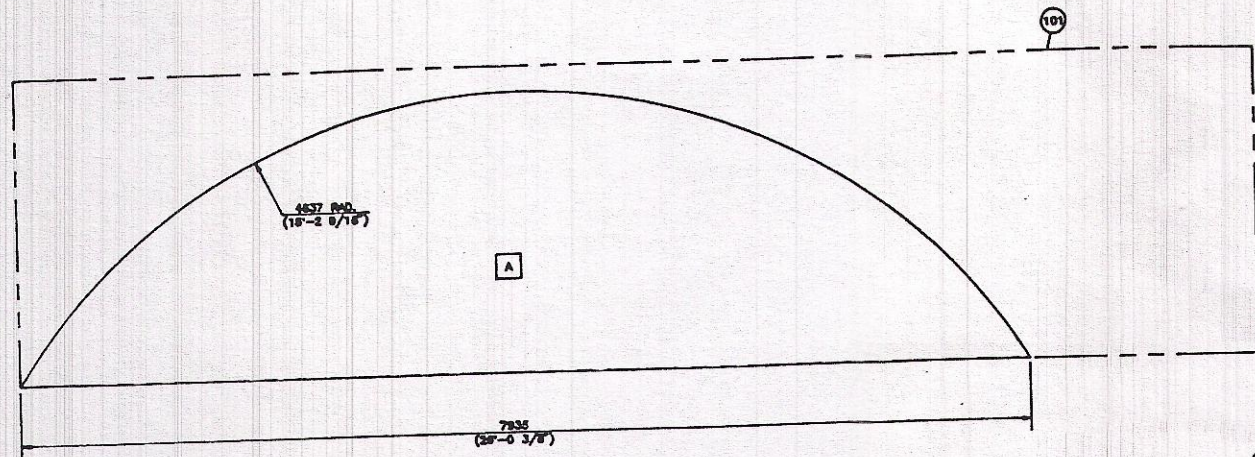


(101) SHEET LAYOUT
(8'-0" x 32'-0")
(2 REVD)

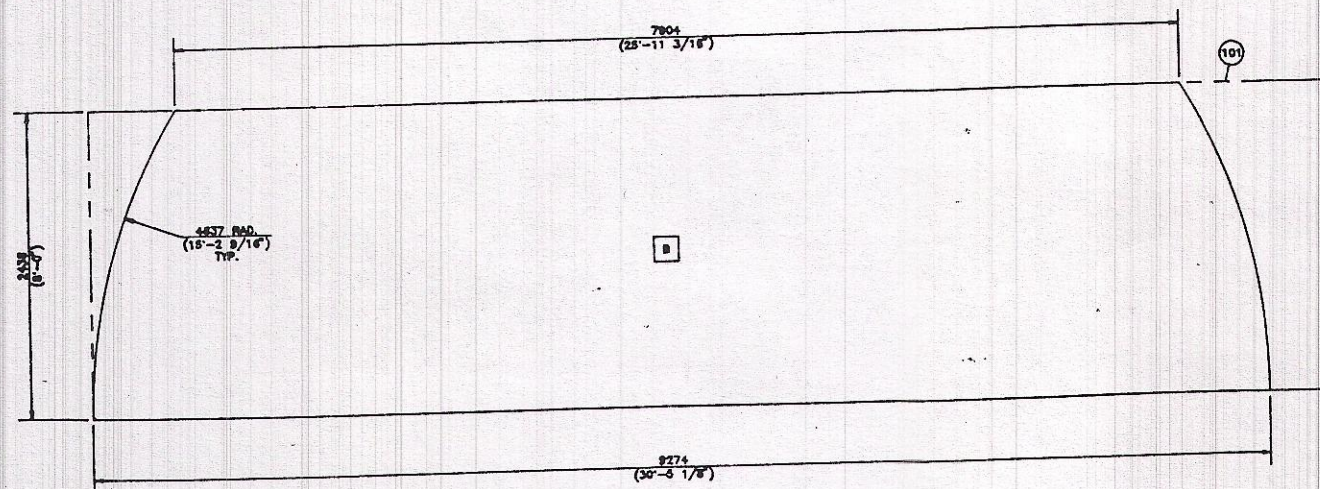


(101) SHEET LAYOUT
(8'-0" x 32'-0")
(2 REVD)

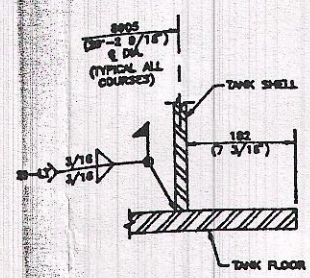

SHELL TO FLOOR CONNECTION DETAIL
SCALE: N.T.S.

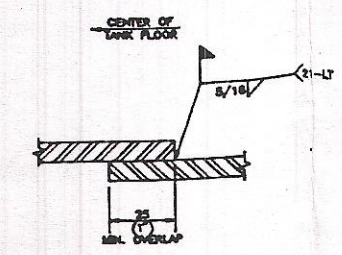

SECTION "A-A"
SCALE: N.T.S.

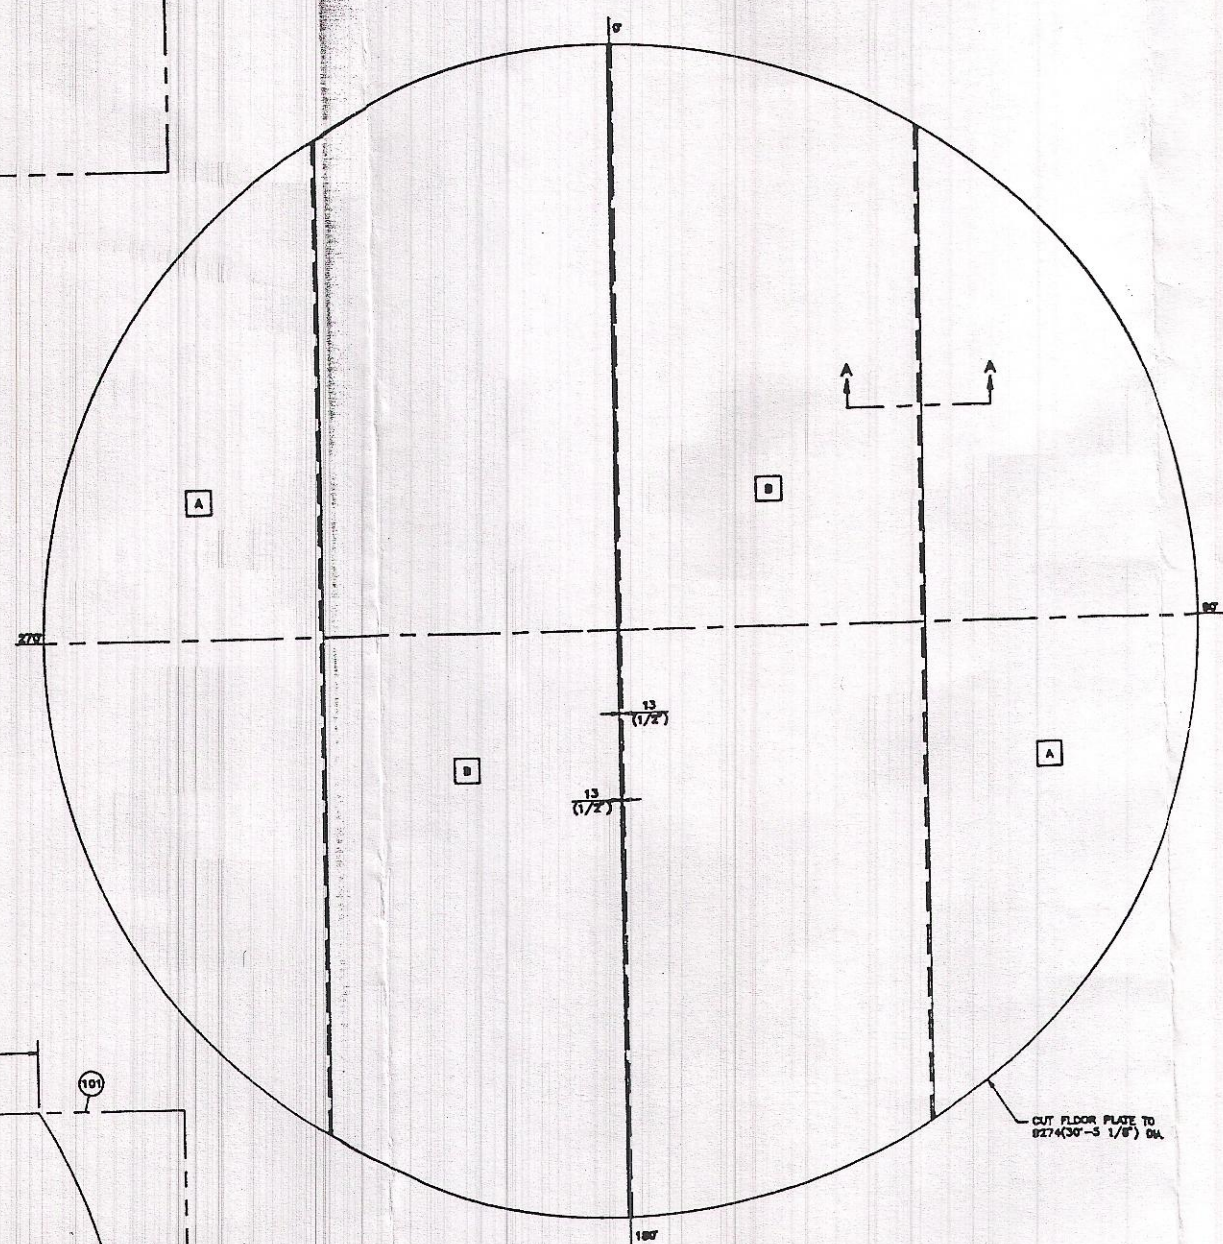


FLOOR PLATE LAYOUT

CUT FLOOR PLATE TO

MATERIAL LIST

MK	QTY.	DESCRIPTION	MATERIAL	WT.
101	4	PLATE 5/16" THK x 8'-0" x 32'-0" LB.	A-36	13000
			SUBTOTAL	13000
			x 1.05	
			TOTAL	13650

NOTES:
1. DIMENSIONS ARE IN MILLIMETERS. DIMENSIONS IN BRACKETS ARE FOR REFERENCE ONLY.

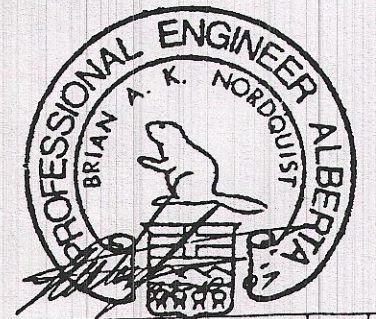

NO	DATE	REVISIONS	BY	APP
1	15/08/92	AS-BUILT		TBR
2	30/06/92	ISSUED FOR CONSTRUCTION		LLC
3	10/01/92	ISSUED FOR APPROVAL		CLB


UNIVERSAL INDUSTRIES LTD.
P.O. BOX 1590
LLOYDMINSTER, ALTA./SASK. S9V 1K5

CLIENT: CAPE DORSET
NORTHWEST TERRITORIES


PROJECT: WATER STORAGE TANK
8900mm(29'-2 3/8") I.D. x 9000mm(29'-6 5/16") HIGH
FLOOR PLATE LAYOUT

SCALE: 1:30	DES. BY: C. GROSSER	CHK. BY: APP	DATE: 18/11/91	REV. NO. 1
-------------	---------------------	--------------	----------------	------------


T-5400-D102 SHT 1/2

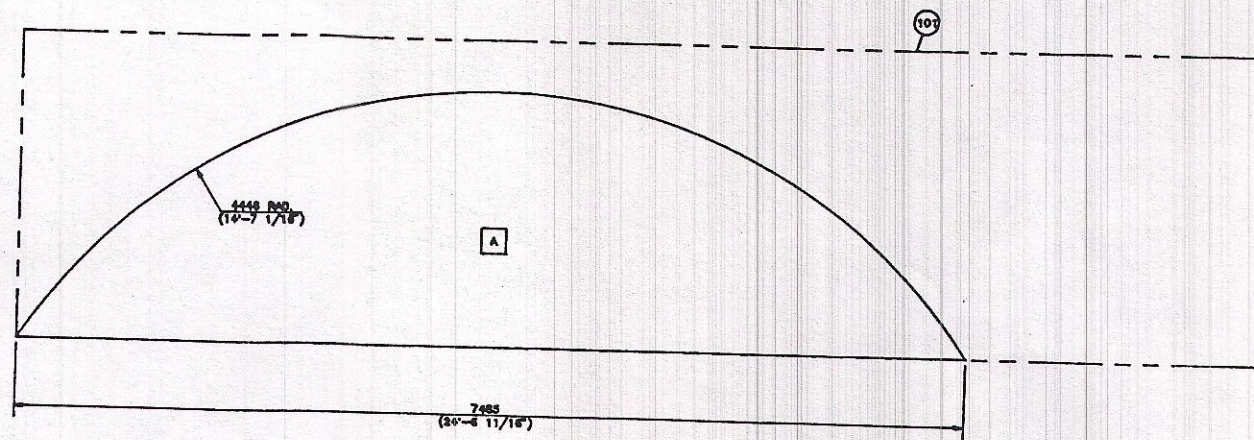


(101) SHEET LAYOUT
(8'-0" x 32'-0")
(2 REVD)

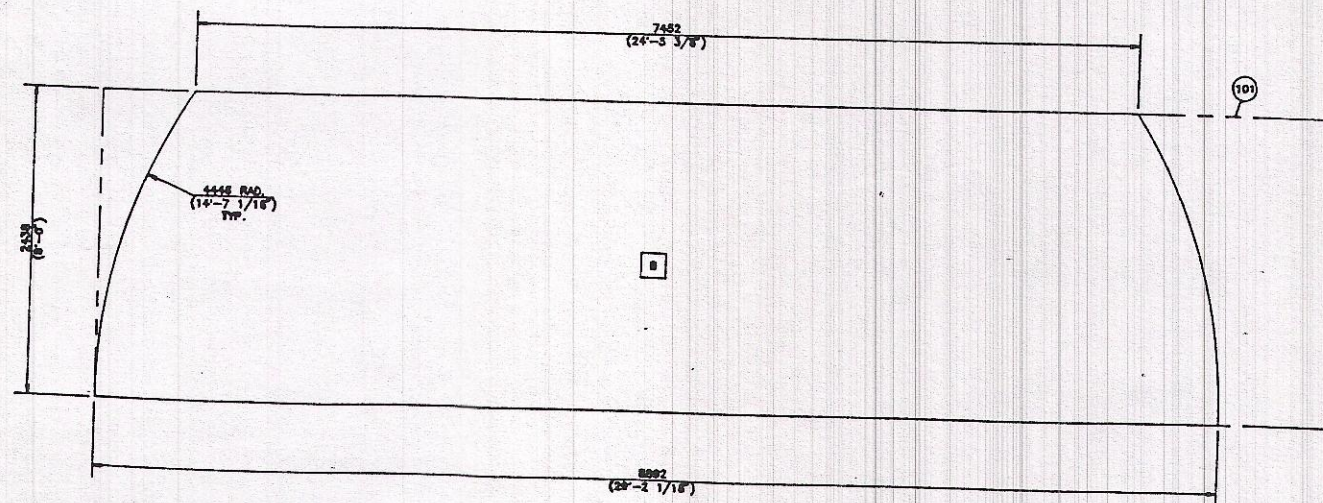

(101) SHEET LAYOUT
(8'-0" x 32'-0")
(2 REVD)

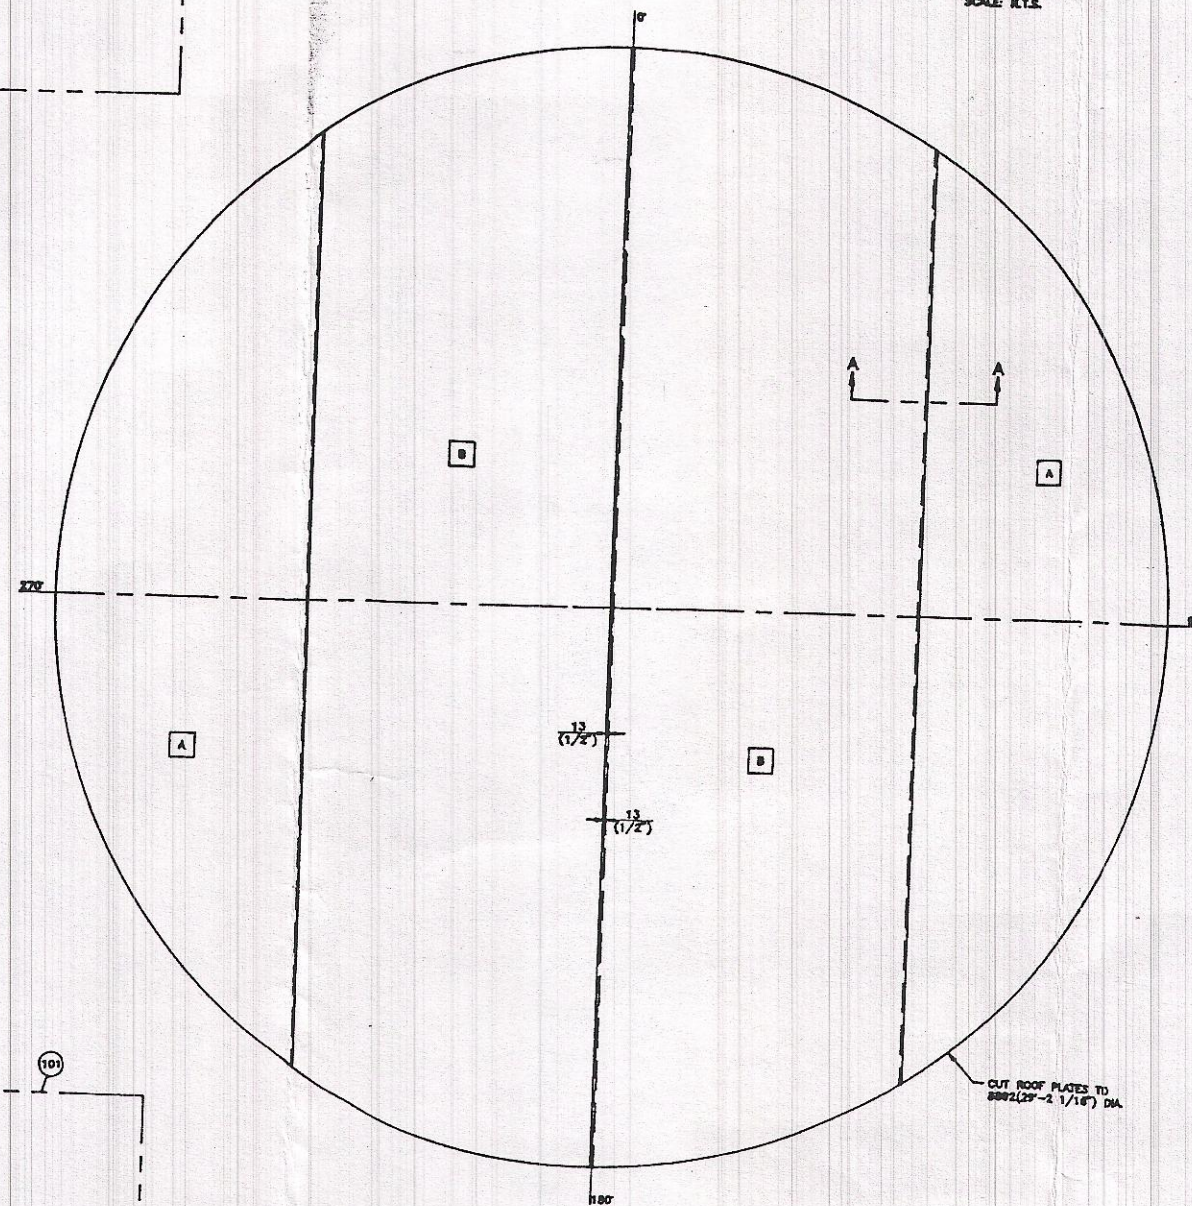

ROOF PLATE LAYOUT

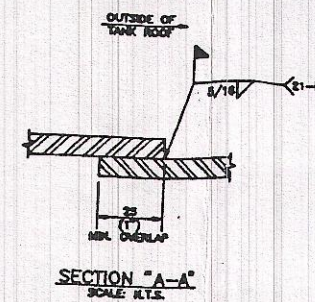


SECTION "A-A"
SCALE N.T.S.

MATERIAL LIST

NO.	QTY.	DESCRIPTION	MATERIAL
101	4	PLATE 3/16" THK x 8'-0" x 32'-0" L.S.	A-36
102			
103			
104			
105			SUBTOTAL
106			± 1.00
107			TOTAL
108			
109			
NOTES:
1. ALL DIMENSIONS ARE IN MILLIMETERS. DIMENSIONS IN BRACKETS ARE FOR REFERENCE ONLY.

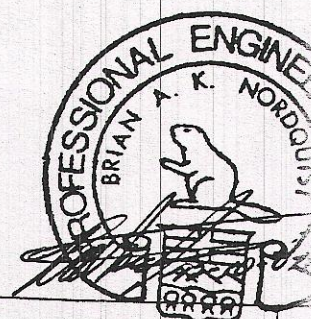


NO.	DATE	REVISIONS	BY
1	15/08/92	AS-BUILT	
2	30/04/92	ISSUED FOR CONSTRUCTION	
3	10/01/92	ISSUED FOR APPROVAL	

UNIVERSAL INDUSTRIES LTD.
P.O. BOX 1590
LLOYDMINSTER, ALTA./SASK. S9V 1K5


CLIENT: CAPE DORSET
NORTHWEST TERRITORIES

PROJECT TITLE: WATER STORAGE TANK
8900mm(29'-2 3/8") I.D. x 9000mm(29'-6 5/16")

SCALE: 1:30
DATE: 20/11/91
DRAWN BY: C. GOSWAMI
CHECKED BY: APP
SHEET NO.: T-5400-D102 SHT 2/2

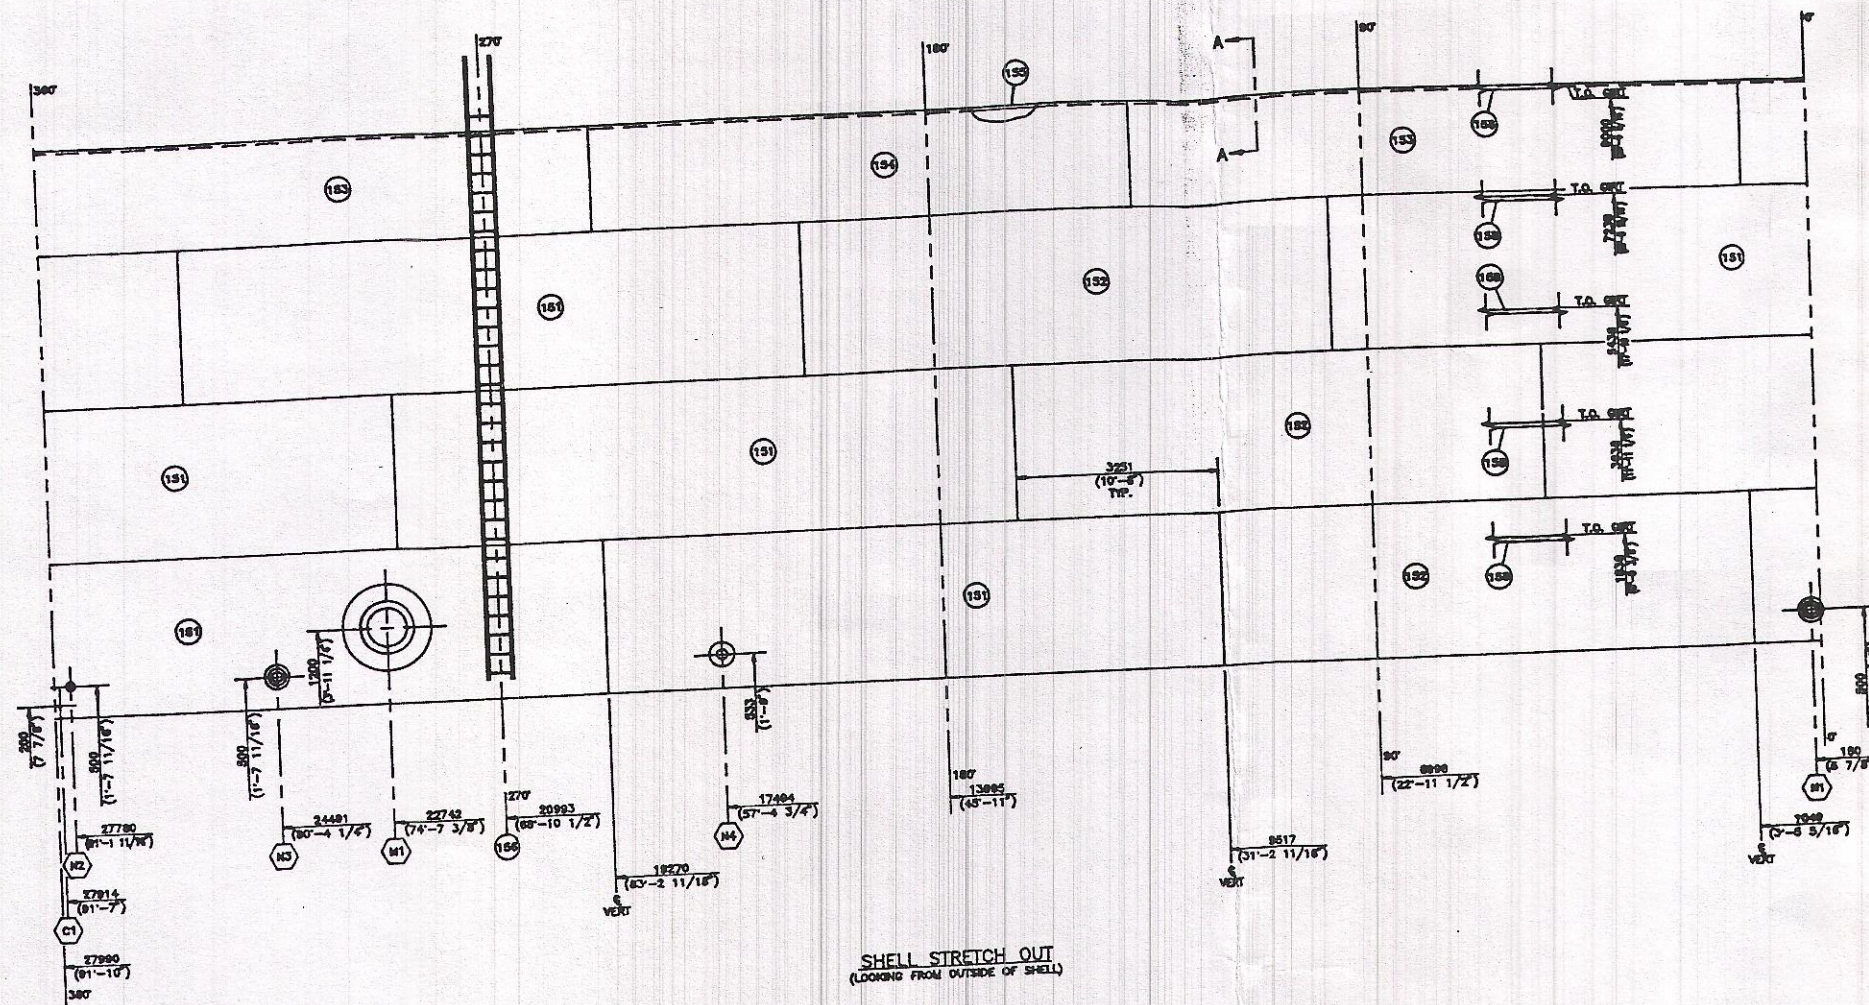


SHELL STRETCH OUT
(LOOKING FROM OUTSIDE OF SHELL)

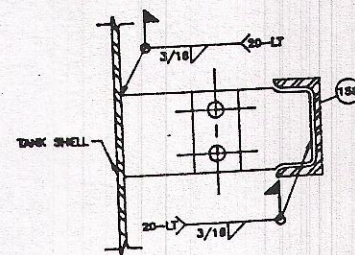

INSULATION CLIP WELD DETAIL
SCALE N.T.S.

NO.	QTY.	DESCRIPTION	MATERIAL
151	8	PLATE 3/16" THK x 8'-0" x 32'-0" LG.	A-36
152	3	PLATE 3/16" THK x 8'-0" x 27'-0" 3/8" LG.	A-36
153	2	PLATE 3/16" THK x 5'-0" 1/8" x 32'-0" LG.	A-36
154	1	PLATE 3/16" THK x 5'-0" 1/8" x 27'-0" 3/8" LG.	A-36
155	22'-0"	RUNAROUND ANGLE 2" x 2" x 3/16" THK	REF. Dwg.
156	1	LADDER	
157	1	ANCHOR BOLTS	
158	5	INSULATION SUPPORTS	
159			
160			
- NOTES:
1. ALL DIMENSIONS ARE IN MILLIMETERS. DIMENSIONS IN BRACKETS ARE FOR REFERENCE ONLY.
 2. ALL VERTICAL DIMENSIONS ARE TAKEN FROM T.O. FLOOR PLATE.

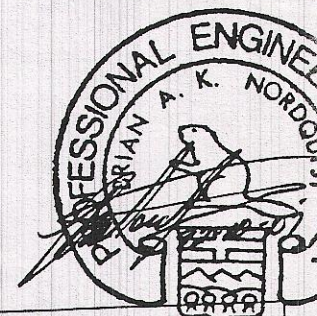


NO.	DATE	REVISIONS	BY
1	15/08/82	AS-BUILT	TRD
2	30/08/82	ISSUED FOR CONSTRUCTION	LLC
3	07/02/82	ISSUED FOR APPROVAL	CLC

UNIVERSAL INDUSTRIES LTD.
P.O. BOX 1590
LLOYDMINSTER, ALTA./SASK. S9V 1K5


CAPE DORSET
NORTHWEST TERRITORIES

WATER STORAGE TANK
8900mm(29'-2 3/8") I.D. x 9000mm(29'-6 5/16")
SHELL STRETCH OUT


SCALE 1:50	DATE 20/11/81	DESIGNED BY C. DRESSER	APPROVED BY T-5400-D103
---------------	------------------	---------------------------	----------------------------

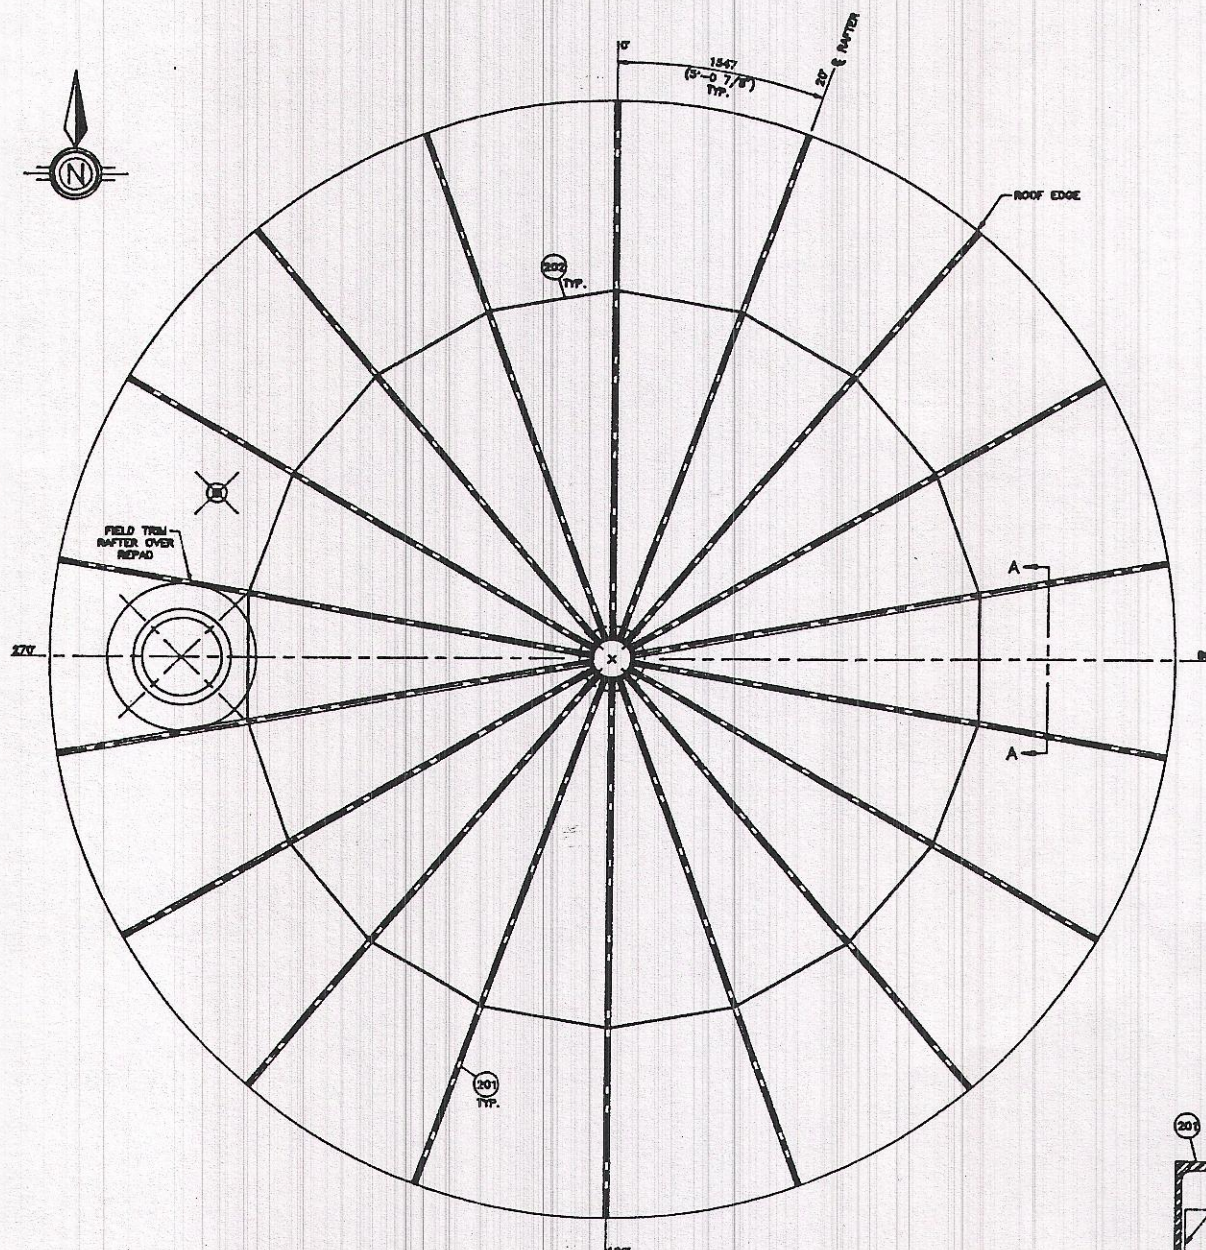


ORIENTATION

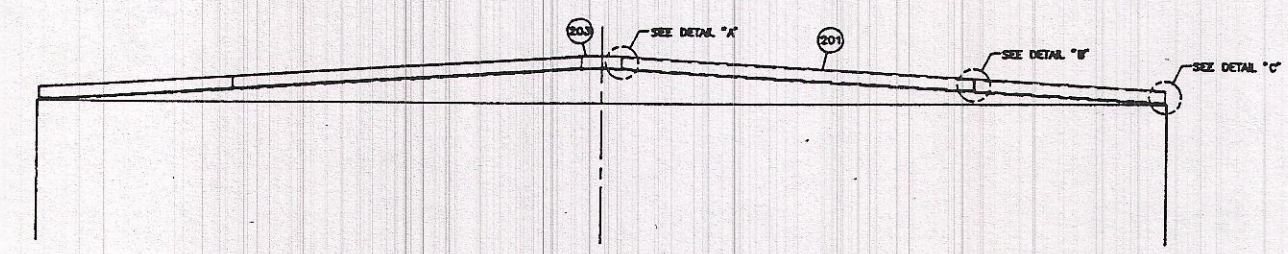


ELEVATION

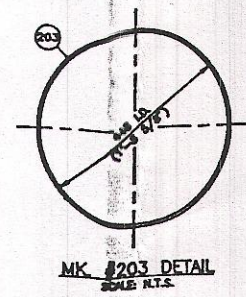


MK #203 DETAIL
SCALE N.T.S.

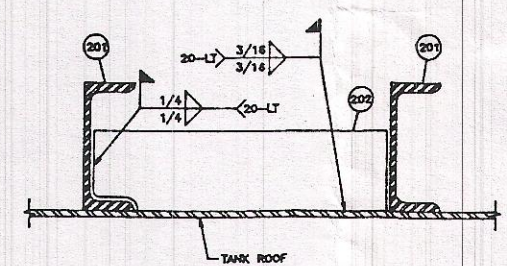


SECTION "A-A"
SCALE N.T.S.

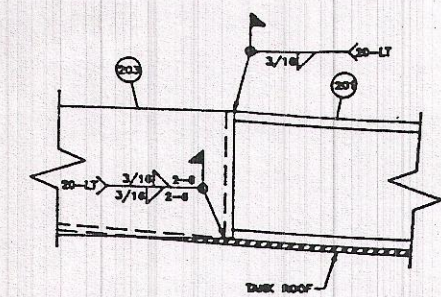


DETAIL "A"
SCALE N.T.S.

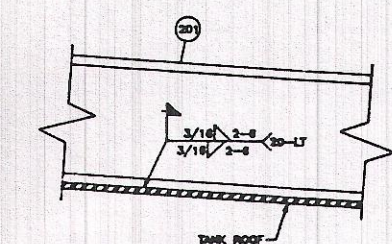

DETAIL "B"
SCALE N.T.S.

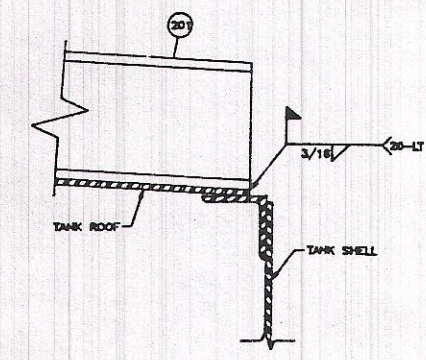

DETAIL "C"
SCALE N.T.S.

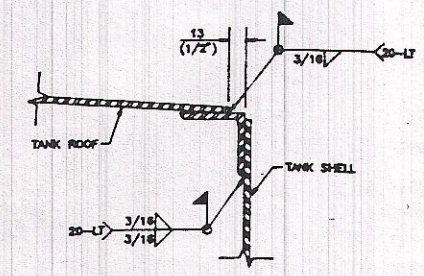


ROOF TO RUNAROUND DETAIL
SCALE N.T.S.

MATERIAL LIST

MK	QTY.	DESCRIPTION	MATERIAL
201	18	ROOF CHANNEL C4 x 8.4	REF. DWG.
202	18	SUPPLEMENTARY FLATBAR 2 1/2 x 1/4 TYP.	REF. DWG.
203	1	COMPRESSION RING PLATE 3/16 x 6	A-36
204			
205			
NOTES:
1. ALL DIMENSIONS ARE IN MILLIMETERS. DIMENSIONS IN BRACKETS ARE FOR REFERENCE ONLY.

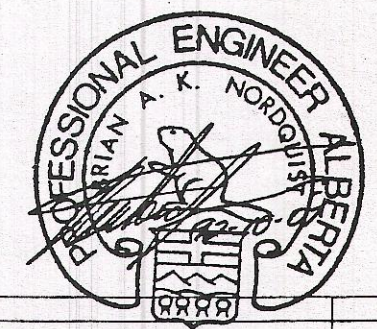











NO	DATE	REVISIONS	BY
1	15/08/82	AS-BUILT	TWA
2	30/08/82	ISSUED FOR CONSTRUCTION	LLC
3	10/01/82	ISSUED FOR APPROVAL	CLD

UNIVERSAL INDUSTRIES LTD.
P.O. BOX 1590
LLOYDMINSTER, ALTA./SASK. S9V 1K5

CLIENT: CAPE DORSET
NORTHWEST TERRITORIES

PROJECT: WATER STORAGE TANK
8900mm(29'-2 3/8") I.D. x 9000mm(29'-6 5/16") HIGH
ROOF STRUCTURE DETAIL


SCALE: 1:30	DATE: 20/11/81	DESIGNER: C. GRESMER	APP: [Signature]	PROJECT NO: T-5400-D104
-------------	----------------	----------------------	------------------	-------------------------

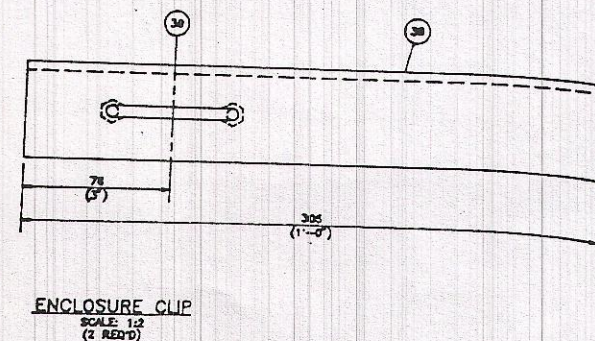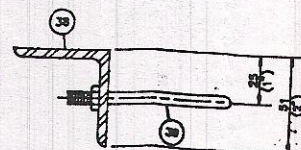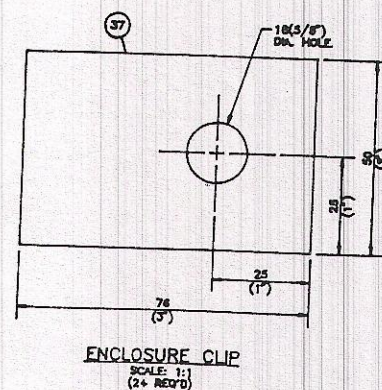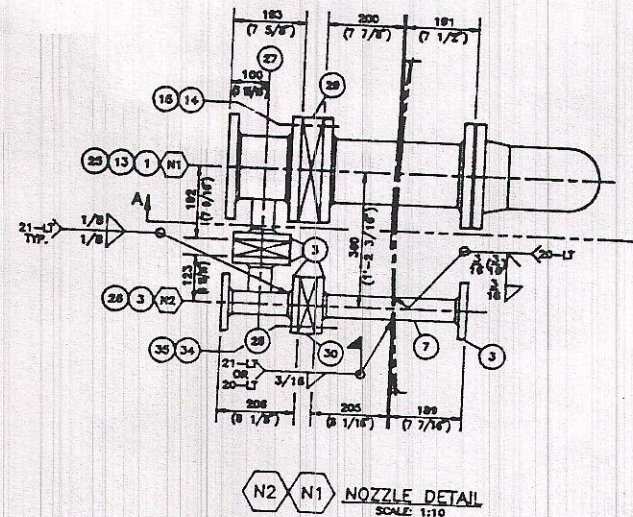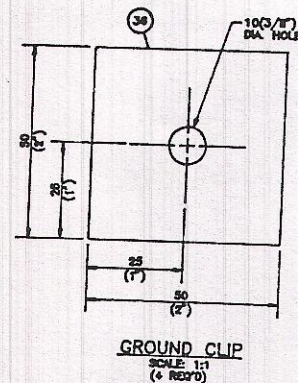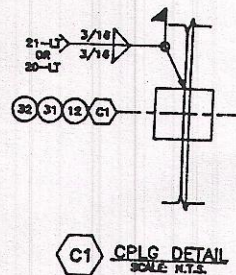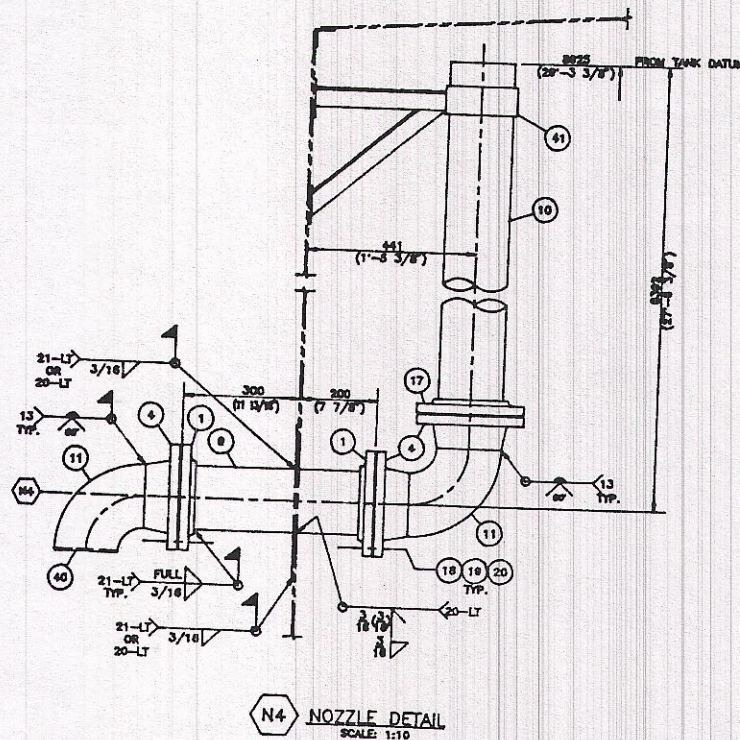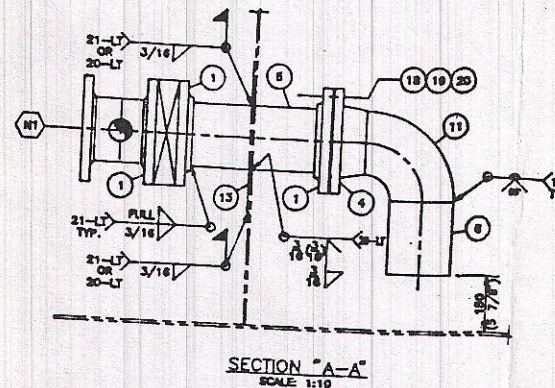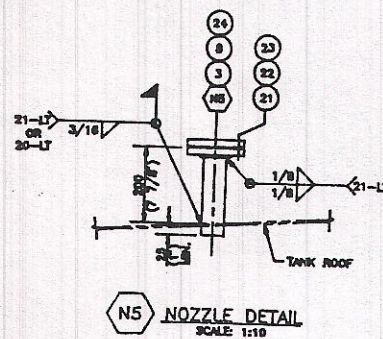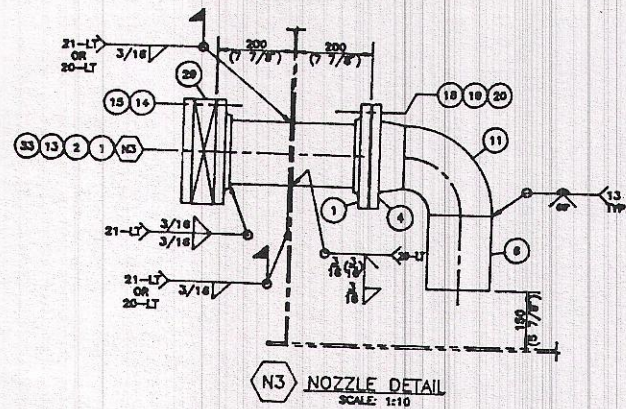

MATERIAL LIST

MK	QTY.	DESCRIPTION	MATERIAL	WT.
1	8	FLANGE 6" ANSI 150 PFSO	A-105	80
2	1	BLIND FLANGE 6" ANSI 150 PF	CAST IRON	20
3	7	FLANGE 2" ANSI 150 PFSO	A-105	36
4	5	FLANGE 6" ANSI 150 PFSO x SCH STD BORE	A-105	66
5	1	PIPE 6" SCH STD x 1'-3 3/8" LG. ERW	A-53-B (GALV.)	25
6	2	PIPE 6" SCH STD x 7 13/16" LG. ERW	A-53-B (GALV.)	25
7	1	PIPE 2" SCH STD x 1'-3 5/8" LG. ERW	A-53-B	5
8	1	PIPE 2" SCH STD x 6" LG. ERW	A-53-B	3
9	1	PIPE 6" SCH STD x 1'-7 5/8" LG. ERW	A-53-B (GALV.)	31
10	1	PIPE 6" SCH 40 x 20'-8 3/4" LG.	PVC	908
11	4	ELBOW 6" SCH STD x 90° S.R.	A-334-WPS (GALV.)	54
12	1	FULL CPLG 1" 3000# F.S. SCRD	A-105	1
13	3	REPAIR PLATE 3/16" x 6 3/4" LG. x 1'-3 3/8" O.D.	A-38	25
14	18	STUDS 3/4" DIA x 6" LG.	SA-193-87	4
15	32	HEX NUTS 3/4" NOM.	SA-194-2H	2
16				
17	1	FLANGE 6" 150# SCH FF S.W.	PVC	18
18	86	STUDS 3/4" DIA x 3 3/4" LG.	S.S.	5
19	112	HEX NUTS 3/4" NOM.	S.S.	3
20	5	GASKET 6" ANSI 150 PF x 1/8" THK.	RUBBER	1
21	4	STUDS 5/8" DIA x 3" LG.	SA-193-87	2
22	8	HEX NUTS 5/8" NOM.	SA-194-2H	1
23	1	GASKET 2" ANSI 150 PF x 1/8" THK.	RUBBER	1
24	1	BLIND FLANGE 2" ANSI 150 PF	A-105	4
25	1	PIPE 6" SCH STD x 7 1/16" LG. ERW	A-53-B (GALV.)	12
26	1	PIPE 2" SCH STD x 7 7/8" LG. ERW	A-53-B	3
27	1	PIPE 2" SCH STD x 4 9/16" LG. ERW	A-53-B	2
28	1	PIPE 2" SCH STD x 4 3/4" LG. ERW	A-53-B	2
29	2	BUTTERFLY VALVE - 6" DREISCHOK	-	34
30	2	BUTTERFLY VALVE - 2" DREISCHOK	-	25
31	1	CLOSE NIPPLE 1" SCH STD ERW	A-53-B	1
32	1	BALL VALVE 1" G/W PLUG	-	10
33	1	PIPE 6" SCH STD x 1'-3 5/8" LG. ERW	A-53-B (GALV.)	25
34	8	STUDS 5/8" DIA x 5" LG.	SA-193-87	3
35	18	HEX NUTS 5/8" NOM.	SA-194-2H	2
36	4	CLIP: PLATE 1/4" THK x 2" x 2" LG.	A-38	1
37	24	CLIP: PLATE 1/4" THK x 2" x 3" LG.	A-38	10
38	2	ANGLE 2" x 2" x 3/16" x 1'-6" LG.	A-38	5
39	2	U-BOLT 2 1/2" DIA.	S.S.	2
40	1	BURDSCREEN 6" DIA.	-	
41	1	6" PIPE CLAMP & BRACE	-	
42				
43				
44				
45				
46				
47				
48				
49				
50				

- NOTES:
1. ALL DIMENSIONS ARE IN MILLIMETERS. DIMENSIONS IN BRACKETS ARE FOR REFERENCE ONLY.
 2. DRILL AND TAP 8mm(5/8") DIA. TELLTALE HOLES IN REINFORCING PADS.
 3. NOZZLES TO BE GALVANIZED.

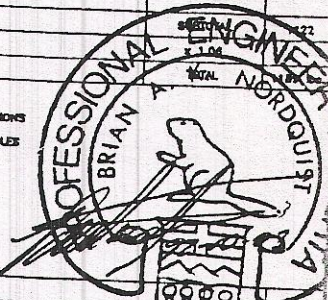

NO	DATE	REVISIONS	BY	APP
1	18/09/92	AS-BUILT		
2	12/04/92	ISSUED FOR CONSTRUCTION	TWA	
3	27/03/92	ISSUED FOR APPROVAL	LLC	

UNIVERSAL INDUSTRIES LTD.
P.O. BOX 1590
LLOYDMINSTER, ALTA./SASK. S9V 1K5

CAPE DORSET
NORTHWEST TERRITORIES

WATER STORAGE TANK
8900mm(29'-2 3/8") I.D. x 9000mm(29'-6 5/16") HIGH
NOZZLE SPOOL & CLIP DETAILS

TA-5400-D105

PLAN VIEW

SECTION "A-A"

ELEVATION VIEW
ISOLATION VALVE ENCLOSURE

SECTION "B-B"

SECTION "C-C"

PLAN VIEW


ELEVATION VIEW
EMERGENCY CONNECTION ENCLOSURE

SECTION "D-D"

MATERIAL LIST				
MR	QTY.	DESCRIPTION	MATERIAL	WT.
1	4	ANGLE 3" x 3" x 1/4" x 3'-3 3/16" LG.	040.21--44W	64
2	1	ANGLE 3" x 3" x 1/4" x 4'-7" LG.	040.21--44W	22
3	2	ANGLE 3" x 3" x 1/4" x 2'-1 3/16" LG.	040.21--44W	21
4	1	PLATE 1/4" THK x 7 7/8" x 4'-7" LG.	040.21--44W	31
5	1	PLATE 1/4" THK x 2'-1 1/4" x 5'-1 7/16" LG.	040.21--44W	110
6	2	PLATE 1/4" THK x 2'-1 1/4" x 3'-3 3/16" LG.	040.21--44W	140
7	1	PLATE 1/4" THK x 1'-7 8/16" x 5'-1 7/16" LG.	040.21--44W	84
8	1	PLATE 1/4" THK x 1'-2 3/4" x 5'-1 7/16" LG.	040.21--44W	64
9	6	ROUND BAR 5/8" DIA. x 1'-0" LG.	040.21--44W	6
10	22	PLATEBAR 1/4" THK x 2" x 3" LG.	040.21--44W	9
11	1	PLATEBAR 1/4" THK x 3" x 5'-7 13/16" LG.	040.21--44W	14
12	4	PLATEBAR 1/4" THK x 3" x 3'-3 3/8" LG.	040.21--44W	34
13	1	PLATE 5/16" THK x 1'-8 1/2" x 5'-3" LG.	040.21--44W	114
14	100	BOLT 1/2" DIA. x 1 1/2" LG.	Gr. 5	10
15	100	NUTS 1/2" NOM.	Gr. 5	6
16	4	PLATEBAR 1/4" THK x 1" x 3'-3 3/16" LG.	040.21--44W	11
17	2	COVER: PLATE 1/4" THK x 3 8/16" DIA.	040.21--44W	2
18	8	SHEET METAL SCREWS 1/8" DIA. x 1" LG.	-	1
19				
20	1	ANGLE 3" x 3" x 1/4" x 3'-3 1/16" LG.	040.21--44W	18
21	2	ANGLE 3" x 3" x 1/4" x 1'-7 1/16" LG.	040.21--44W	16
22	1	PLATE 1/4" THK x 7 7/8" x 2'-8 3/8" LG.	040.21--44W	19
23	1	PLATE 1/4" THK x 1'-8" x 3'-3 3/8" LG.	040.21--44W	56
24	2	PLATE 1/4" THK x 1'-8" x 3'-3 3/16" LG.	040.21--44W	111
25	1	PLATE 1/4" THK x 3'-3 3/8" x 2'-10 1/16" LG.	040.21--44W	96
26	1	PLATEBAR 1/4" THK x 3" x 5'-8 7/8" LG.	040.21--44W	10
27	1	PLATE 5/16" THK x 1'-8" x 3'-5 5/16" LG.	040.21--44W	33
28	2	PLATEBAR 3/16" THK x 2" x 3'-8 7/16" LG. TRIM TO FIT	040.21--44W	10
29				
30				
31			SUBTOTAL	1132
32			x 1.06	
33			TOTAL	1200 lbs.
34				
35				
36				
37				
38				
39				
40				

2012

1. ALL DIMENSIONS ARE IN MILLIMETERS. DIMENSIONS IN BRACKETS ARE FOR REFERENCE ONLY.

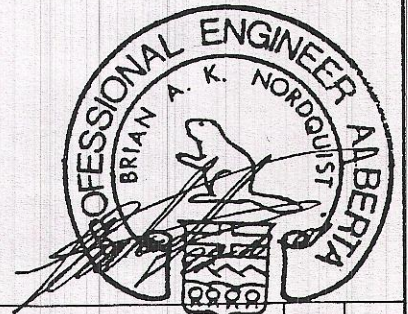

△								
△								
△								
△	10/08/92	AS-BUILT					TWA	
△	30/08/92	ISSUED FOR CONSTRUCTION					LLC	
△	28/05/92	ISSUED FOR APPROVAL					CLD	
NO	DATE	REVISIONS					BY	APP
		REVISIONS						


REVISIONS

 UNIVERSAL INDUSTRIES LTD.

P.O BOX 1590
LLOYDMINSTER, ALTA./SASK. S9V 1K5

CAPE DORSET
NORTHWEST TERRITORIES

8900mm(29'-2 3/8") I.D. x 9000mm(29'-6 5/16") HIGH
ENCLOSURE DETAILS

SCALE:	DATE:	DESIGNER:	DATE:	REV. NO.
1:10		C. GROSSER		
DATE:	CHG'D:	APP'D:	TA-5400-D112	
21/05/92				

DE BERARD PER Ryan



NDT RECORD SHEET

UNIVERSAL INDUSTRIES LTD.

BOX 1590, LLOYDMINSTER, SASK./ALTA. S9V 1K5 (403) 875-6161

SAMPLE 15

S.O. # : _____ CUSTOMER: _____
 DESCRIPTION: _____ LOCATION: _____
 FOREMAN: _____ VESSEL # : _____

TANK ELEMENT	TEST	STANDARD	CUSTOMER	UIL	DATE
ANNULAR RING	RADIOGRAPHY	Q-RE-1.0			
BOTTOM	VACUM BOX	Q-VT-1.0	MA	JS	July 10/92
SHELL TO BOTTOM	OIL PENETRANT MAGNETIC PARTICLE	Q-SB-1.0			
FIELD INSTALLED FITTINGS, (LAYOUT) MA	VISUAL	Q-MP-1.0 UIL DWG. API 650	MA	JS	July 10/92
SHELL REPADS	AIR TEST	Q-AP-1.0	B.G.	JS	July 21/92
FLOOR SUMPS	MAGNETIC PARTICLE	Q-AP-1.0			
FIELD INSTALLED SHELL FITTINGS	MAGNETIC PARTICLE	Q-MP-1.0			
ROOF	VACUUM BOX	Q-VT-1.0			
FLOATING ROOF	OIL PENETRANT	Q-SB-1.0			
TANK TEST	Air HYDROSTATIC	Q-HT-2.1.0	B.G.	JS	July 21/92
TANK GAUGING	STRAPPING				
ROOF DRAIN	AIR TEST				
PONTOONS	AIR TEST				



memo

To: Consultant
Subject: Comments
Date: Nov 17th 1992

- (1) Overall Plain location
of Tank (new one) in relation
- ship to Hamlet and Tree
Lake. show it.