

ALAN CHOUHARD | ENV. PROTECTION OFFICER, GOVT OF NUNAVUT

NWT 1702/1305

82-86-81 15:28 TO: AAL STATION/SPILL LINE

FROM: 8678989188

PAGE 2

FEB-06-01 17:14 FROM: HAMLET CHESTERFIELD INLET ID: 8678989188

PAGE 1/4



CHESTERFIELD INLET, N.W.T. XOC 080
PHONE 898-8851 FAX 898-0108

HAMLET OF CHESTERFIELD INLET
P.O. BOX 10
CHESTERFIELD INLET, NUNAVUT XOC-080

PHONE: (867-898-0951)

FAX: (867-898-9108)

DATE FEB 6/2001 TIME 5:05

TO: GNWT
SPILL REPORT

FROM:	☐	GEORGE TANUYAK MAYOR	☐	GREG TANUYAK RECREATION CO-ORDINATOR
	☒	DARREN RITTER S.A.O.	☐	DAVID KATIGATSIK C.E.O.
	☐	ALINA SAMMURTOK ADMIN. OFFICER	☐	HARRY AGGARE FOREMAN
	☐	JOHNMY SAMMURTOK BY-LAW OFFICER	☐	RITA KADLUK HAMLET LIAISON OFFICER
	☐	MARY SAMMURTOK RECEPTIONIST	☐	URSULA INUKSHUK ALCOHOL & DRUG
	☐	LILLIAN SIMIK LANDS OFFICER	☐	OTHER

NUMBER OF PAGES INCLUDING COVER SHEET: TOTAL NUMBER (INCLUDING COVER) 4

MESSAGE

- REPORT OF SPILL THAT TOOK PLACE FEB 6/2001.

THIS DOCUMENT ACCOMPANYING THIS TRANSMISSION CONTAIN CONFIDENTIAL INFORMATION INTENDED FOR A SPECIFIC INDIVIDUAL AND PURPOSE. THE INFORMATION IS PRIVATE, AND IS LEGALLY PROTECTED BY LAW. IF YOU ARE THE INTENDED RECIPIENT, YOU ARE HEREBY NOTIFIED THAT ANY DISCLOSURE, COPYING, DISTRIBUTION, OR THE TAKING OF ANY ACTION IN REFERENCE TO THE CONTENTS OF THIS TELESCOPED INFORMATION ERROR, PLEASE NOTIFY US IMMEDIATELY BY TELEPHONE AND RETURN THE ORIGINAL BY REGULAR MAIL.

C.C. - ALAN CHOUHARD, ENV. PROTECTION OFFICER, ARVAT


C.C. - SHAWN MALEY, DIRECTOR CGGT, RANKIN.

C.C. - RUTH KEMOE, MANAGER, PITSIULAK CO-OP


C.C. - ALAN CHOUZWARD, ENV. PROTECTION UNIT, ARV. HTI
C.C. - SHAWN MALEY, DIRECTOR CGGT, RANKIN.
C.C. - RUTH KENOE, MANAGER, PITSILAK CO-OP

701

PAGE 3/4

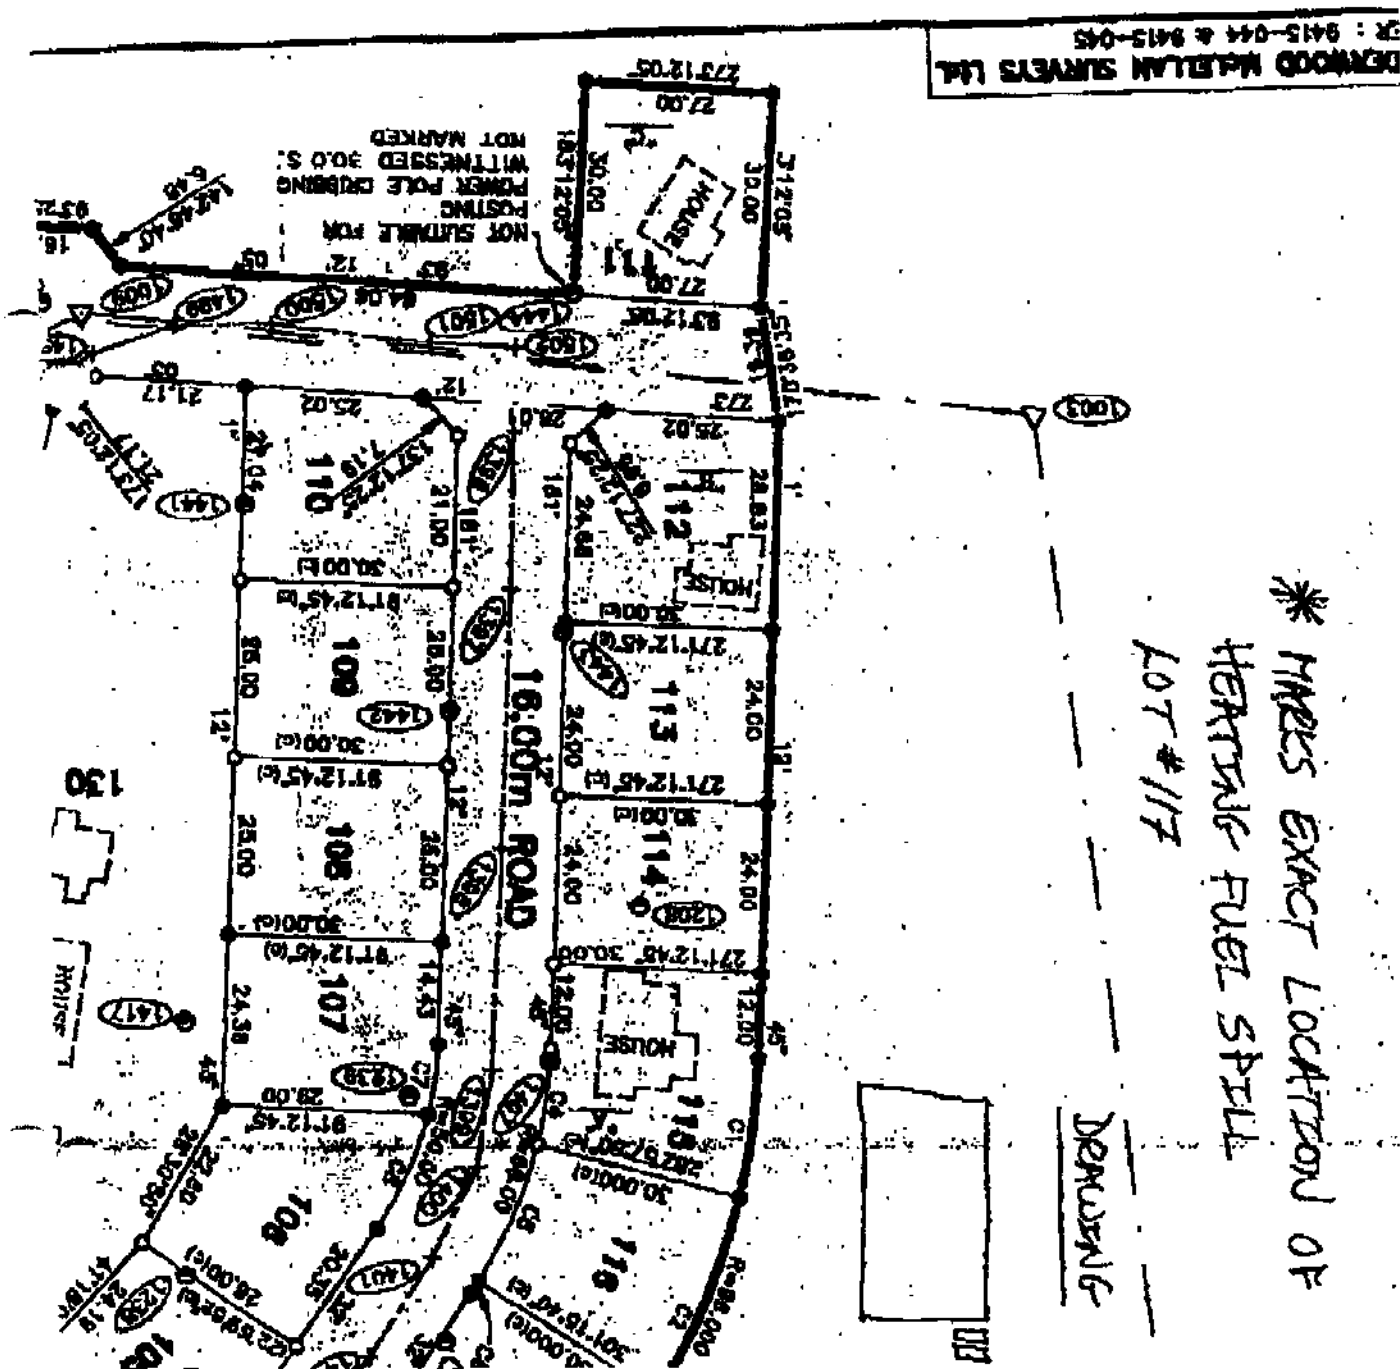

P. 05/06

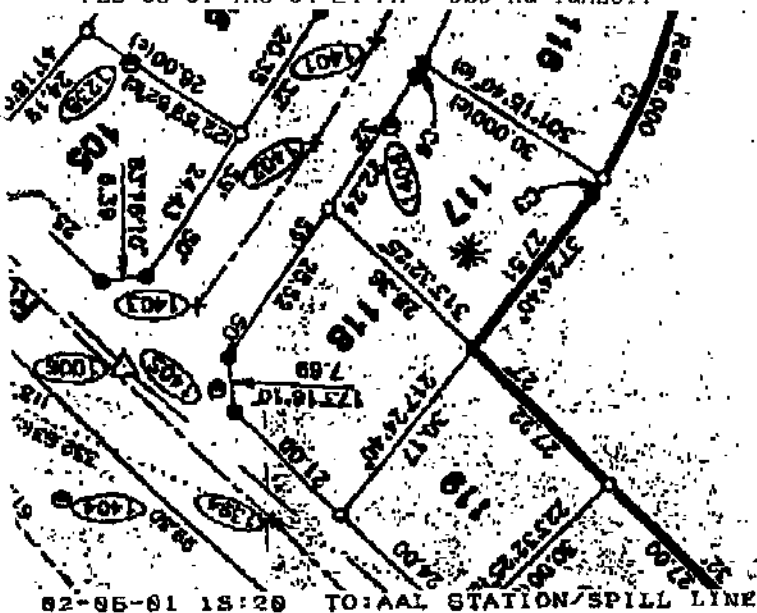

FUEL TANKS
SITE OF SPILL

303
ORDINARY
IN QUOT
DS FOR
NDS COUN
WDS FOR
DS FOR
WDS FOR
15 YEAR
UNITEK
WAVE IN M
TY AND C
RECT AND
P ME G

2151

Feb-2/01