



GOVERNMENT OF NUNAVUT

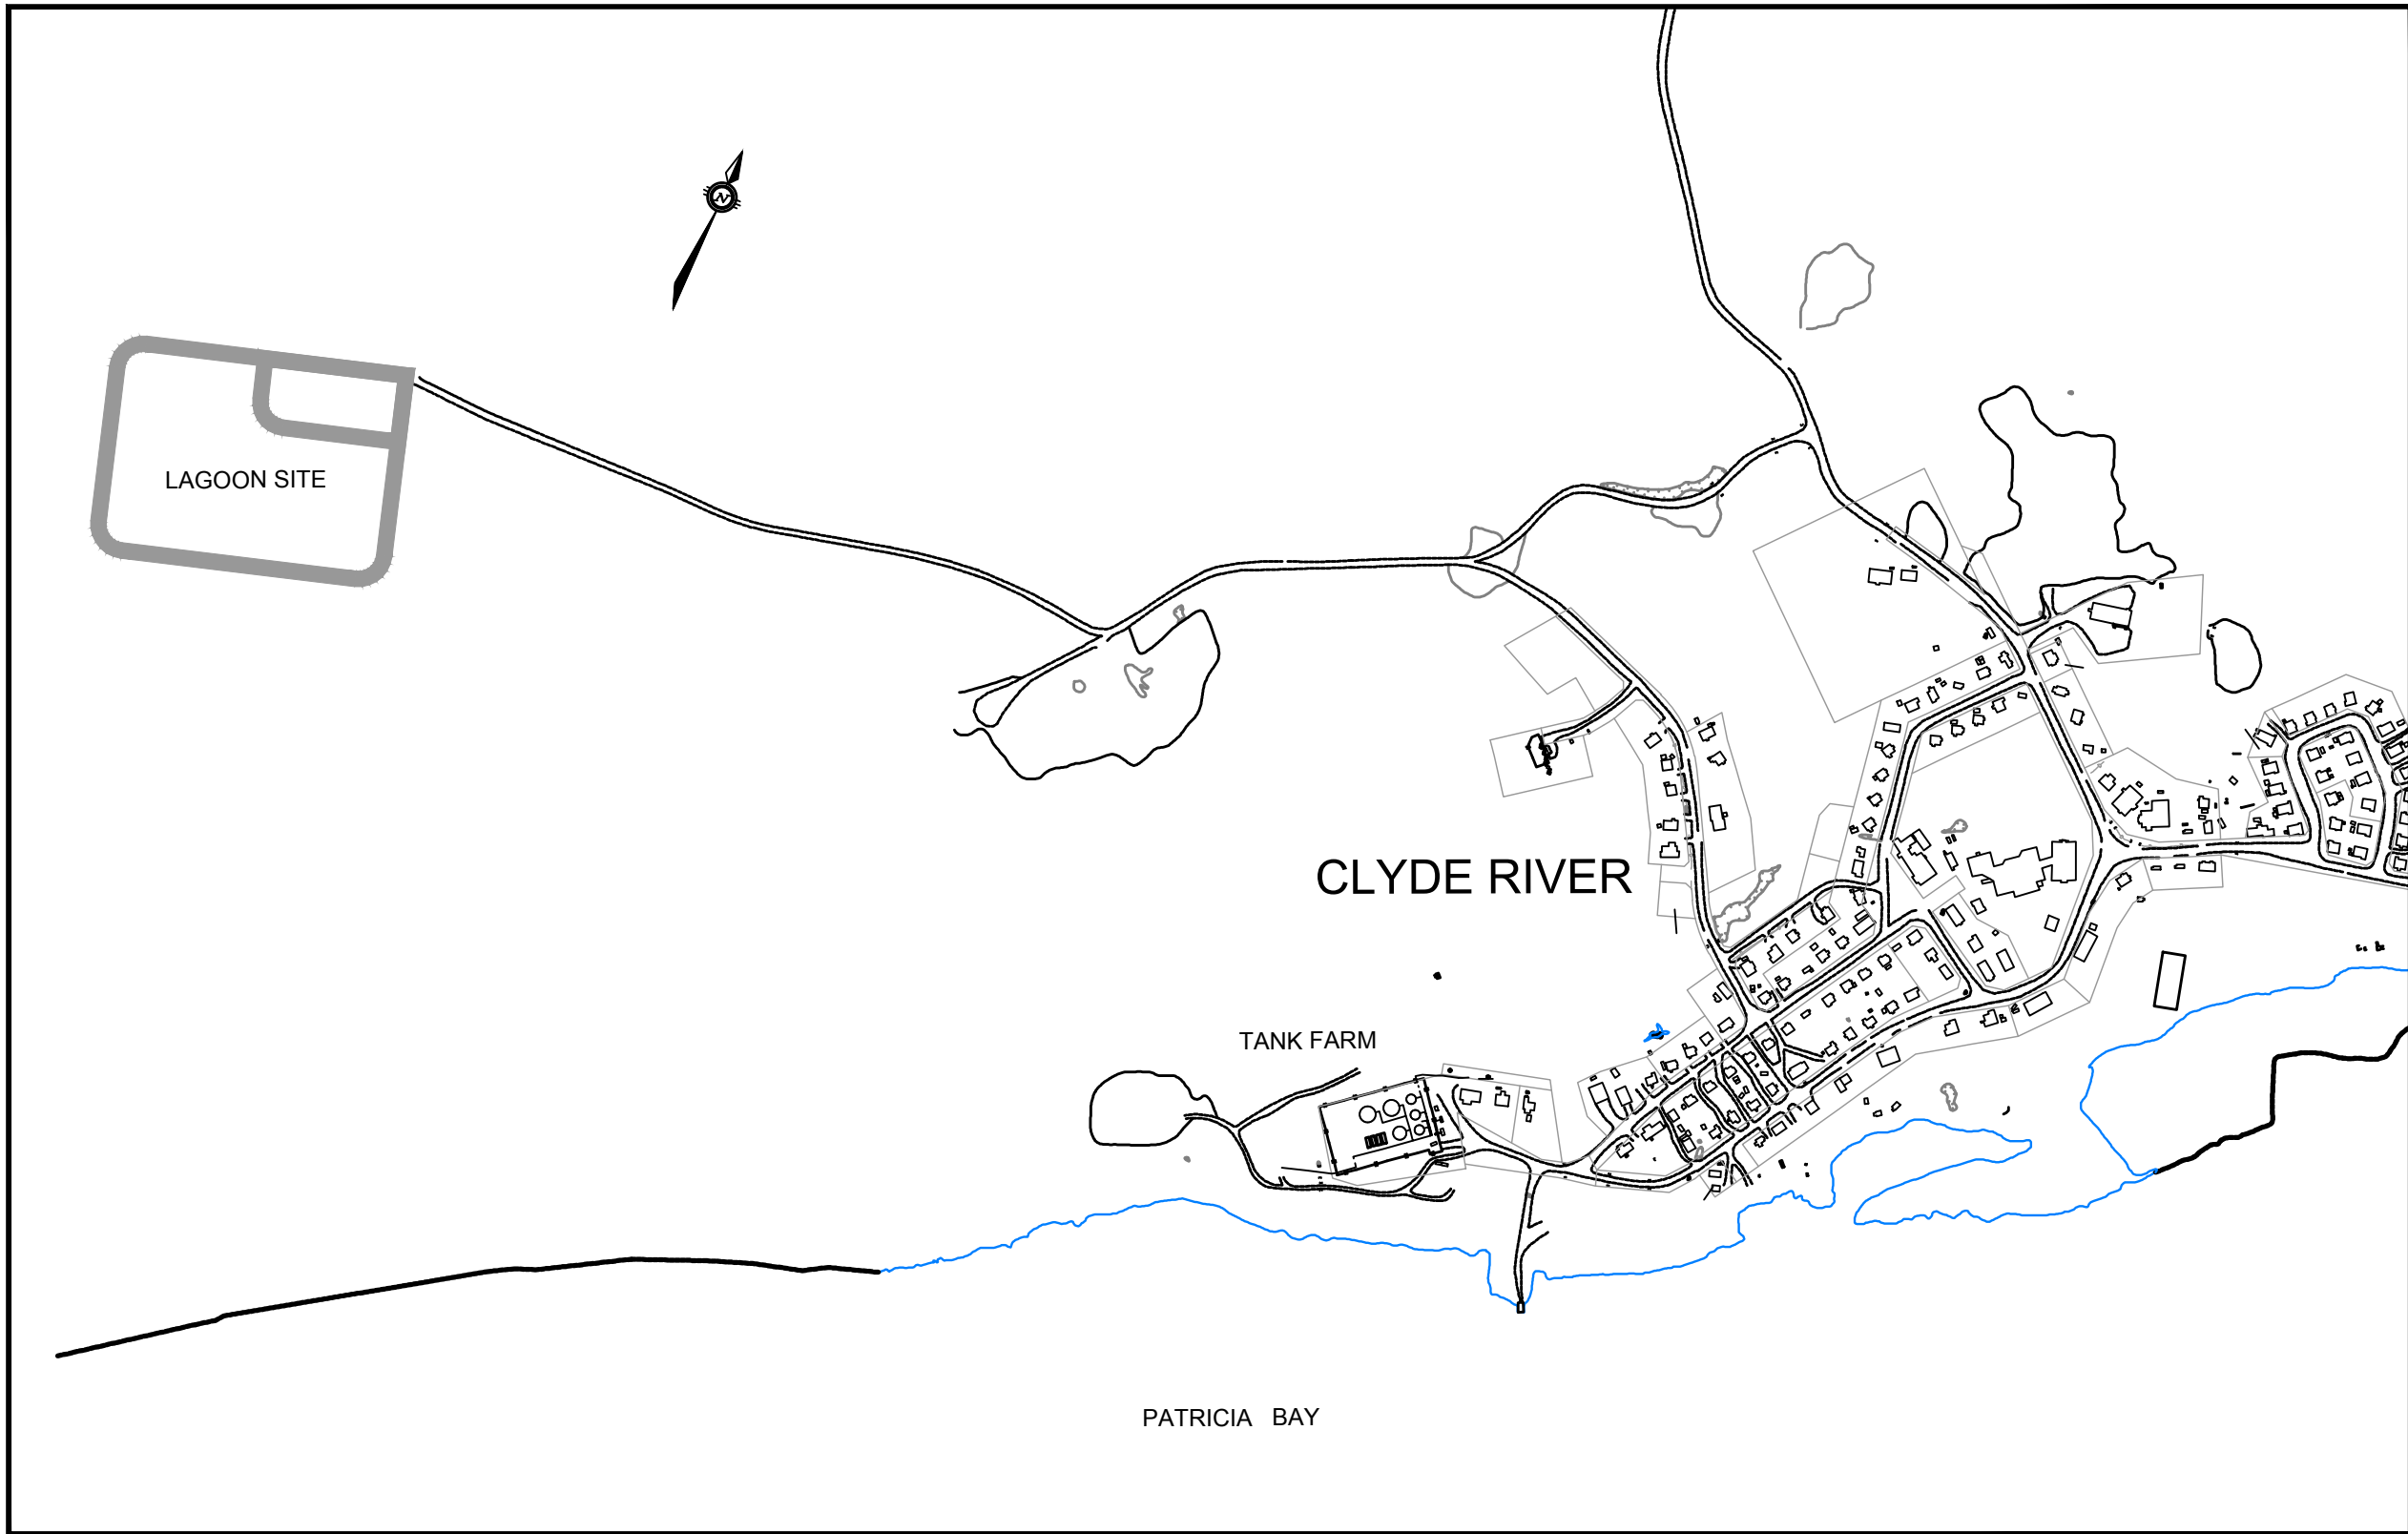

INDEX OF INCLUDED DRAWINGS

DRAWING NO.	REVISION	DESCRIPTION
		COVER
OTCD00019055A-SP1	REV 5	OVERALL SITE PLAN
OTCD00019055A-SP2	REV 5	SITE PLAN
OTCD00019055A-TD1	REV 6	TRUCK DISCHARGE SITE PLANS
OTCD00019055A-DE1	REV 5	DETAILS
OTCD00019055A-DE2	REV 5	DETAILS
OTCD00019055A-T1	REV 1	MUNICIPAL LOCATION PLAN

CLYDE RIVER WASTEWATER LAGOON (NEW SEWAGE LAGOON AND REHABILITATE EXISTING LAGOON)

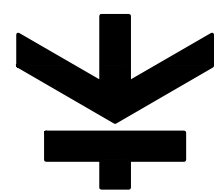

Trow Associates Inc.

100-2650 Queensview Drive
Ottawa, Ont. K2B 8H6

PHONE: (613) 688-1899
FAX: (613) 225-7337

**RECORD
DRAWING**

DATE: _____