
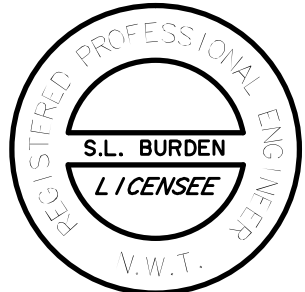


PERMIT OF PRACTICE
TROW ASSOCIATES INC.
Signature _____
Date _____
PERMIT NUMBER P184
The Association of Professional Engineers
Geologists and Geophysicists of the NWT/NU

2	AS-CONSTRUCTED 2011	18/11/11	MEB	SLB	
1	AS-CONSTRUCTED	02/12/10	MEB	SLB	
No.	DESCRIPTION	DATE	BY	APP'D	
R E V I S I O N S					

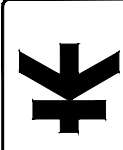

 **Trow Associates Inc.**
100-2650 Queensview Drive PHONE: (613) 688-1899
Ottawa, Ont. K2B 8H6 FAX: (613) 225-7337

CLIENT
GOVERNMENT OF NUNAVUT

PROJECT
CLYDE RIVER
WASTEWATER LAGOON

TITLE
CLYDE RIVER
MUNICIPAL LOCATION PLAN

design by	SAD	project no.	OTCD000190554
drawn by	MEB	drawing no.	
checked by	SLB		
date	11/02/2008		
scale	HORIZ 1:5000		