



ᓄᓇᓕᓂ ᓄᓇᓄᓂᓂ ᓄᓇᓄᓂᓂ
Nunalingni Kavamatkunillu Pivikhaqautikkut
Department of Community and Government Services
Ministère des Services communautaires et gouvernementaux

Richard Dwyer
Licensing Administrator
Nunavut Water Board
PH: 867-360-6338 ext.29
FX: 867-360-6369
P.O. Box 119
Gjoa Haven, NU X0B 1J0

July 2, 2009

Sub: Correction on Quarry Permit for "New Deposit 2A" of Hamlet of Kimmirut

Dear Mr. Richard,

Please read granular "New Deposit 2A" instead of granular deposit #2 as per the hamlet corrected Quarry permit # 001 and a site map attached.

Please contact me if you have any question.

Thanks.

Bhabesh Roy, M.A.Sc., P.Eng.
Municipal Planning Engineer
Community & Government Services
Baffin Region, Government of Nunavut
P.O.Box 379, Pond Inlet, X0A 0S0
Ph-867 899 7314
Fax-867 899 7328
E-mail: broy@gov.nu.ca

Copy to : Patricio Fuentes, Regional Manager of projects, CGS, Baffin Region
Johnathan Palluq, Asstt. Regional Director, CGS, Baffin Region
Timoon Toonoo, Regional Director, GN-CGS, Baffin Region
Matthew Hamp, Project officer, GN-CGS, Baffin Region
Akeego Ikkidluak, SAO, Hamlet of Kimmirut, Baffin Region

QUARRY PERMIT

PURSUANT TO THE COMMISSIONER'S LAND ACT AND REGULATIONS

FULL NAME OF PERMITTEE

Bhabesh Roy (GN-CCGS)

MAILING ADDRESS OF PERMITEE

P. O. BOX 379 Pond Inlet, Nunavut X0A 0S0

is hereby authorized to take **40,000** cubic meters of **granular material** from one site described as "New Deposit 2A" which location is described and detailed by the sketch annexed to this Permit.

This permit is subject to the following conditions:

1. This permit expires on **June 30th, 2010** or when the quantity of material specified in this permit has been quarried or removed, whichever is sooner.
2. This permit does not grant to the permittee any exclusive right or leasehold interest in the land described above.
3. This permit is not assignable and any assignment of it is of no effect.
4. All quarrying under this permit shall be carried out in accordance with the MINING SAFETY ACT, where that Act applies
5. This permit is issued subject to the provisions of the Commissioner's Land Act and the Commissioner's Land Regulations. This Permit and the terms and conditions annexed are equally binding parts of this Permit. Failure to comply with the provisions of the Act and Regulations, this Permit or the terms and conditions annexed, may result in penalties including the cancellations of the Permit without prior notice to the Permittee.

ISSUED AT

KIMMIRUT, NUNAVUT

DATE


JUNE 19th, 2009

The MUNICIPAL CORPORATION
of the HAMLET of KIMMIRUT

per:  (SEAL)

Senior Administrative Officer - Kimmirut

Sketch attached to and forming part of Quarry Permit detailing location and site of "New Deposit 2A"

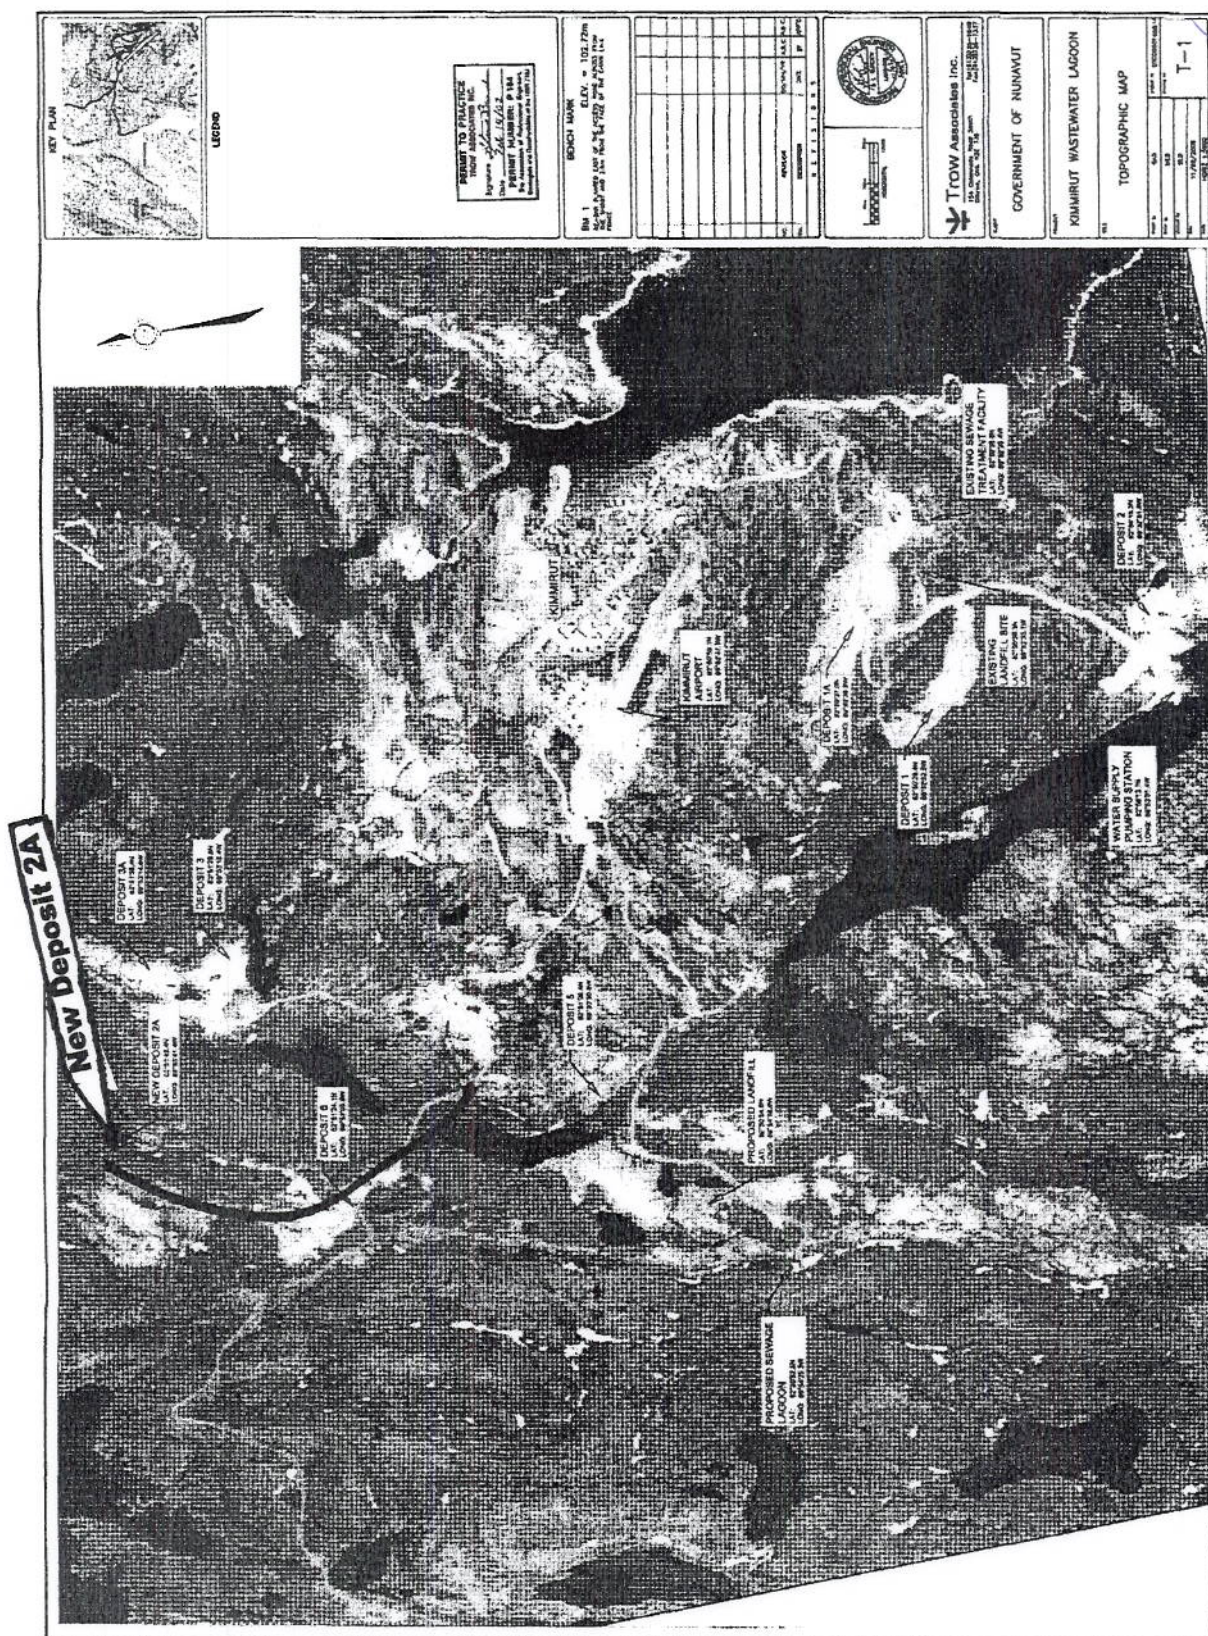

New Deposit 2A Co-ordinates: Lat 62 degree 51 min. 42.4 N
Long 69 degree 53 min. 41.4 W