


GOVERNMENT OF NUNAVUT

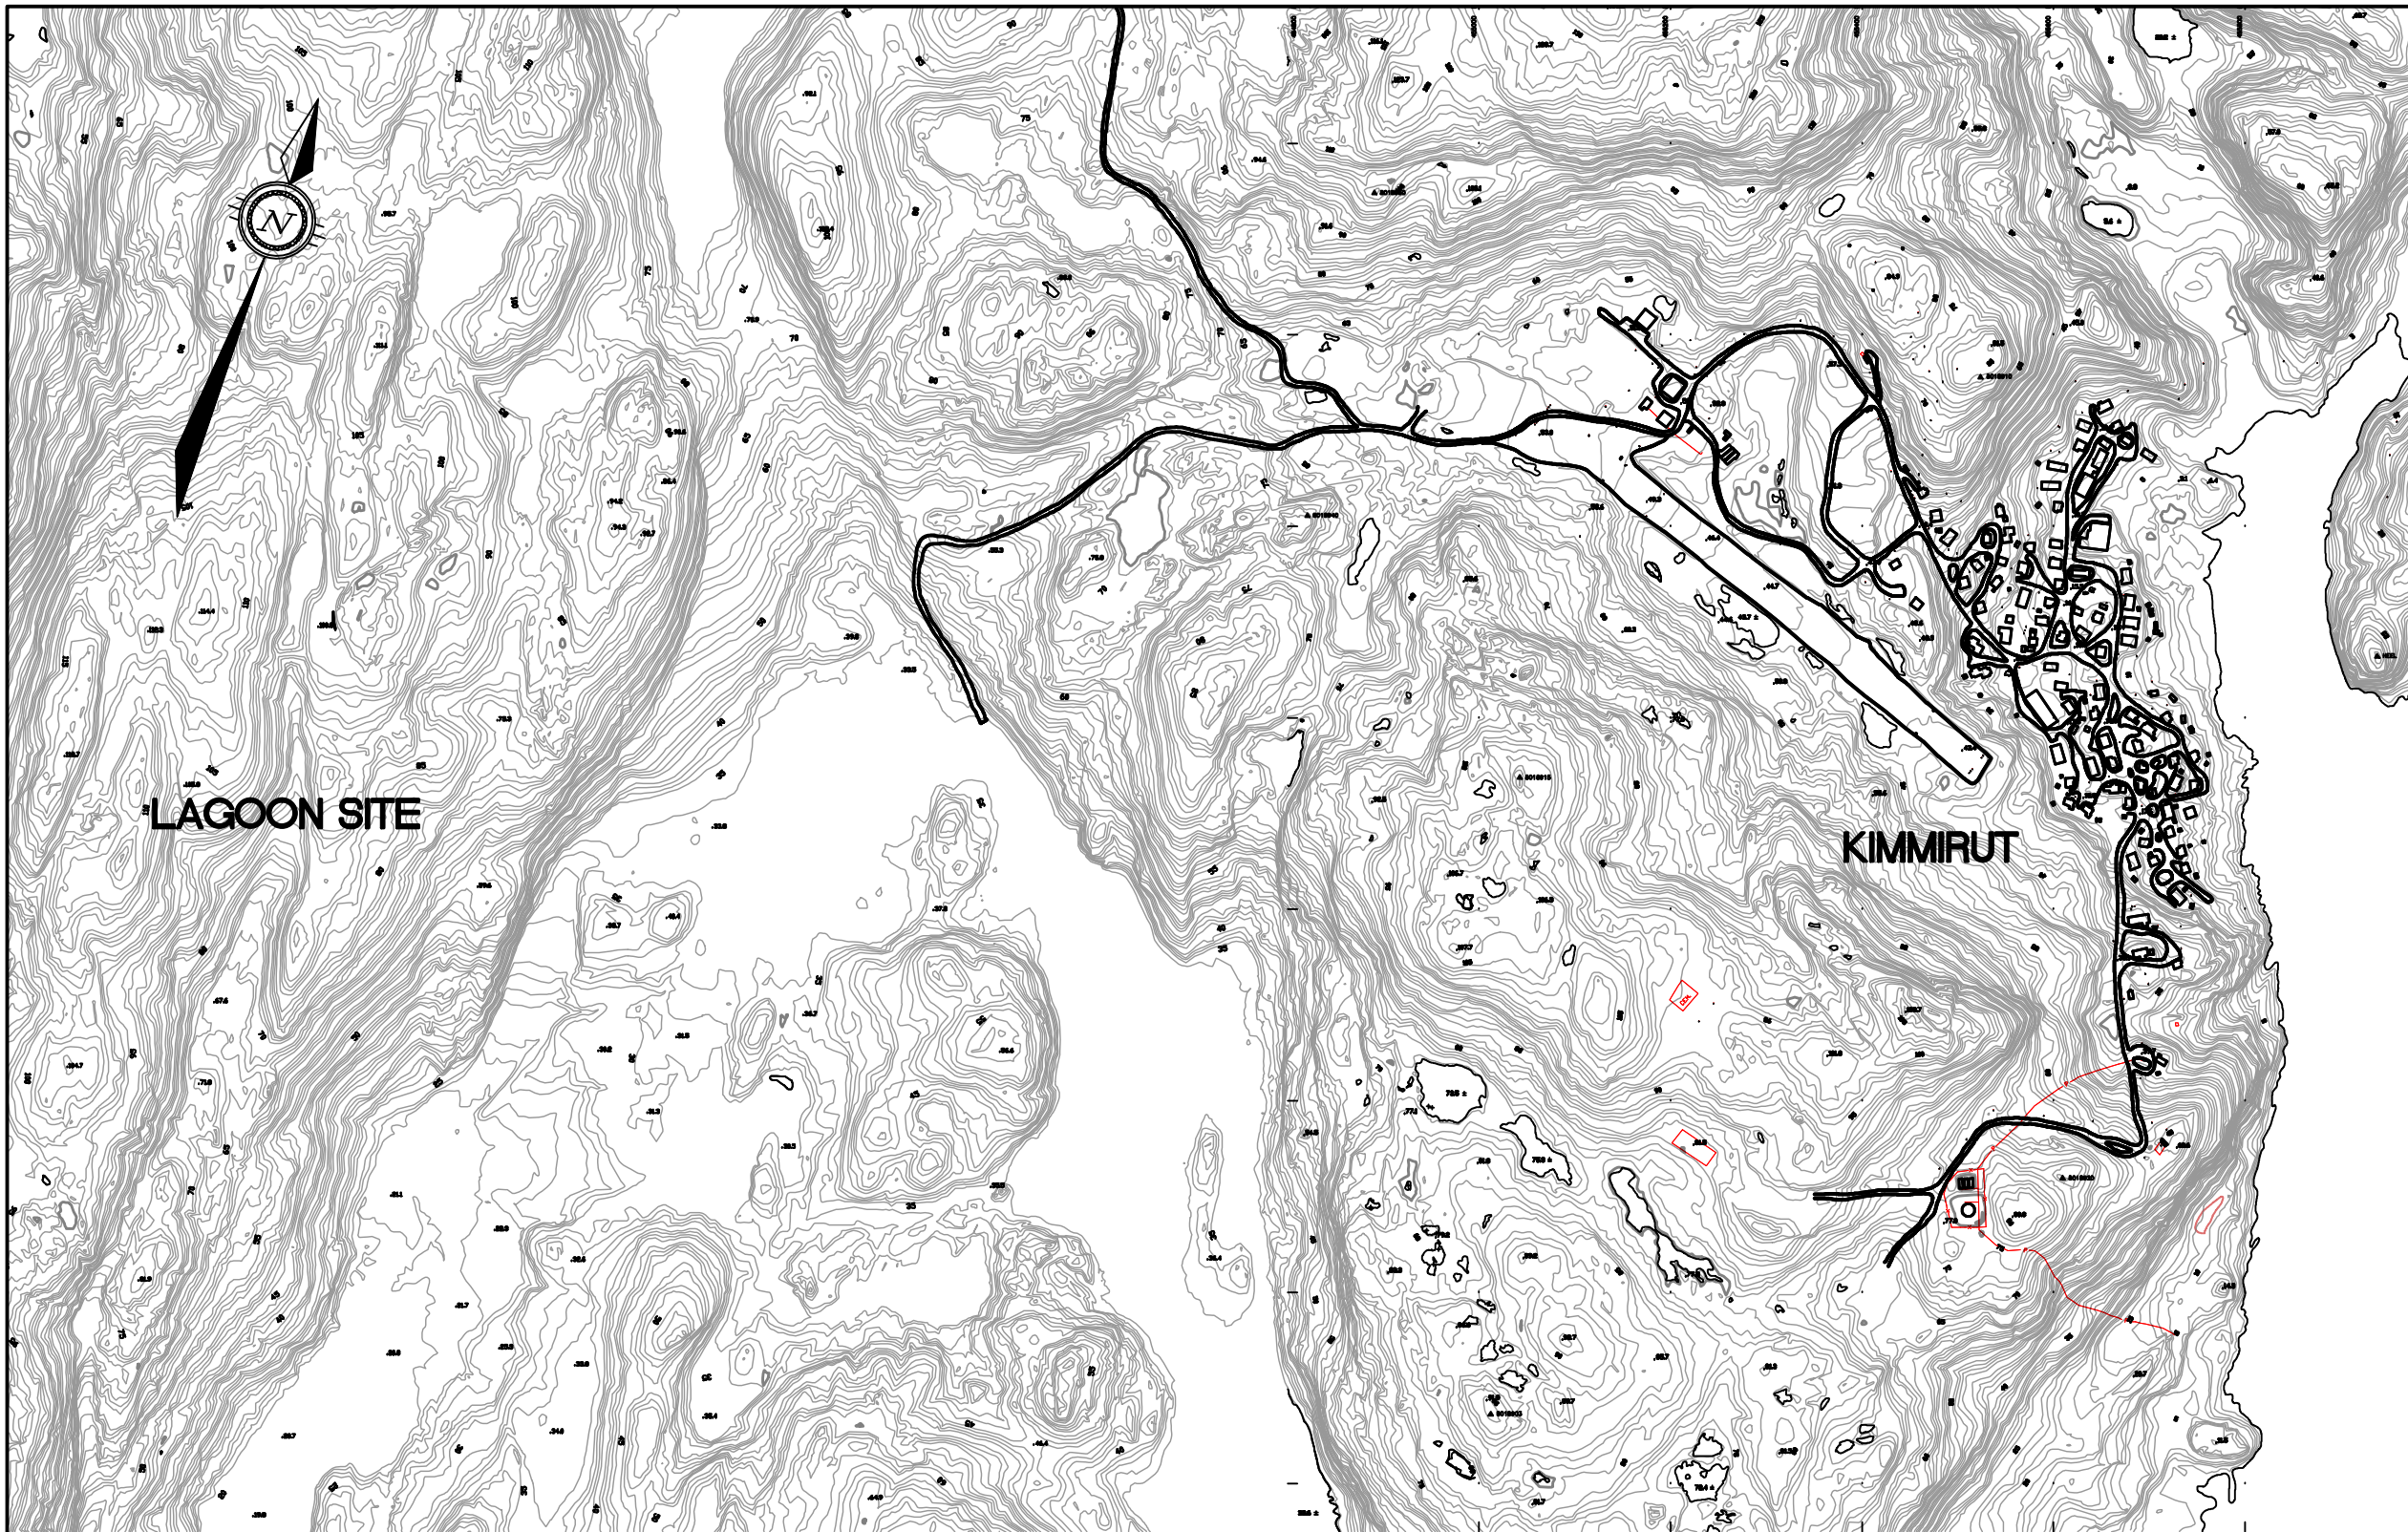

INDEX OF INCLUDED DRAWINGS

DRAWING NO.	REVISION	DESCRIPTION
		COVER
OTCD00018881A-SP1	REV 4	LAGOONS AND WETLANDS SITE PLAN
OTCD00018881A-SP2	REV 4	UPPER LAGOON SITE PLAN
OTCD00018881A-SP3	REV 4	LOWER LAGOON SITE PLAN
OTCD00018881A-TD1	REV 4	UPPER LAGOON TRUCK DISCHARGE PLAN
OTCD00018881A-TA1	REV 4	LOWER LAGOON TRUCK ACCESS PLAN
OTCD00018881A-DE1	REV 4	DETAILS
OTCD00018881A-DE2	REV 4	DETAILS

HAMLET OF KIMMIRUT WASTEWATER LAGOONS

Trow Associates Inc.

154 COLONNADE ROAD SOUTH PHONE (613) 225-9940
OTTAWA, ONTARIO K2E 7J5 FAX (613) 225-7337

AS-BUILT INFORMATION PROVIDED BY KUDLIK CONSTRUCTION LTD. SEPTEMBER 2011

AS-BUILT

DATE: SEPTEMBER 30, 2011