



Hamlet of Pangnirtung, P.O. Box 253, Pangnirtung, Nunavut X0A 0R0 • Tel.: (867) 473-8953 • Fax: (867) 473-8832

November 04 2002

Jim Wall
 Nunavut Water Board
 Gjoa Haven Nunavut




INTERNAL	
PC	
LA	
OM	
TA	
BS	
ST	Copy
ED	
CEO	
BRD	
EXT.	


Request for Amendment Pangnirtung Water License

We are requesting an amendment to our water license to include dumping of offal in the community dump. We have been working closely with Senator Adam's office concerning this issue.

Yours Truly

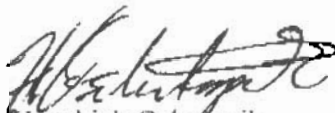
 Hezakiah Oshutapik
 Mayor of Pangnirtung

Cc R. Sellech Senator Adam's Office

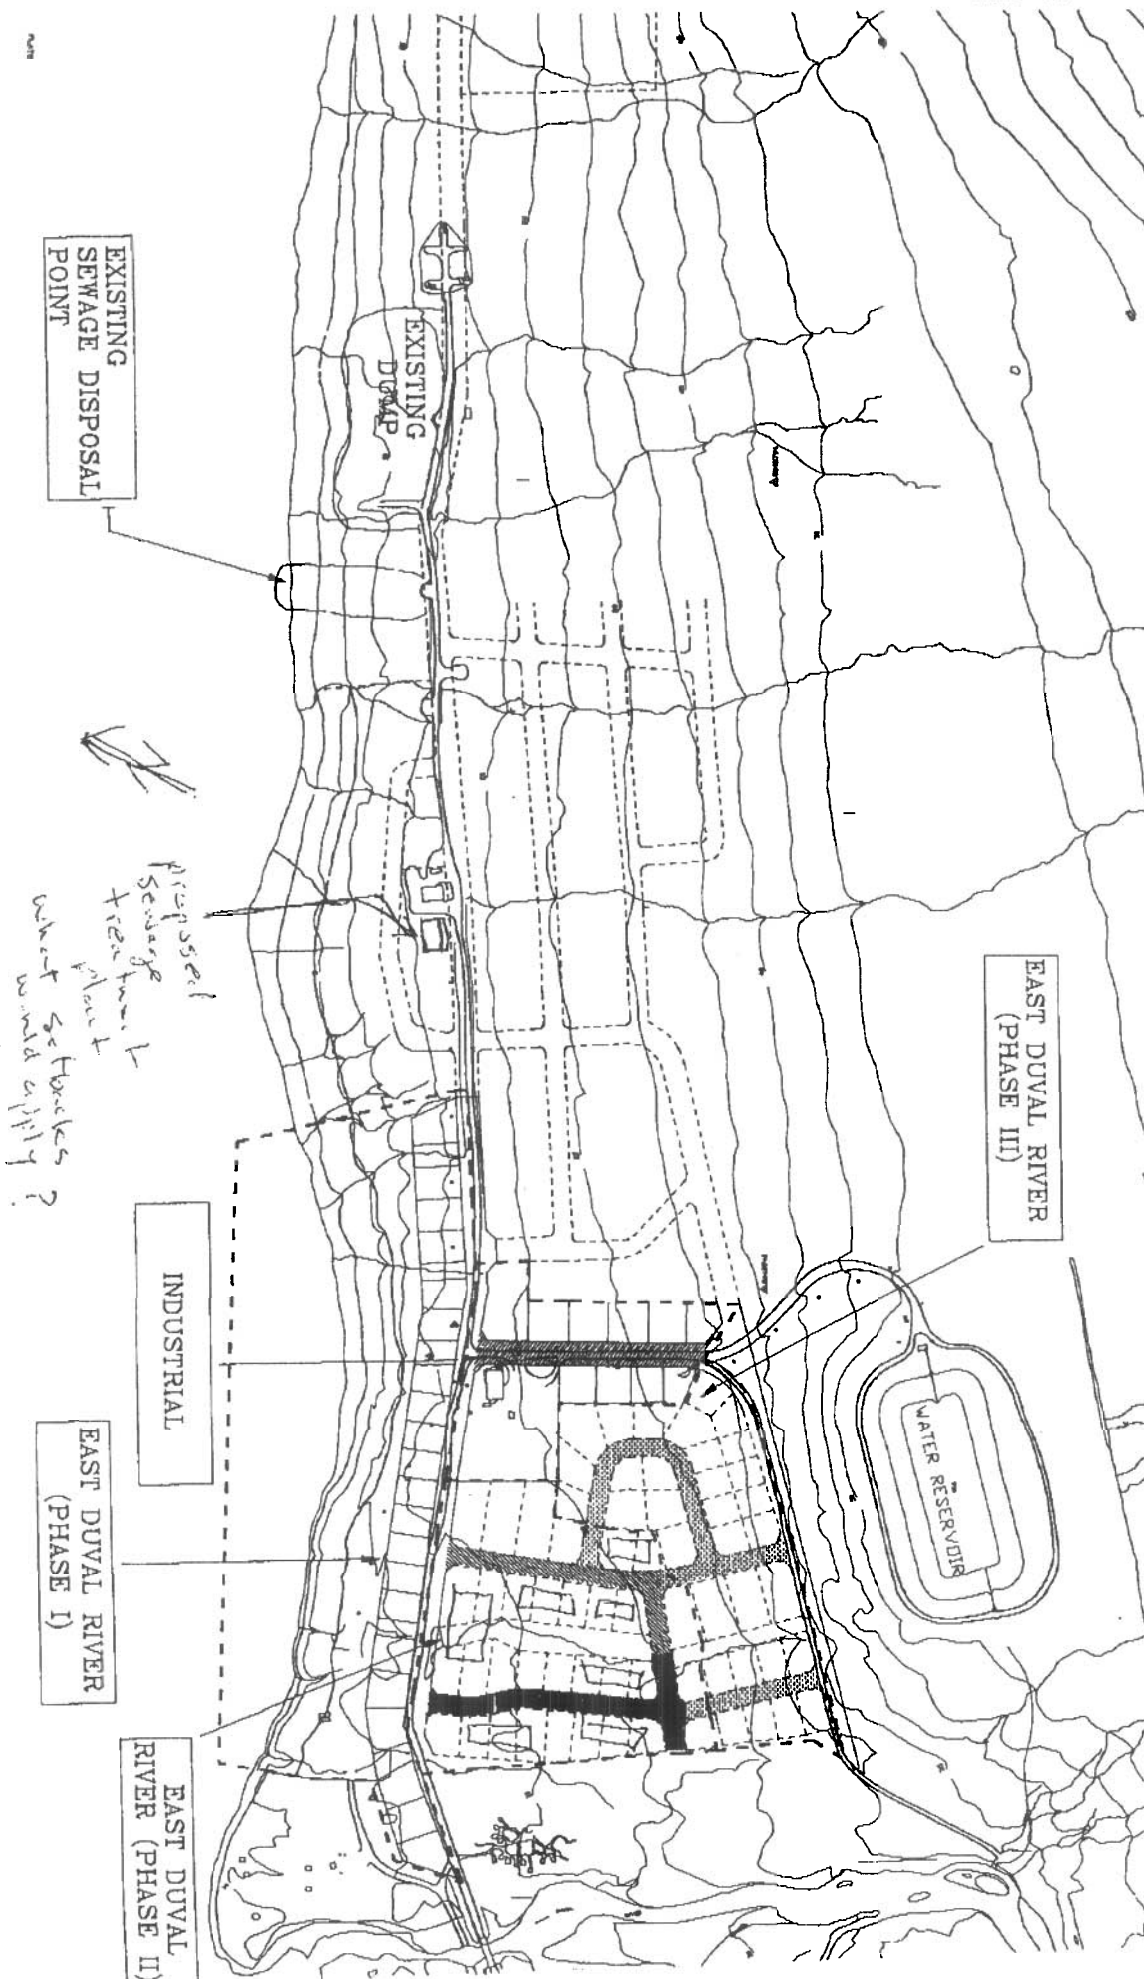

FORESHORE FLATS

FORESHORE FLATS

abandoned
dump.
Land fill

proposed
sewage
treatment
plant.

discharge
position
EXISTING SANITARY
TRUCK DISCHARGE


pump




WATER
RESERVOIR

825m
1180m
1780m

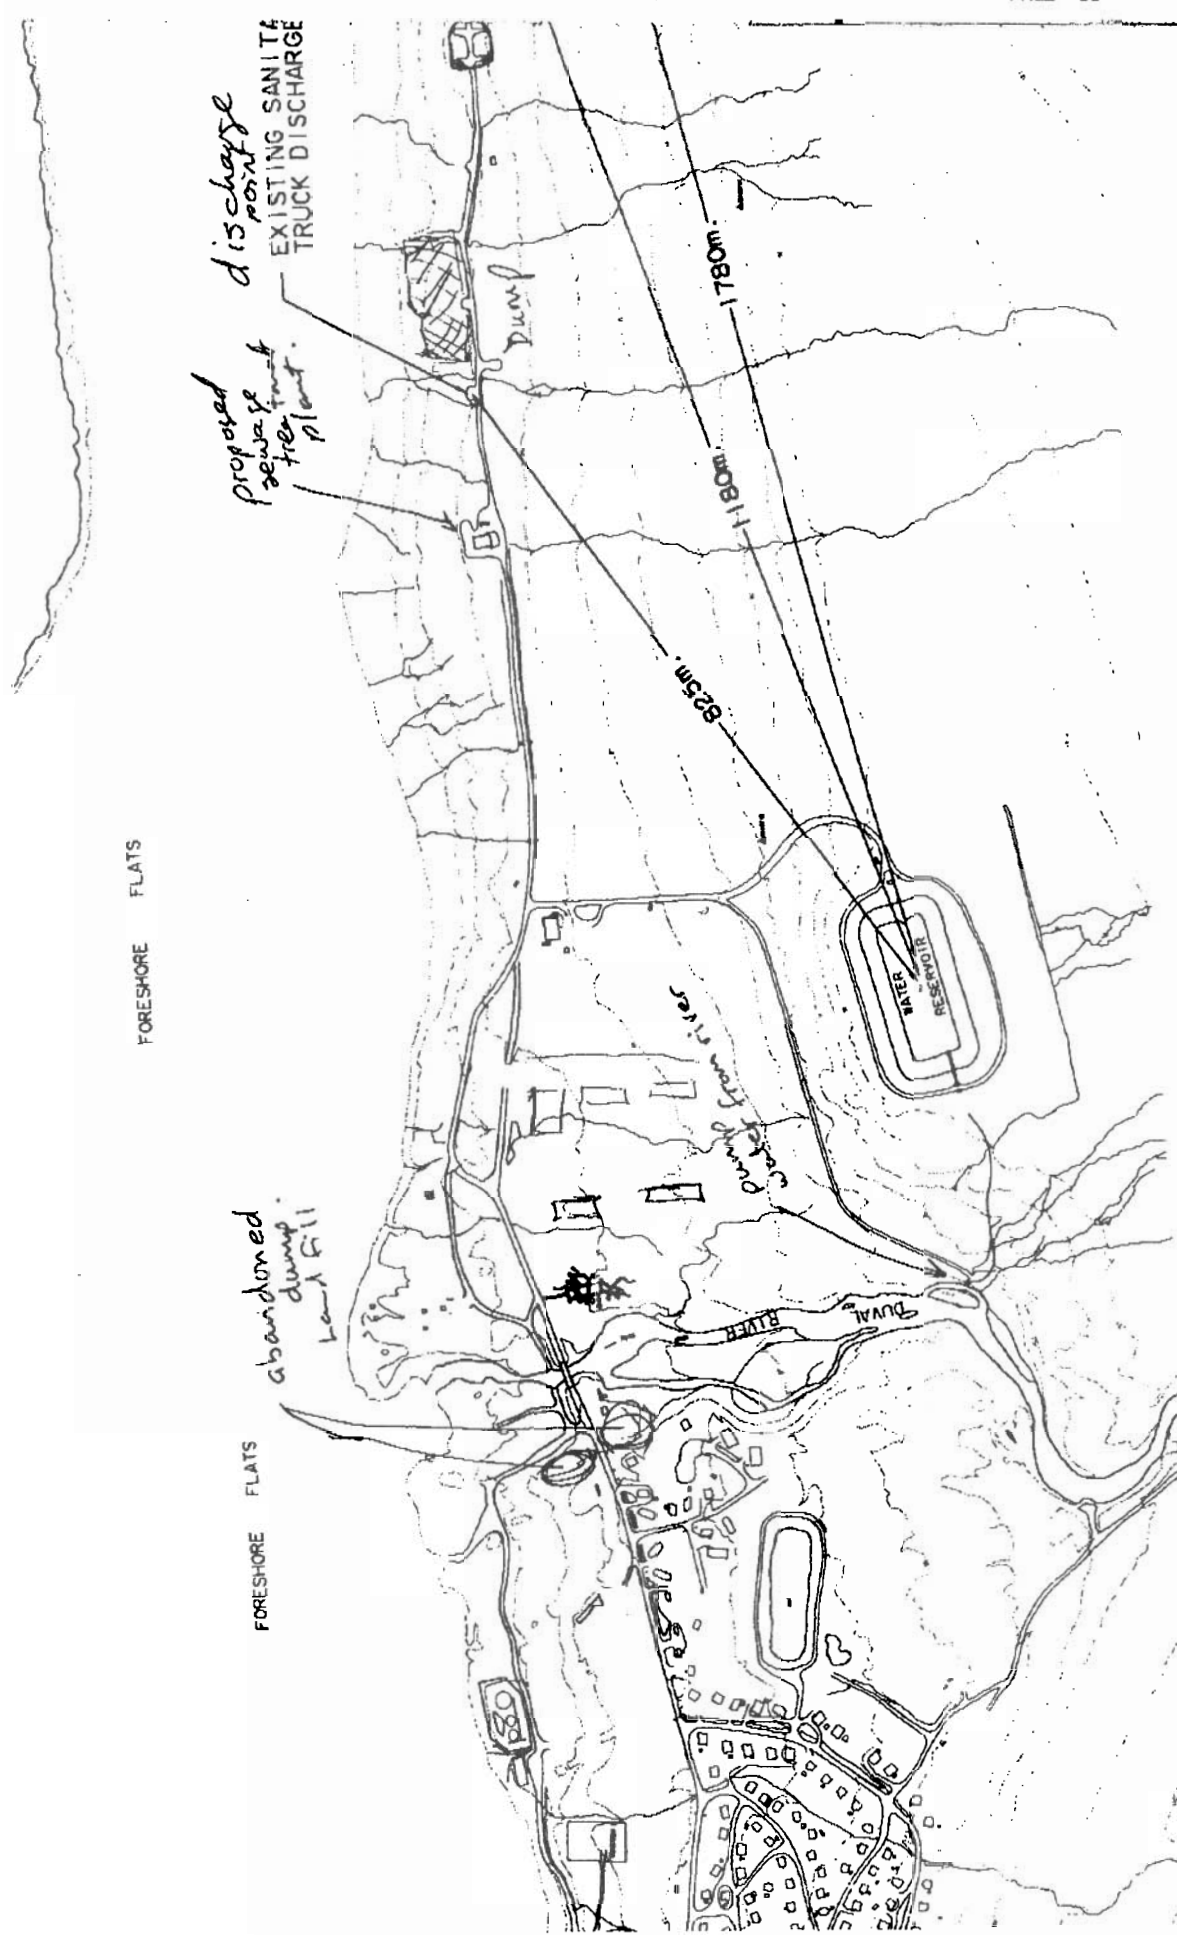

PANGNIFTUNG FIORD

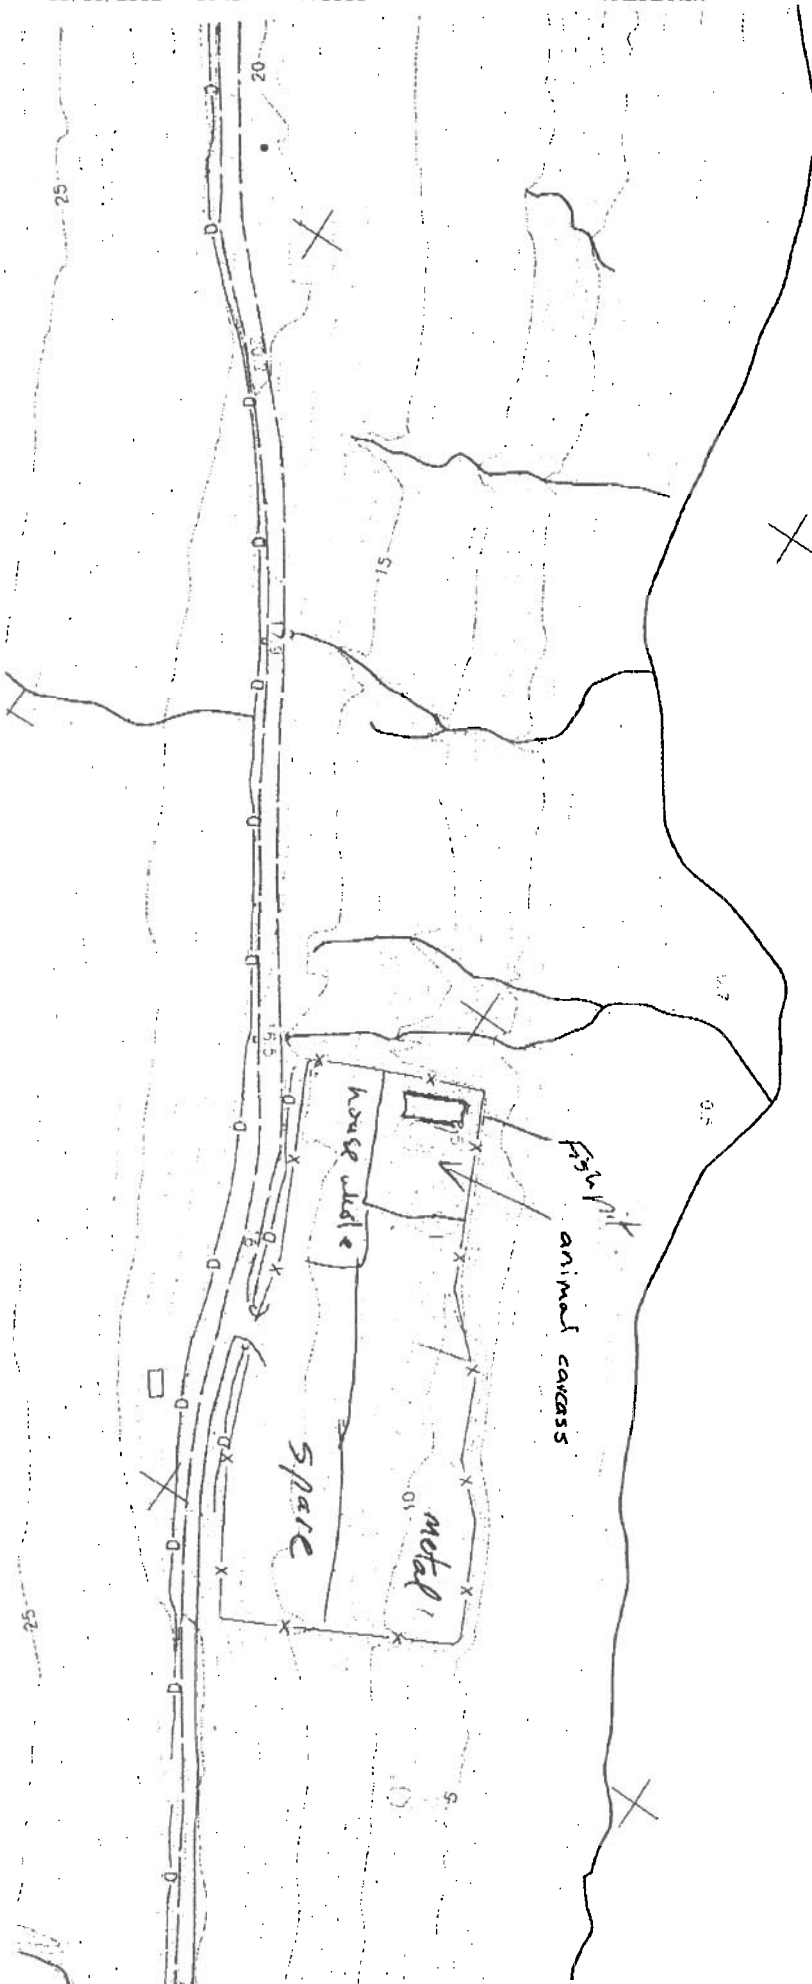

scale 1:2000 m.