



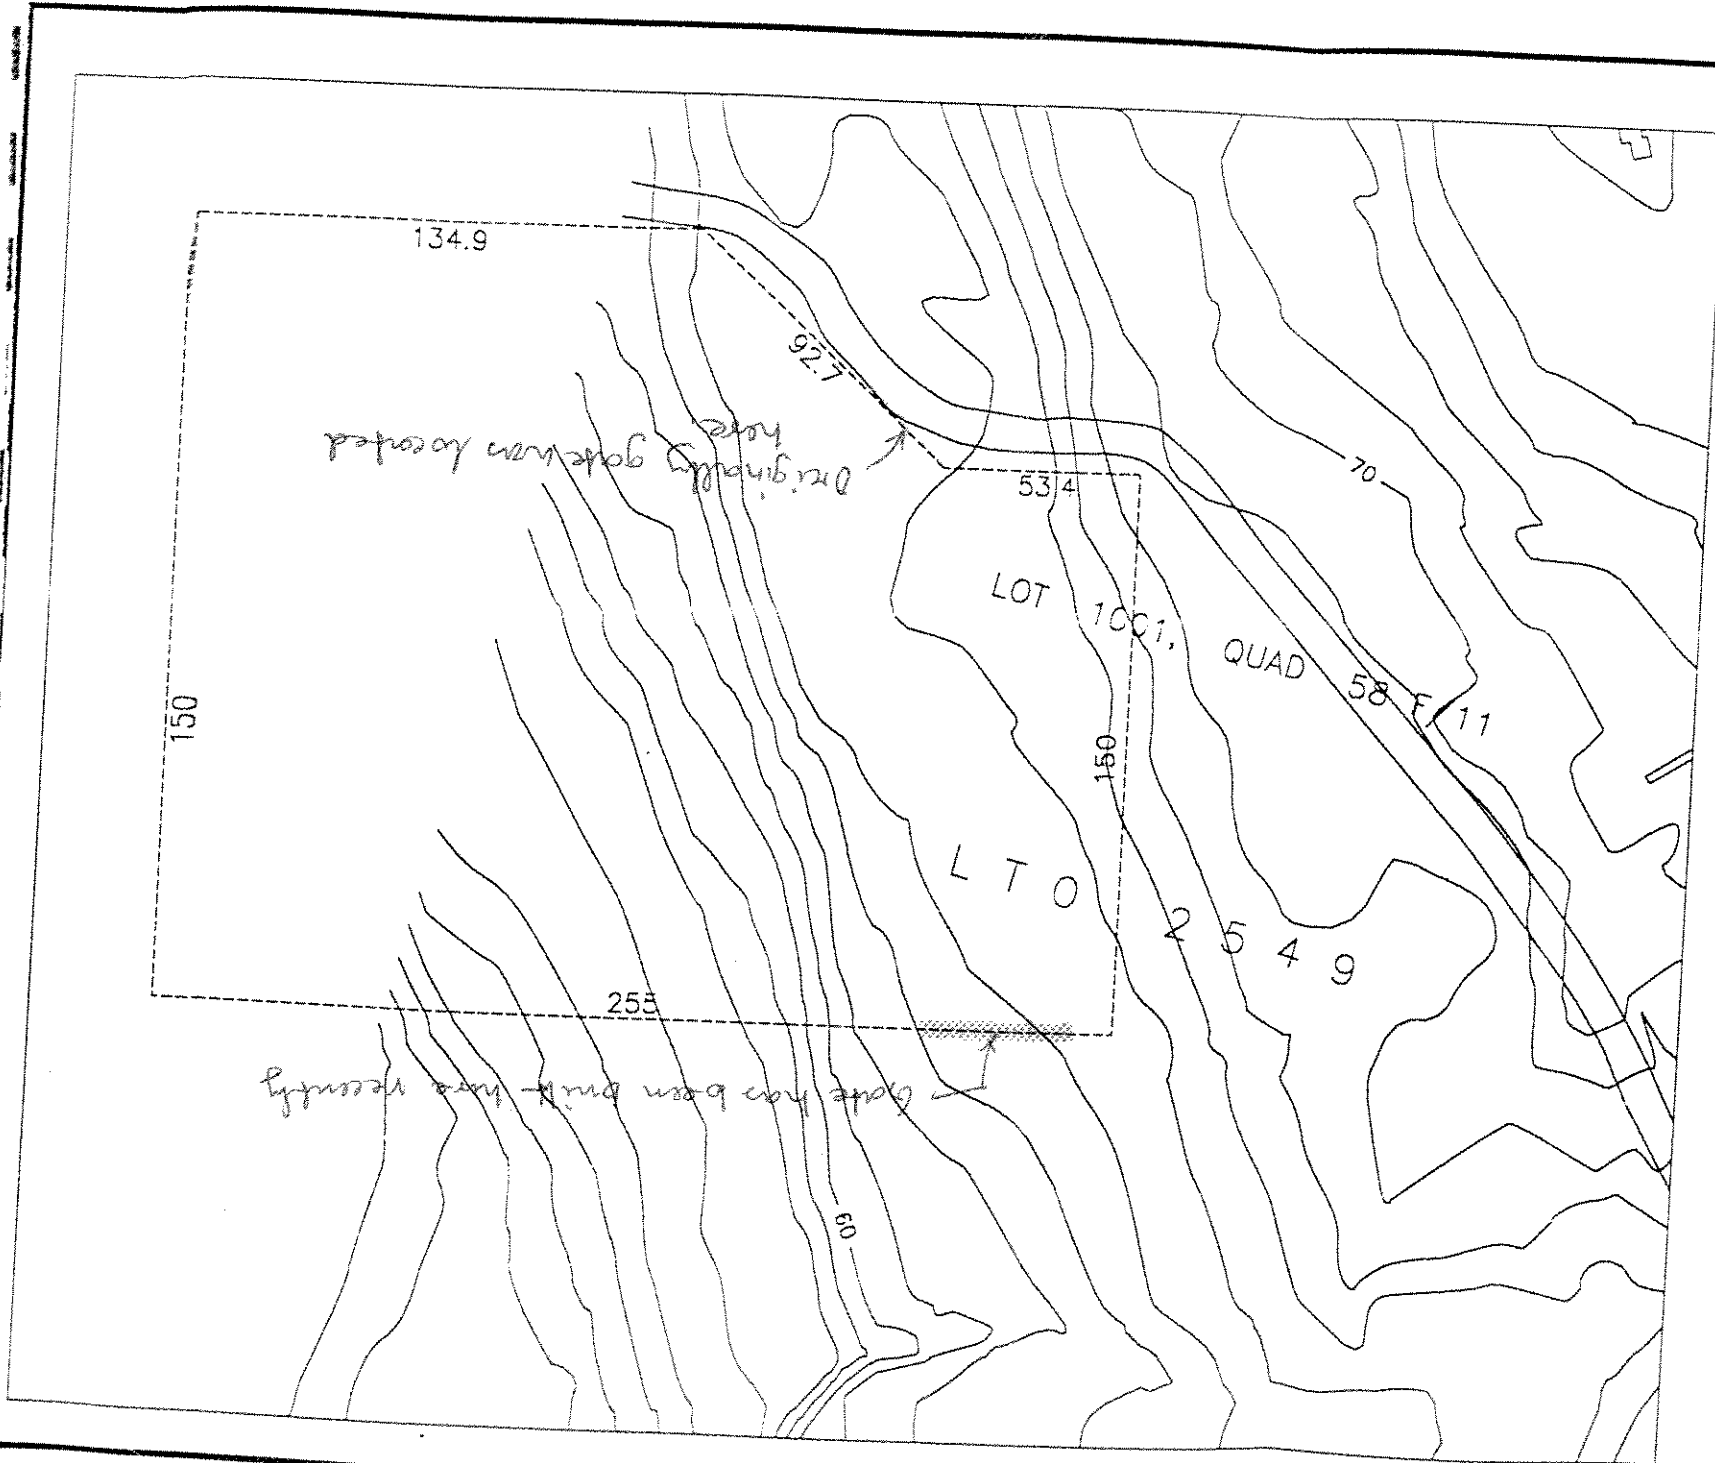

Northwest
Territories

Municipal and Community Affairs
Lands Division

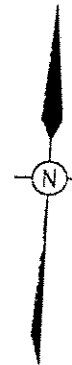

RESOLUTE BAY WASTE DISPOSAL SITE

1:2000

INITIALS

SKETCH NUMBER

PROPOSED
SOLID WASTE DISPOSAL SITE




AIRPORT



Northwest
Territories

Municipal and Community Affairs
Lands Division

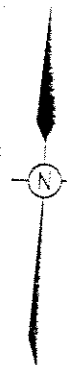

RESOLUTE BAY

PROPOSED SOLID WASTE
DISPOSAL SITE
KEY MAP

1:16000

INITIALS

SKETCH NUMBER