


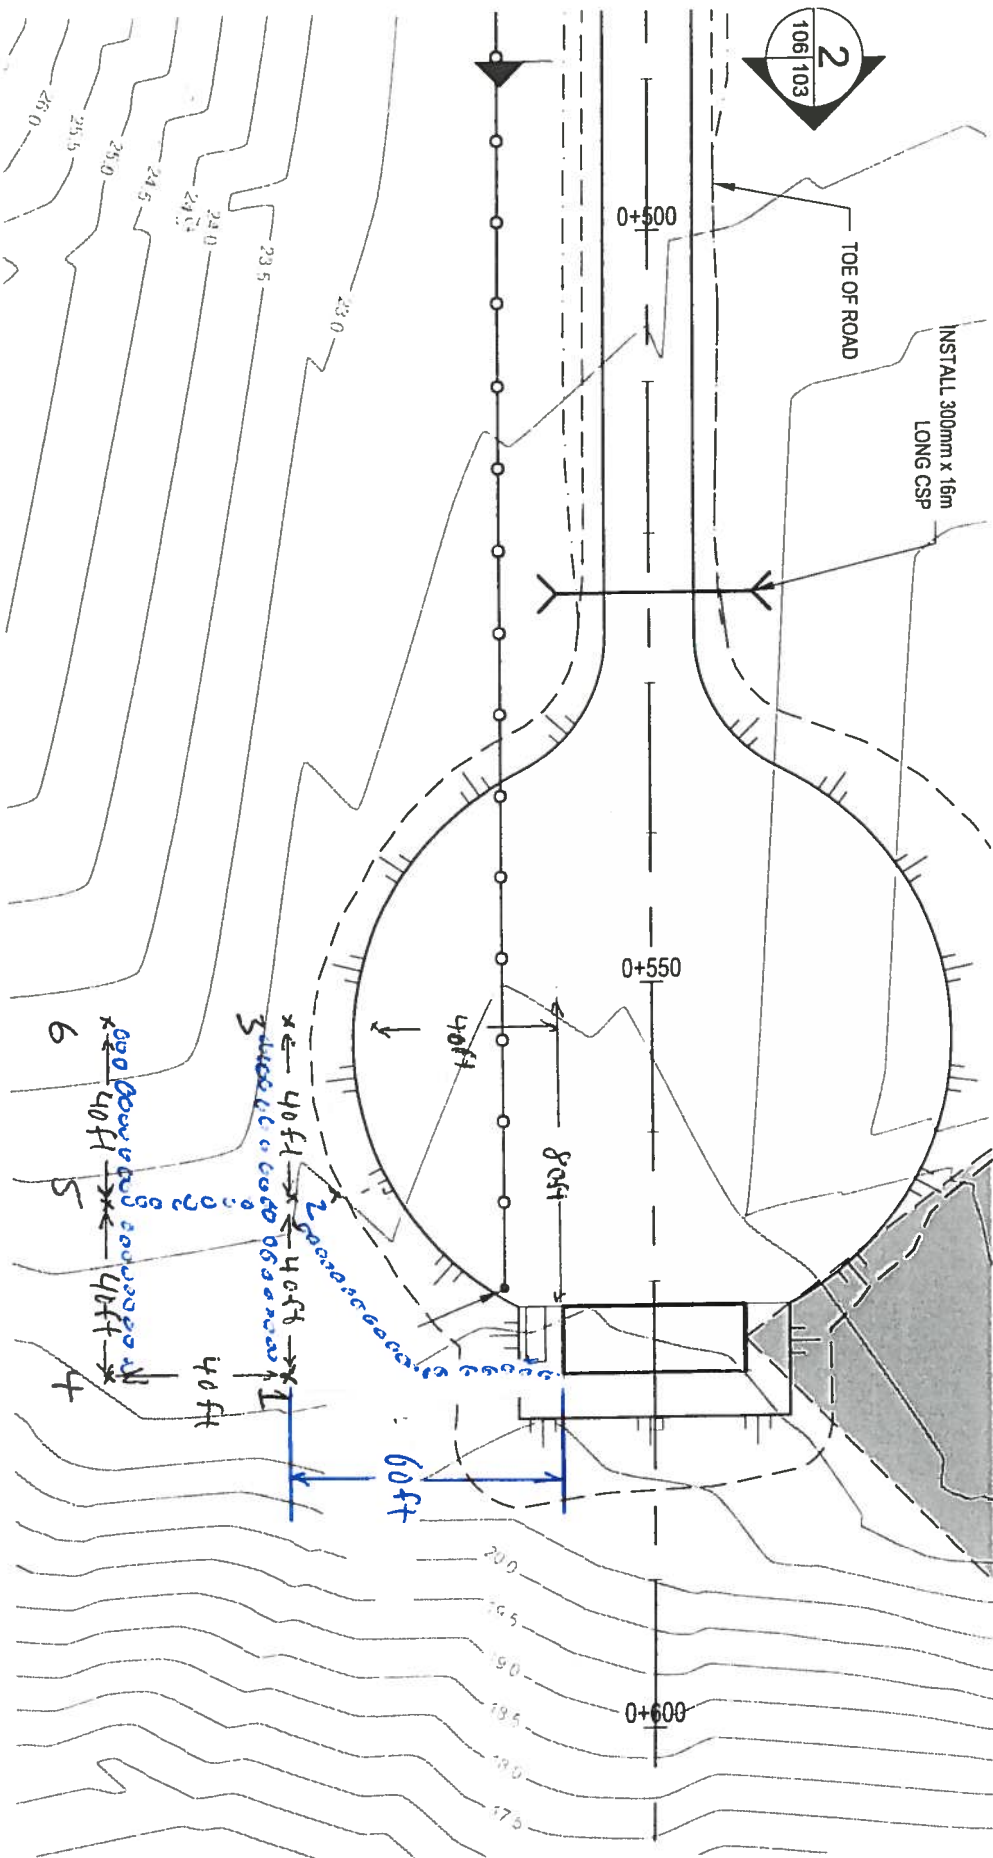

Sketch 3

----- wire path