

# BARE PIPE SHOP DRAWING

## SHOP DRAWING REVIEW

THIS DRAWING HAS BEEN REVIEWED FOR GENERAL CONFORMANCE WITH THE DESIGN CONCEPT ONLY. SUCH REVIEW SHALL NOT RELIEVE THE CONTRACTOR OF HIS RESPONSIBILITY FOR ERRORS OR OMISSIONS OR OF MEETING THE REQUIREMENTS OF THE CONTRACT DOCUMENTS. NO RESPONSIBILITY IS ASSUMED FOR CORRECTNESS OF DIMENSIONS OR DETAILS.

|                  |  |
|------------------|--|
| PRO COMMENT      |  |
| REV COMMENTS     |  |
| ADDENDUM ELEMENT |  |
| DELETED          |  |


Submission No.

Project No. 078107

By G.S

Date June 25/10

DILLON CONSULTING LIMITED

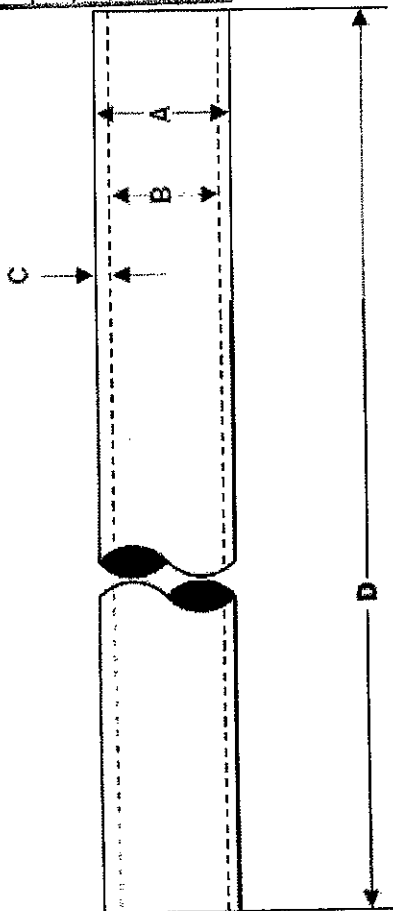

## PIPE

Material :

HDPE

Nominal Diameter :

4"

Series/Class/Sch. :

DR17

Pipe service :

Intake

Operating temperature :

Joint type :

Butt Fusion

Specification :

PE 3408

Manufacturer :

KWH

Outside diameter "A" :

4.5"

Inside diameter "B" :

3.939"

Wall thickness "C" :

.265"

Overall length "D" :

50'

|                 |               |
|-----------------|---------------|
| PROJECT         | Taloyoak      |
| OWNER           | Government    |
| ENGINEER        | Solomon       |
| DATE            | June 23, 2010 |
| CONTRACT NUMBER |               |