



2100

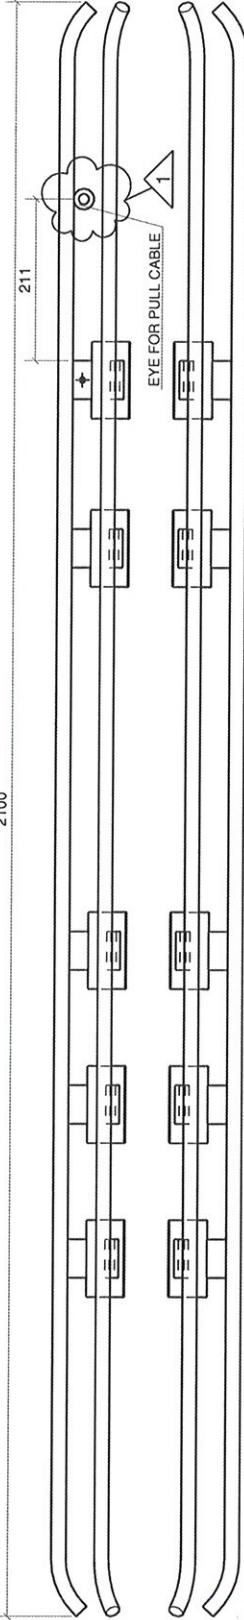

FRONT VIEW

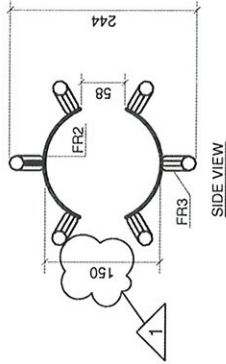

SIDE VIEW

SHOP DRAWING REVIEW

THIS DRAWING HAS BEEN REVIEWED FOR GENERAL CONFORMANCE WITH THE DESIGN CONCEPT ONLY. SUCH REVIEW SHALL NOT RELIEVE THE CONTRACTOR OF HIS RESPONSIBILITY FOR ERRORS OR OMISSIONS OR OF MEETING THE REQUIREMENTS OF THE CONTRACT DOCUMENTS. NO RESPONSIBILITY IS ASSUMED FOR CORRECTNESS OF DIMENSIONS OR DETAILS.

NO COMMENT

DATE REVIEWED

REVIEWED

Submission No.

Project No. 078107

By GS

Date June 18/10

DILLON CONSULTING LIMITED



PK METAL WORKS

19469 - 92 Ave. Surrey, BC V4N 4G6
Tel: 604-882-8659 Fax: 604-882-8709

COMPANY: BI PUREWATER

ADDRESS: #29790-190 STR. SURREY, BC

TEL/FAX: 604-882-8650/604-882-8659

PROJECT: PUMP SKID, INTAKE SCREEN

ADDRESS: TALOYAK, NUNAVUT

DATE: 08.06.10 DRAWN BY: PK REF: JIM TAM

DRAWING TITLE: CHECK CUST REF.

PO

JOB # 5822

DRAWING # 5822-10-00-001 REV. 1

Date Revision

1 17.16.2010 Changes after Engineer review, quantity increased

QTY. SIZE LONG A325



HOLES: 20.6

PAINT:

WELD: 6

FILLET ALL AROUND

STEEL GRADE: G40.21 GRADE 300W, W SHAPE 350W

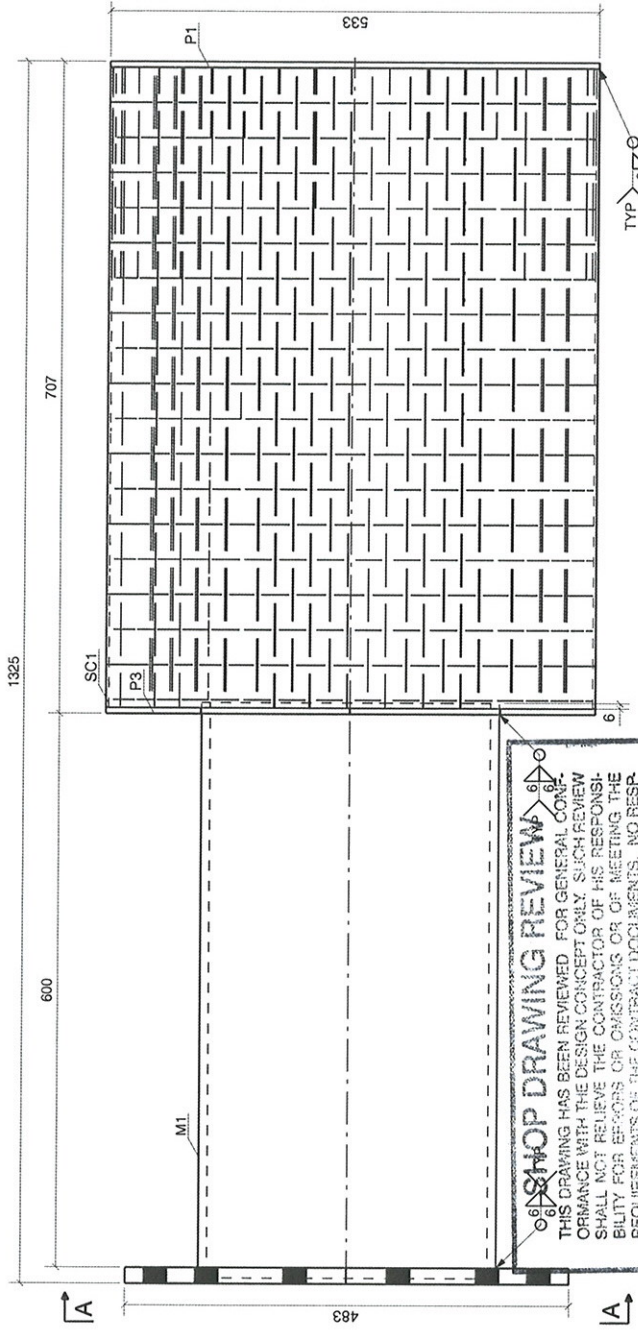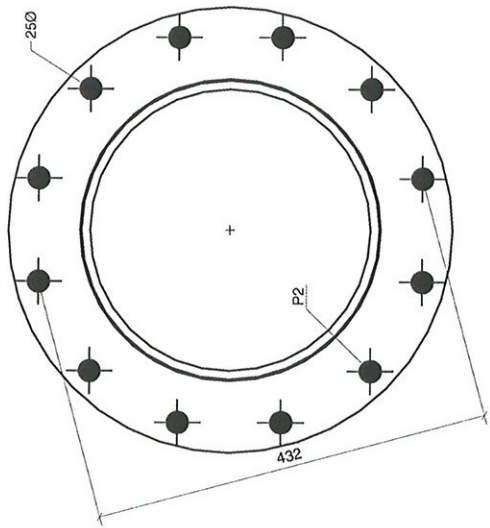

SHOP DRAWING REVIEW

THIS DRAWING HAS BEEN REVIEWED FOR GENERAL CONFORMANCE WITH THE DESIGN CONCEPT ONLY. SUCH REVIEW SHALL NOT RELIEVE THE CONTRACTOR OF HIS RESPONSIBILITY FOR ERRORS OR OMISSIONS OR OF MEETING THE REQUIREMENTS OF THE CONTRACT DOCUMENTS. NO RESPONSIBILITY IS ASSURED FOR CORRECTNESS OF DIMENSIONS OR DETAILS.

NO COMMENTS	Submission No. 078107
DATE REVIEWED	Project No. 078107
REVIEWED BY	By June 18/10
DATE	June 18/10

DILLOV CONSULTING LIMITED



MARK	QTY	DESCRIPTION	LENGTH	WEIGHT	REMARKS
M1	2	PIPE 310STD	623	189.4	
P1	2	D533	6	48.8	
P2	2	PL 18X483	483	59.9	3060FT ITEM
P3	2	PL 6X533	533	30.5	
SC1	2	SPD533X3	694	119.5	
TOTAL WEIGHT				448.1	

#	Date	Revision		
1	17.16.2010	Change after Engineer review quantity increased		
QTY.	SIZE	LONG	A325	U.N.O.
HOLES: 20.6				U.N.O.
PAINT:				U.N.O.
WELD: 6				U.N.O.
Fillet all around				
STEEL GRADE: G40.21 GRADE 300W, W SHAPE 350W				

PK METAL WORKS

19460 - 92 Ave. Surrey, BC V4N 4C6
TEL: 604-882-8699 FAX: 604-882-8799

COMPANY:	BI PUREWATER
ADDRESS:	#29790-190 STR. SURREY, BC
TEL/FAX:	604-882-6650/604-882-6659
PROJECT:	PUMP SKID, INTAKE SCREEN
ADDRESS:	TALOYOAK, NUNAVUT
DATE:	08.06.10
DRAWN BY:	PK REF. JIM TAM
DRAWING TITLE:	CHECK CUST. REF.
FRAME	PO
FR1	JOB # 5822
	DRAWING # 5822-10-29-001 REV. 1

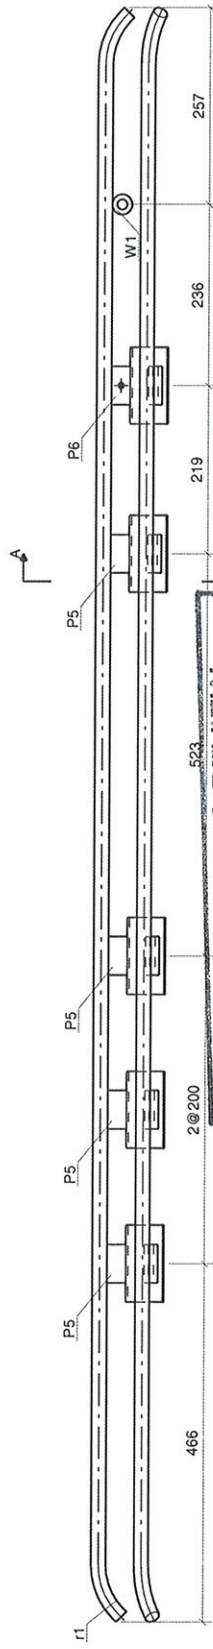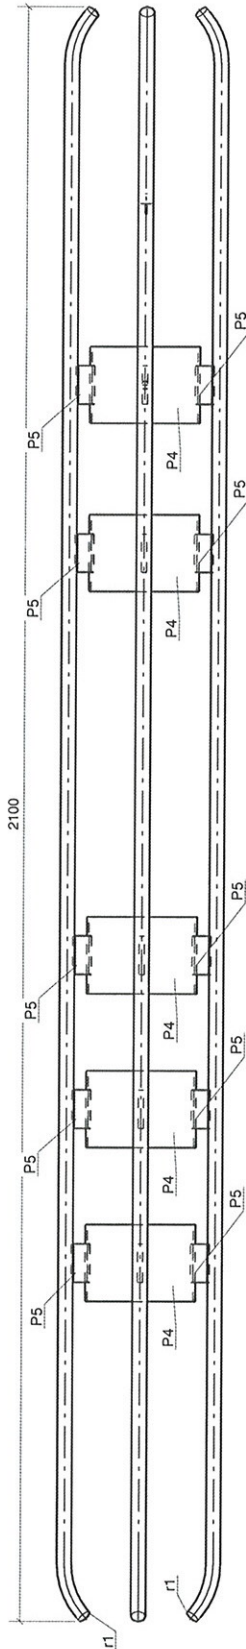

SHOP DRAWING REVIEW

THIS DRAWING HAS BEEN REVIEWED FOR GENERAL CONFORMANCE WITH THE DESIGN CONCEPT ONLY. SUCH REVIEW SHALL NOT RELIEVE THE CONTRACTOR OF HIS RESPONSIBILITY FOR ERRORS OR OMISSIONS OR OF MEETING THE REQUIREMENTS OF THE CONTRACT DOCUMENTS. NO RESPONSIBILITY IS ASSURED FOR CORRECTNESS OF DIMENSIONS OR DETAILS.

NO COMMENTS

Submittal No. **078107**

Project No. **55**

By **June 18/10**

DILLON CONSULTING LIMITED





19469 - 92 Ave. Surrey, BC V4N 4G6
Tel: 604-882-8699 Fax: 604-882-5799

#	Date	Revision		
1	17.18.2010	Change after Engineer review, quantity increased		
QTY.	SIZE	LONG	A325	U.N.O.
HOLES: 20.6				U.N.O.
PAINT:				U.N.O.
WELD: 6				FILLET ALL AROUND U.N.O.
STEEL GRADE: G40.21 GRADE 300W, W SHAPE 350W				

MARK	QTY	DESCRIPTION	LENGTH	WEIGHT	REMARKS
P4	10	BLX100	177	9.9	304
P5	28	PLX25	50	3.8	304
P6	2	PLX25	50	0.3	304
W1	2	1/2 WASHER	3	0.0	304
r1	6	RB19.05	2090	56.1	304
TOTAL WEIGHT				70.0	

2 - PUMP SKIDS - FR2

COMPANY: BI PUREWATER
ADDRESS: #2, 9790-190 STR. SURREY, BC
TEL/FAX: 604-882-6650/604-882-6659
PROJECT: PUMP SKID, INTAKE SCREEN
ADDRESS: TALOYOK, NUNAVUT
DATE: 08.06.10 DRAWN: JK PK REF: JIM TAM
DRAWING TITLE: CHECK CUST. REF.
FRAME PO
FR2 JOB # 5822
DRAWING # 5822-10-29-002 REV. 1

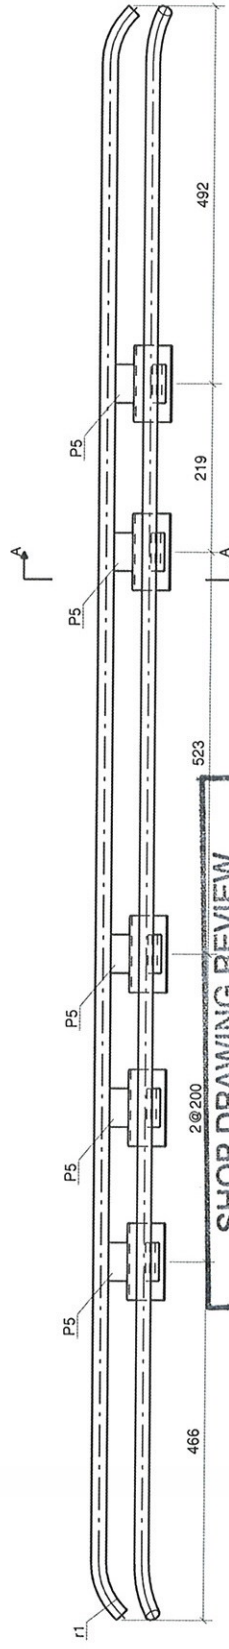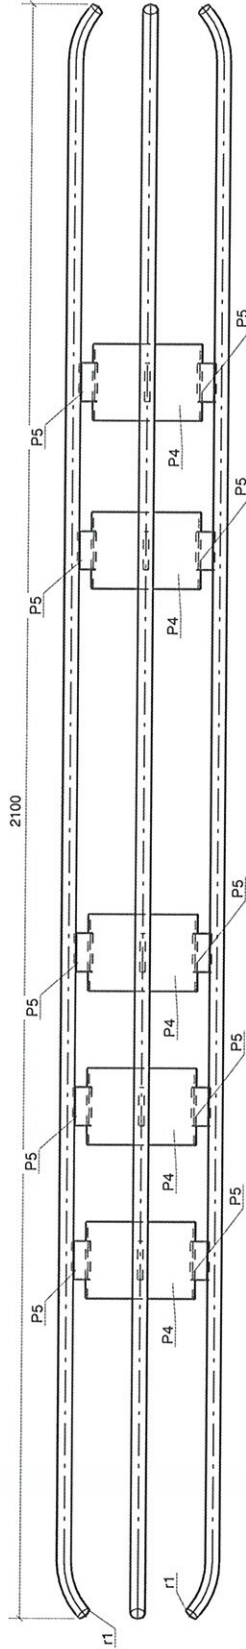

SHOP DRAWING REVIEW

THIS DRAWING HAS BEEN REVIEWED FOR GENERAL CONFORMANCE WITH THE DESIGN CONCEPT ONLY. SUCH REVIEW SHALL NOT RELIEVE THE CONTRACTOR OF HIS RESPONSIBILITY FOR ERRORS OR OMISSIONS OR OF MEETING THE REQUIREMENTS OF THE CONTRACT DOCUMENTS. NO RESPONSIBILITY IS ASSUMED FOR CORRECTNESS OF DIMENSIONS OR DETAILS.

NO COMMENT	✓
NOT REVIEWED	
APPROVED	
REWORK	

Submission No. 072107

Project No. 65

By June 18/10

Date

DILLON CONSULTING LIMITED

2 - PUMP SKIDS - FR3

MARK	QTY	DESCRIPTION	LENGTH	WEIGHT	REMARKS
P4	10	BL3X100	177	9.9	30
P5	30	PL6X25	50	4.1	30
r1	6	RB19.05	2090	56.1	30
TOTAL WEIGHT				70.0	

#	Date	Revision		
1	17/16/2010	Changes after Engineer review, quantity increased		
QTY.	SIZE	LONG	A325	U.N.O.
HOLES: 20.6				
PAINT:				
U.N.O.				
WELD: 6				
Fillet ALL AROUND				
U.N.O.				
STEEL GRADE: G40.21 GRADE 300W, W SHAPE 350W				

PK METAL WORKS

18400 - 43 Ave. Surrey, BC V4N 4C6
TEL: 604-882-6650 FAX: 604-882-6659

COMPANY: BI PUREWATER
ADDRESS: #29790-190 STR. SURREY, BC
TEL/FAX: 604-882-6650/604-882-6659
PROJECT: PUMP SKID, INTAKE SCREEN
ADDRESS: TALOYOAK, NUNAVUT
DATE: 08.06.10 DRAWN: IK PK REF: JIM TAM
DRAWING TITLE: CHECK CUST REF.
FRAME PO
JOB # 5822
DRAWING # 5822-10-29-003 REV. 1