

12 IMP. GAL. OPEN TOP CYLINDRICAL TANK


SHOP DRAWING REVIEW

THIS DRAWING HAS BEEN REVIEWED FOR GENERAL CONFORMANCE WITH THE DESIGN CONCEPT ONLY. SUCH REVIEW SHALL NOT RELIEVE THE CONTRACTOR OF HIS RESPONSIBILITY FOR ERRORS OR OMISSIONS OR OF MEETING THE REQUIREMENTS OF THE CONTRACT DOCUMENTS. NO RESPONSIBILITY IS ASSUMED FOR CORRECTNESS OF DIMENSIONS OR DETAILS.

<input checked="" type="checkbox"/>	NO COMMENT
<input type="checkbox"/>	SEE COMMENTS
<input type="checkbox"/>	AMEND & RESUBMIT
<input type="checkbox"/>	REJECTED

Submission No. 45
 Project No. 078107
 By GS
 Date June 4/10

DILLON CONSULTING LIMITED

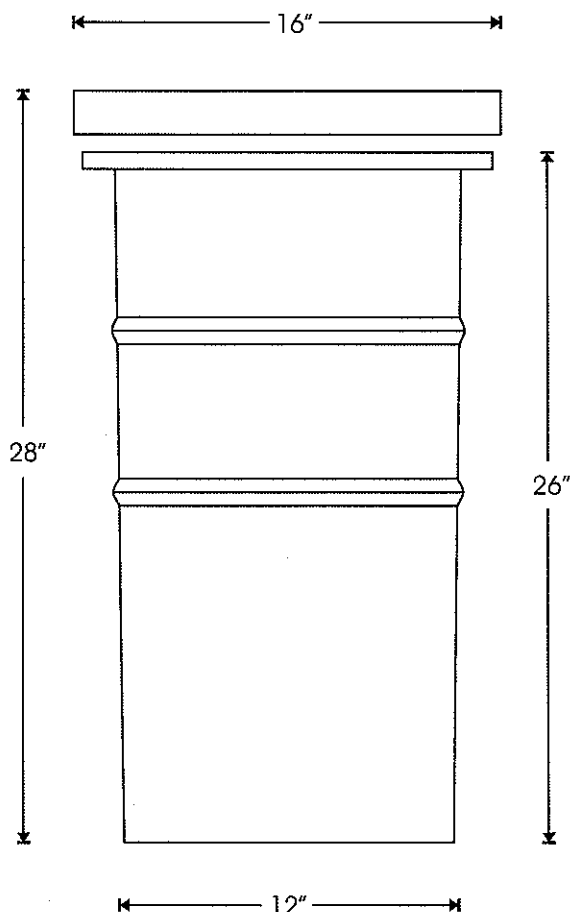

- HEAVY DUTY, ONE-PIECE, SEAMLESS POLYETHYLENE CONSTRUCTION
- EXCELLENT RESISTANCE TO IMPACT AND COLD WEATHER STRESS
- WON'T CRACK, RUST, OR CORRODE
- ULTRAVIOLET INHIBITORS PROVIDE PROTECTION AGAINST DETERIORATION FROM SUNLIGHT
- F.D.A. APPROVED FOR POTABLE WATER
- SUPERIOR CHEMICAL RESISTANCE AND COMPATIBILITY
- CLOSED TOP OR OPEN TOP AVAILABLE WITH COVER
- STEEL STANDS AVAILABLE TO YOUR HEIGHT REQUIREMENTS
- 2 YEAR WARRANTY
- DIMENSIONS: 12" DIA. x 26" H
- CAPACITY: 12 IMP. GAL. (55 LITRES)
- MODEL NO.: OTC012

For replacing:

1. 50L chlorine mixing tank
2. 50L chlorine storage tank

Hand stencil (not embossed) graduation marks at 5L intervals

*All Measurements are approximate

"When Quality Counts"

ZEEBEST PLASTICS

OF CANADA INC.

11941 - 121 Street NW, Edmonton, Alberta T5L 4H7

Tel: (780) 447-5222 Fax: (780) 455-9448

Internet Website: www.zeebest.com email: sales@zeebest.com