Parts List

ITEM	QTY	SIZE	MATERIAL	DESCRIPTION	MANUFACTURER	MODEL #	SPECIFICATION
1	3	1/2"	PVC	BACK PRESSURE VALVE	GRIFFCO	BPT-050-P-3	2 PORT, 10-150 PSI, VITON DIAPHRAGM
2	3	1/4"	BRASS	BALL VALVE	NVC	N10000-025BR	STANDARD PORT, FPT X FPT, MINIATURE HANDLE
3	3	1/2"	PVC	BALL VALVE	PRAHER	120989	TRUE UNION, VITON O-RING, TEFLON SEAT
4	3	N/A	PVC	METERING PUMP	GRUNDFOS	DDI209 20-3 AR-PVC/V/G-F-31SSB	SEE PUMP SPECS FOR DETAILS
5	3	0-200 PSI	SS	PRESSURE GAUGE	FOSTER	02FF00200-SS	LQUID FILLED, 2-1/2" SS BODY, 1/4" SS STEM
6	3	1/2" X 1/4"	PVC	PRESSURE GAUGE ISOLATOR	HAYWARD	GG125X50	NPT CONNECTIONS
7	3	1/2"	PVC	PRESSURE RELIEF VALVE	GRIFFCO	PRT-050-P-V	3 PORT, 10-150 PSI, VITON DIAPHRAGM

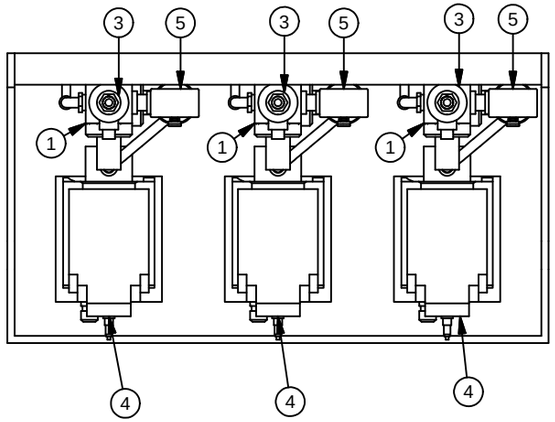

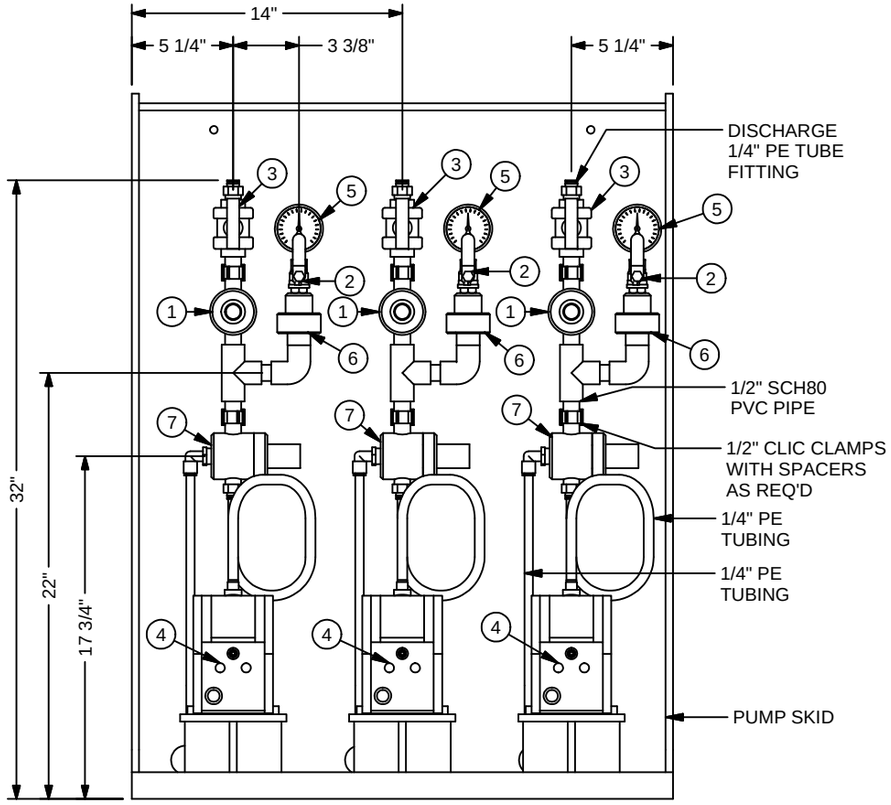

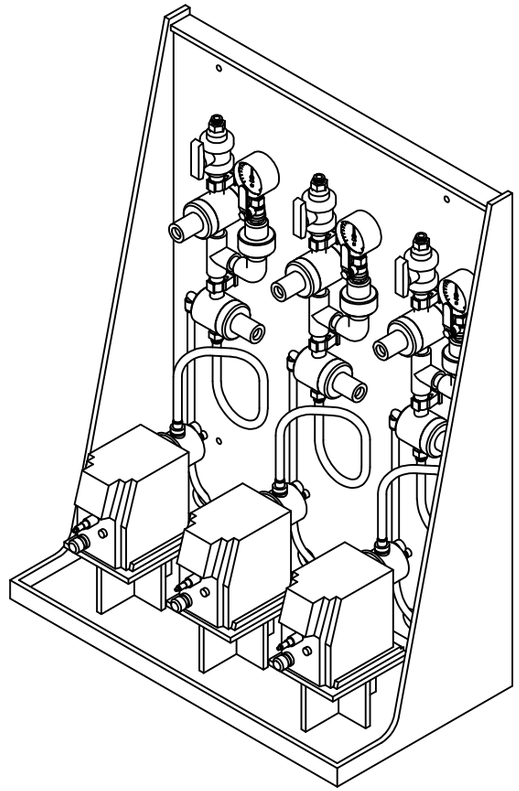

BI Pure Water (Canada) Inc.
#2, 9790 - 190th Street
Surrey, BC V4N 3M9
Phone: (604) 882-6650
Fax: (604) 882-6659
http://www.bipurewater.ca

THE INFORMATION CONTAINED IN THIS DRAWING IS THE SOLE PROPERTY OF
BI PURE WATER (CANADA) INC.
ANY REPRODUCTION IN PART OR WHOLE OF THE INFORMATION HEREIN, WITHOUT THE WRITTEN PERMISSION OF BI PUREWATER (CANADA) INC., IS STRICTLY PROHIBITED.

Status: AS PER RECORD

Issue	Date	Appd	Revision Description
02	NOV 4/11	JT	AS PER RECORD
01	JUN 15/10	JT	ISSUED FOR CONSTRUCTION

Design By: JT
Drawn By: RS
Checked By:
Submitted
Approved

Client: KITNUNA PROJECTS INC.

Title: CHLORINE SKID ASSEMBLY
Project: TALOYOAK WATER TREATMENT SYSTEM UPGRADE
Drawing #: 1772-ME-105
Scale
Date 15/06/2010
Sheet 1 of 1
Job#
Rev: 02