


Chapter 9: Prefab Building Components
Page 4

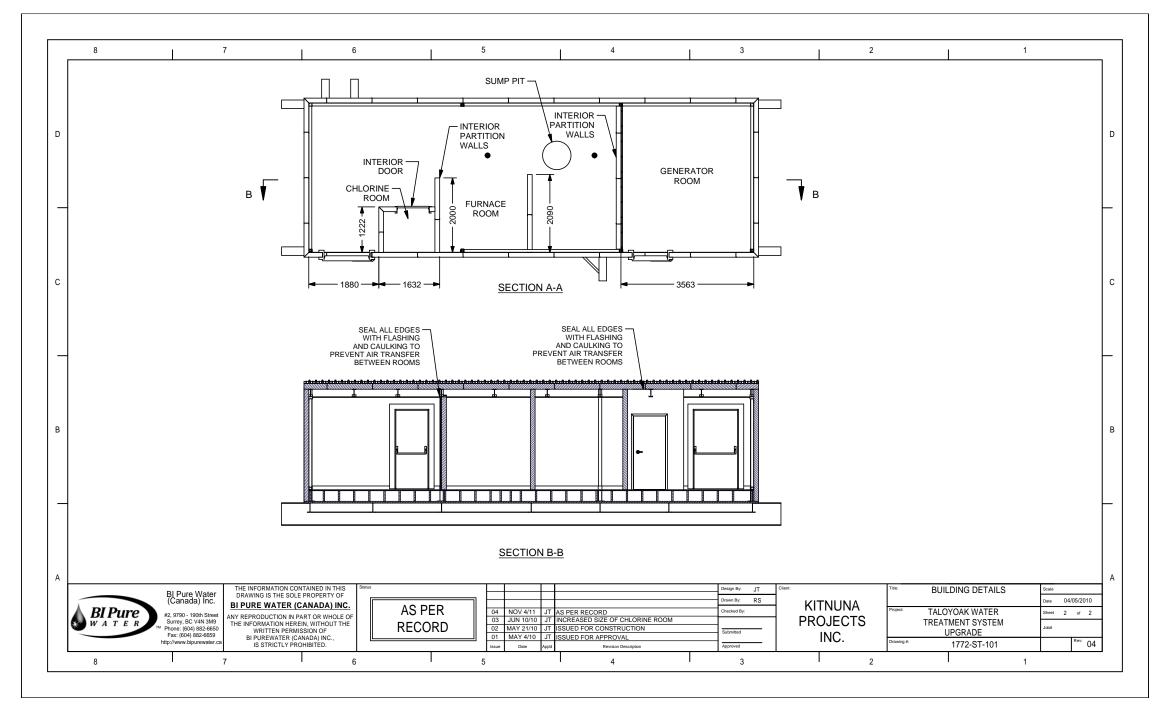

Chapter 9: Prefab Building Components
Page 5