


SHOP DRAWING REVIEW

THIS DRAWING HAS BEEN REVIEWED FOR GENERAL CONFORMANCE WITH THE DESIGN CONCEPT ONLY. SUCH REVIEW SHALL NOT RELIEVE THE CONTRACTOR OF HIS RESPONSIBILITY FOR ERRORS OR OMISSIONS OR FOR HIS COMPLIANCE WITH THE REQUIREMENTS OF THE SPECIFICATIONS. THE REVIEWER'S RESPONSIBILITY IS LIMITED TO THE REVIEW OF THE DRAWING FOR CONFORMANCE WITH THE DESIGN CONCEPT ONLY.

NO COMMENT
✓ SEE COMMENTS
AMEND & RESUBMIT
REJECTED

Submitted by: 12
Project No. 07 B107
By: ES
Date: May 24/10


DILLON CONSULTING LIMITED

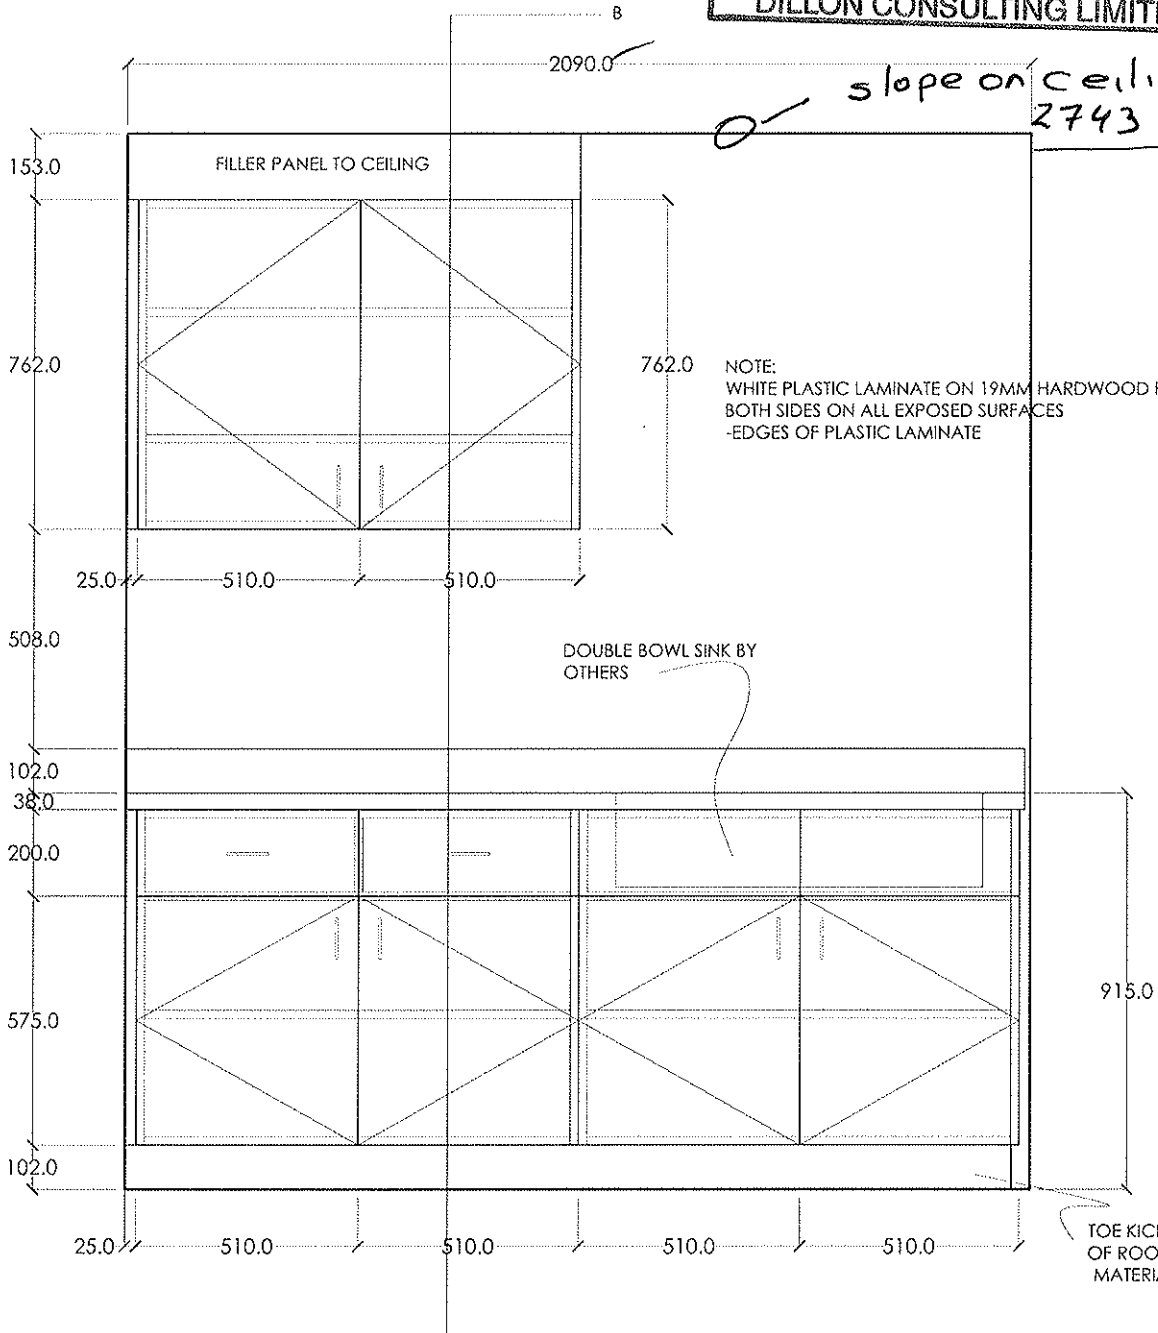

ELEVATION A

N.T.S.

41 - 7790 120 STREET
SURREY, BC, CANADA
V4N 3M9
Tel: 604.886.8418
Fax: 604.886.8419
info@proformconstruction.com

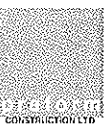

DRAWING # A-1

REVISION DATE

REVISION #

DATE: MAY 17, 2010

JOB # 1024

TALOYOK WATER
TREATMENT PLANT

ROOM NUMBER/NAME:
PUMP HOUSE


PULLS:
96MM BRUSHED STAINLESS
D PULLS

DRAWER SLIDE/TYPE:
SIDE MOUNT ACCURIDE
BALL BEARING

STAIN COLOUR:
N/A

SEMI EXPOSED MATERIAL:
WHITE PLAM ON 19MM
HARDWOOD PLYWOOD

EXPOSED MATERIAL:
WHITE PLAM ON 19MM
HARDWOOD PLYWOOD

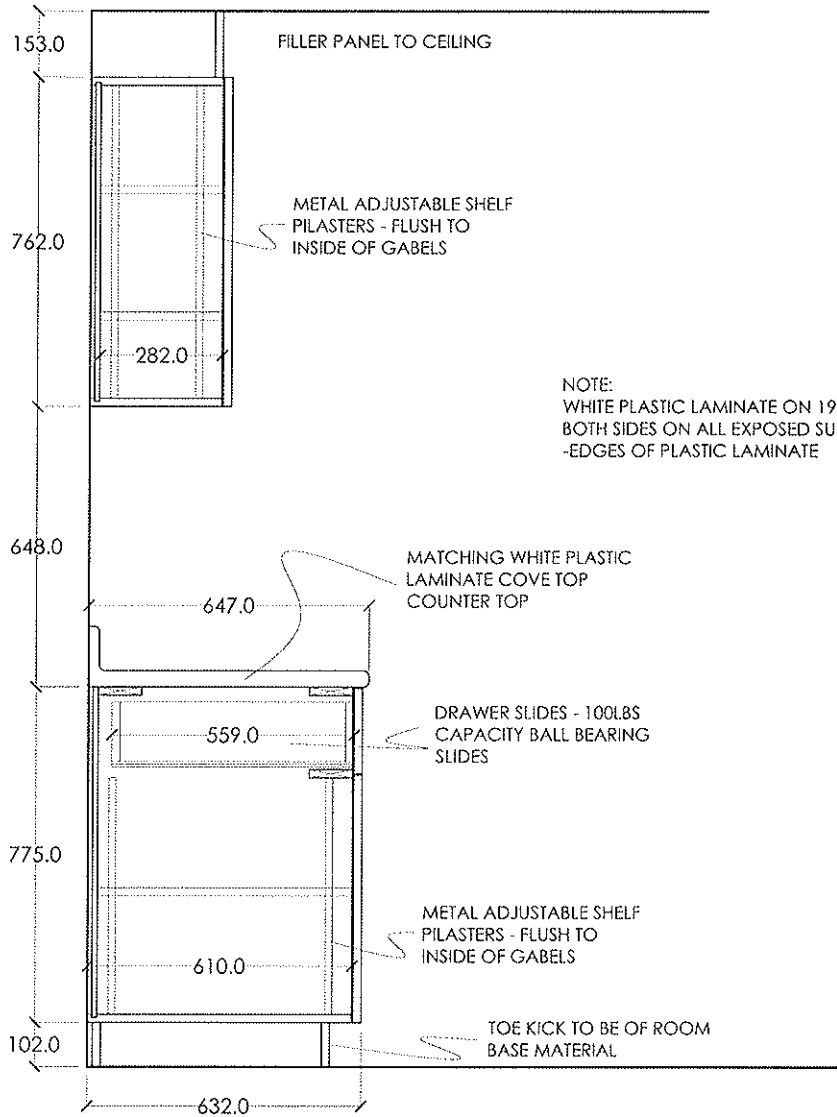

SECTION B

N.T.S.

EXPOSED MATERIAL:
WHITE PLAM ON 19MM
HARDWOOD PLYWOOD

SEMI EXPOSED MATERIAL:
WHITE PLAM ON 19MM
HARDWOOD PLYWOOD

STAIN COLOUR:
N/A

DRAWER SLIDE/TYPE:
SIDE MOUNT ACCURIDE
BALL BEARING

PULLS:
96MM BRUSHED STAINLESS
D PULLS

ROOM NUMBER/NAME:
PUMP HOUSE

TALOYOAK WATER
TREATMENT PLANT


JOB # 1024

DATE: MAY 17, 2010


REVISION #

REVISION DATE

DRAWING # A-2

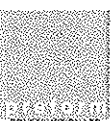

#1 - 9790 170 STREET
SURREY BC CANADA
VAN SW9
P 604 898 8618
F 604 898 8633
info@preformconstruction.com

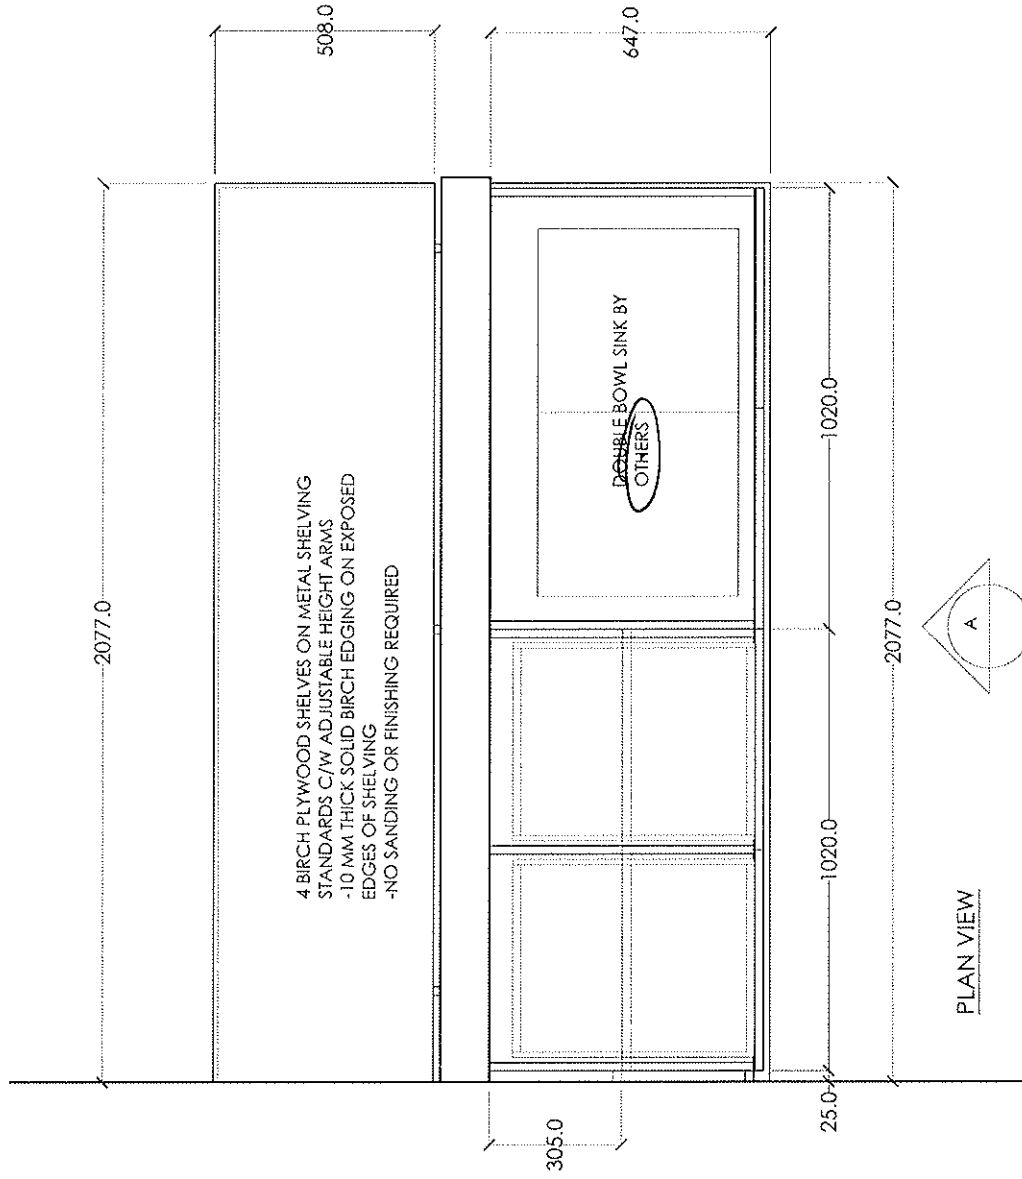

N.T.S.

EXPOSED MATERIAL:
WHITE PLAM ON 19MM
HARDWOOD PLYWOOD

SEMI EXPOSED MATERIAL:
WHITE PLAM ON 19MM
HARDWOOD PLYWOOD

STAIN COLOUR:
N/A

DRAWER SLIDE/TYPE:
SIDE MOUNT ACCURIDE
BALL BEARING

PULLS:
96MM BRUSHED STAINLESS
D PULLS

ROOM NUMBER/NAME:
PUMP HOUSE

TALOYOAK WATER
TREATMENT PLANT

JOB # 1024

DATE: MAY 17, 2010

REVISION #

REVISION DATE

DRAWING # A-3






2090.0

4 BIRCH PLYWOOD SHELVES ON METAL SHELVING STANDARDS C/W ADJUSTABLE HEIGHT ARMS
-10 MM THICK SOLID BIRCH EDGING ON EXPOSED EDGES OF SHELVING
-NO SANDING OR FINISHING REQUIRED

2077.0

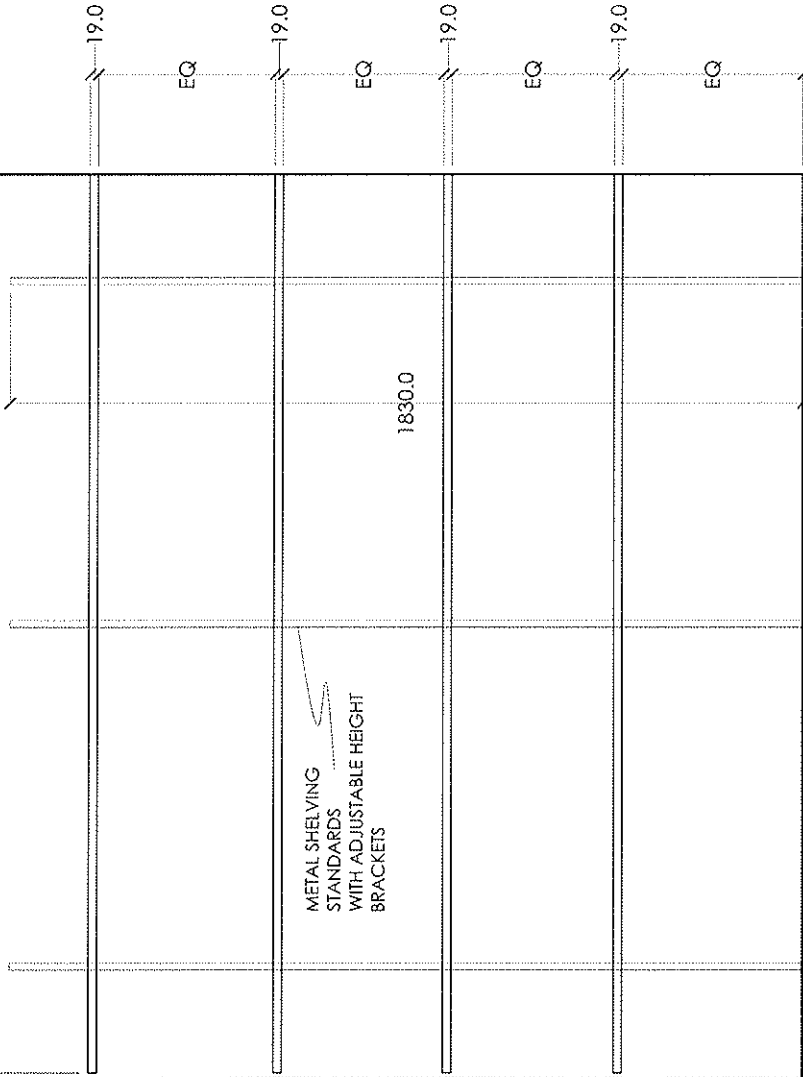

METAL SHELVING STANDARDS WITH ADJUSTABLE HEIGHT BRACKETS

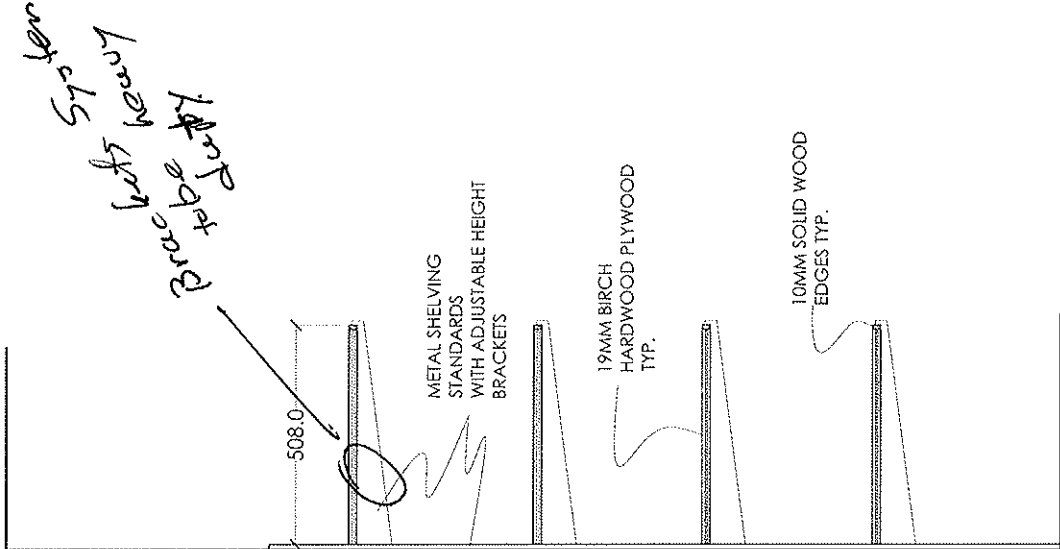

System
brackets heavy
to justify

METAL SHELVING STANDARDS WITH ADJUSTABLE HEIGHT BRACKETS

19MM BIRCH HARDWOOD PLYWOOD TYP.


10MM SOLID WOOD EDGES TYP.

ELEVATION B

ADJUSTABLE PLYWOOD SHELVES

SECTION B

N.I.S.

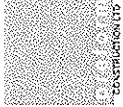
