



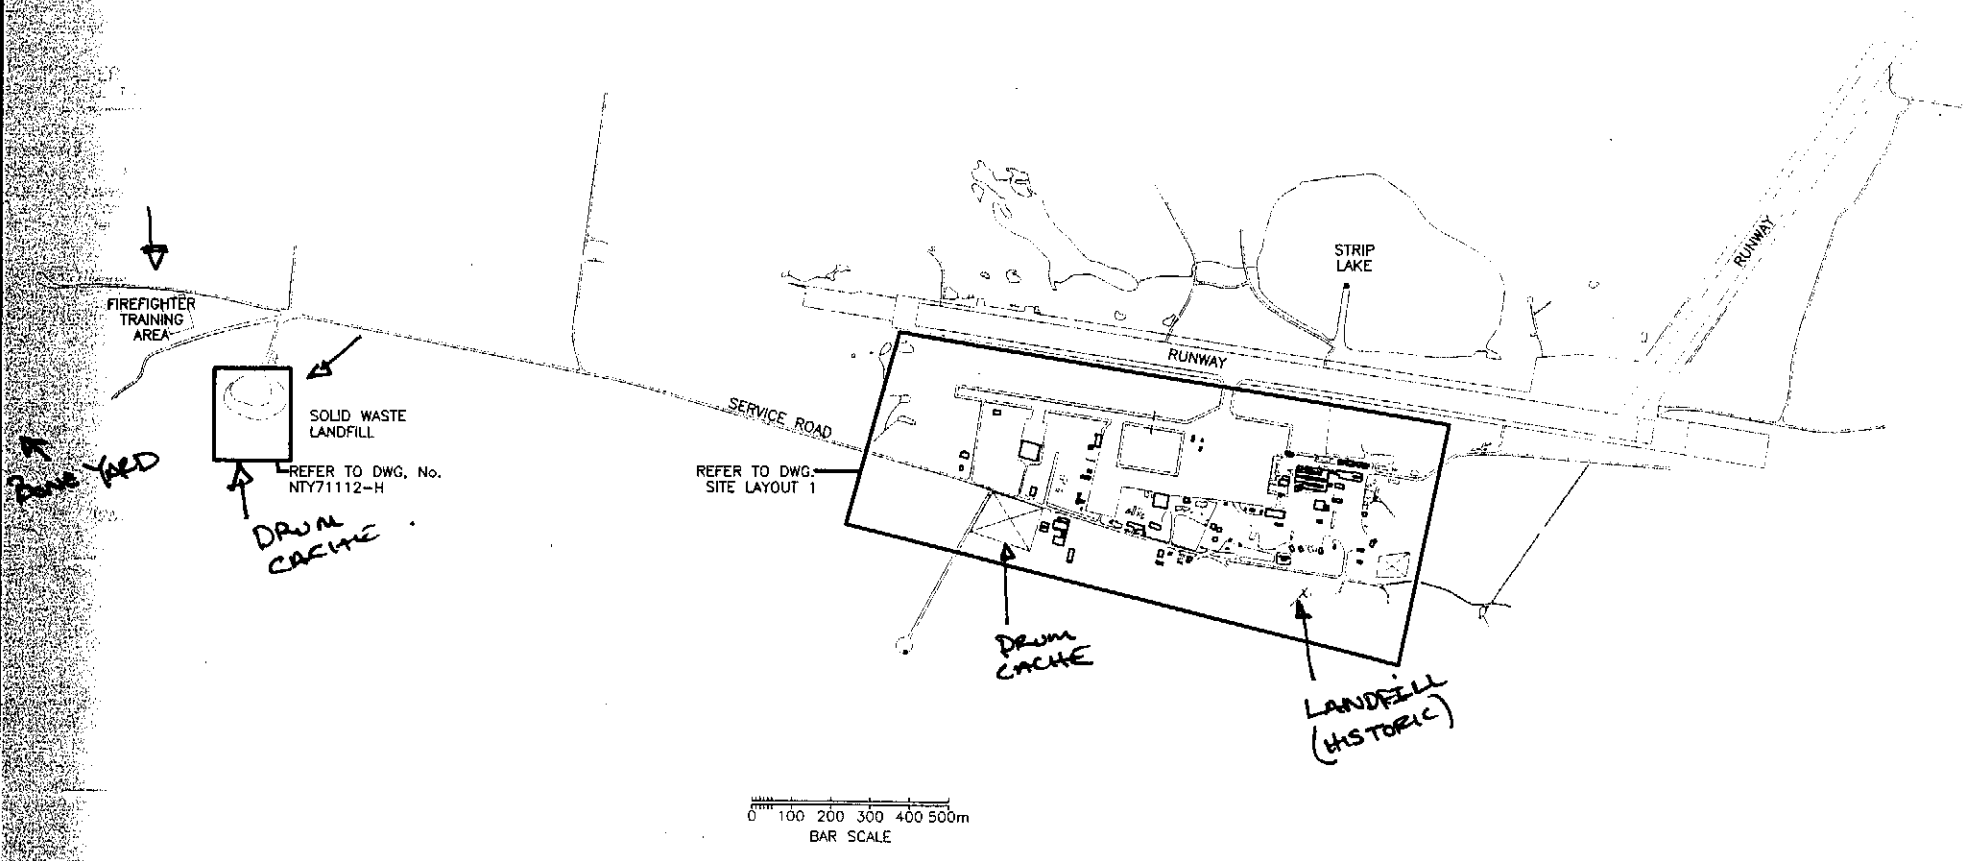

0 100 200 300 400 500m
BAR SCALE

	REFERENCE:	SCALE :	BAR SCALE	TRANSPORT CANADA SITE INVESTIGATION RESOLUTE BAY AIRPORT, NUNAVUT	SITE PLAN DRAWING NO. NTY71112 SITE PLAN
		DATE :	2006/03/29		
		DRAWN BY :	P.J. SOO		
		APPROVED BY :			

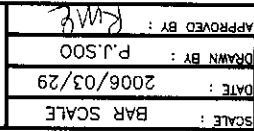

TRANSPORT CANADA

DRAWING NO.

