H-B199/2-9314-601

BAF-3

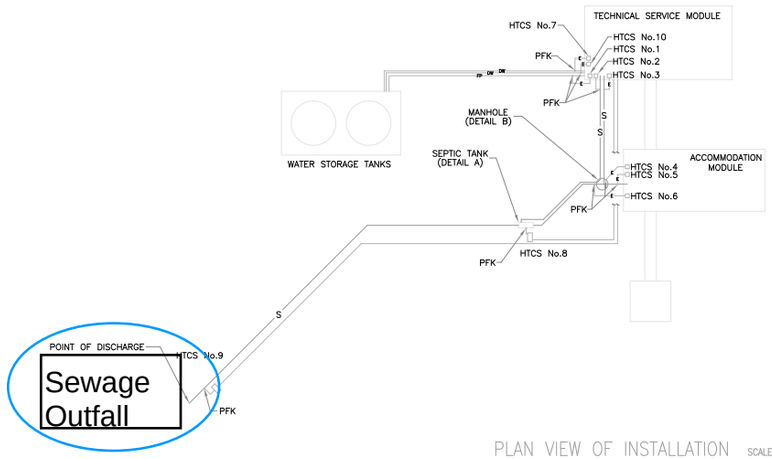

PLAN VIEW OF INSTALLATION SCALE 1:500

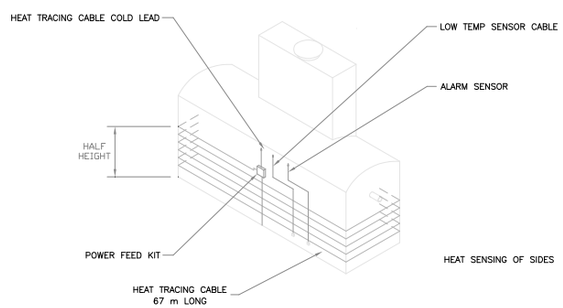

DETAIL A – HEAT TRACING OF SEPTIC TANK SCALE 1:50

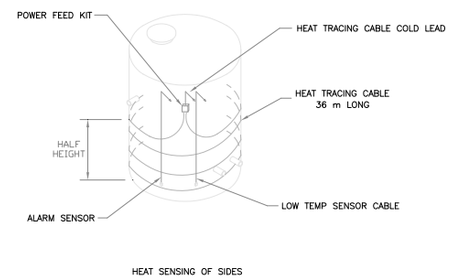

DETAIL B – HEAT TRACING OF MANHOLE

REFERENCE DRAWING

H-B199/2-9304-602

National Defence / Défense nationale

NORTH WARNING SYSTEM OFFICE
Bureau du système d'alerte du Nord

LOCATION

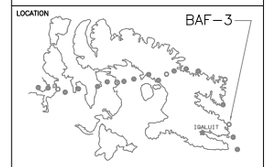

ATCO Frontec
100-170 LAURIER AVE. WEST
OTTAWA, ONTARIO K1P 5V5
TEL.: (613) 234-9033
FAX.: (613) 234-3888

LOCID BRE B05A, W04A, W04B, W03, W02C, W02A.

NOTES

SEWAGE DISPOSAL

1. FOR SEWAGE DISPOSAL SEE VOLUME 1 SITE INFASTRUCTURE, BOOK 261.E10 (BINDER 1)

REDUCED DRAWING FOR INFORMATION ONLY

SCALE IS REPRESENTATIVE OF FULL SIZE DRAWING.

No.	DATE	REVISION RÉVISION	APPR.

SITE RECORD DRAWING

SCALE – ÉCHELLE

1 0 1 2 3 4 metres mètres

PROJECT – PROJET

CM-66272

LONG RANGE RADAR SITE

BAF-3

BREVOORT NUNAVUT

TRADE – MÉTIER CIVIL

DATE 16 DEC 99

SUBJECT – SUJET

DOMESTIC WATER, FIRE PROTECTION, PIPING & SEWAGE DISPOSAL SYSTEM

PRODUCTION		CONCURRENCE – ASSENTIMENT	
DESIGNED ÉTUDIÉ		FIRE MARSHAL	PRÉVÔT DU SERVICE DES INCENDIES
DRAWN DESSINÉ	F.P.		
CHECKED VÉRIFIÉ	S.F.	NWSO ENGINEERING OFFICER	OFFICIER DU GÉNIE BSAN
COORDINATION		NWSO FACILITIES ENGINEER	GÉNIE DES INSTALLATIONS BSAN

DWG. NO. – DESSIN NO.

H-B199/2-9314-601

Canada